Book 1301

7-6-46

MONUMENTATION MAP

SHEET 1 OF 2

1260048

WASHINGTON SQUARE UNIT № 7

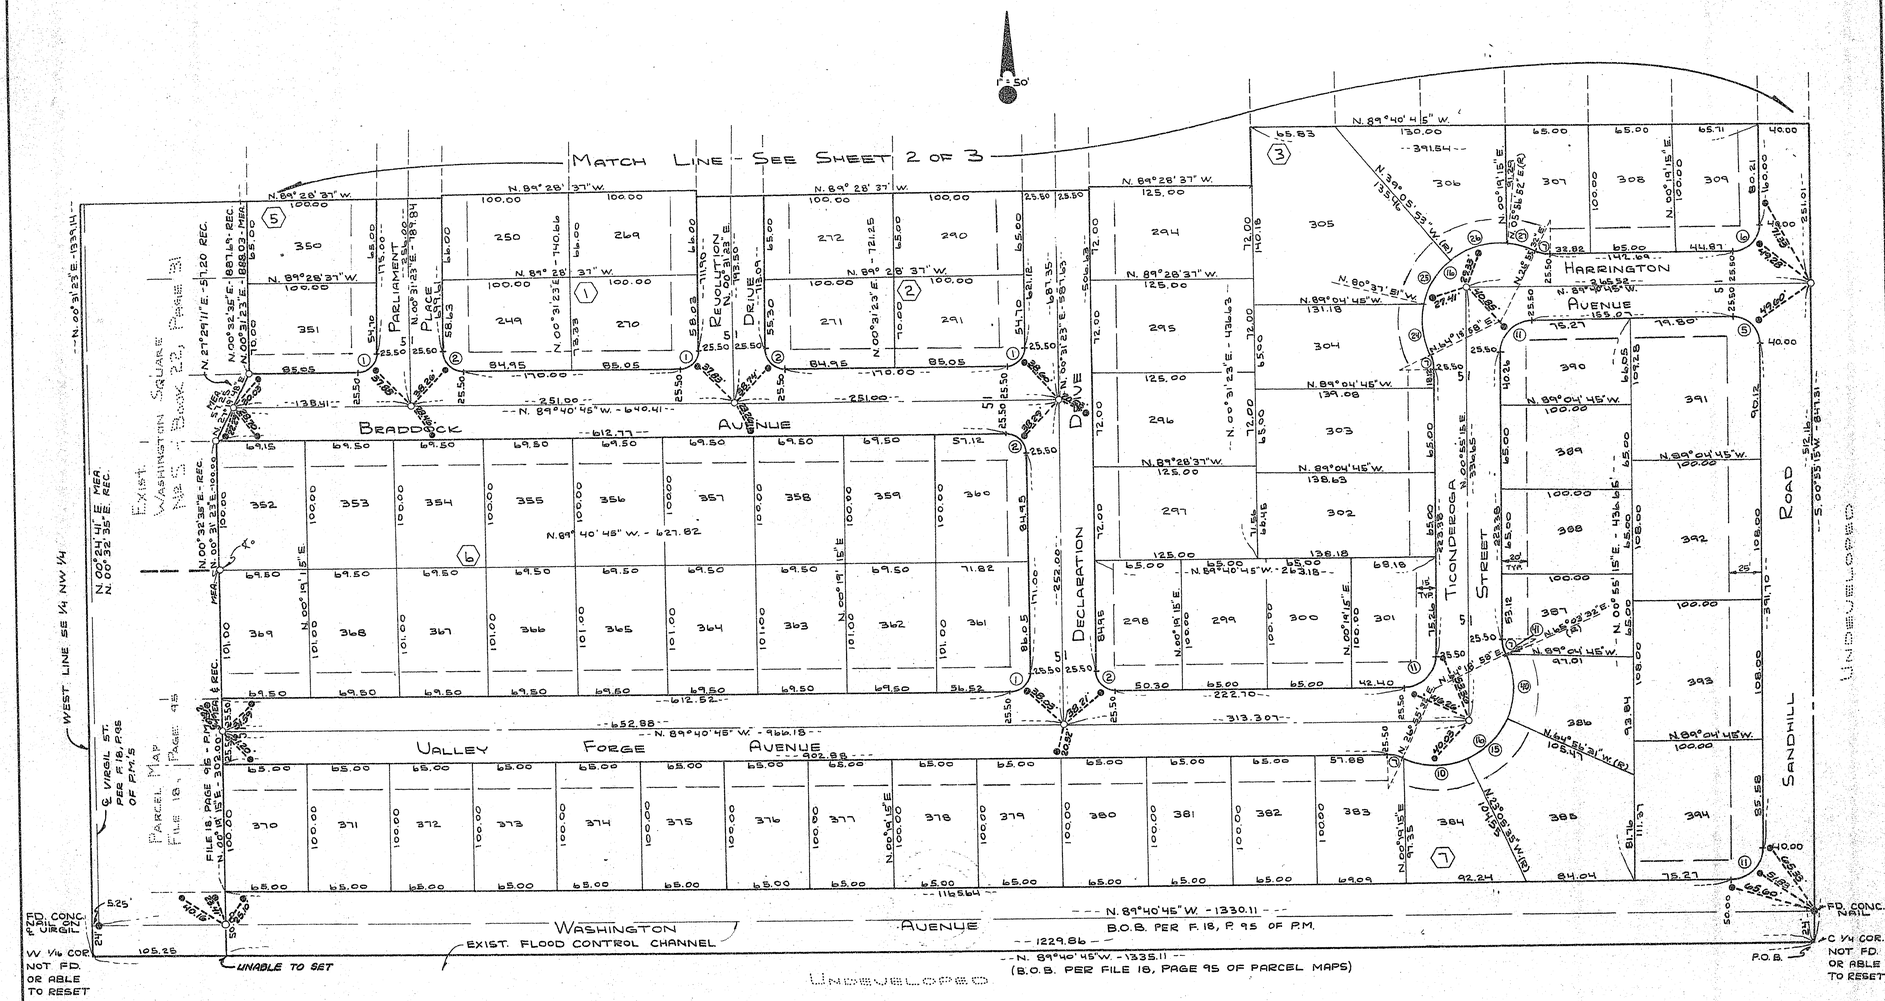

LEGEND

- ○ = REBAR & CAP R.L.S. 1871 W/ BRASS CAP REFERENCES
- ② = CURVE NO.
- (7) = BLOCK NO.
- 300 = LOT NO.
- ● = FOUND MONUMENT
- MEA. = MEASURED
- REC. = RECORD
- — — = 20' FRONT & 15' SIDE YARD SETBACK (EXCEPT 25' FRONT YARD SETBACK ON SANDHILL ROAD)
- ● = BRASS CAP REFERENCE POINT

CURVE DATA

NO.	DELTA	RADIUS	LENGTH	TANGENT
1	89°47'52"	15.00	23.51	14.95
2	90°12'08"	15.00	23.61	15.05
3	91°02'15"	15.00	23.83	15.27
4	88°57'45"	15.00	23.29	14.73
5	90°36'00"	20.00	31.63	20.21
6	89°24'00"	20.00	31.21	19.79
7	26°36'17"	25.00	11.61	5.91
8	90°00'00"	15.00	23.56	15.00
10	50°01'07"	60.00	52.38	27.99
11	89°24'00"	25.00	39.01	24.74
12	88°57'45"	25.00	38.82	24.55
13	34°47'46"	25.00	16.06	8.32
14	54°14'29"	25.00	23.67	12.80
15	41°50'56"	60.00	43.82	22.94
16	142°36'34"	60.00	149.34	177.31
18	142°10'19"	60.00	148.06	176.11
19	90°00'20"	60.00	94.25	60.01
20	107°27'03"	60.00	112.52	81.76
24	35°03'11"	60.00	36.71	18.95
25	41°31'56"	60.00	43.49	22.75
26	45°02'46"	60.00	47.17	24.86
27	20°56'40"	60.00	21.97	11.11
29	19°38'53"	25.00	8.57	4.33
31	09°32'15"	60.00	9.99	5.01
32	51°21'38"	60.00	53.78	28.65
33	46°33'10"	60.00	48.75	25.81
34	30°54'15"	60.00	32.36	16.59
35	53°42'53"	60.00	56.25	30.38
36	05°23'12"	60.00	5.64	2.82
37	43°06'41"	60.00	45.18	23.72
38	46°33'10"	60.00	48.75	25.81
39	52°28'28"	60.00	54.95	29.57
40	49°59'57"	60.00	52.36	27.98
41	00°44'34"	60.00	0.78	0.39

*NOTE:
THERE WILL BE NO VEHICULAR ACCESS TO THE REAR OF LOTS 370 - 385 FROM WASHINGTON AVENUE.

LOTS 391-394 SHALL HAVE CIRCULAR DRIVEWAYS.

CERTIFICATE OF MONUMENTATION

I, NELSON E. MYER, DO HEREBY CERTIFY THAT THE MONUMENTS AND TIES SHOWN HEREON HAVE BEEN SET AND ARE TRUE AND CORRECT.

Nelson E. Myer — 8/31/61
NELSON E. MYER — DATE
R.L.S. 1871

Registered Land Surveyor — State of Nevada — NELSON E. MYER — No. 1871

BOOK 26 PAGE 49

058-3275-7