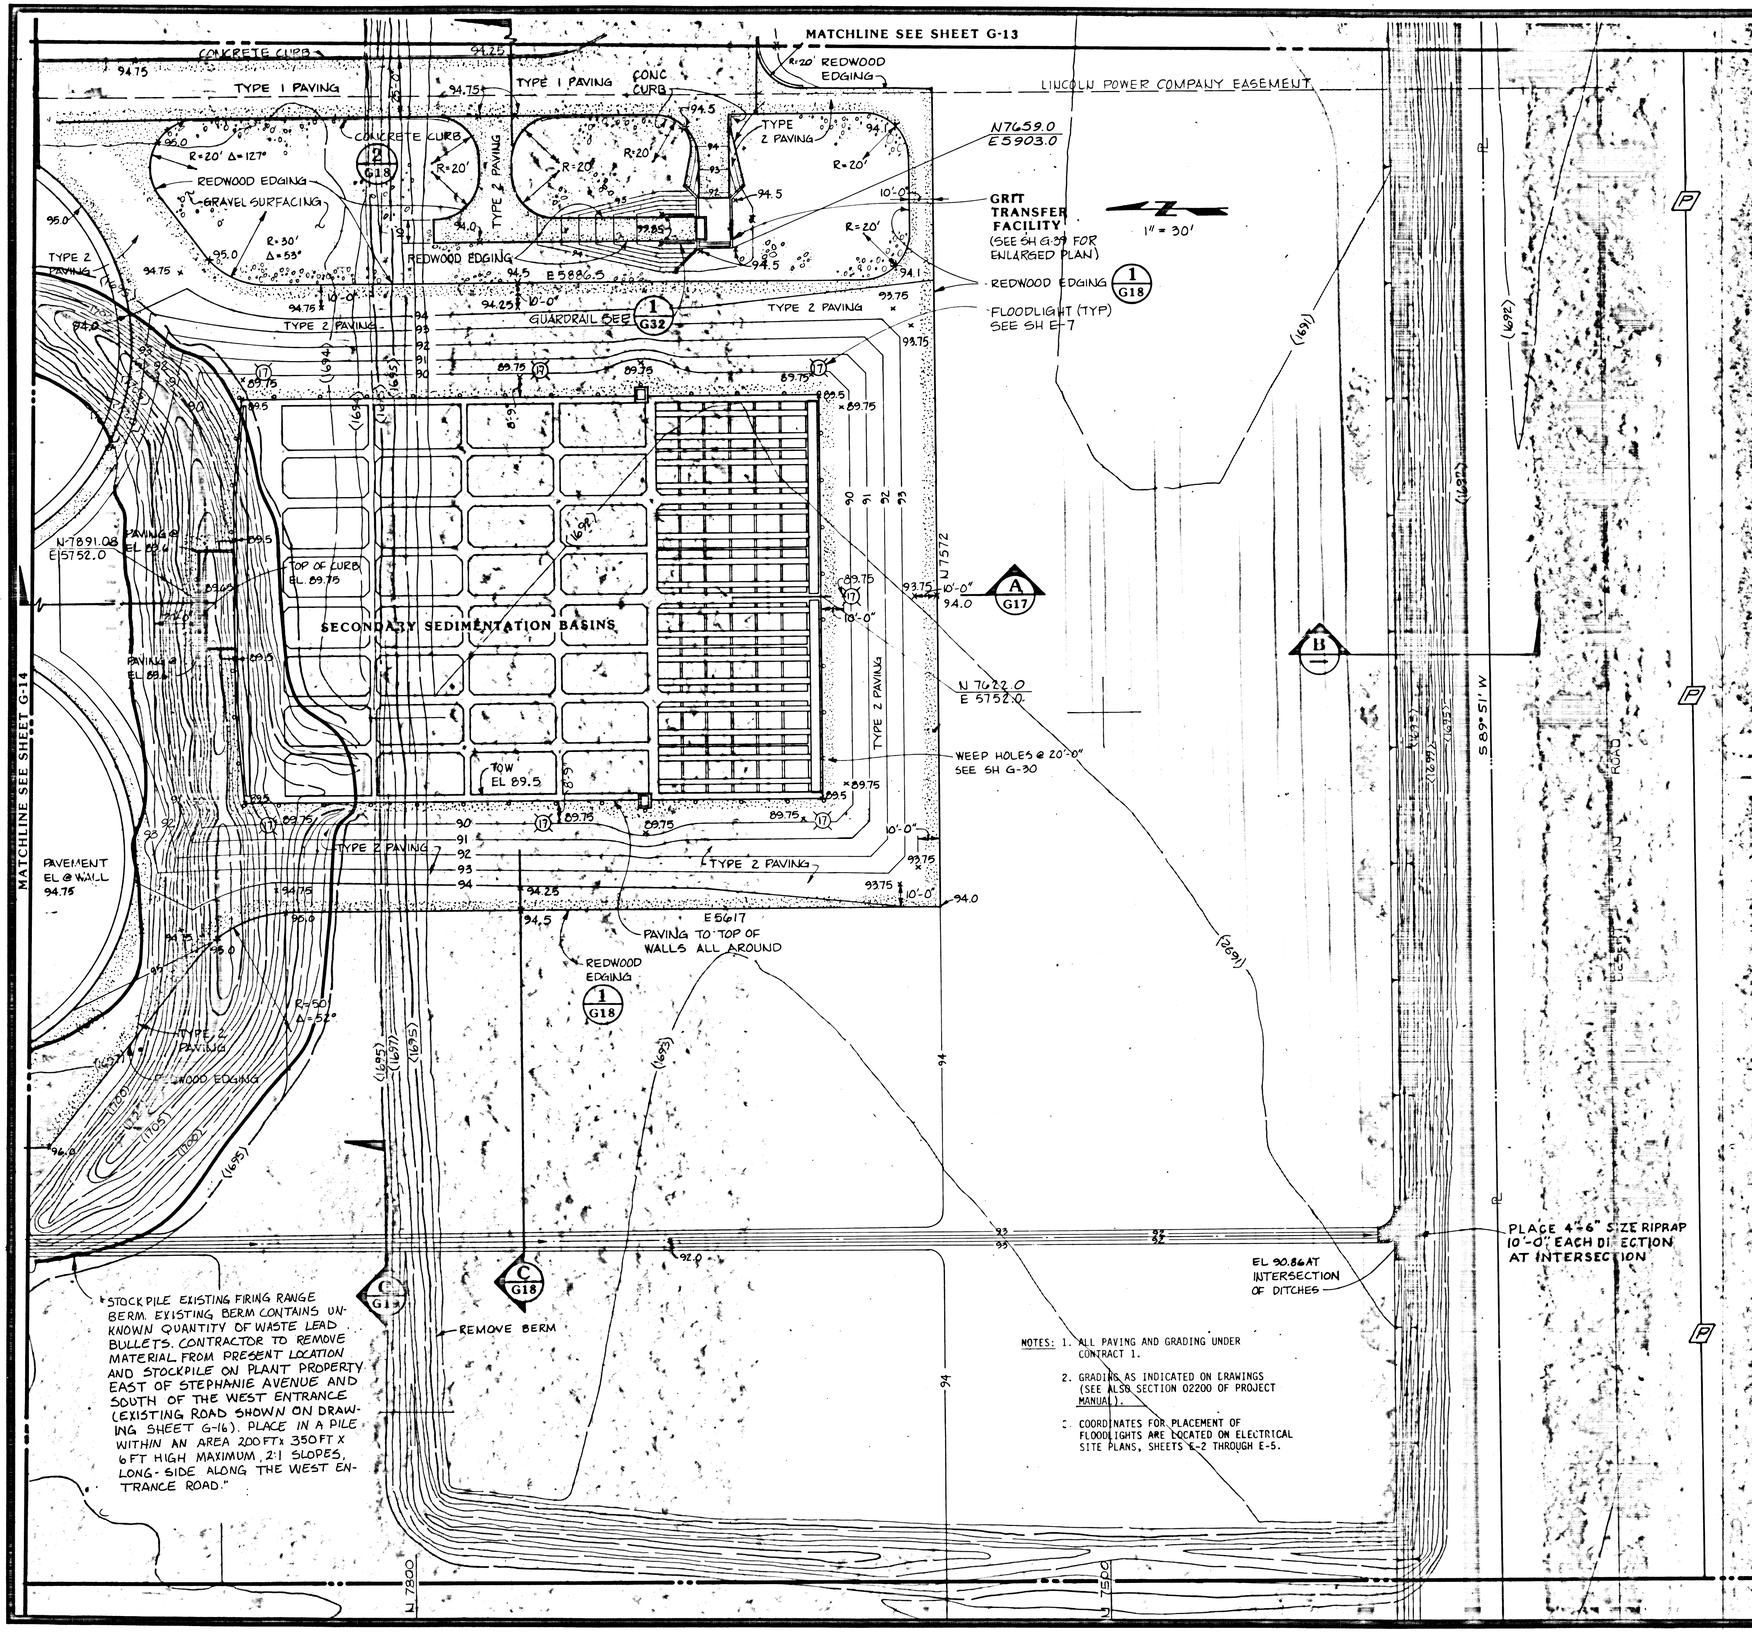

NOTES:
1. ALL PAVING AND GRADING UNDER CONTRACT 1.
2. GRADING AS INDICATED ON DRAWINGS (SEE ALSO SECTION 02200 OF PROJECT MANUAL).
3. COORDINATES FOR PLACEMENT OF FLOODLIGHTS ARE LOCATED ON ELECTRICAL SITE PLANS, SHEETS E-2 THROUGH E-5.

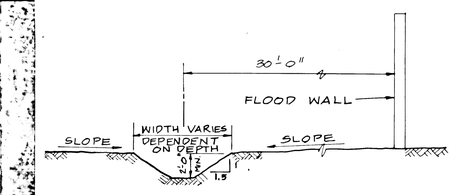

TYPICAL SECTION B/—
N.T.S.

PGT 4	PGT 4
NSW 4	NSW 4
AP 4	AP 4
ECW 4	ECW 4

No.	By	Revision Description	Date
1		CORRECTED ACCORDING TO CONSTRUCTION RECORDS	8-92

Job No. 740.11
Designed GSC
Drawn TDB
Checked JBG
Approved DAP
Date 12/9/88

City of Las Vegas
WASTEWATER TREATMENT PLANT
Contract No. 1
Main Plant Expansion

PAVING & GRADING PLAN - 4

Sheet 15
G-15
of 164

311.21

6-1-15