NOTE: 1. 4'-0" x 8'-0" x 3/4" PAINTED PLYWOOD BACKBOARD FOR TEL EQUIPMENT. BRING ALL TEL EQUIPMENT CONDUITS DOWN OR UP TO PLYWOOD BACKBOARD & STRAP TO PLYWOOD. INSTALL BUSHINGS ON CONDUITS.

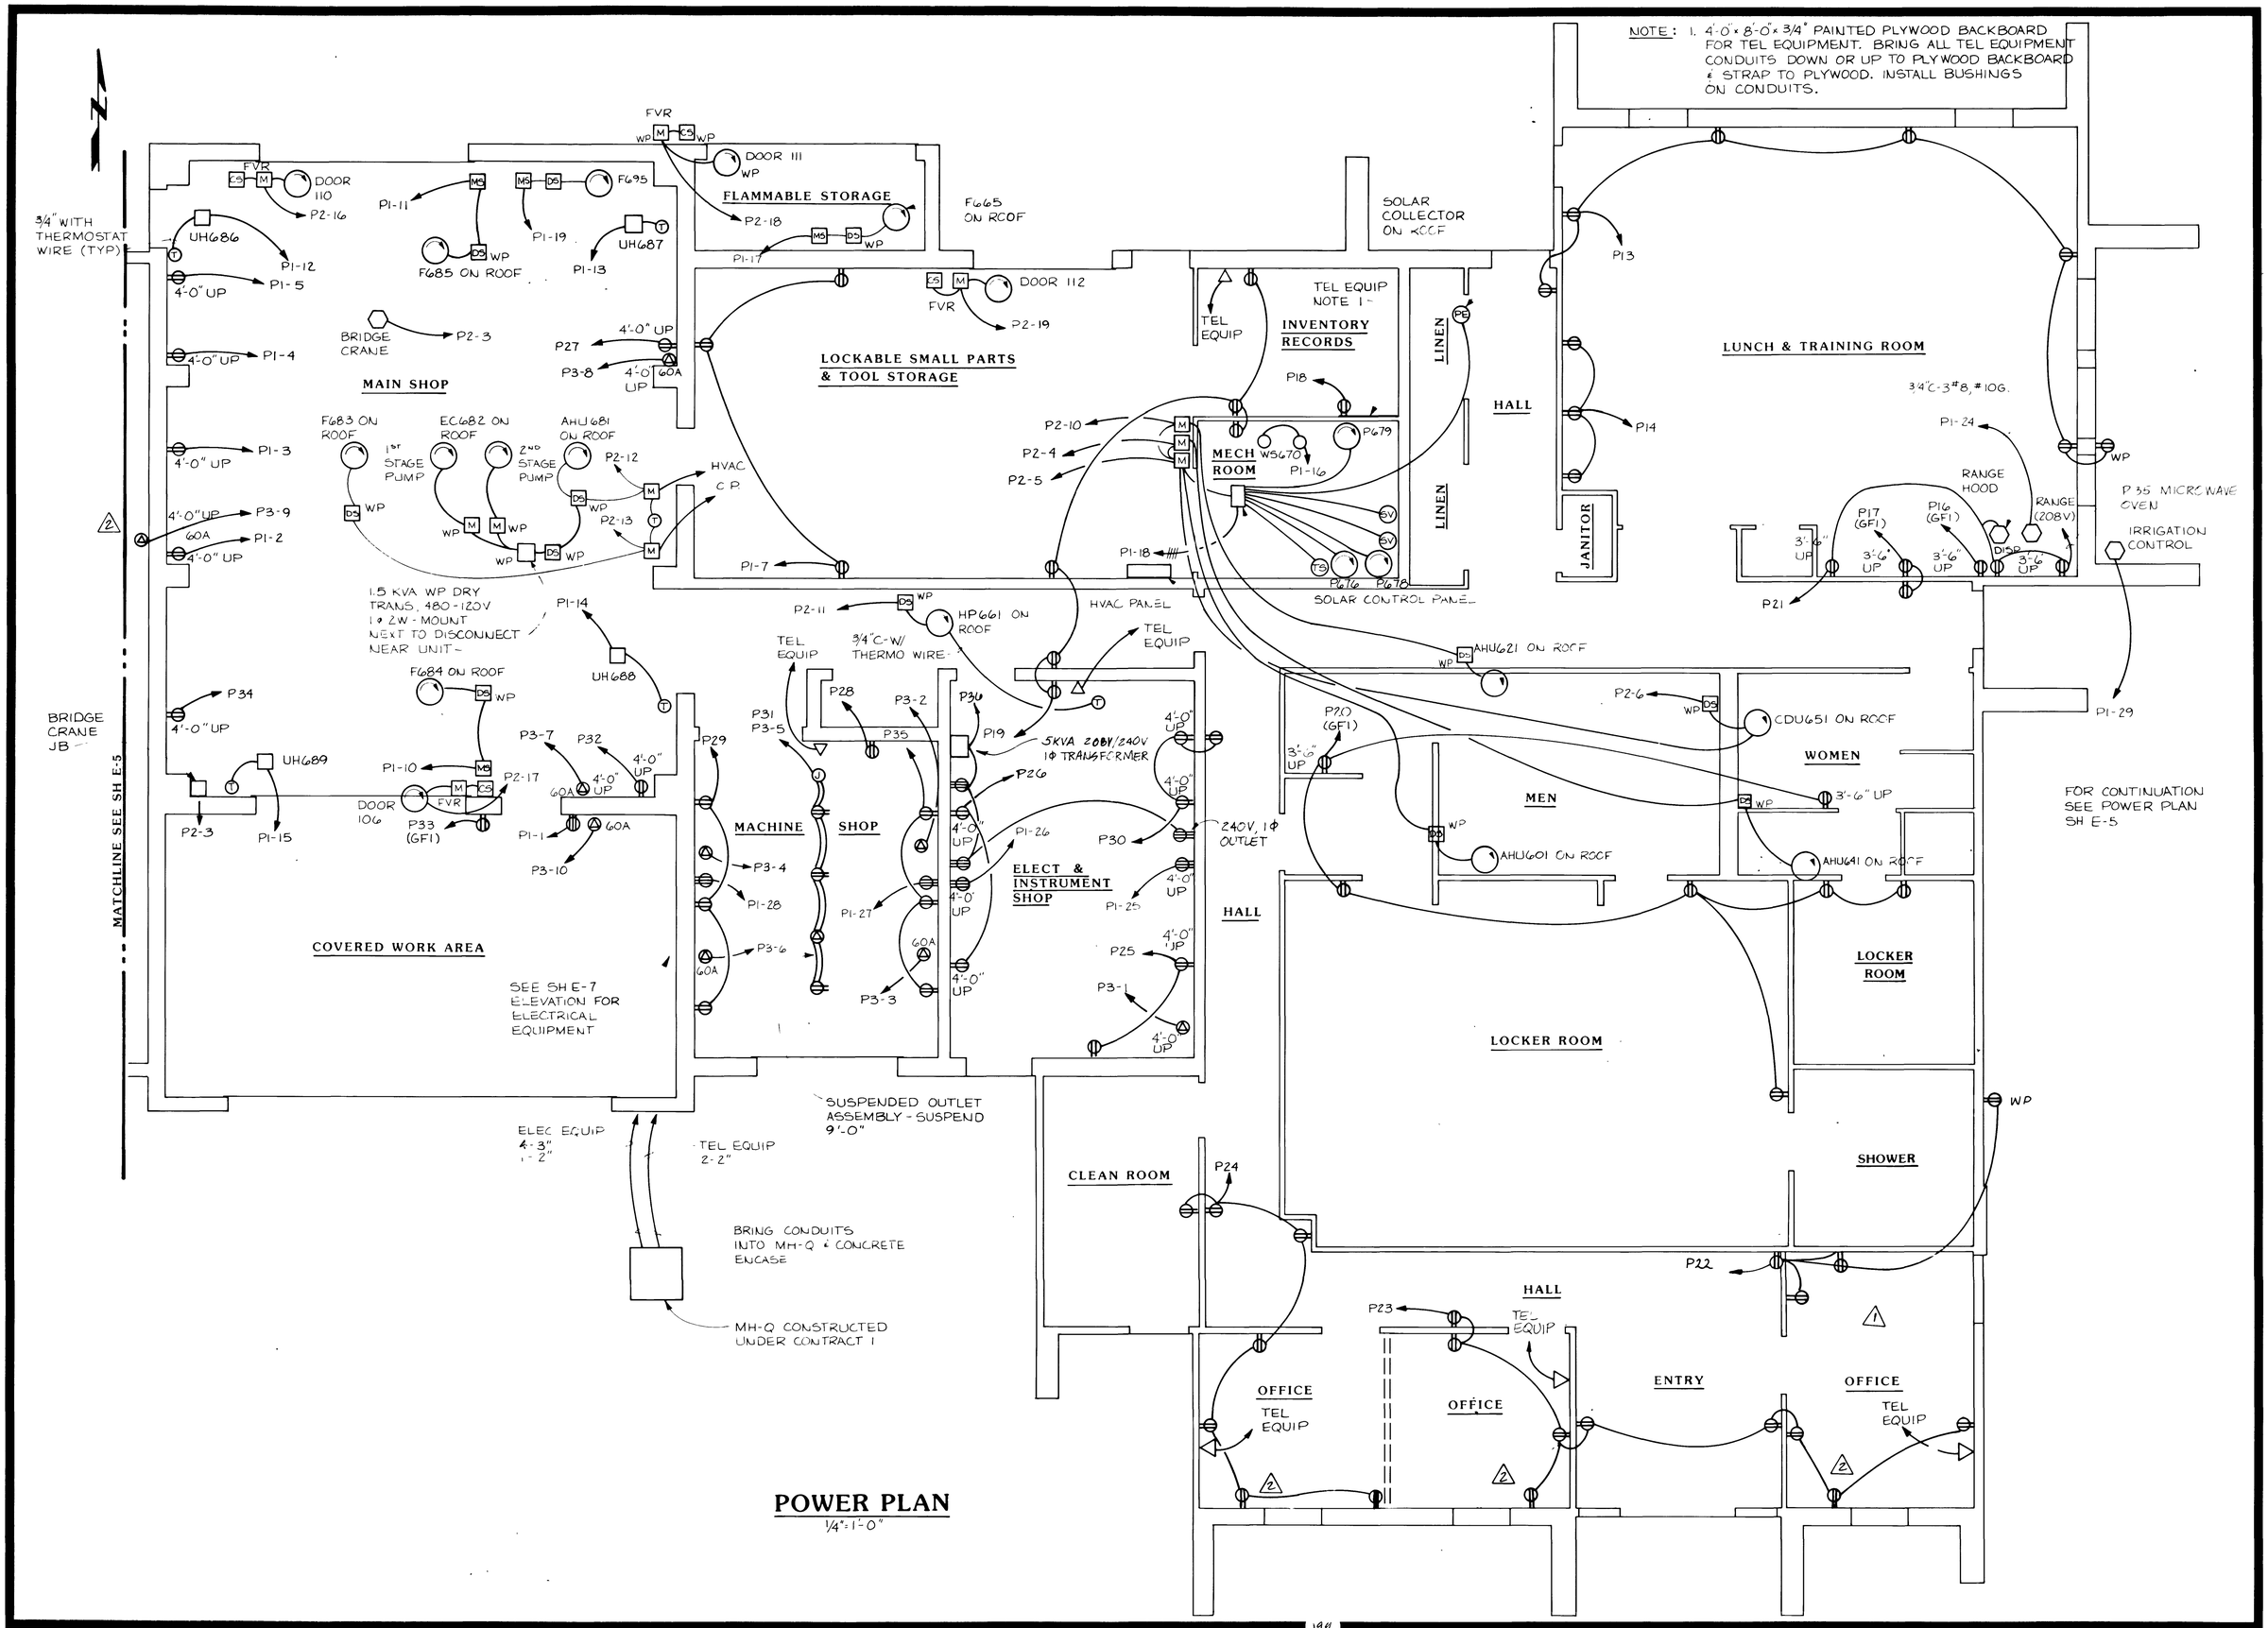

POWER PLAN

1/4" = 1'-0"

CULP/WESNER/CULP
CAMERON PARK, CALIFORNIA
SANTA ANA, CALIFORNIA DENVER, COLORADO

H D R
CH2M HILL, Inc.
Consulting Engineers

REGISTERED PROFESSIONAL ENGINEER
STATE OF NEVADA
WILLIAM E. KETLUCH
"ELECTRICAL"
No. 5637

Job No.	740.15
Designed	WEE
Drawn	WAVE
Checked	DWR
Approved	DAP
Date	4/24/89

No.	By	Revision Description	Date
1	WA	CO #2	3/90
2	WA	FO #13	7/89
		CORRECTED ACCORDING TO AS CONSTRUCTION RECORDS	

City of Las Vegas
WASTEWATER TREATMENT PLANT
Contract No. 5
Maintenance & Storage Buildings

MAINTENANCE BUILDING
POWER PLAN

Sheet 49
E-4
of 57

7-1-1989 311.25