




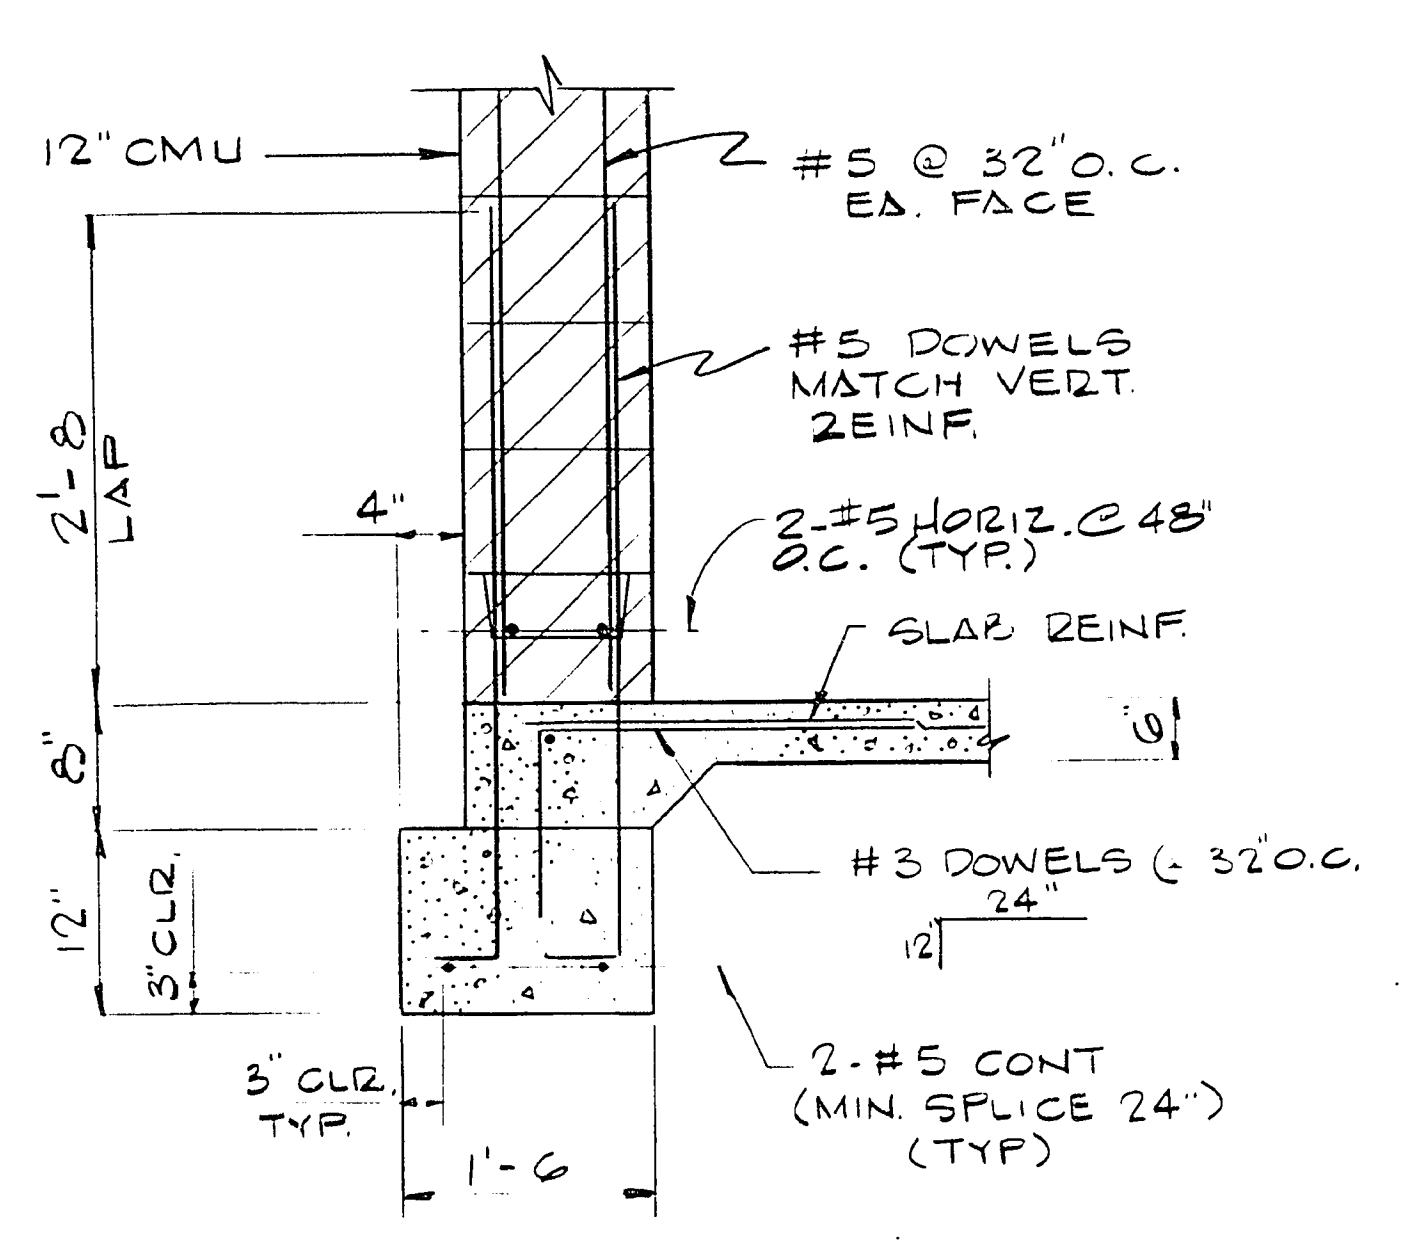


SECTION A
1" = 1'-0"

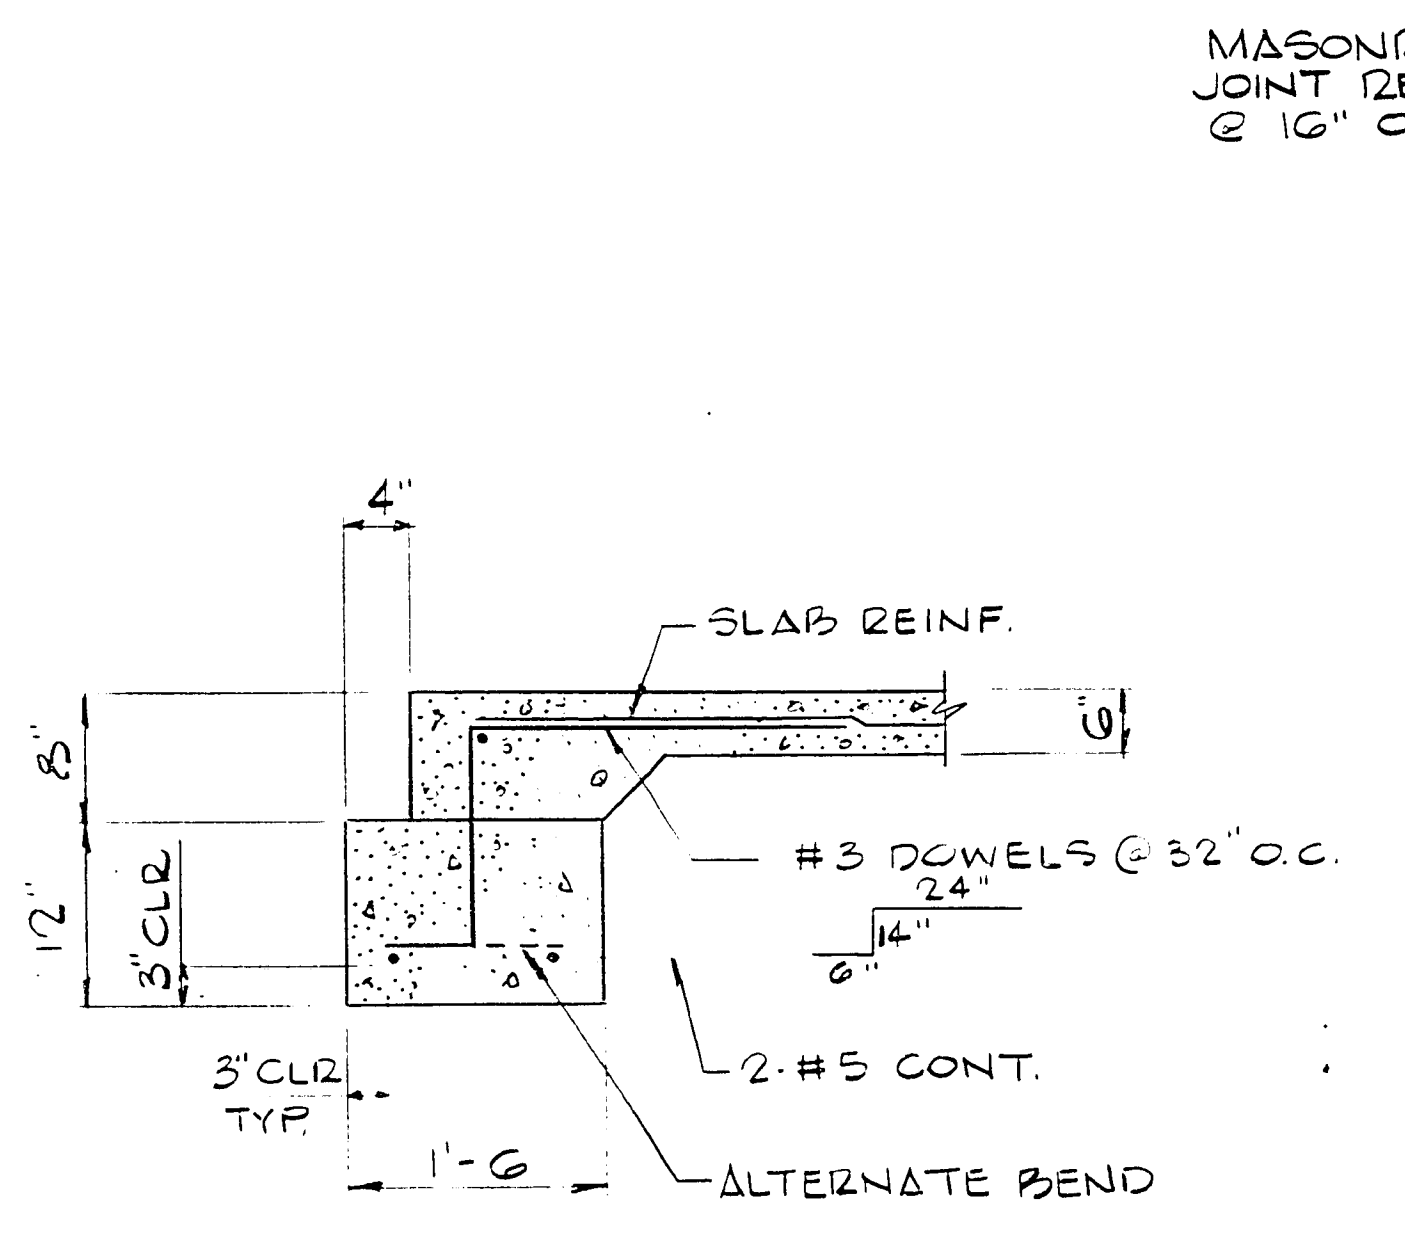


SECTION B
1" = 1'-0"

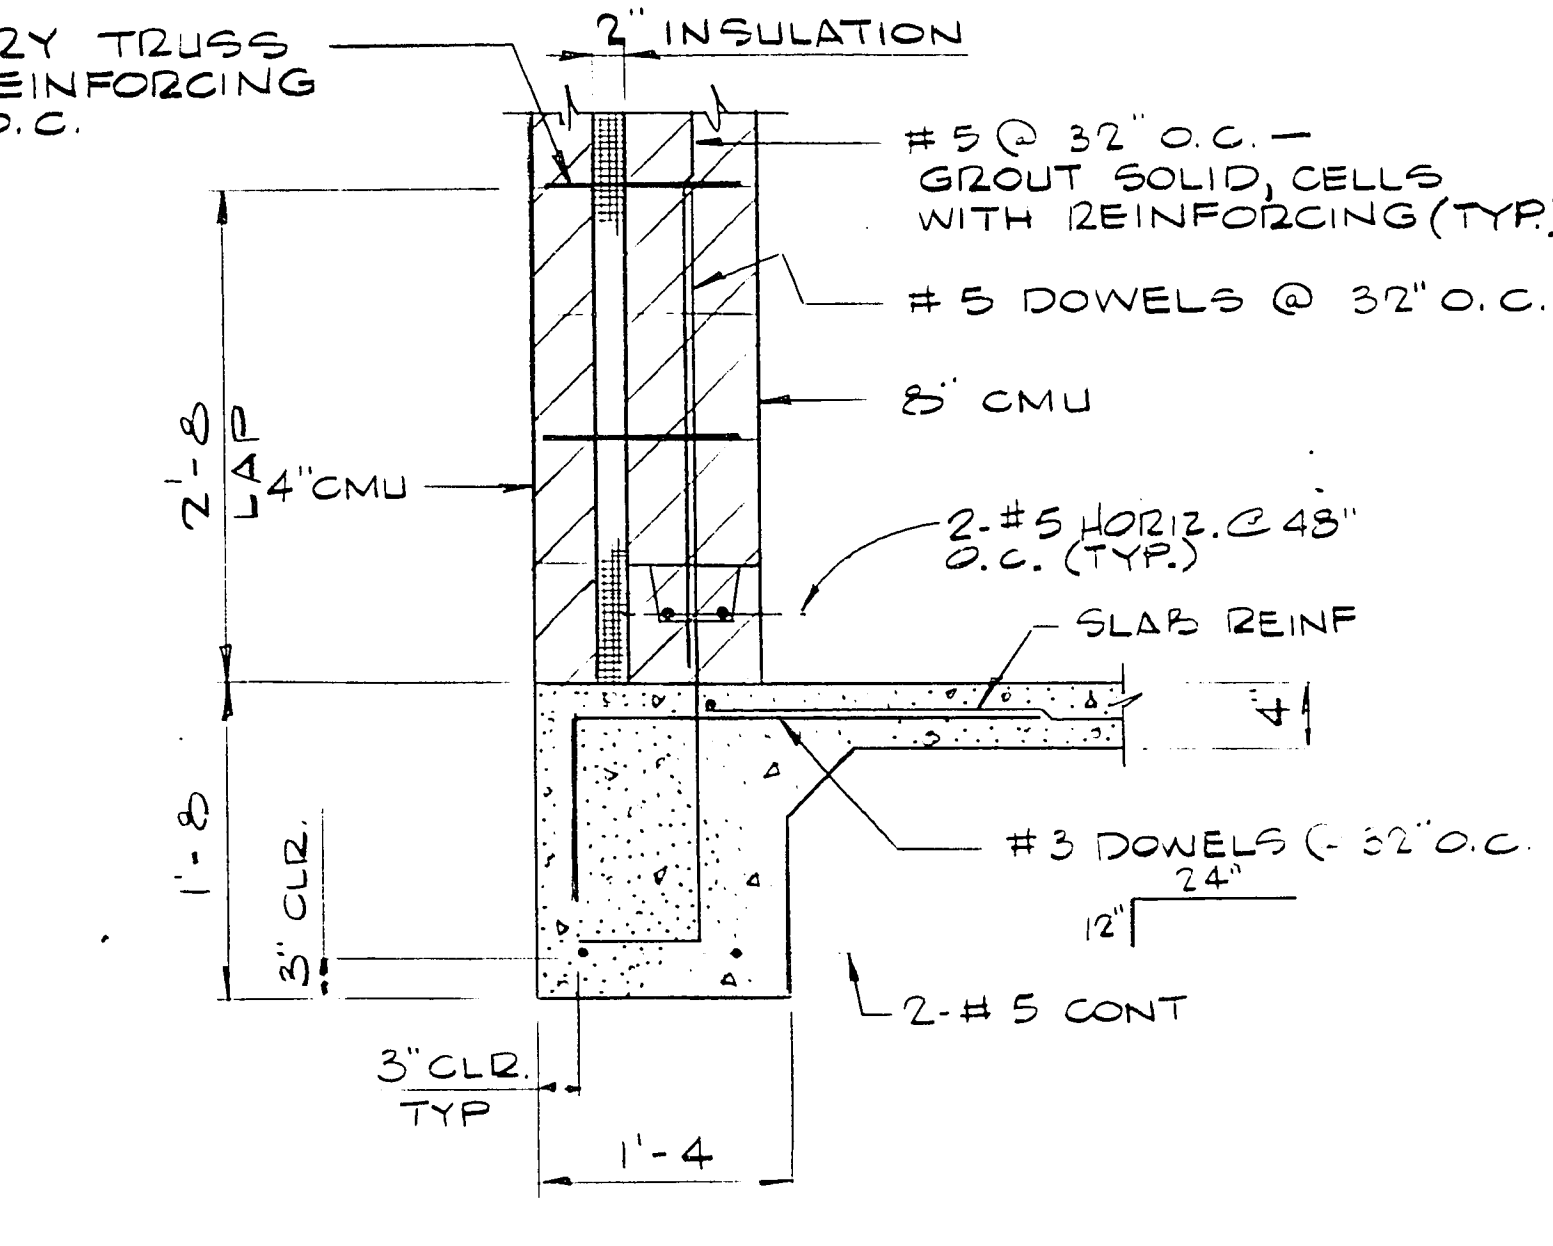


SECTION C
1" = 1'-0"

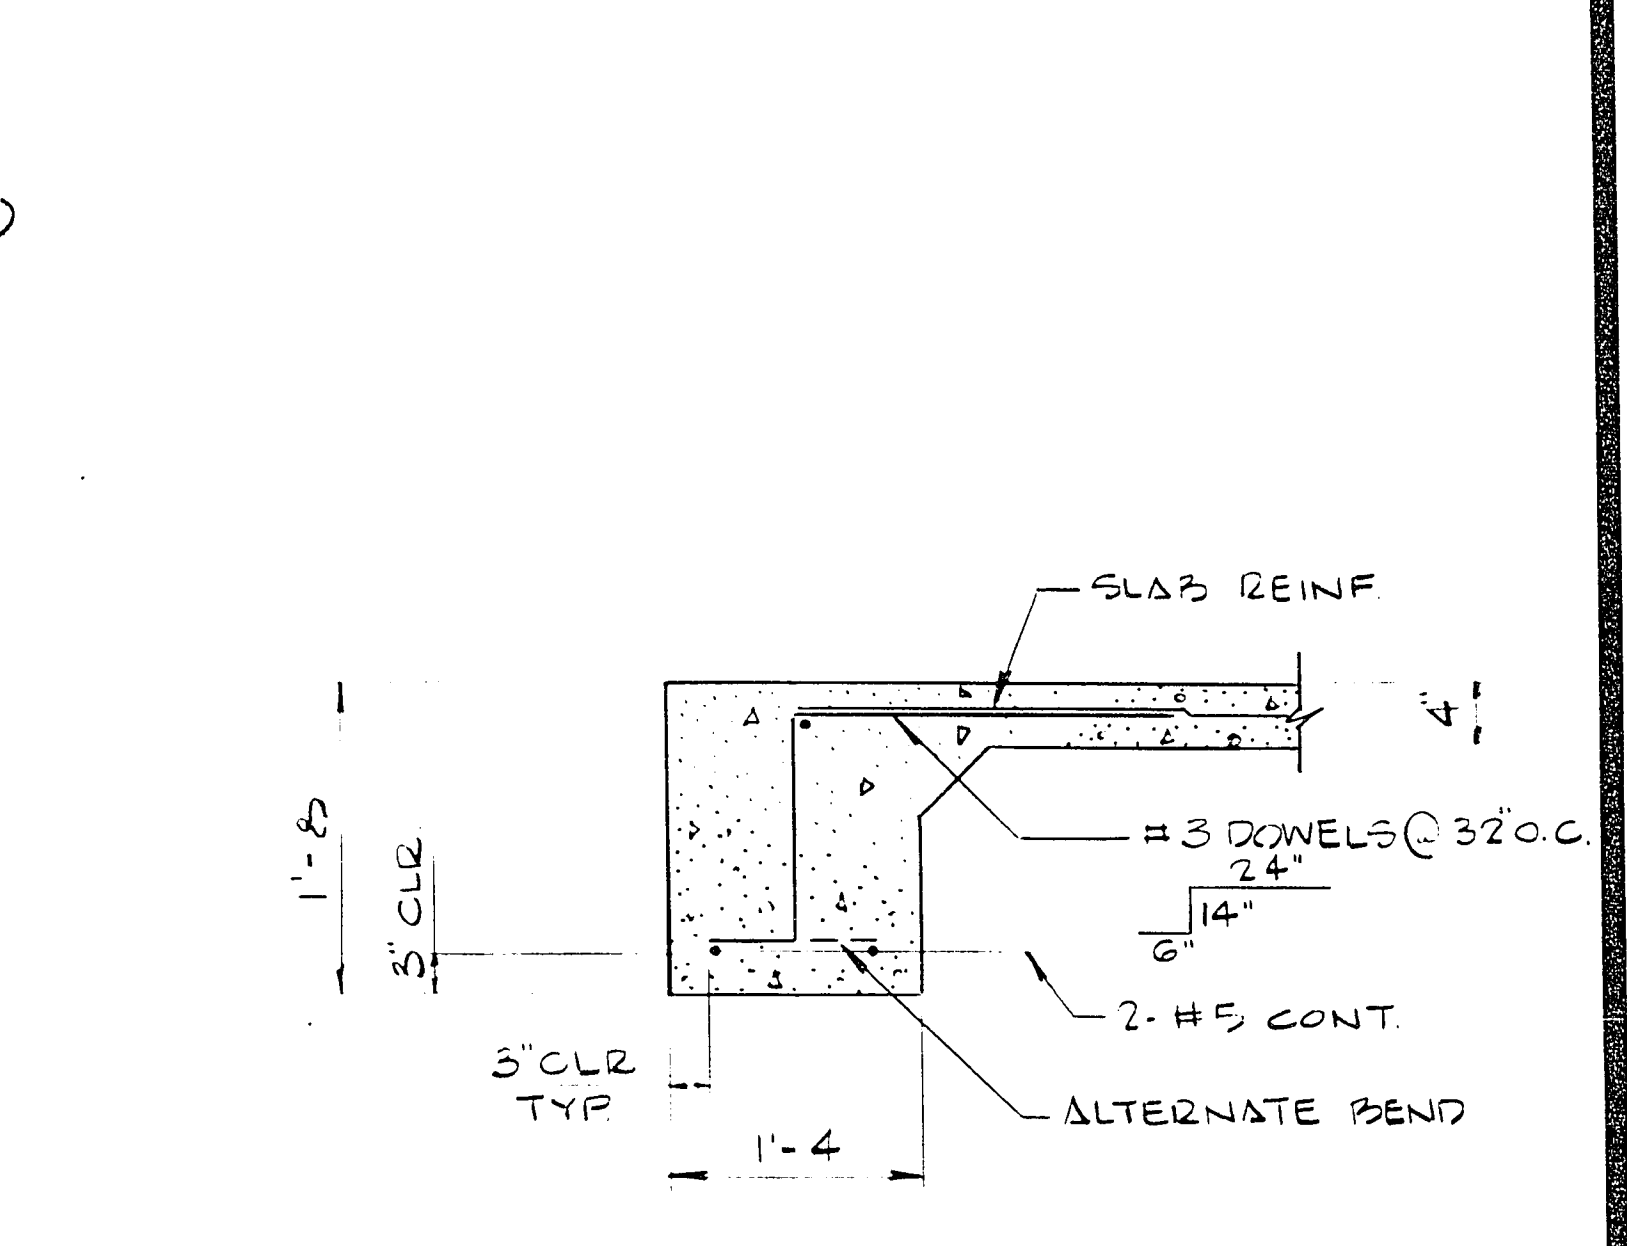


SECTION D
1" = 1'-0"

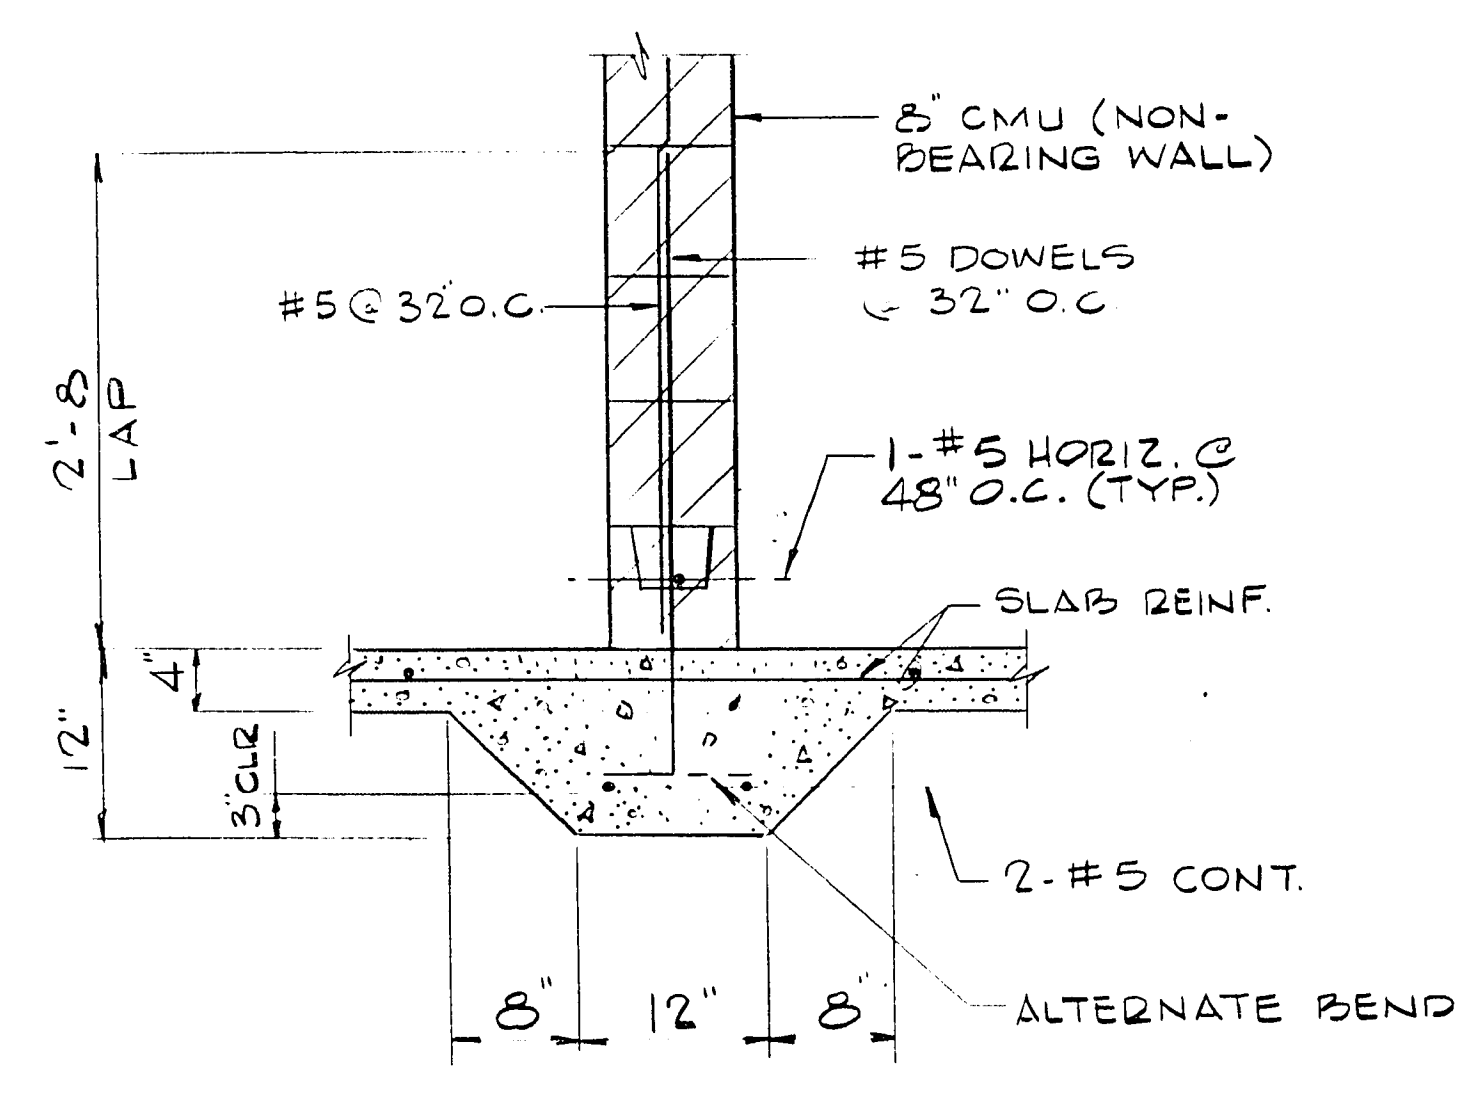


SECTION E
1" = 1'-0"

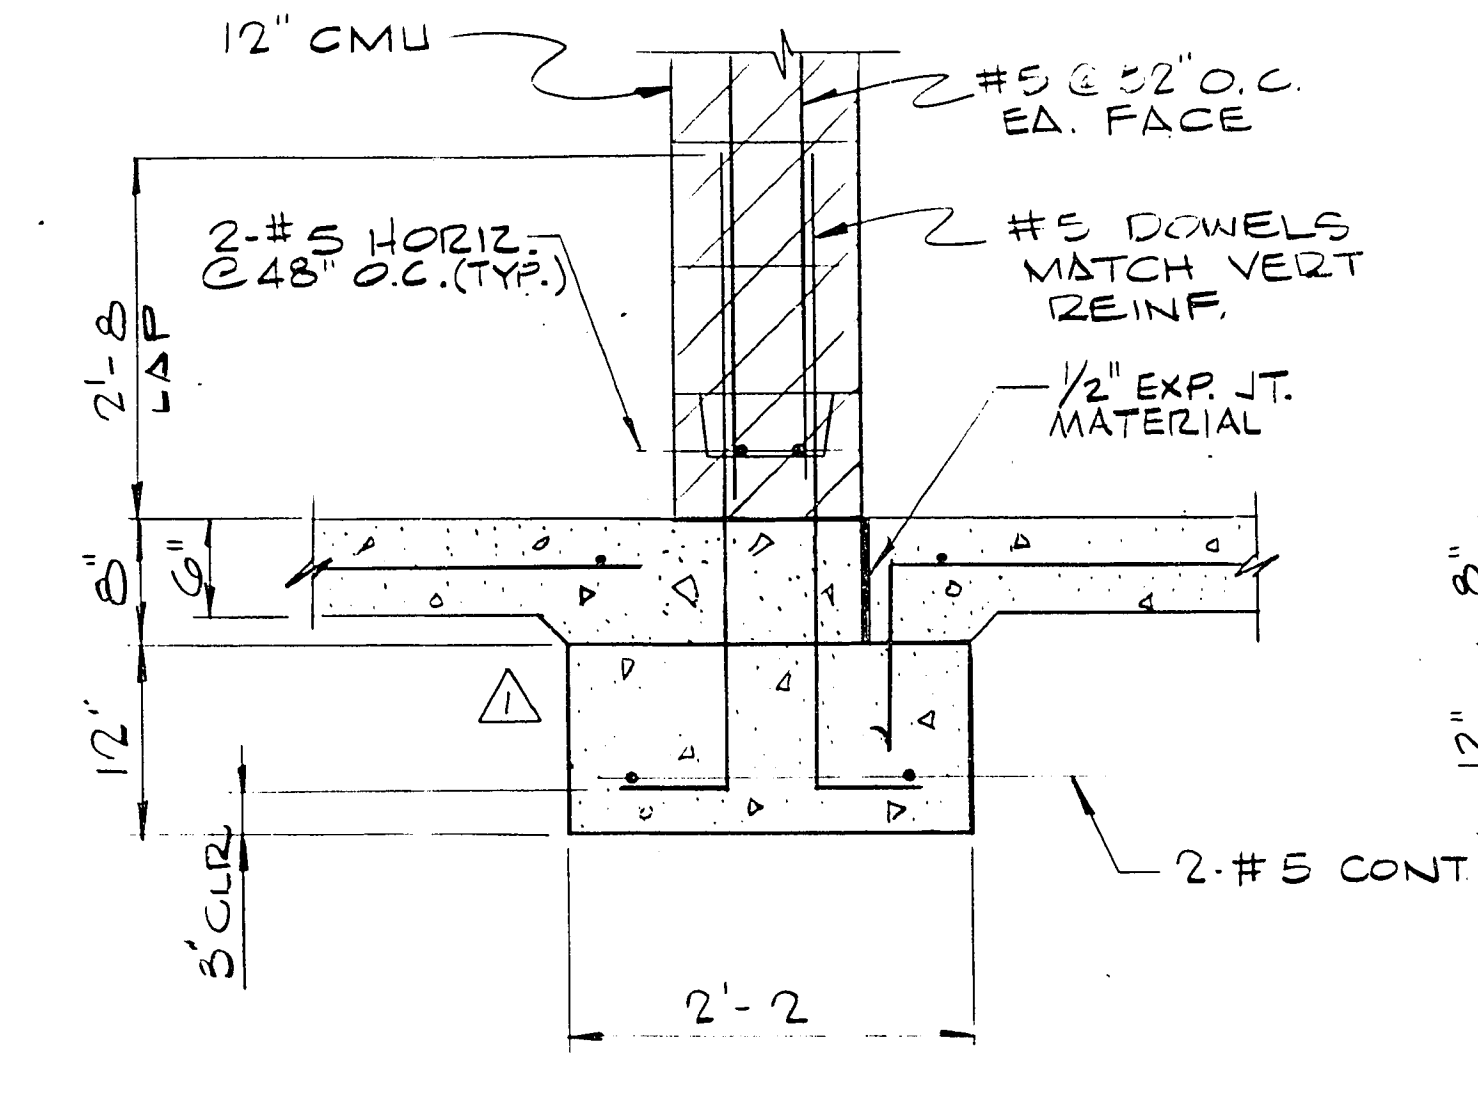


SECTION F
1" = 1'-0"

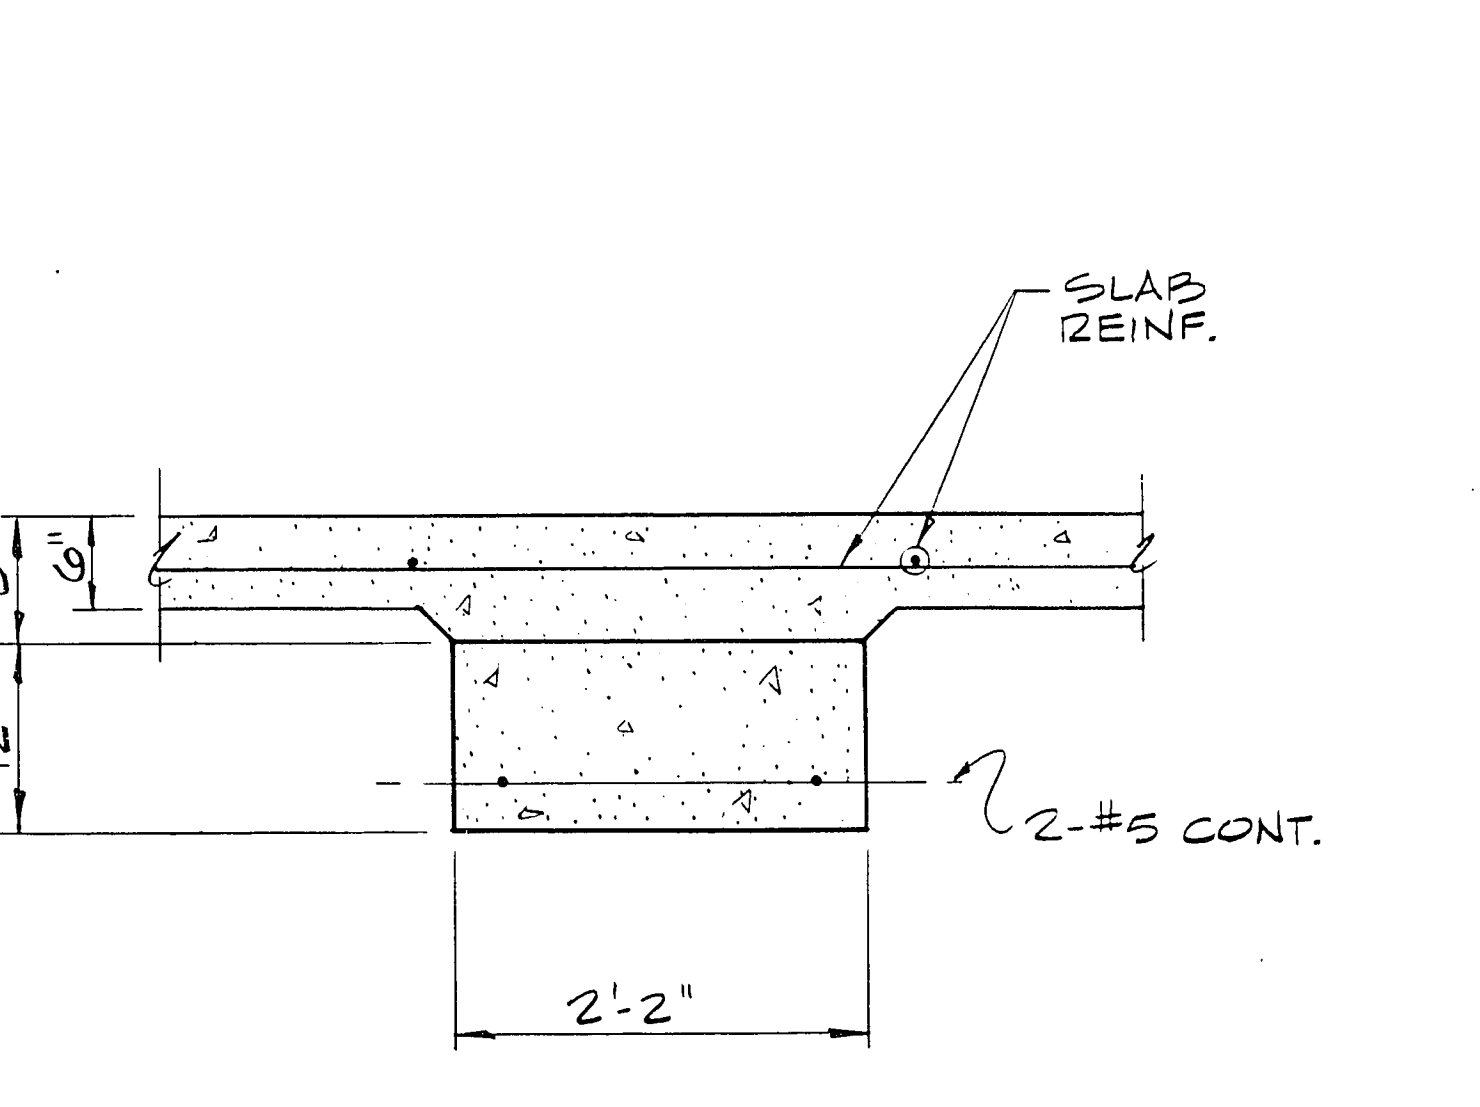


SECTION M
1" = 1'-0"

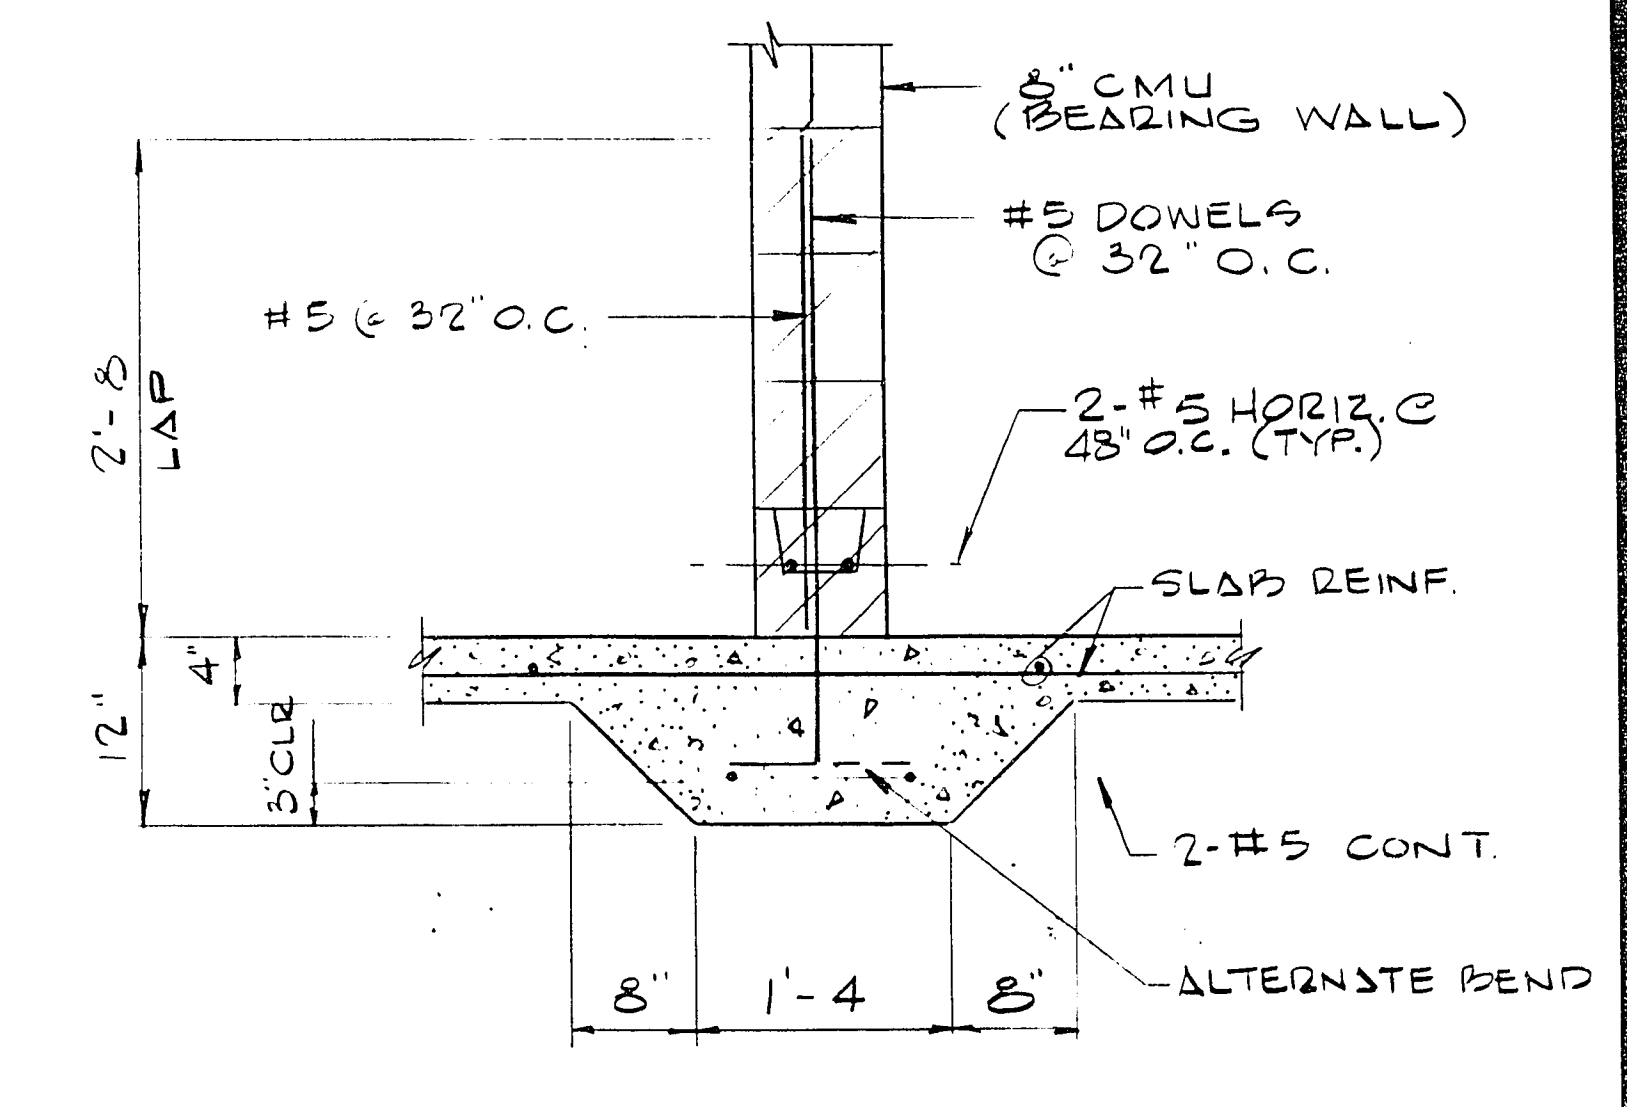


SECTION G
1" = 1'-0"

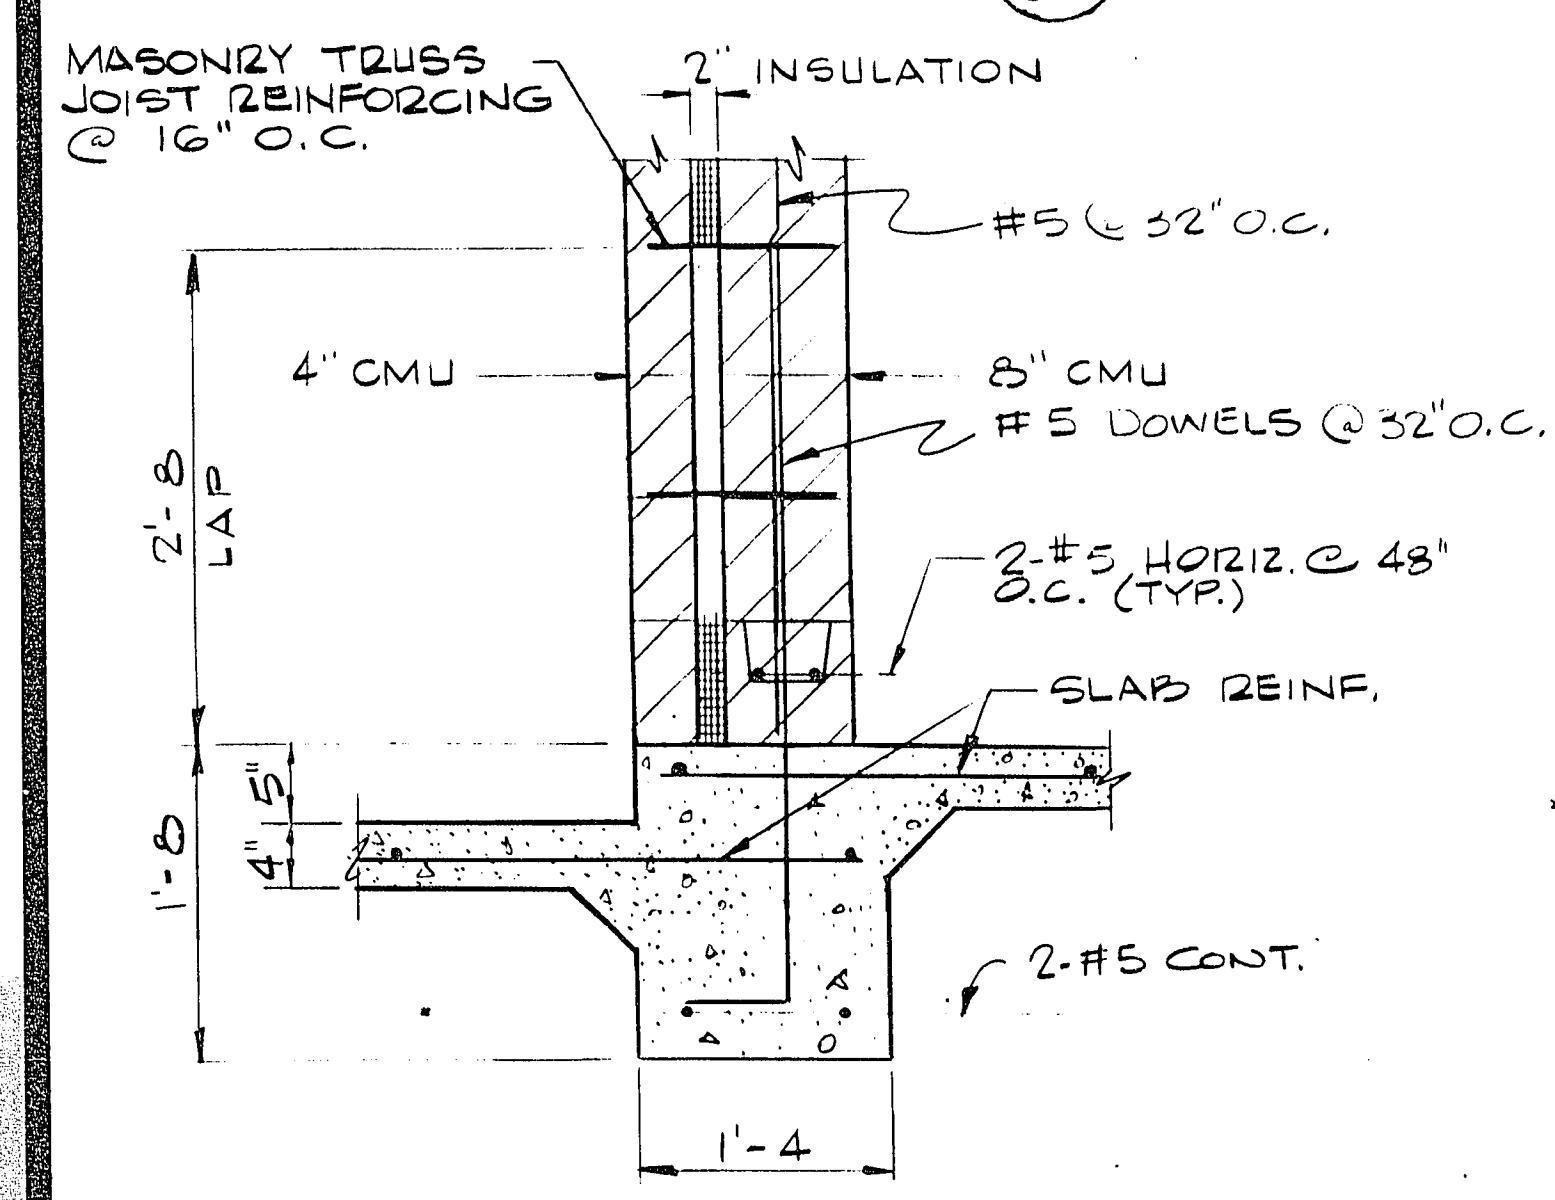


SECTION H
1" = 1'-0"

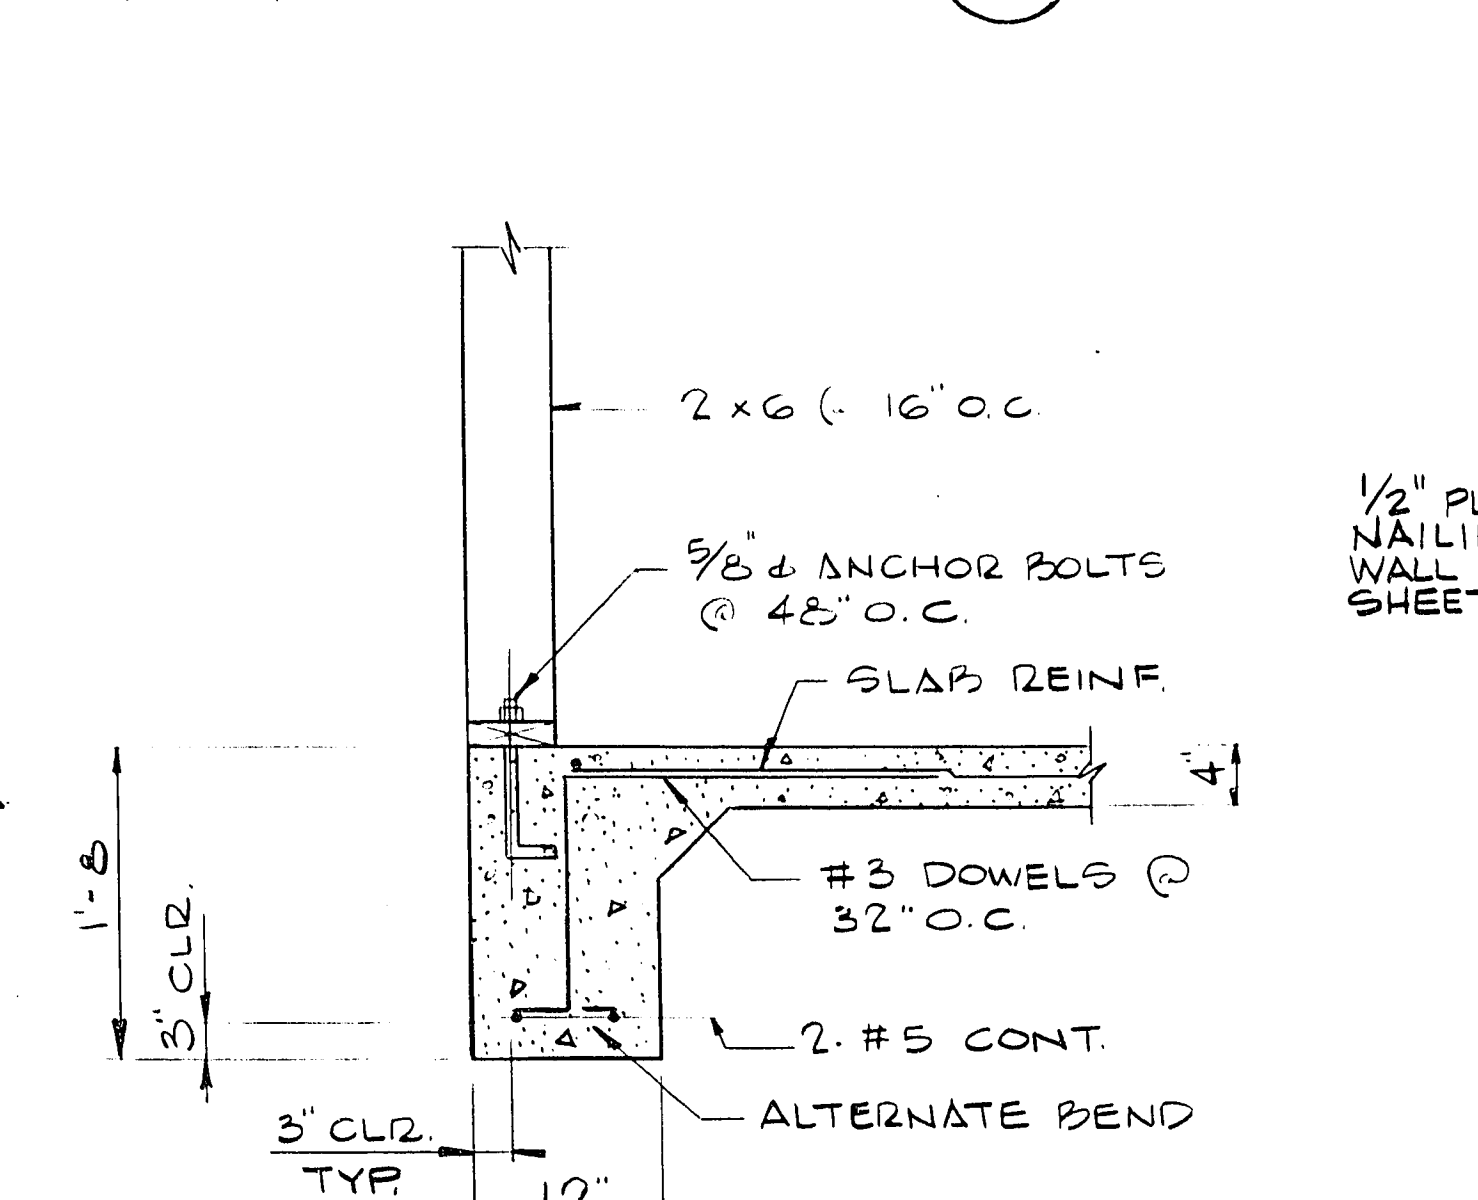

SECTION J
1" = 1'-0"

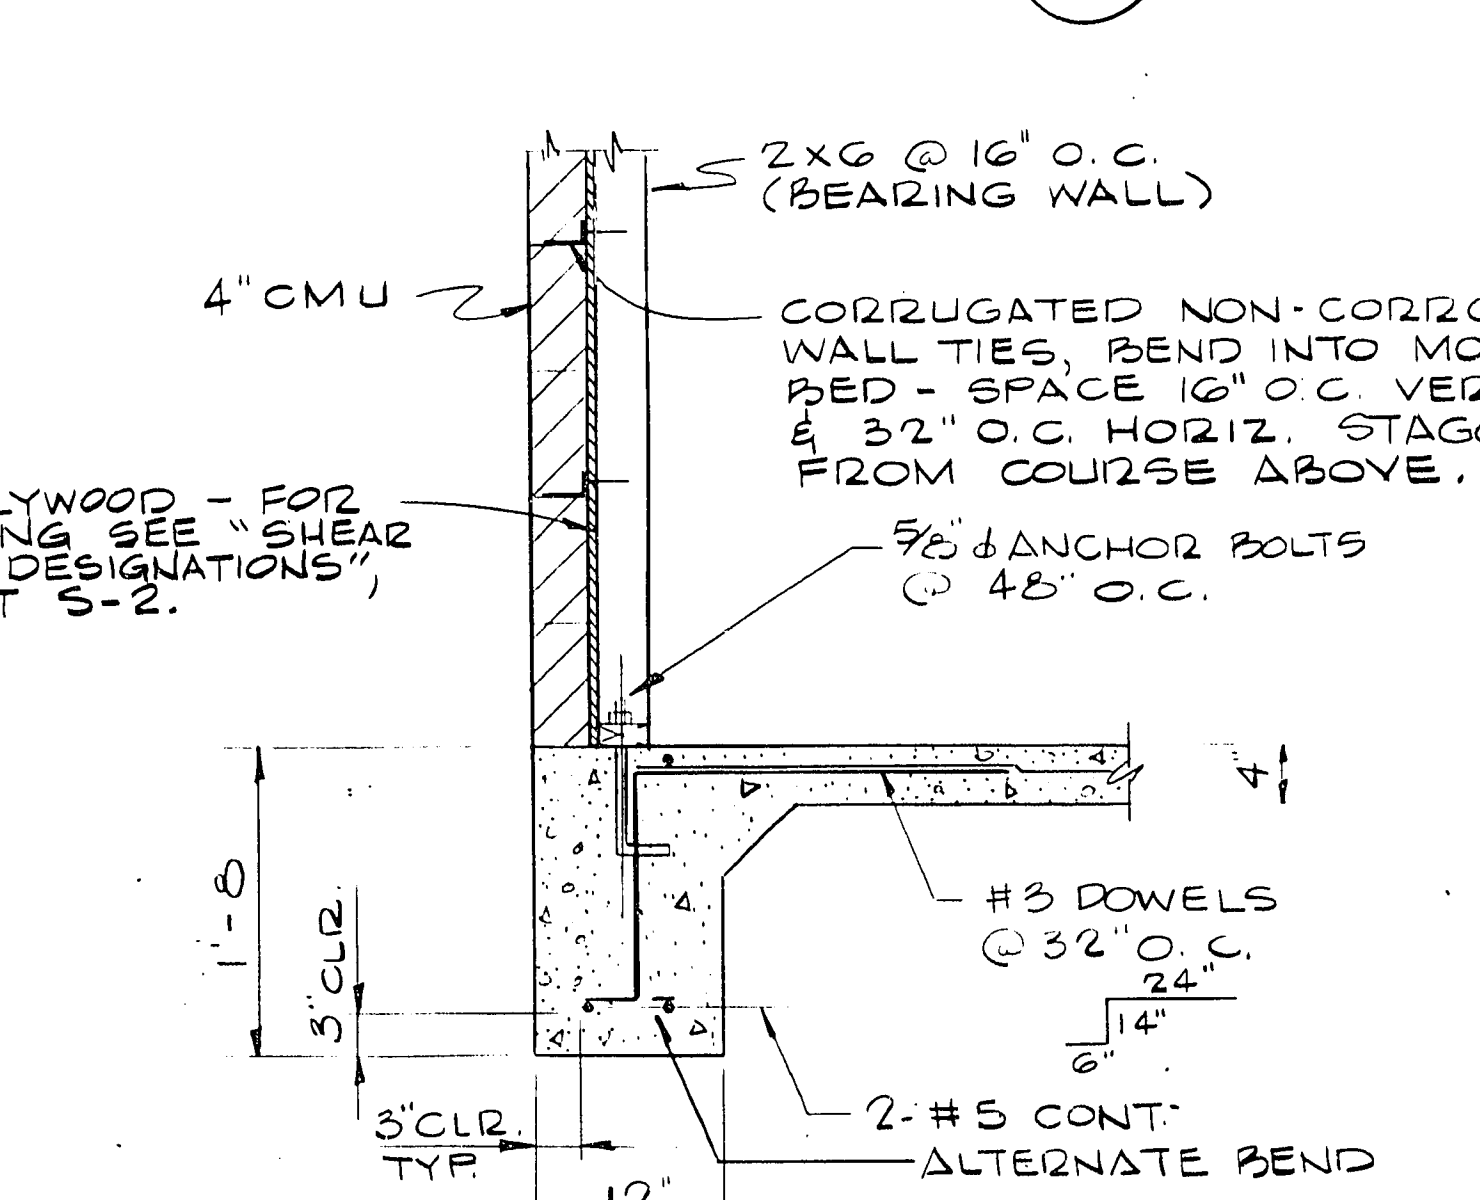

SECTION K
1" = 1'-0"

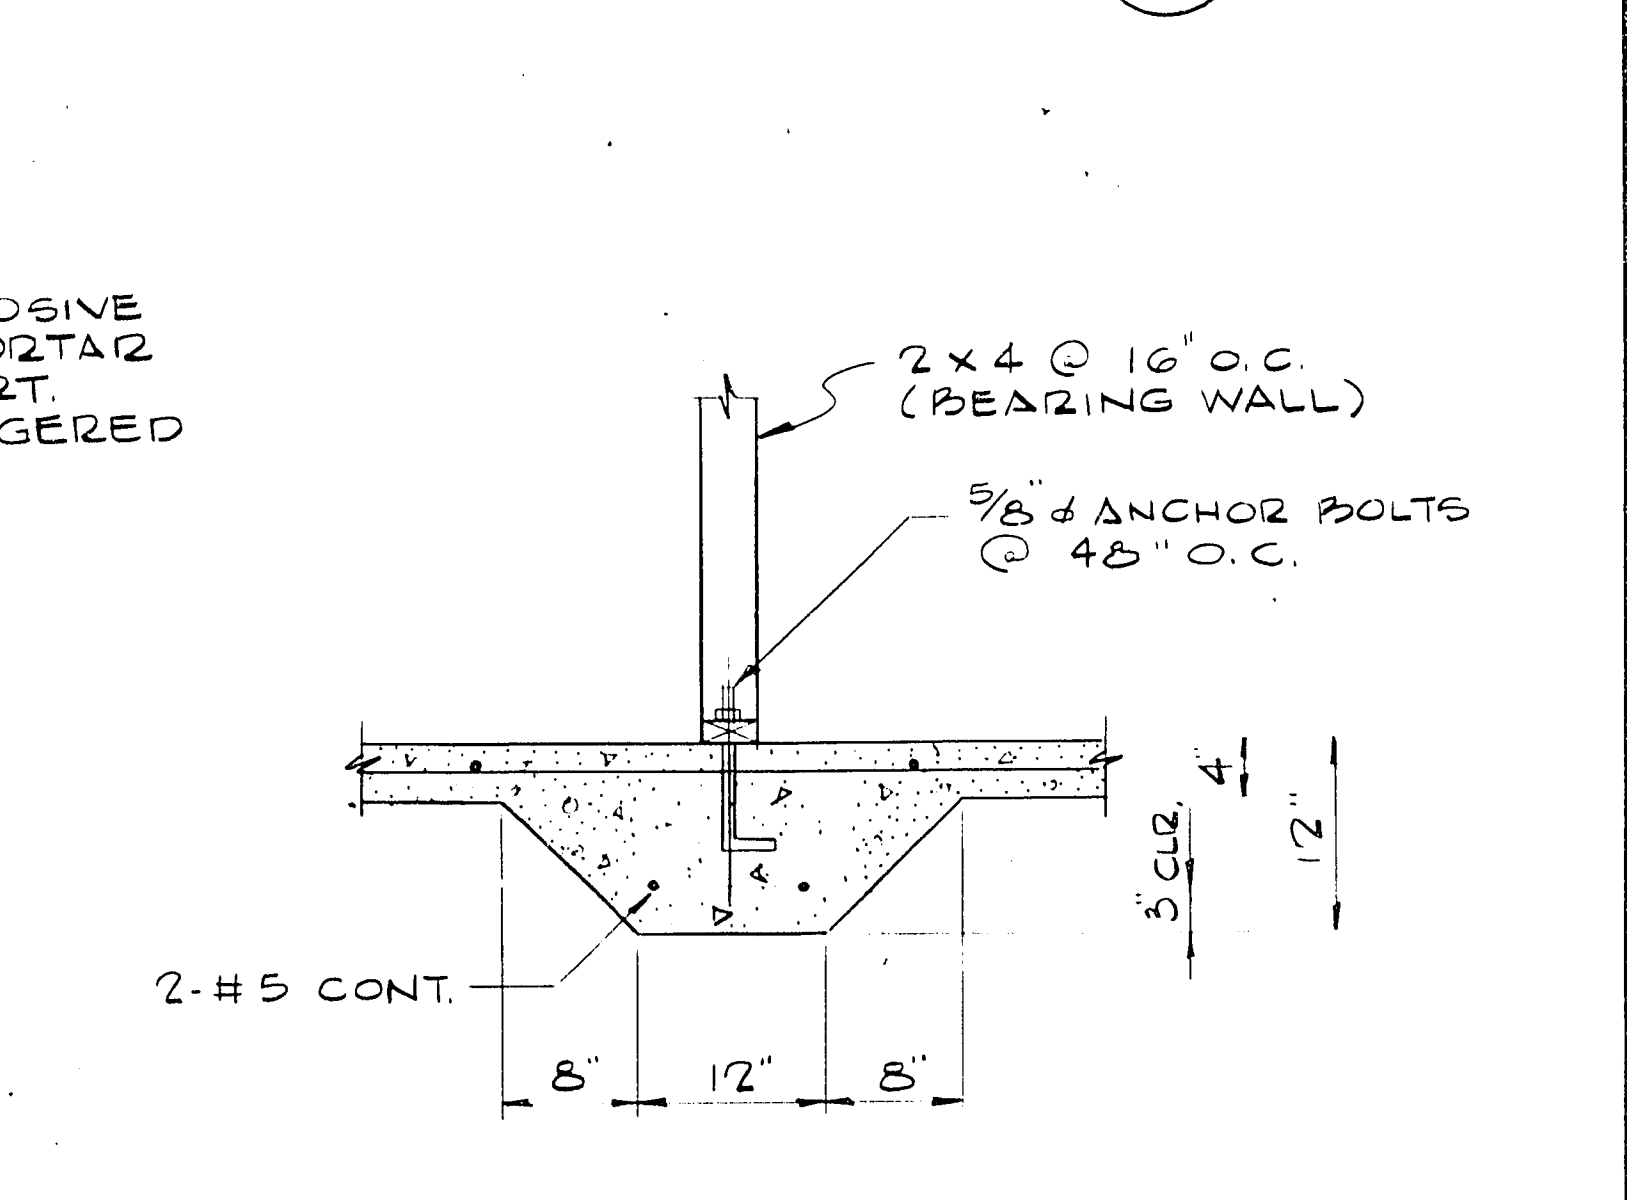

SECTION L
1" = 1'-0"

CULP/WESNER/CULP

CARMON PARK, CALIFORNIA

SANTA ANA, CALIFORNIA

DENVER, COLORADO

Job No. 740.15

Designed GCM

Drawn GCM

Checked

Approved

Date

1 1/4" F.O. # 8

1 1/2" CORROSION RESISTANT

CONSTRUCTION RECORDS

10/08

DATE

G.C. WALLACE, Inc.

Consulting Engineers, Inc.

1905 South Rainbow Blvd. • Las Vegas, Nevada 89102 • 363.1200

CITY OF LAS VEGAS

WASTEWATER TREATMENT PLANT

Contract No. 5

MAINTENANCE BUILDING

SECTIONS

Sheet 27

6-3

of 57

7-1-107

3/1/25