



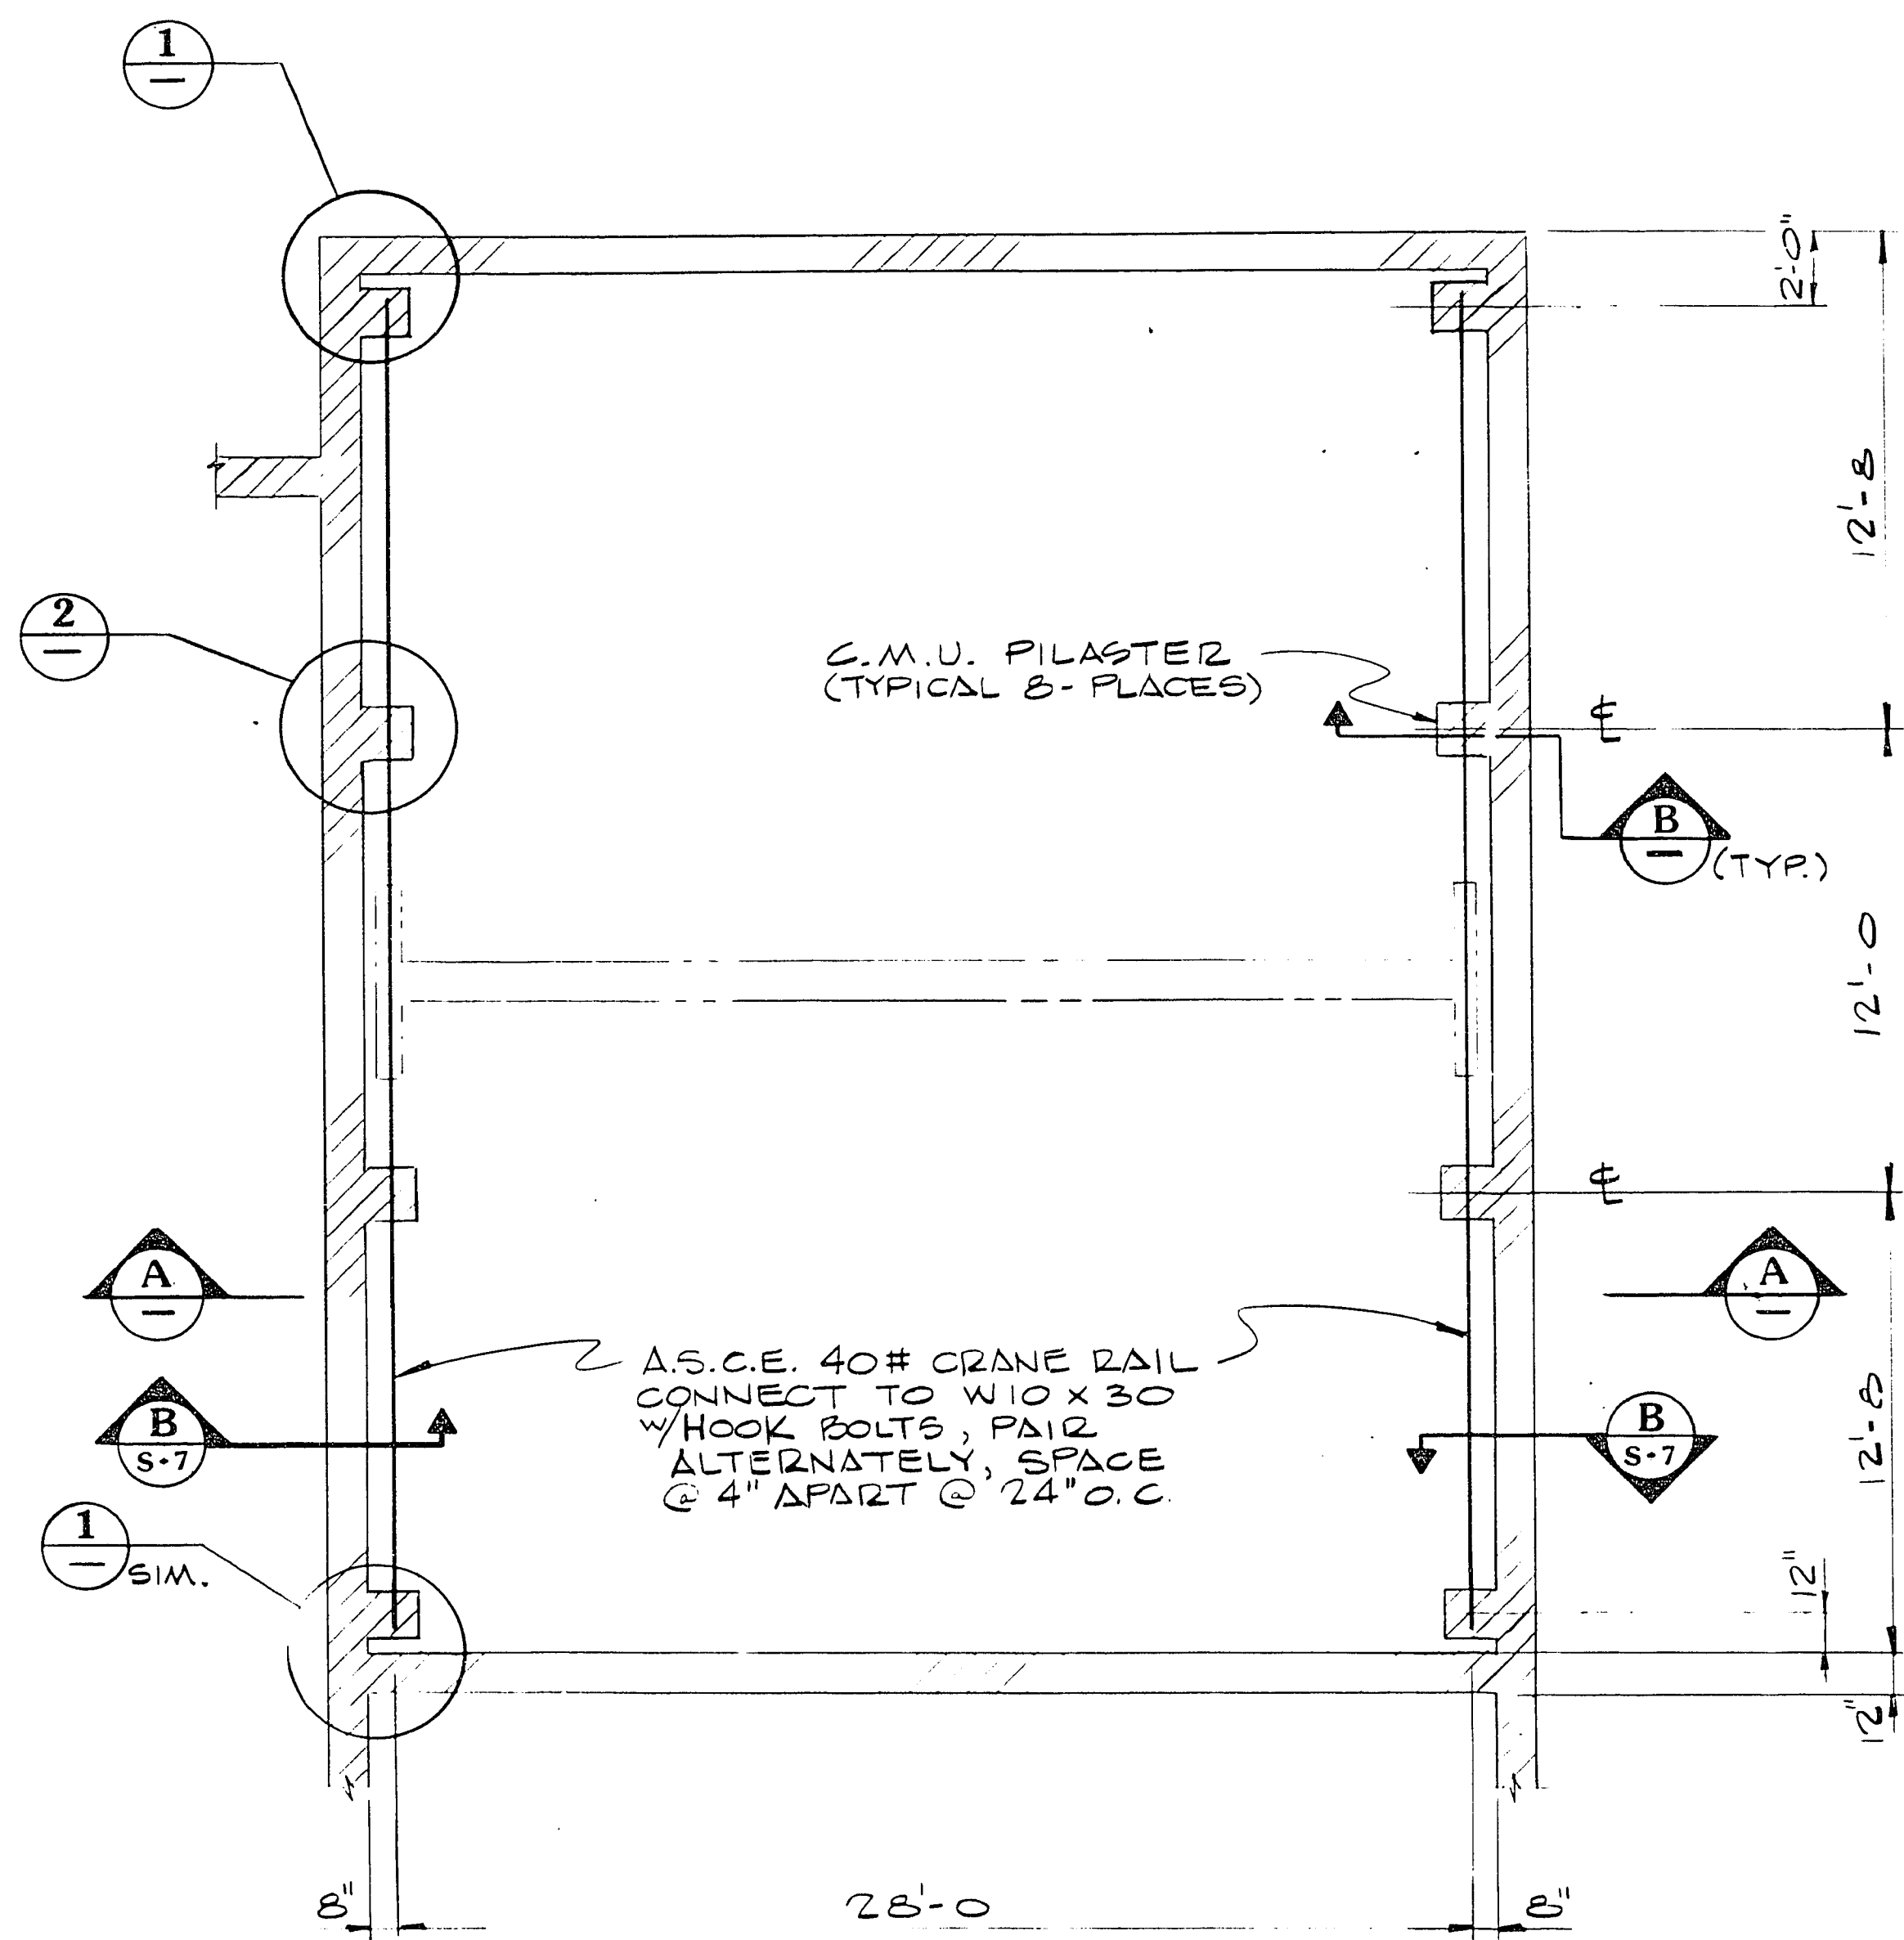


BRIDGE CRANE PLAN

1/4" = 1'-0"

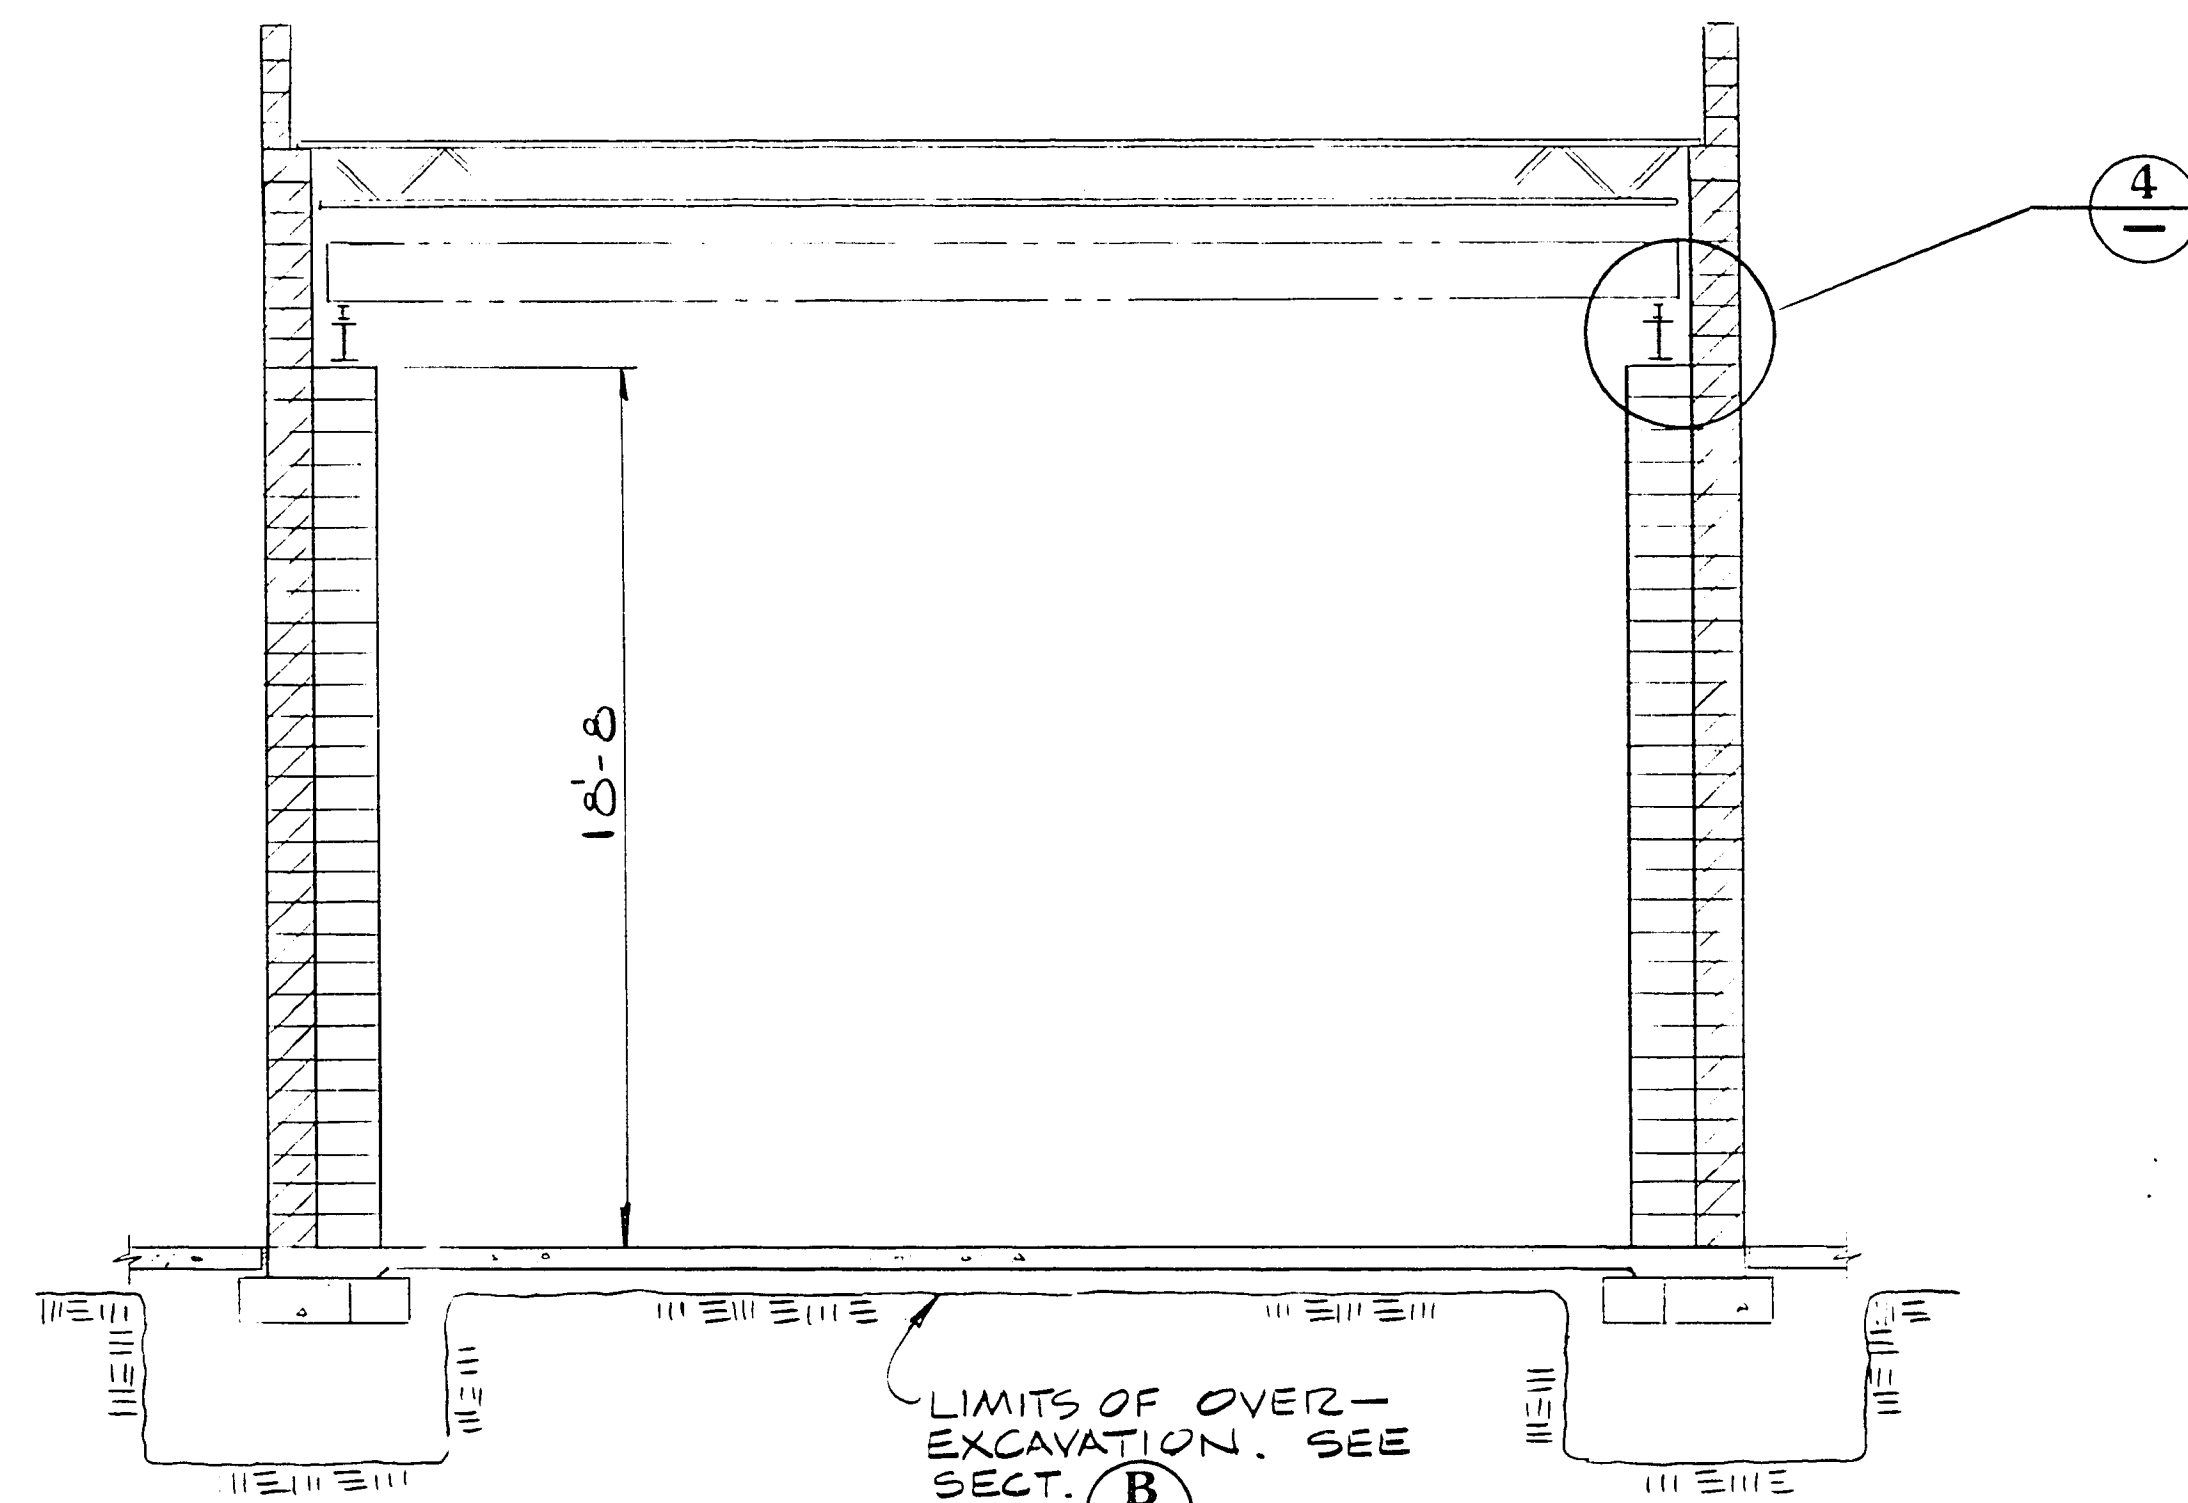

SECTION

1/4" = 1'-0"

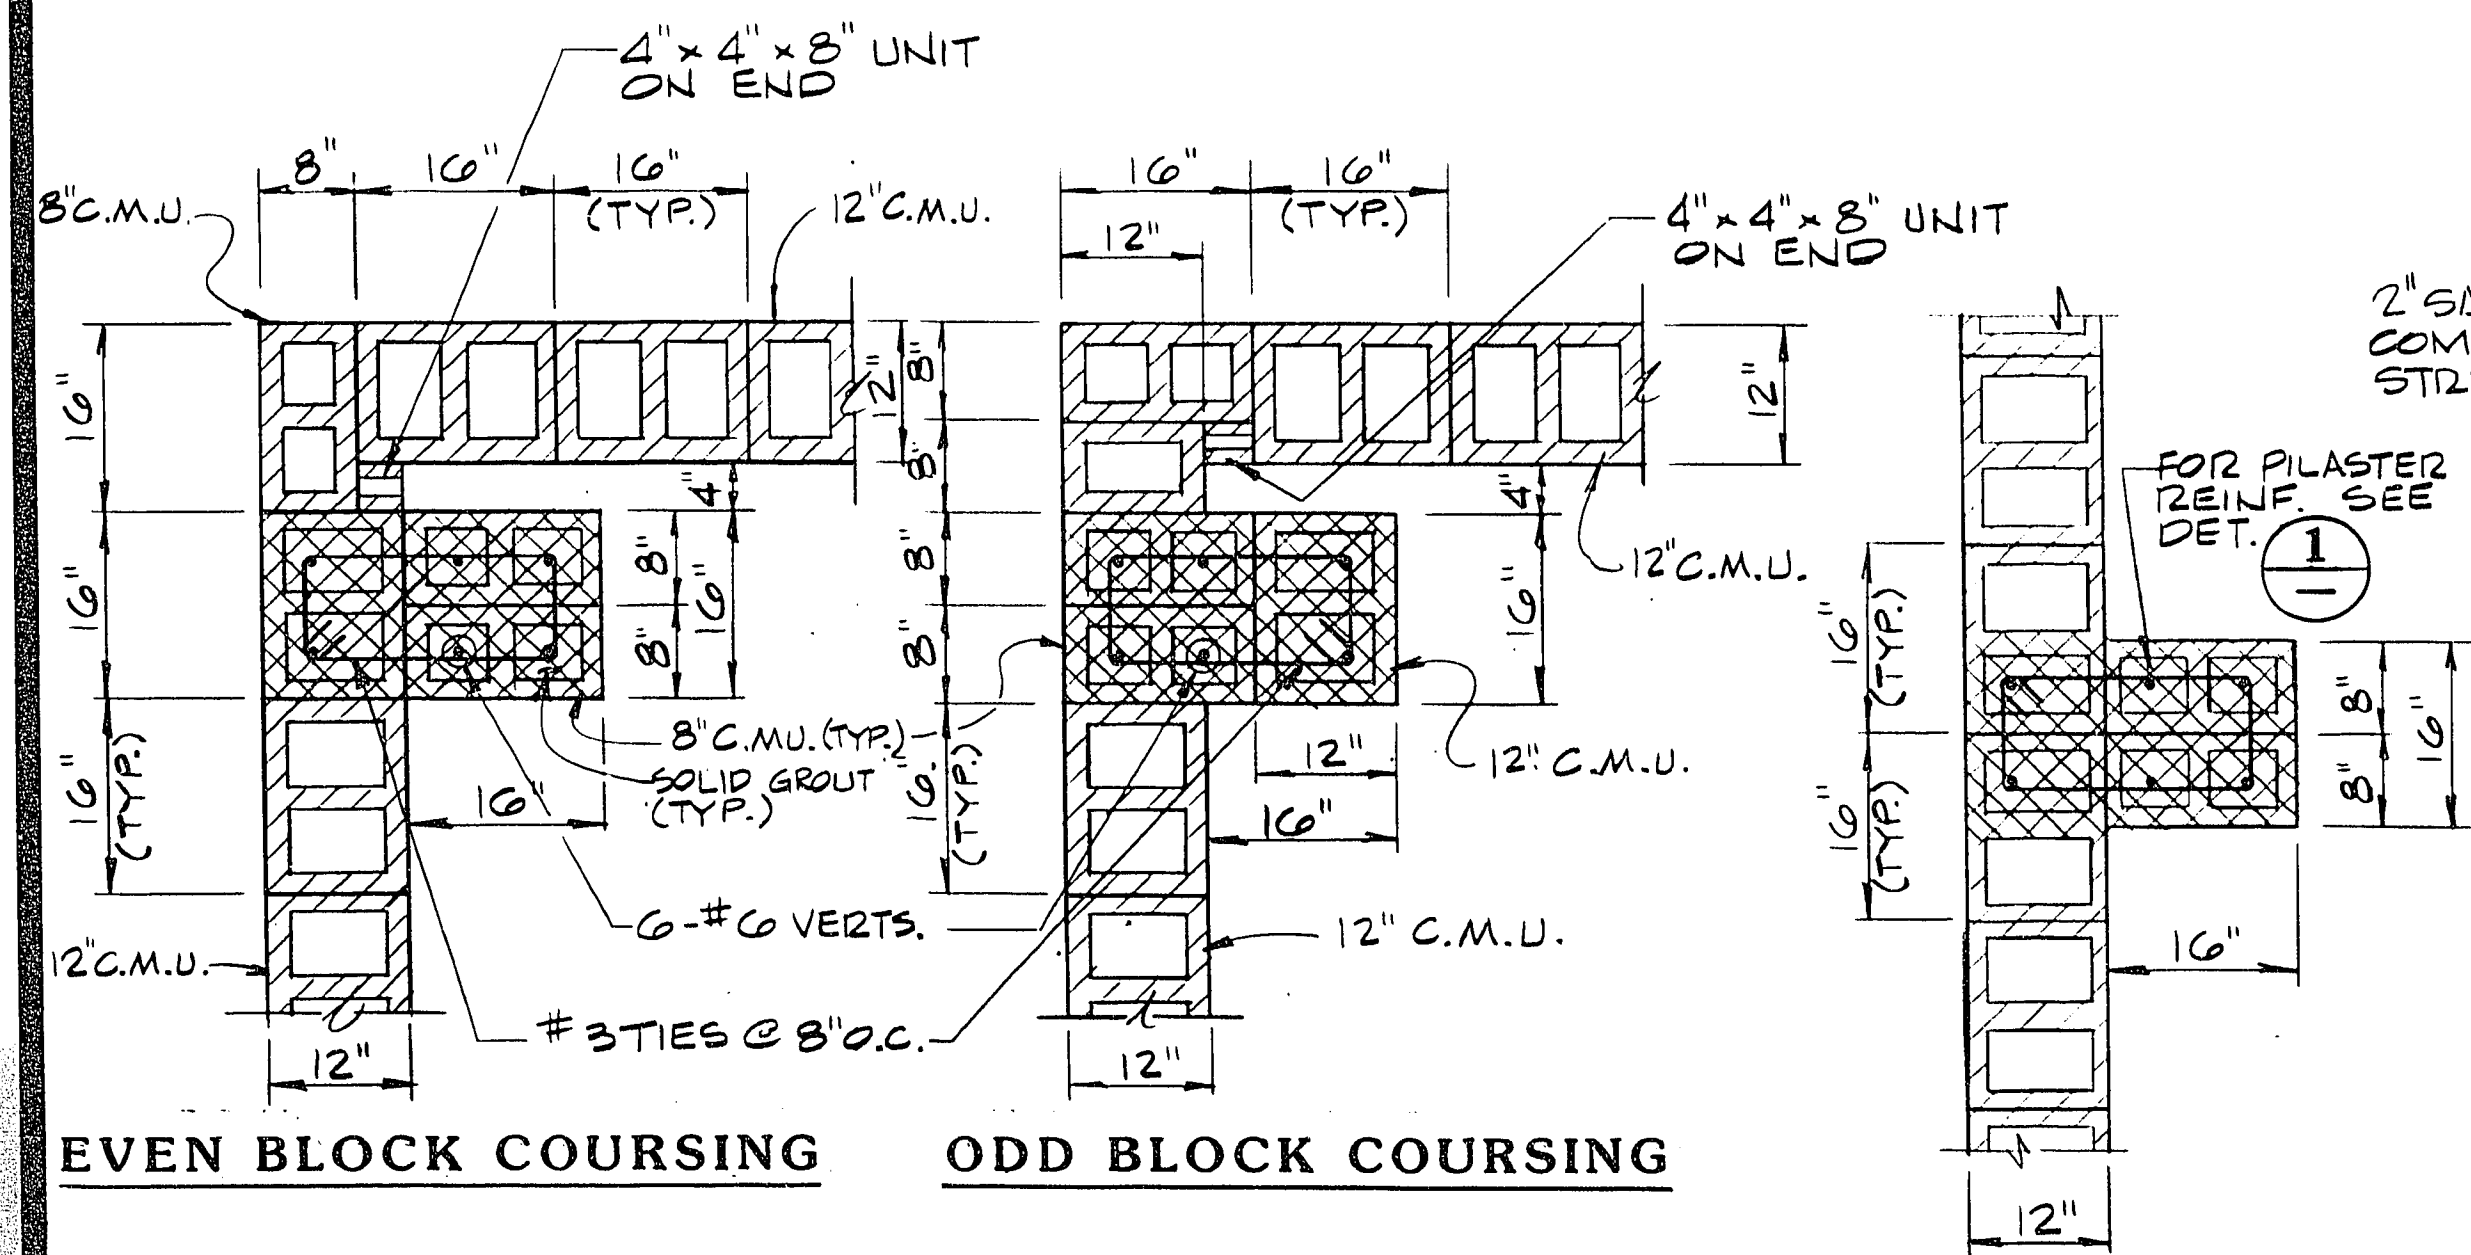


DETAIL

3/4" = 1'-0"

DETAIL

3/4" = 1'-0"

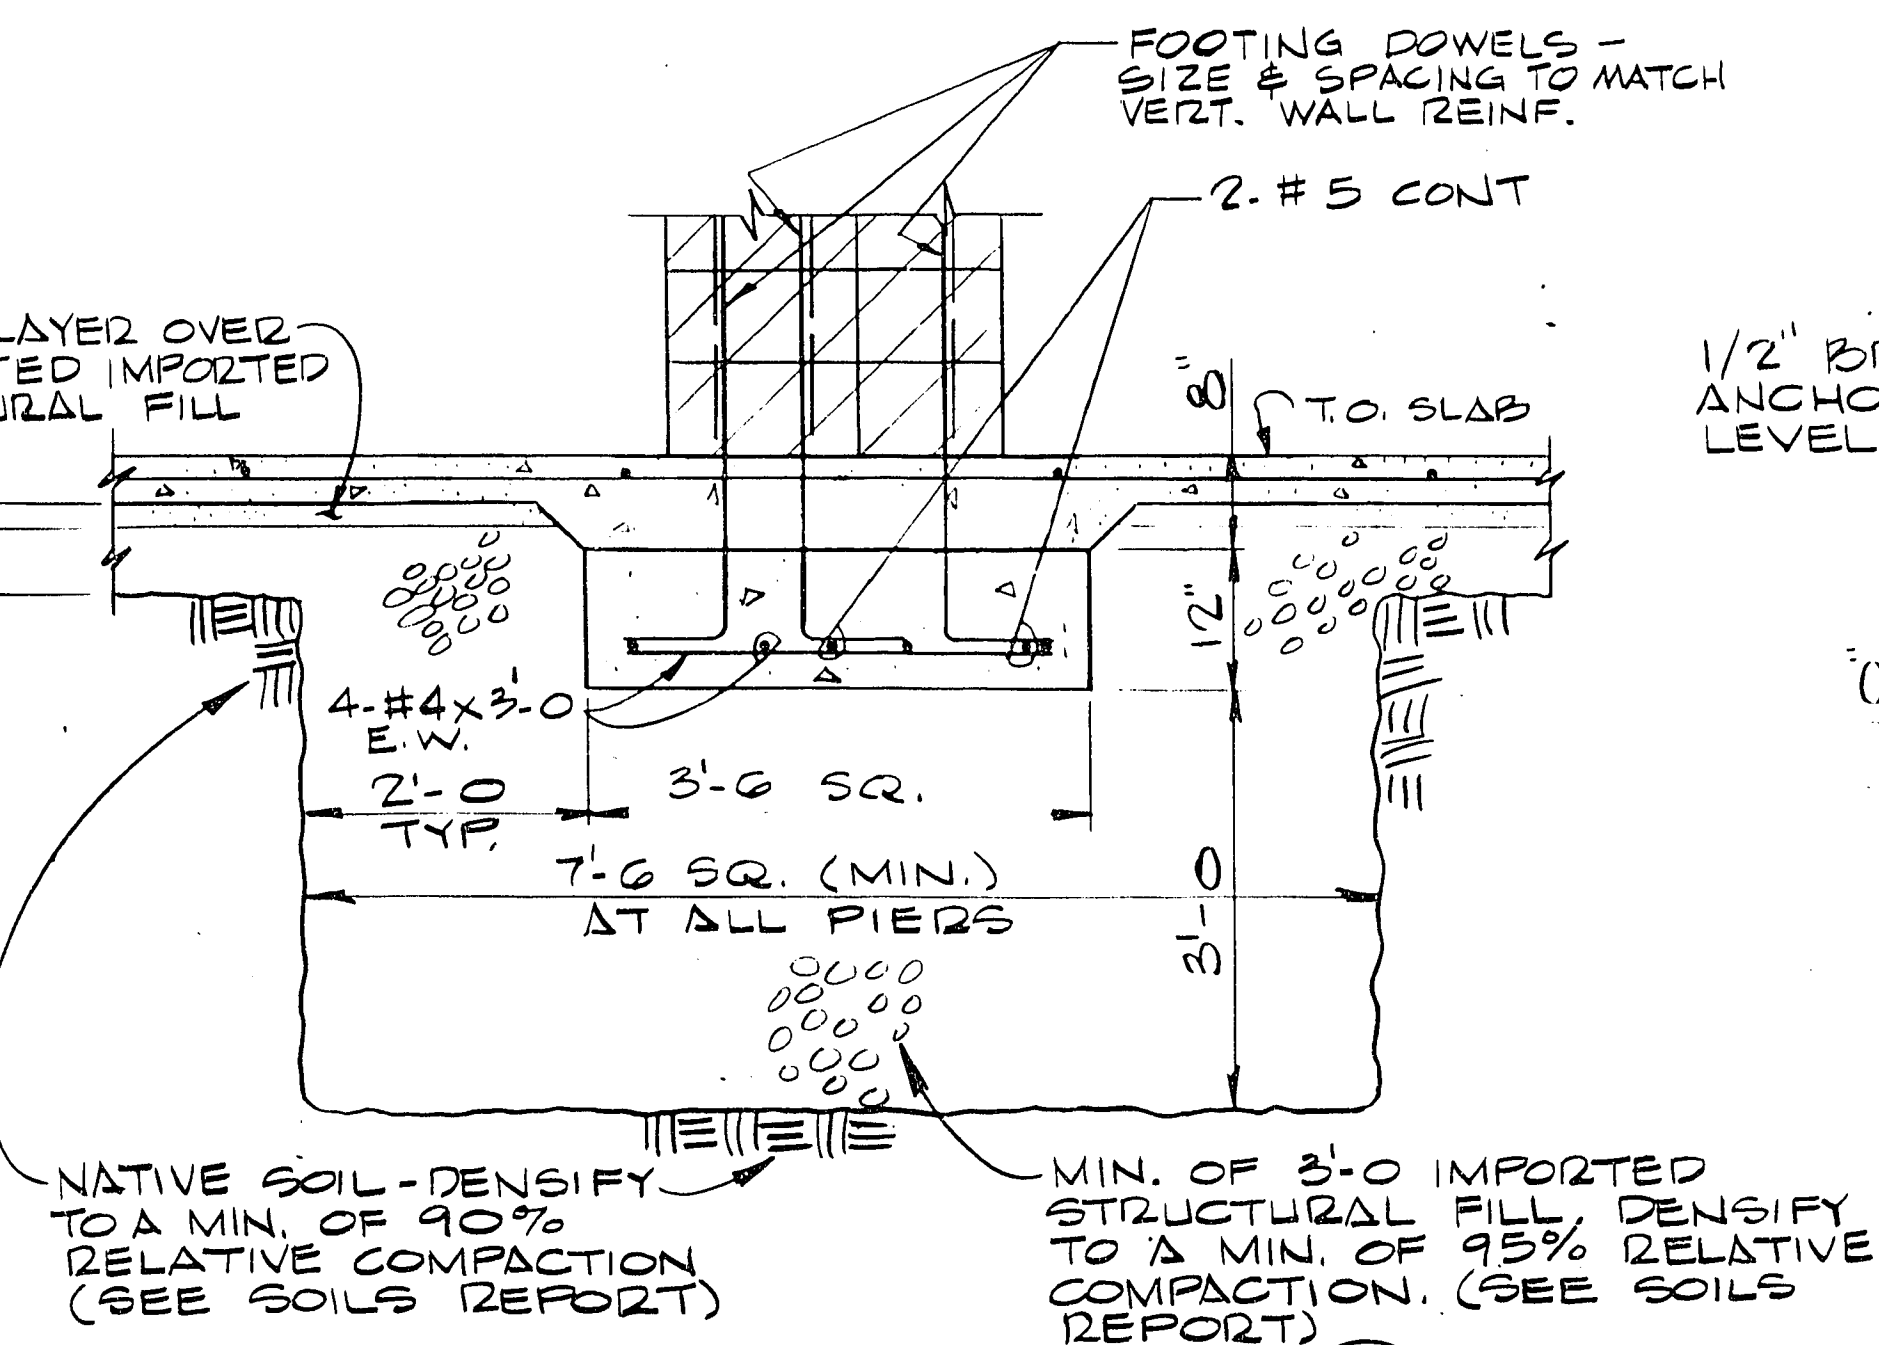


SECTION

3/4" = 1'-0"

DETAIL


1" = 1'-0"

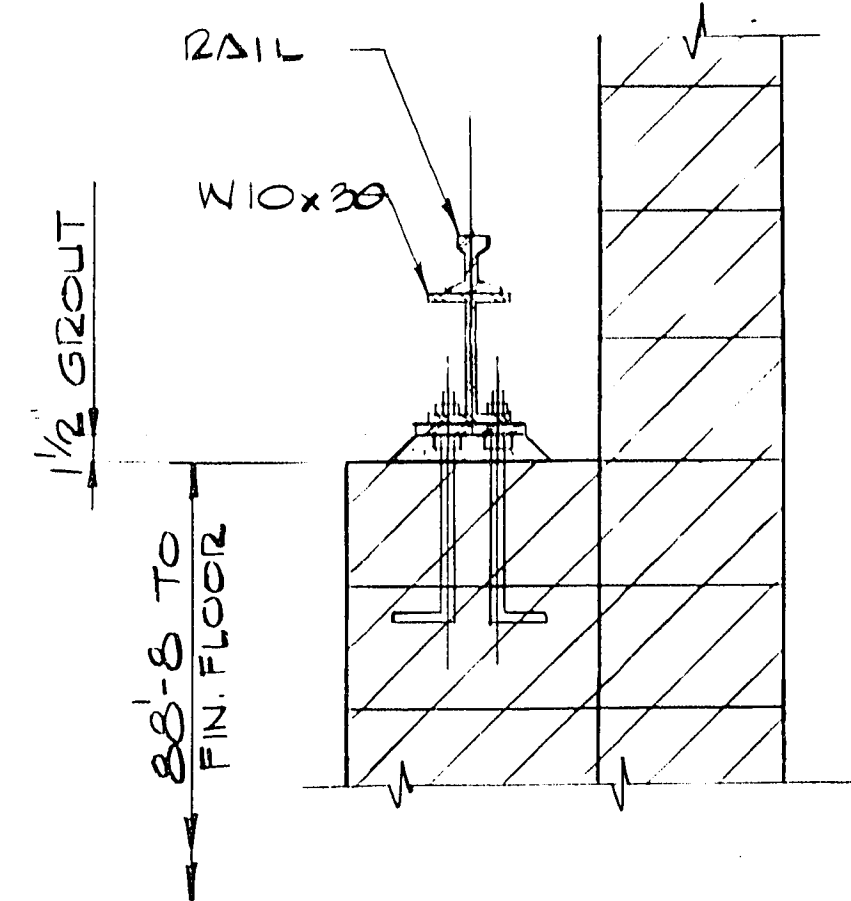

DETAIL

1" = 1'-0"


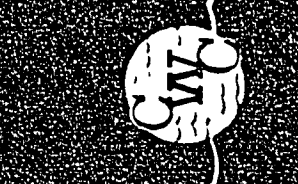


Job No. 74015
Designed G.C.W.
Drawn G.C.W.
Checked
Approved
Date

Revision	Description	Date
1	CONSTRUCTION RECORDS	
2		
3		
4		
5		
6		
7		
8		
9		
10		

G.C. WALLACE
Consulting Engineers, Inc.

CITY OF LAS VEGAS
Maintenance & Storage Buildings
Contract No. 5

MAINTENANCE BUILDING
BRIDGE CRANE
PLAN & SECTIONS

Sheet 30
3-6
of 57
3/1/25

7-1-10