

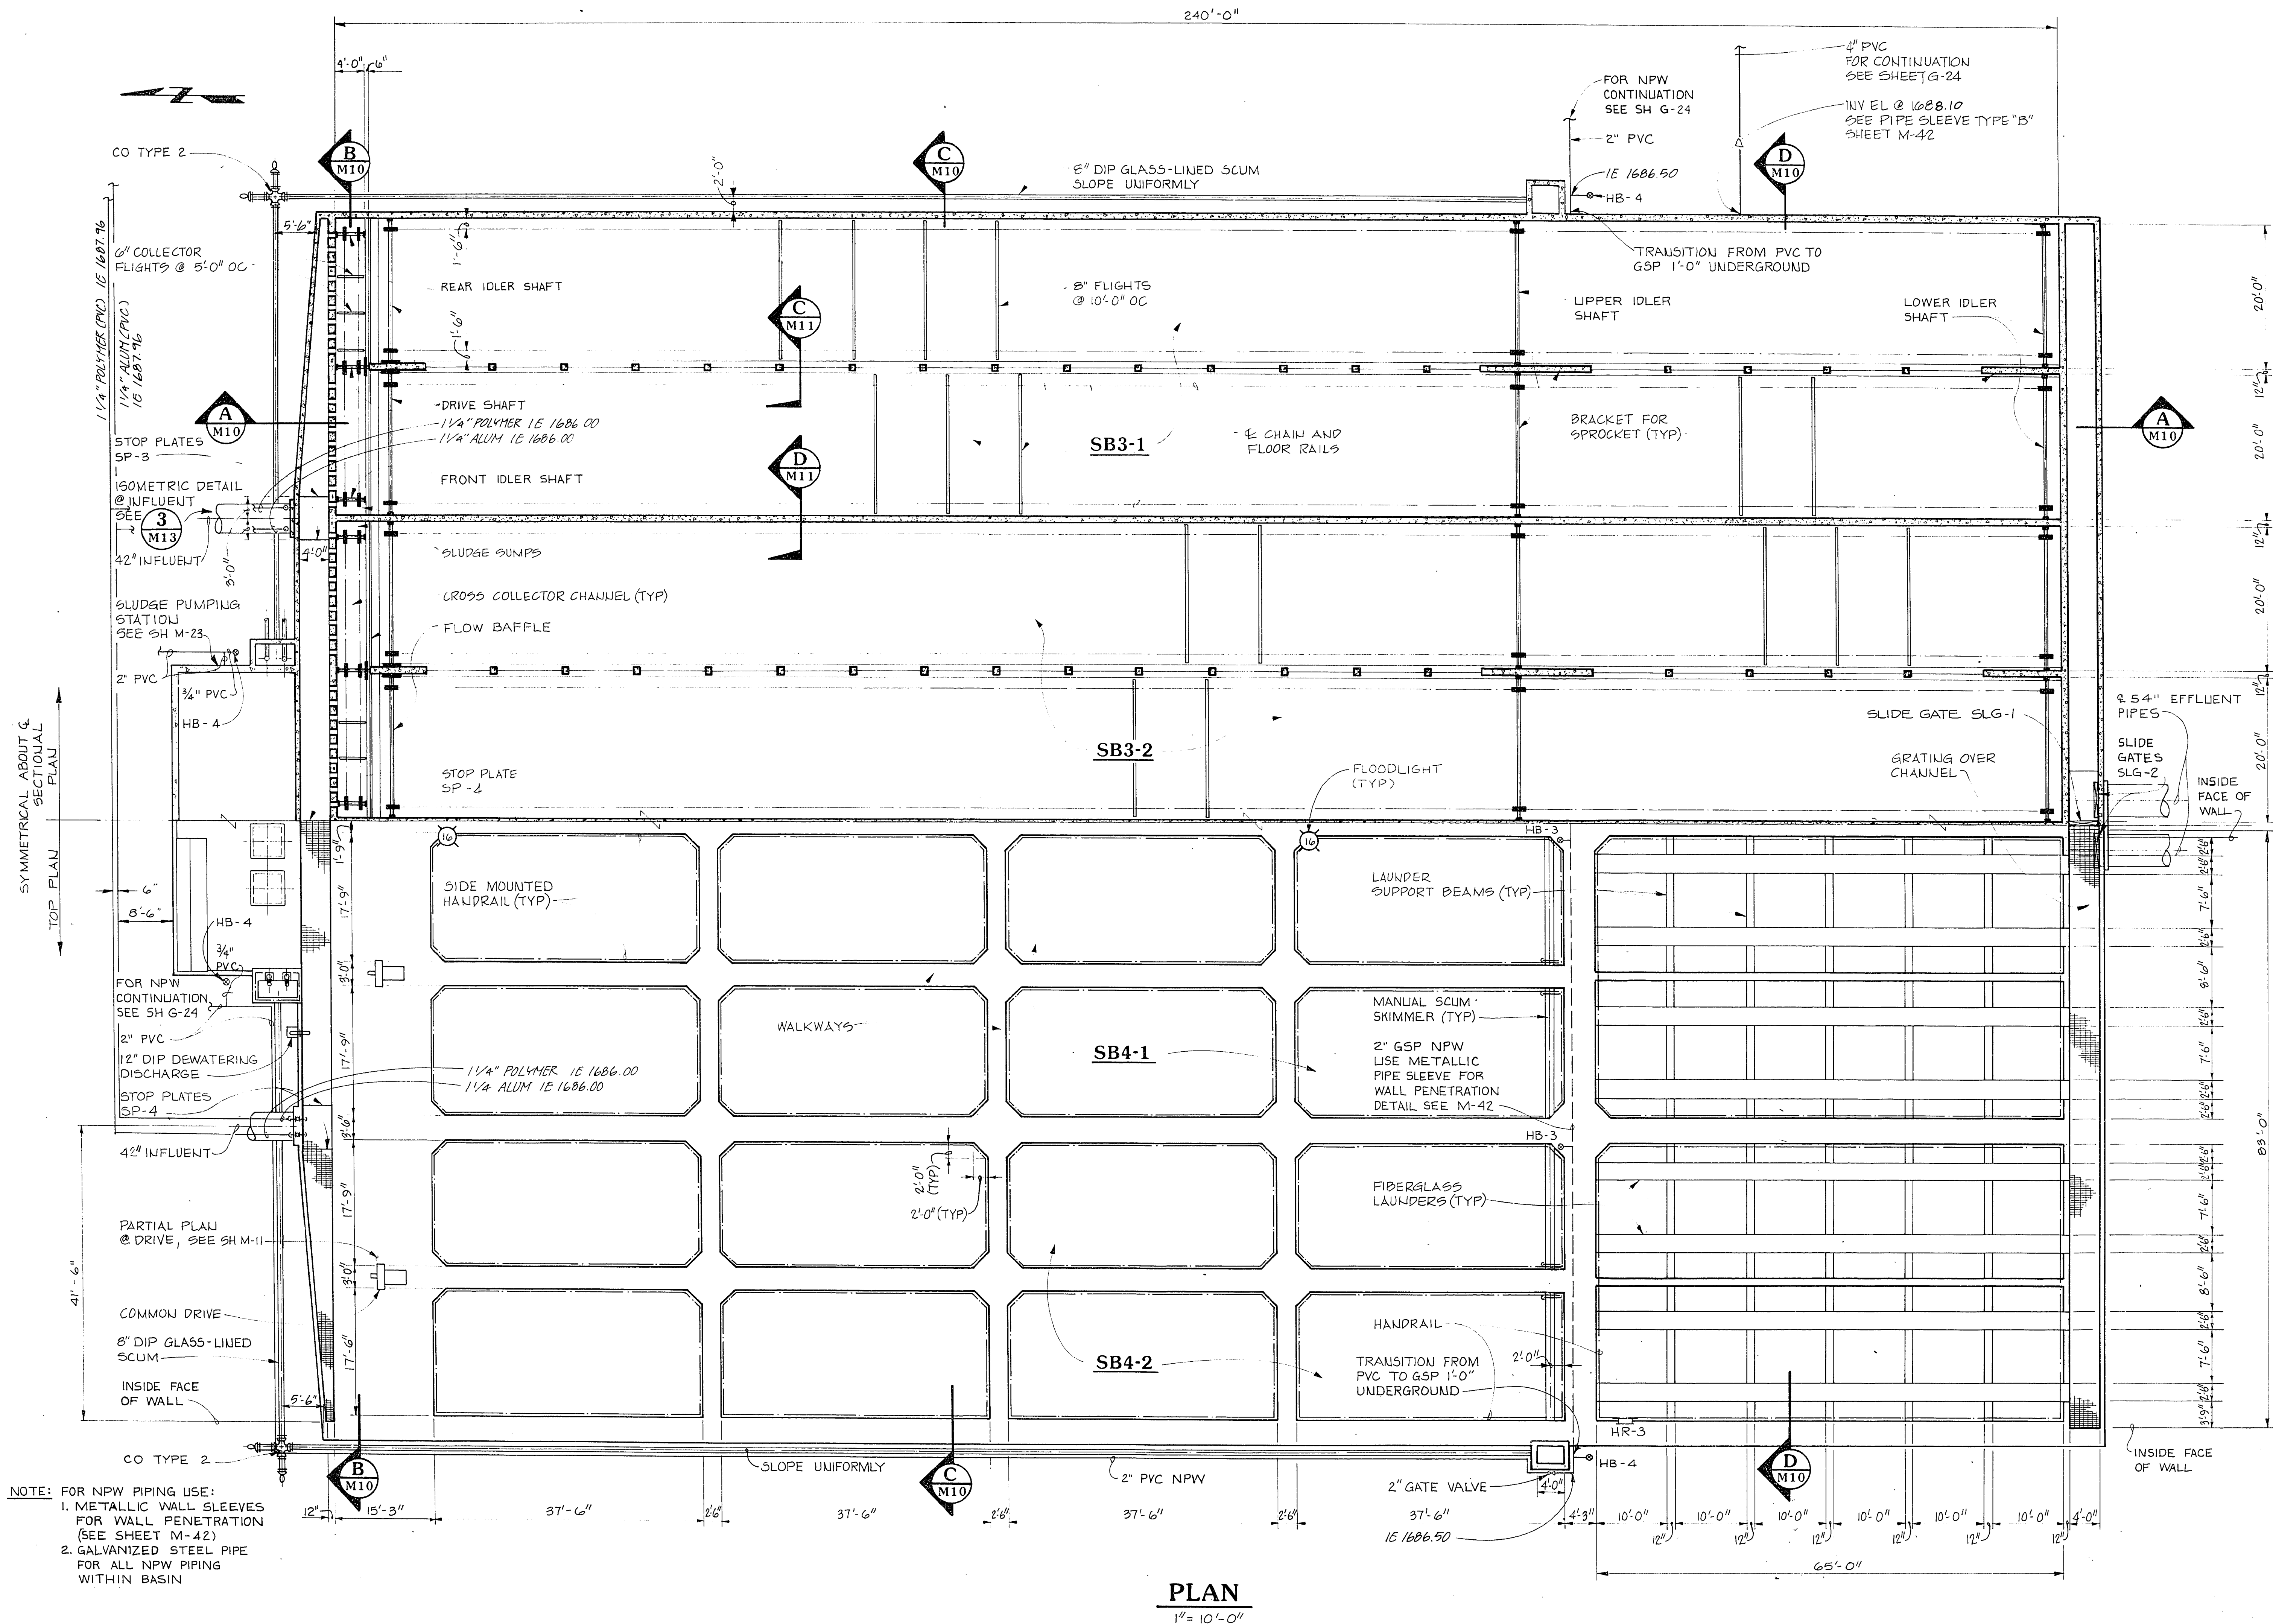


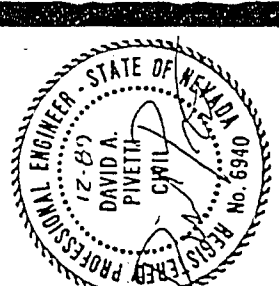

PLAN
 1" = 10'-0"

CULP/WESNER CULP

CAMERON PARK, CALIFORNIA
 SANTA ANA, CALIFORNIA DENVER, COLORADO

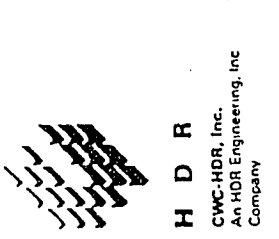

Job No. 740.11	Designed DAP	Drawn REL	Checked DAP	Approved DAP	Date 12/19/88
----------------	--------------	-----------	-------------	--------------	---------------

No.	By	Revision	Description	Date
1	DAVID A. CULP	1	CONSTRUCTION RECORD	5/97

City of Las Vegas
 WASTEWATER TREATMENT PLANT
 Main Plant Expansion
 Contract No. 1

SECONDARY
 SEDIMENTATION BASINS
 TOP/SECTIONAL PLAN

Sheet 100
M-9

01 164

0-1-100 3/1/21