




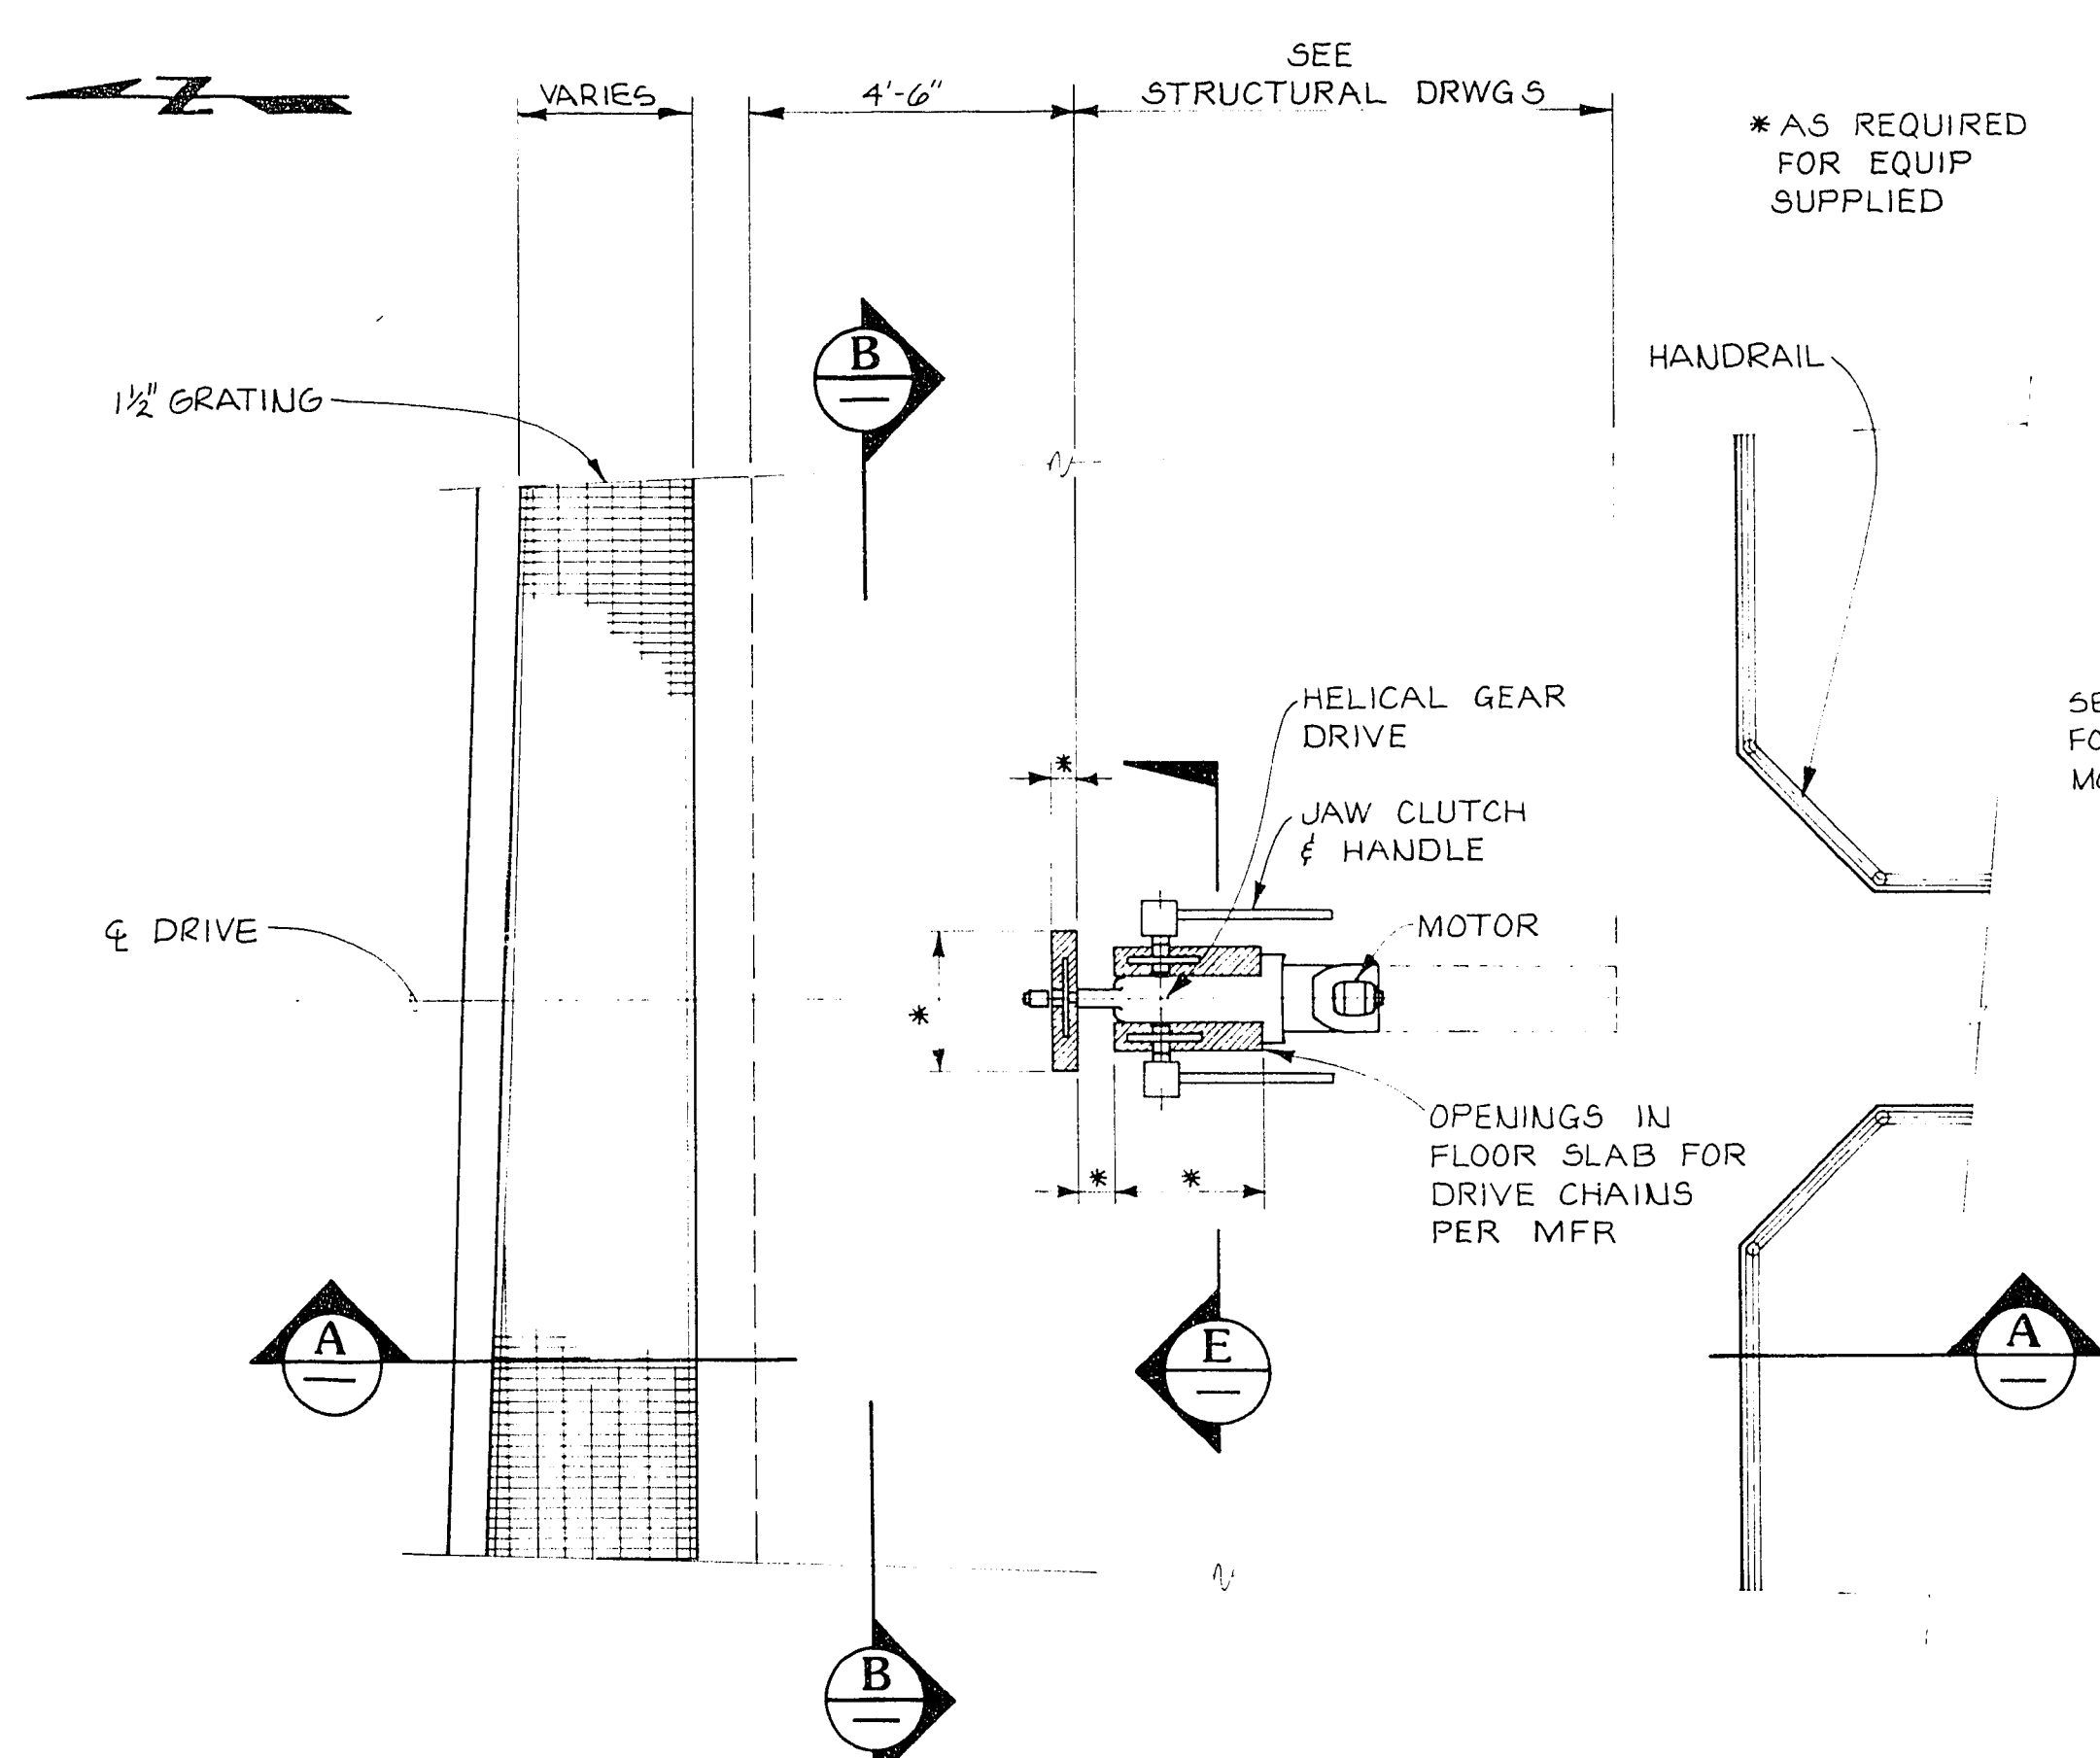


PARTIAL PLAN AT DRIVE
3/8" = 1'-0"

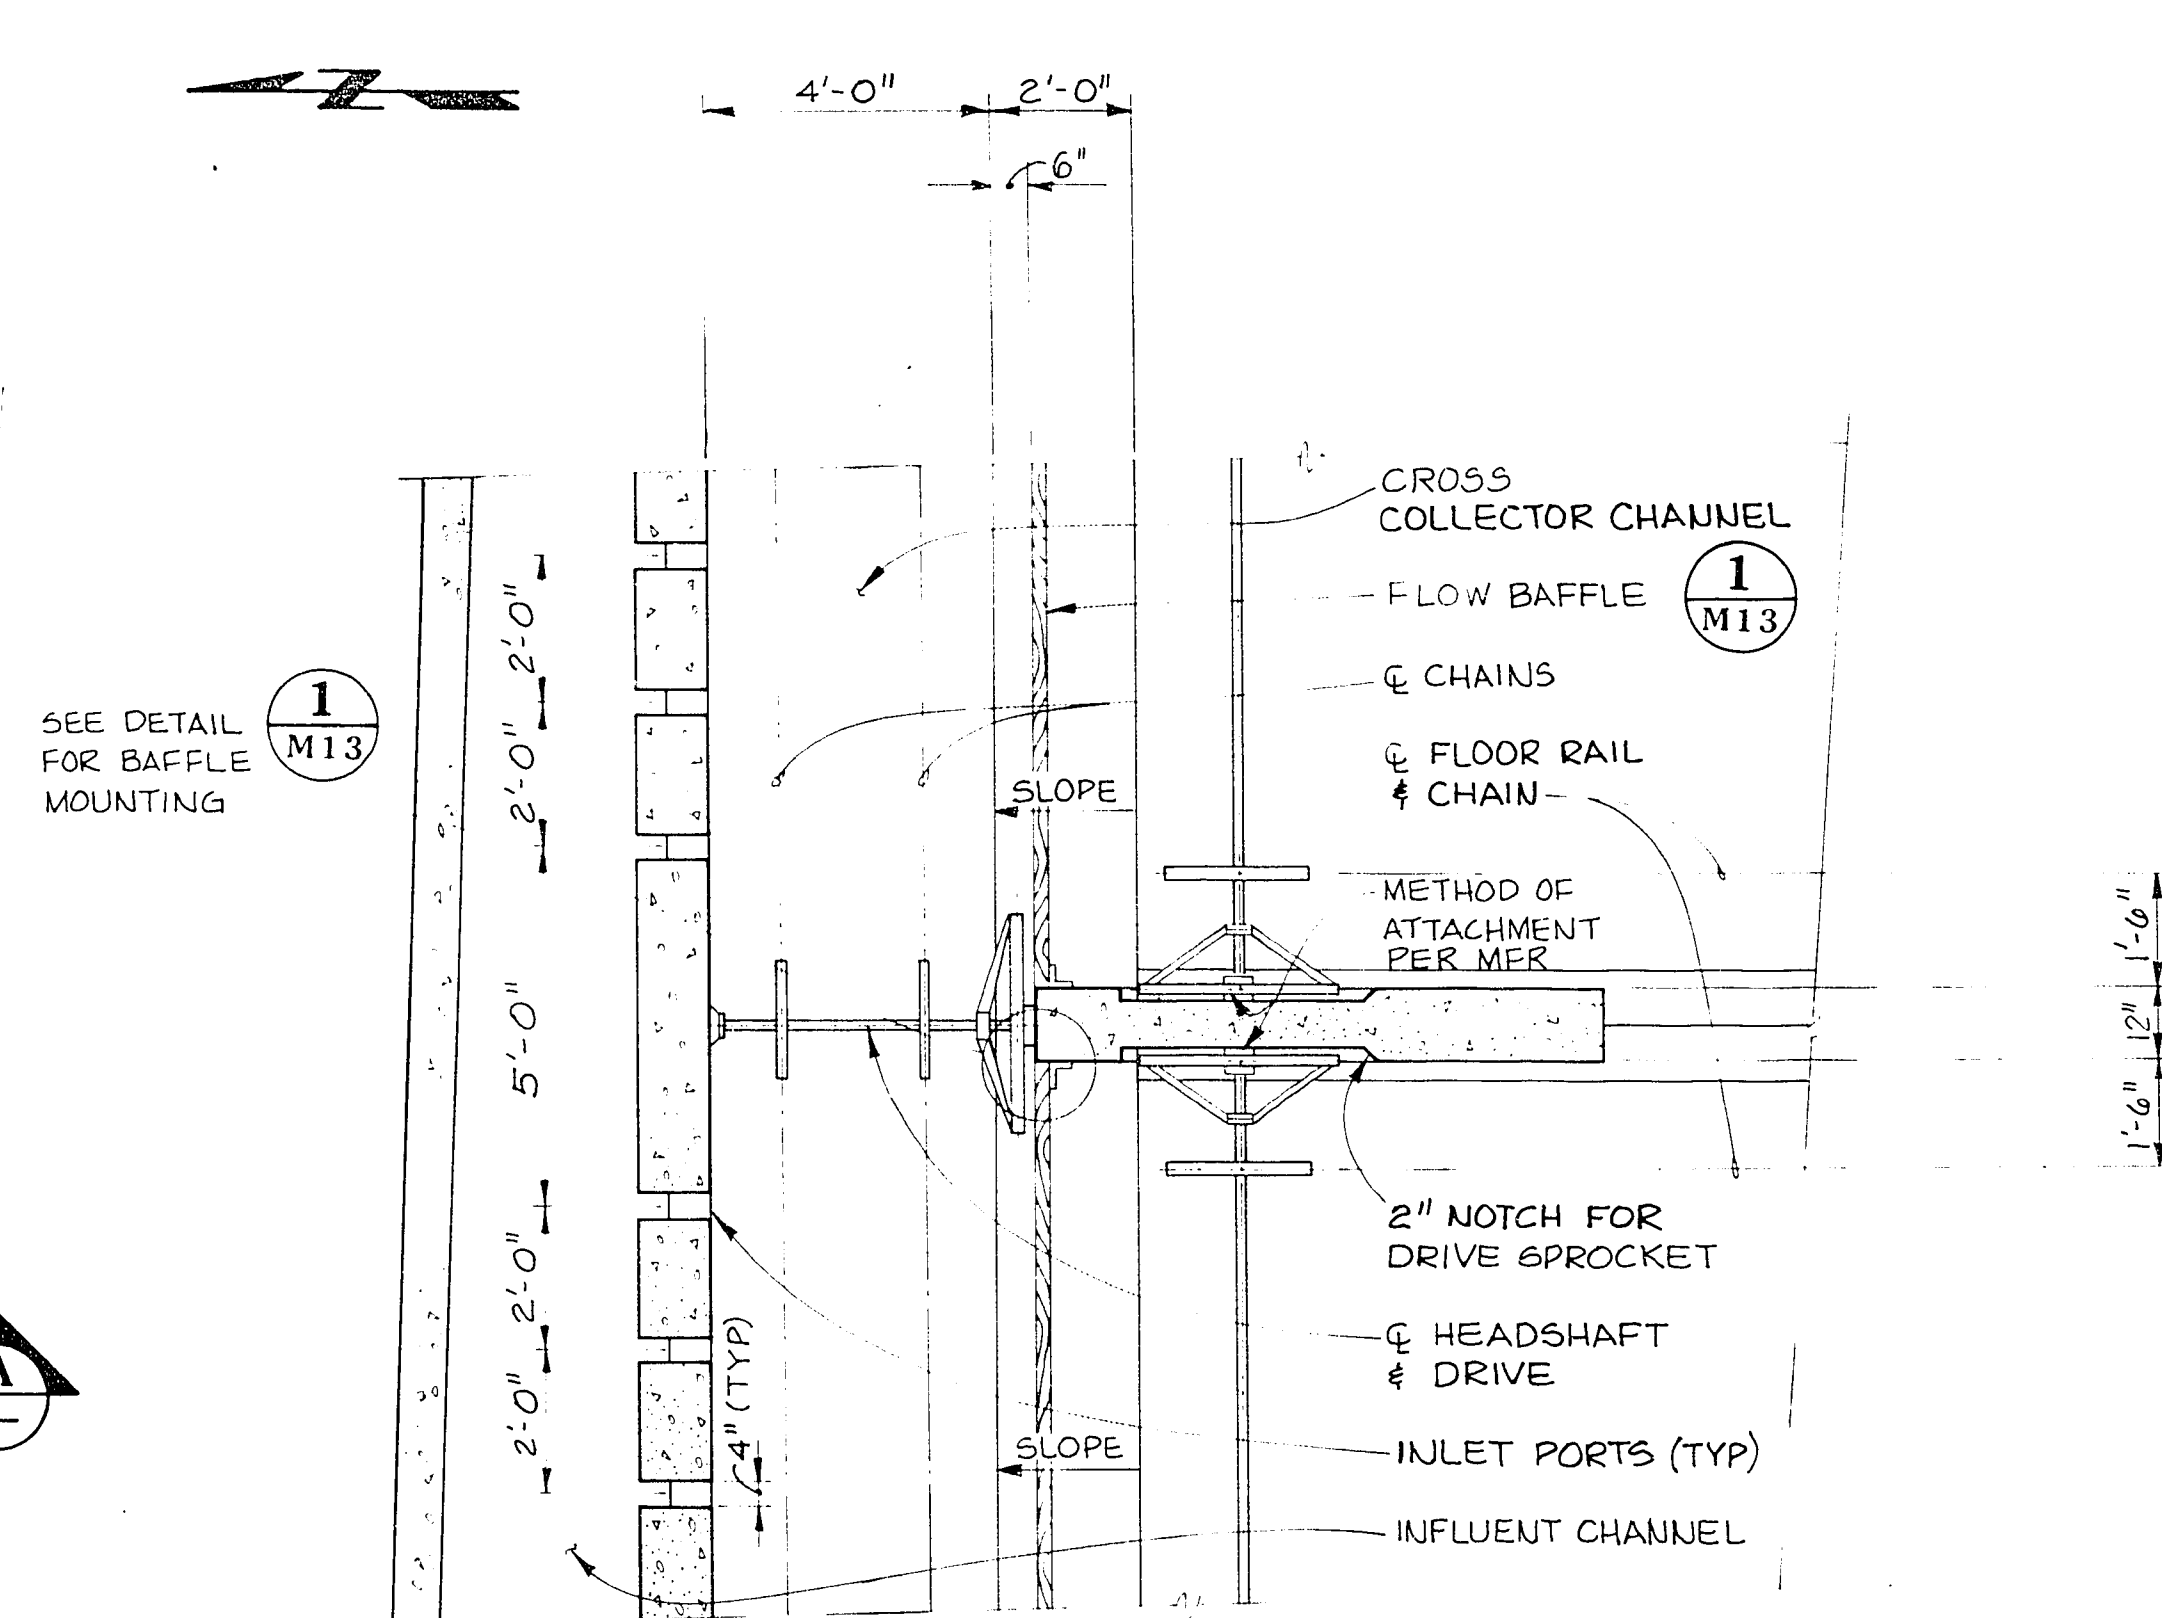


SECTIONAL PLAN AT DRIVE
3/8" = 1'-0"

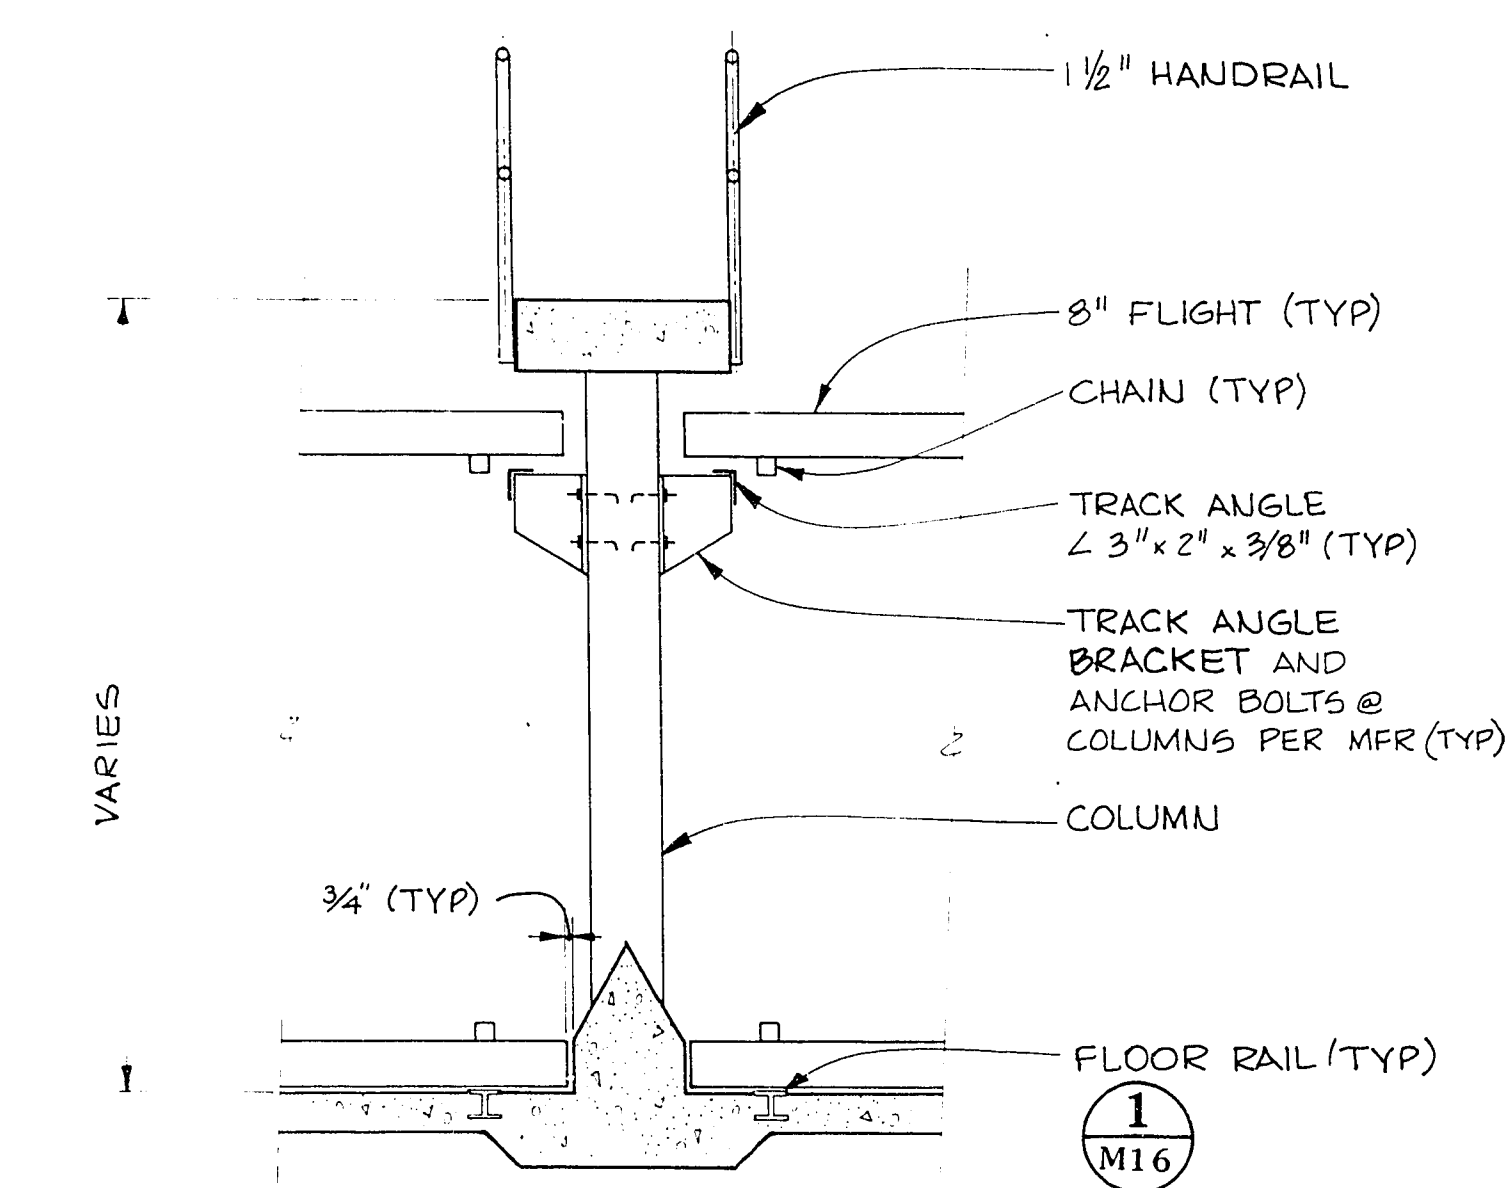


SECTION C
3/8" = 1'-0" M7, M9

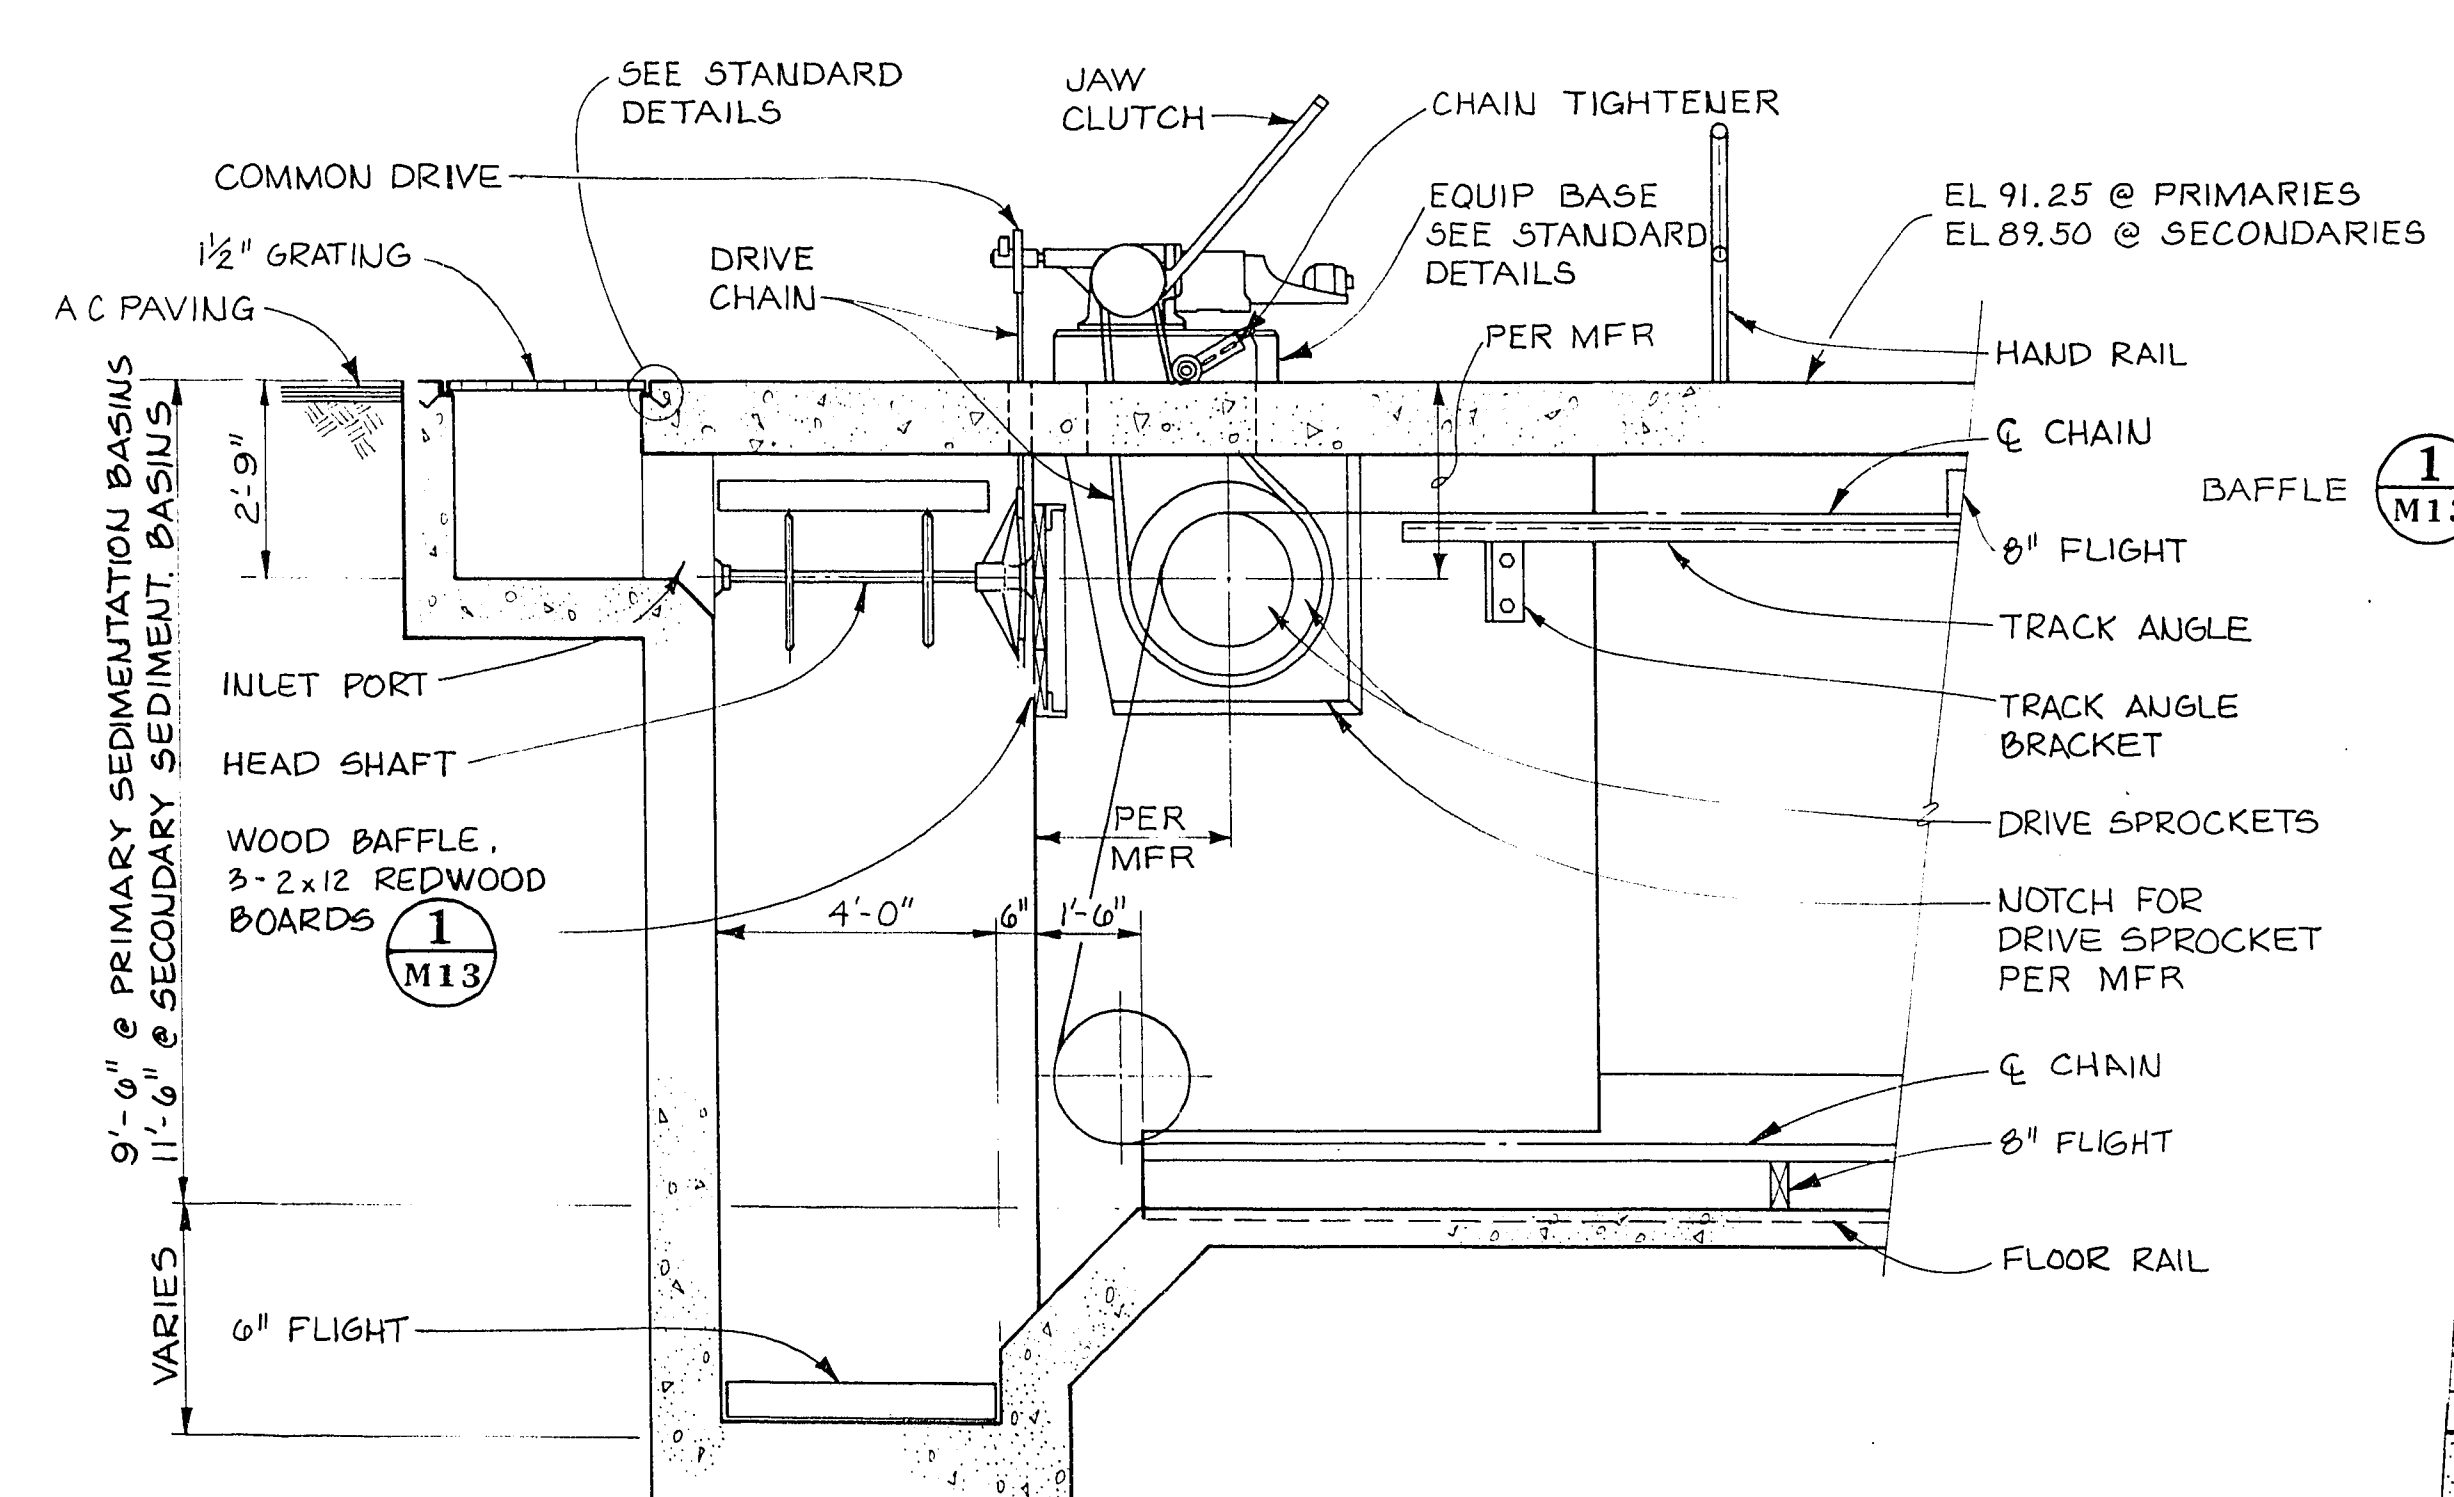


SECTION A
3/8" = 1'-0"

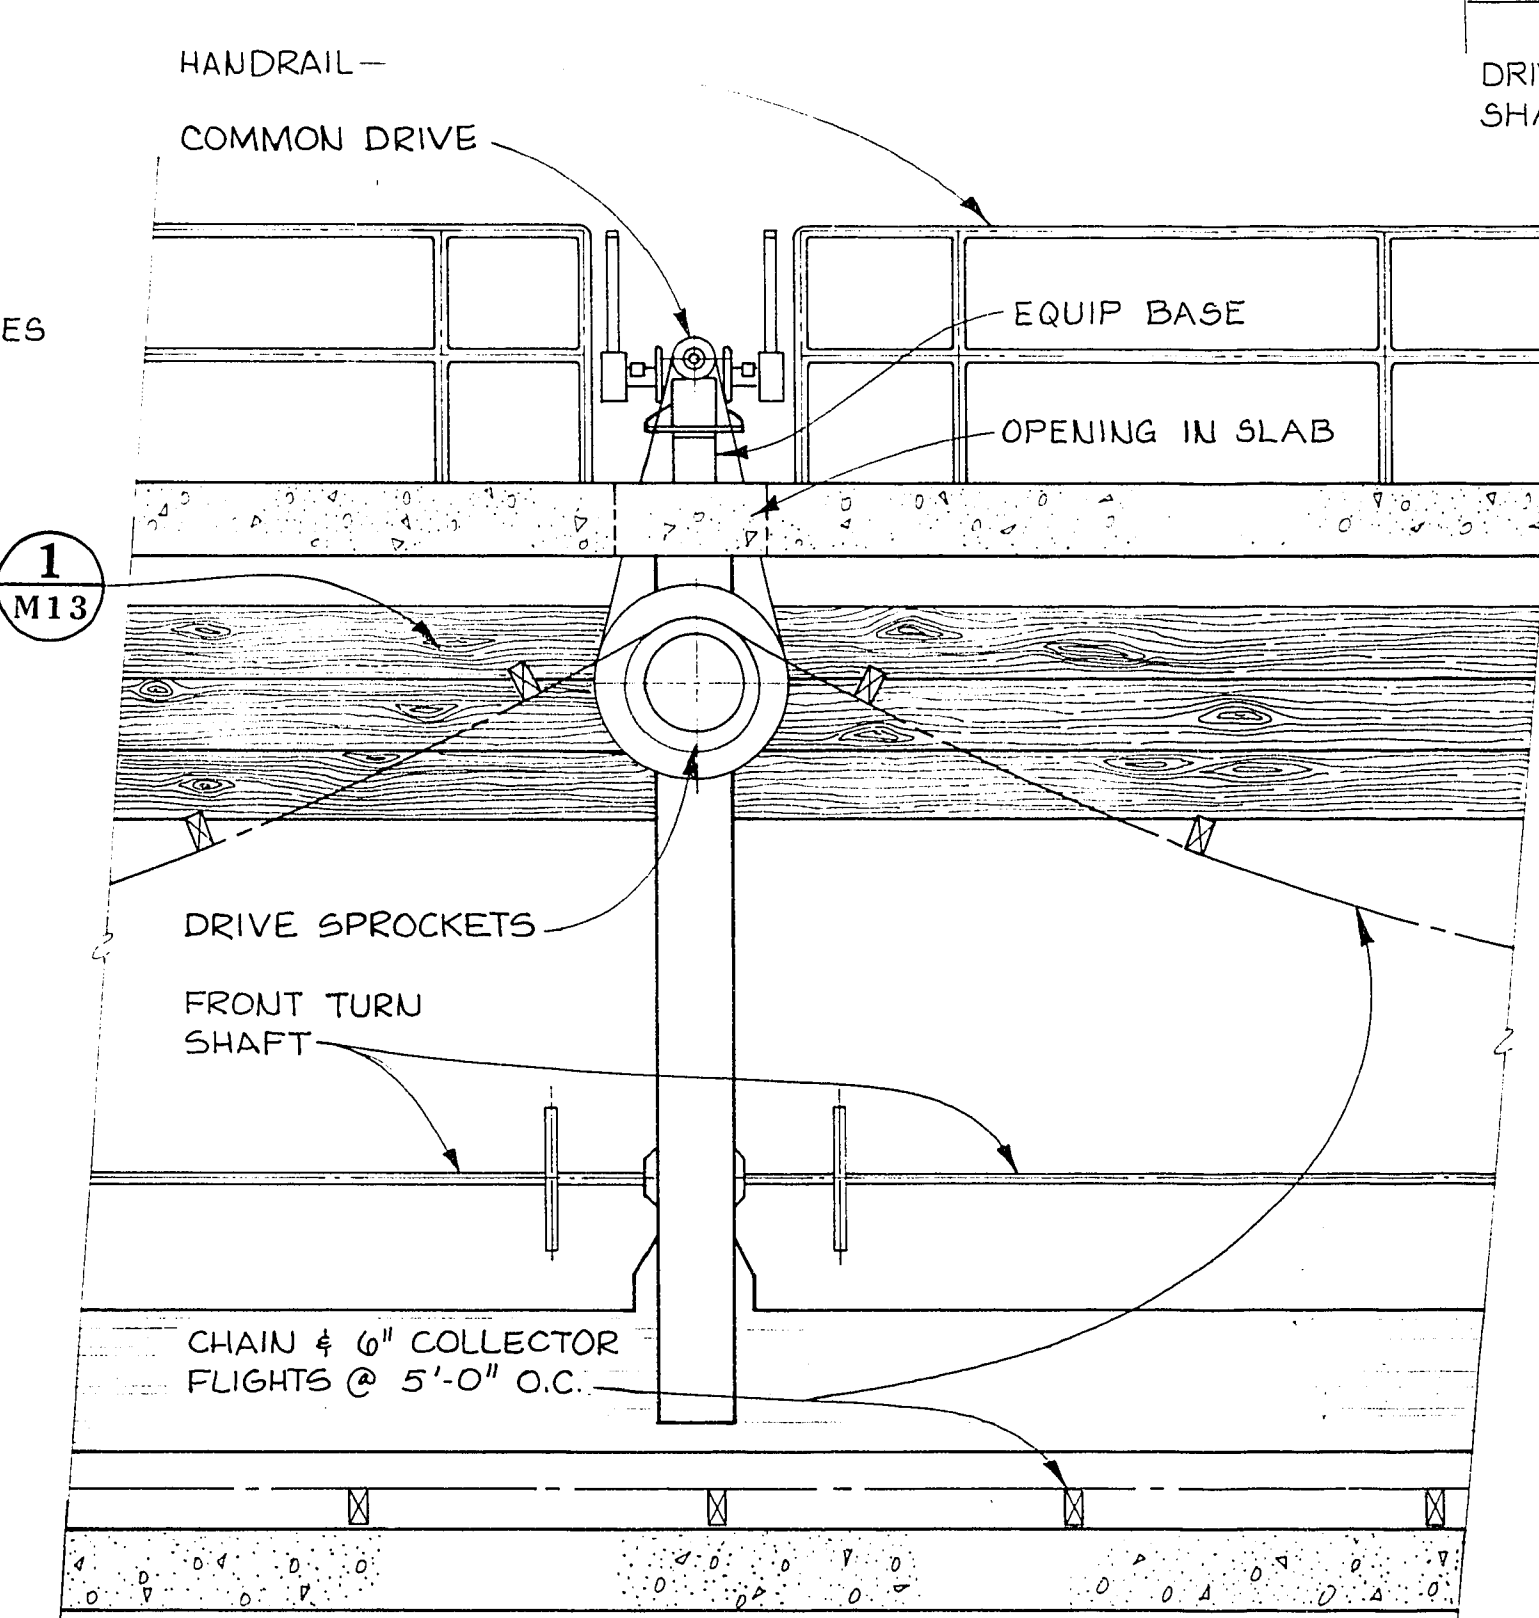

SECTION B
3/8" = 1'-0"

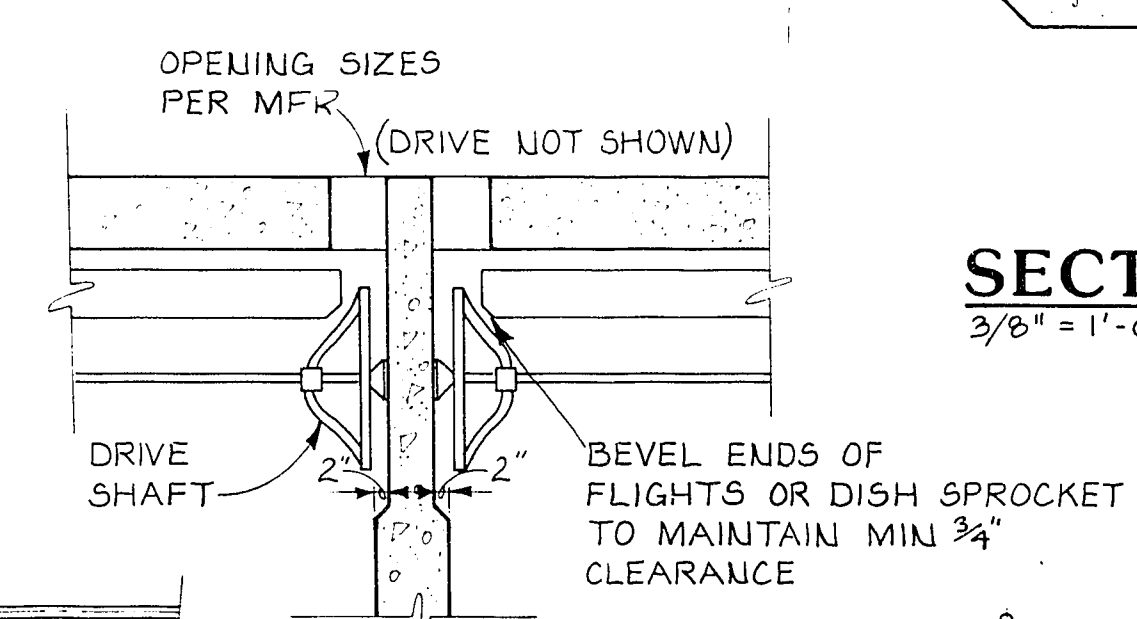

SECTION E
3/8" = 1'-0"

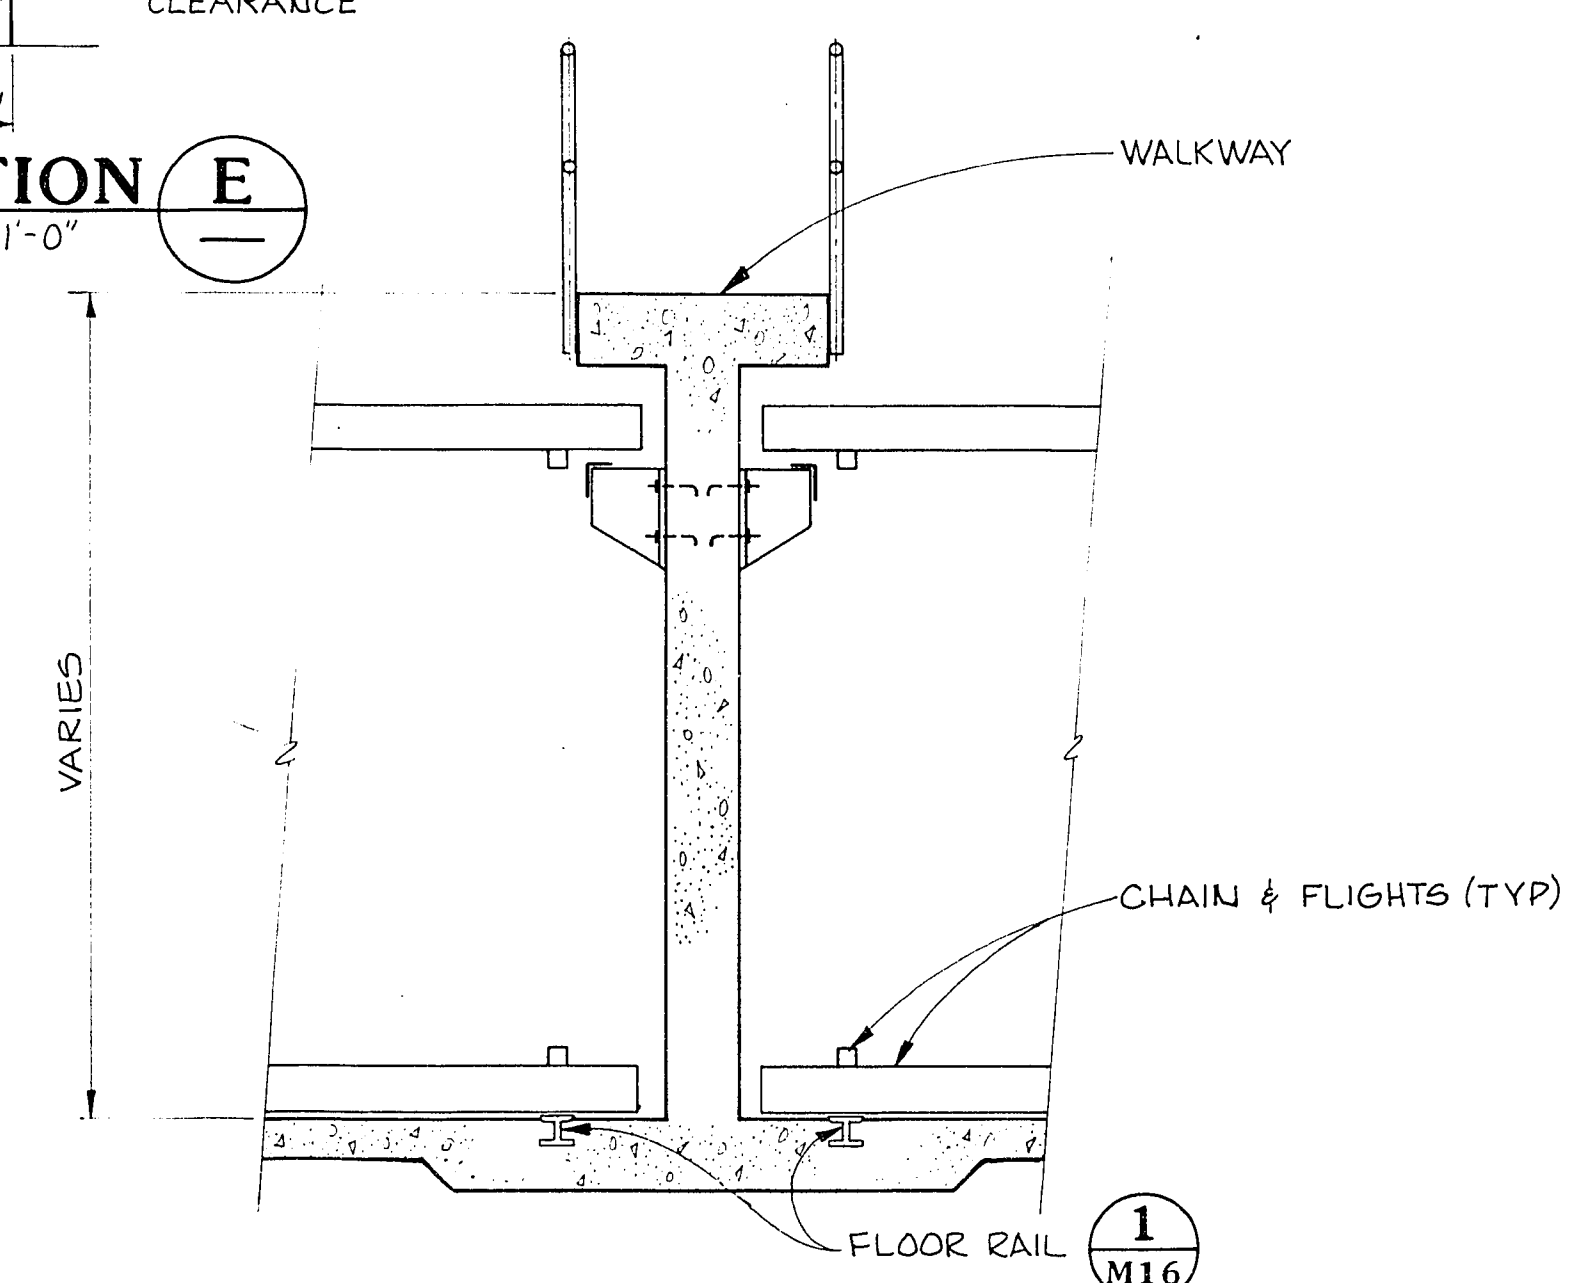

SECTION D
3/8" = 1'-0" M7, M9

CULP/WESNER/CULP
CLARKSON PARK, CALIFORNIA
SANTA ANA, CALIFORNIA - DENVER, COLORADO

City of Las Vegas
WASTEWATER TREATMENT PLANT
Main Plant Expansion
Contract No. 1

PRIMARY & SECONDARY SEDIMENTATION BASINS
SECTIONS

Job No. 740.11
Designed DAP
Drawn GHS
Checked DJR
Approved DAP
Date 12/9/88

1. NOTED ACCORDING TO 1.5.92
CONSTRUCTION RECORDS

Revision Description
No. By

Sheet 102
M-11
of 164

6-1-102 311.21