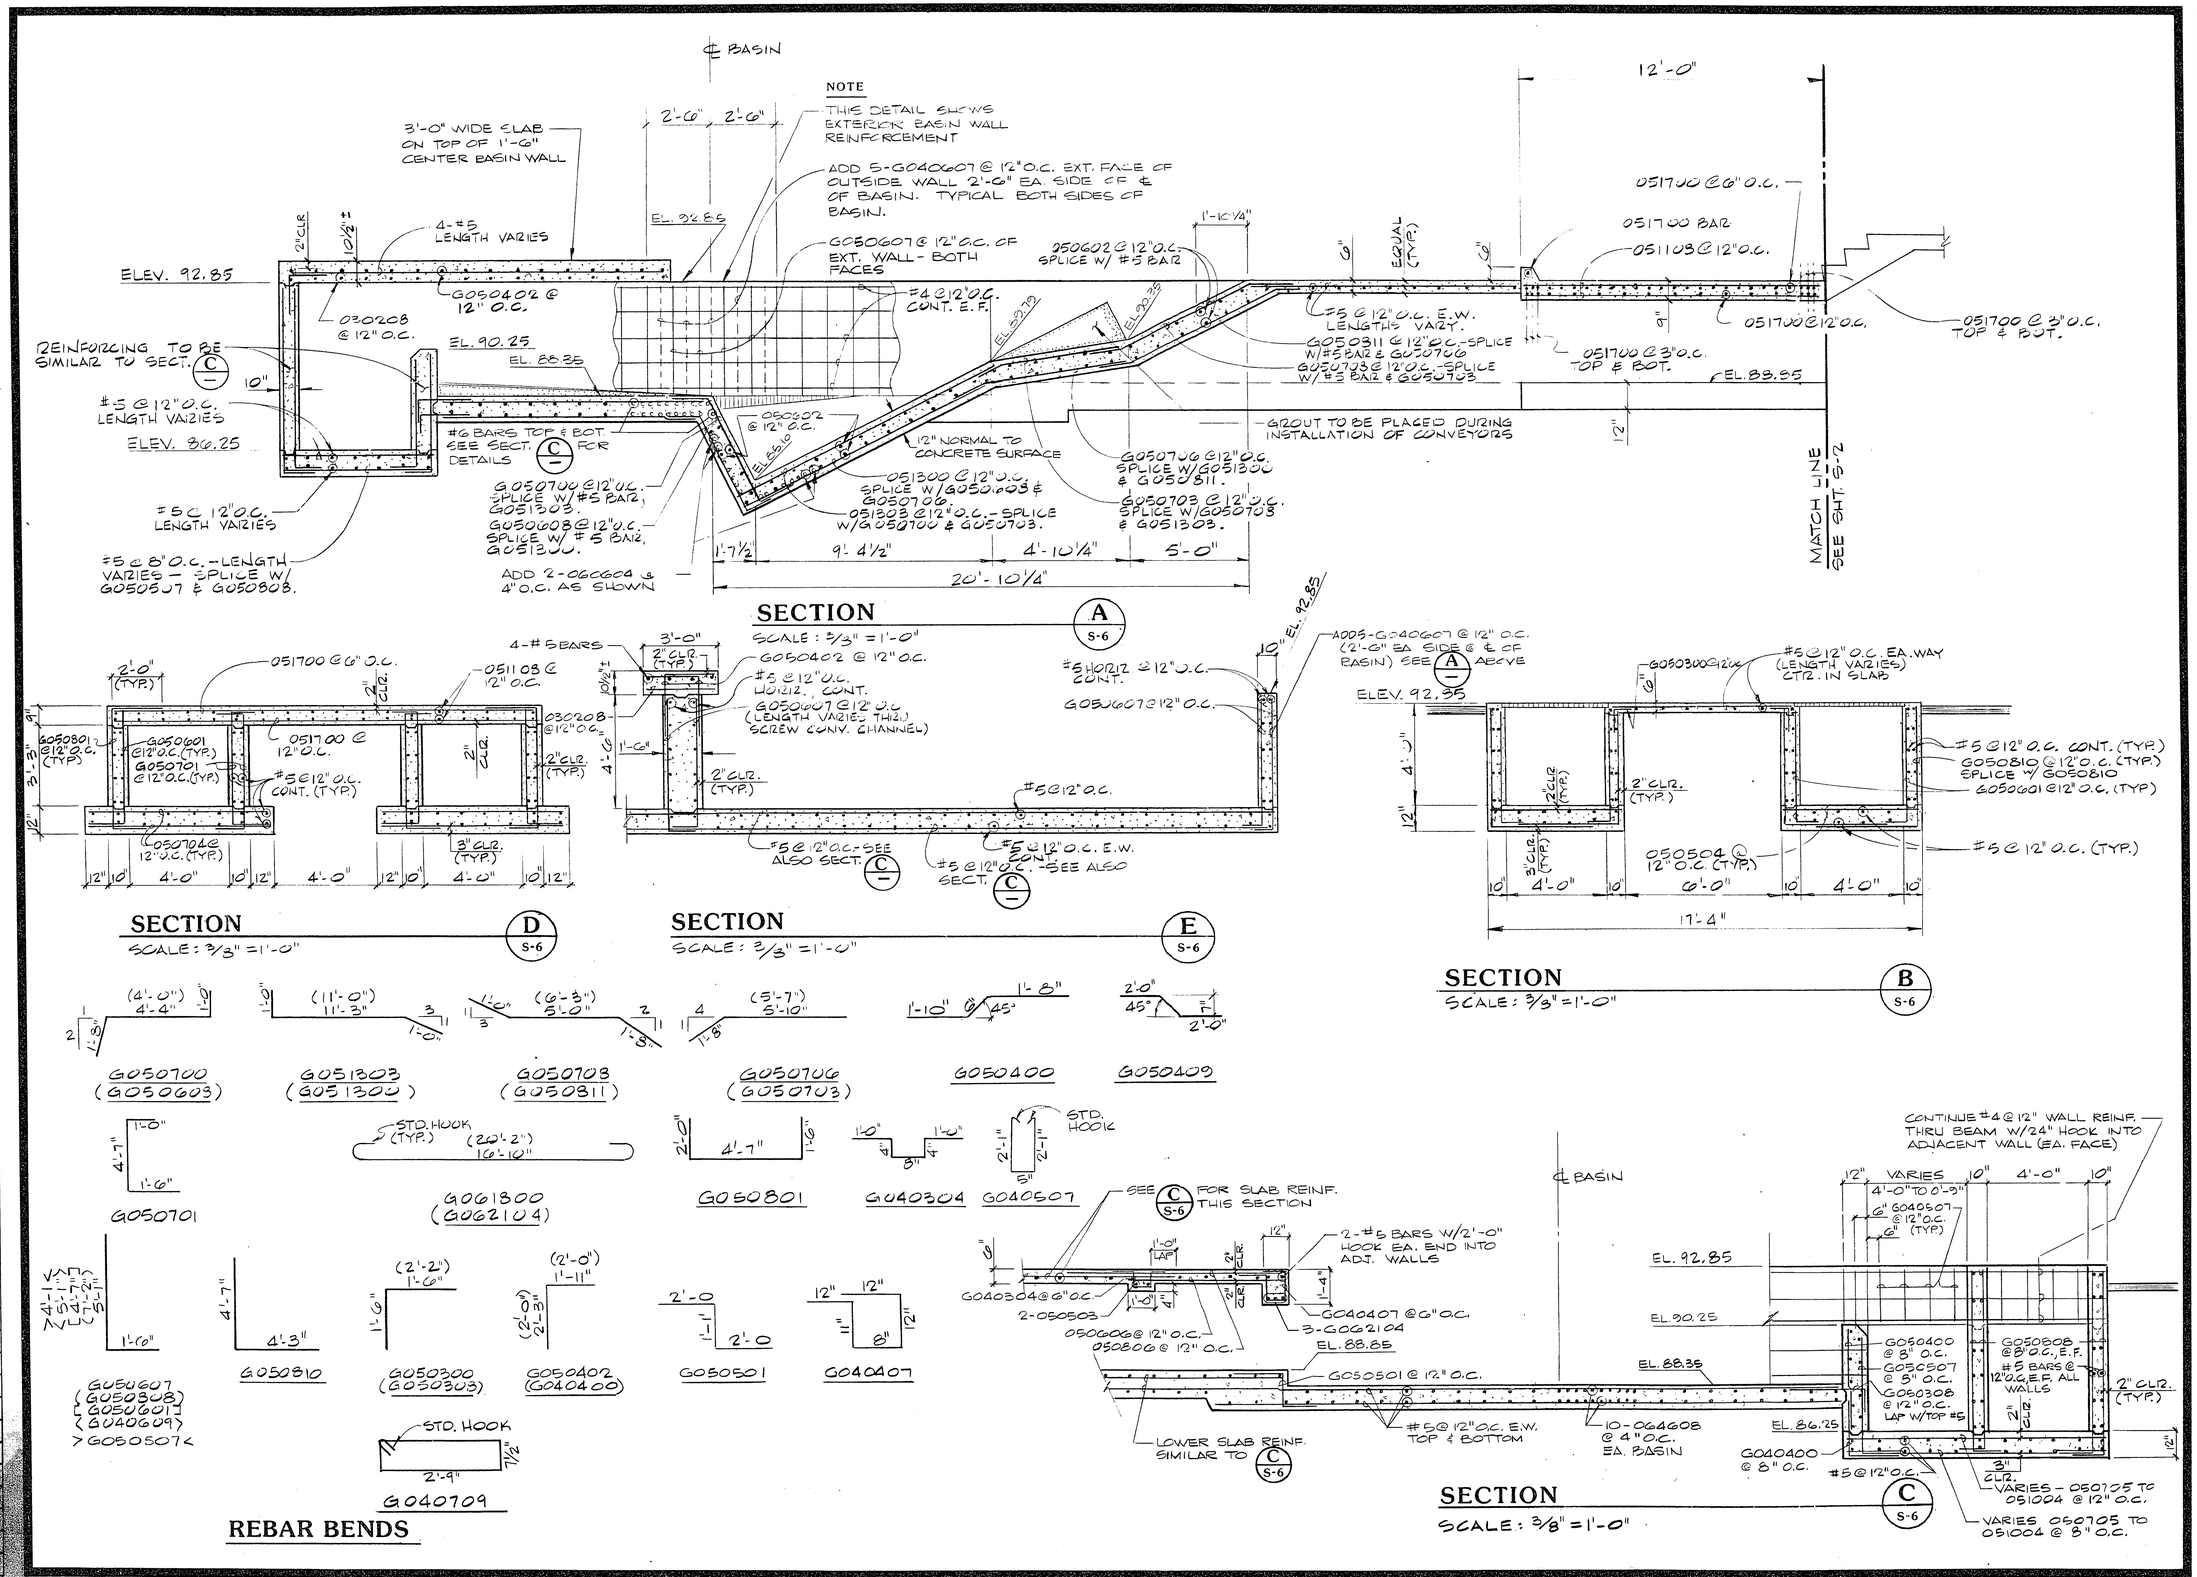

CULP/WESNER/CULP
CAMERON PARK, CALIFORNIA
SANTA ANA, CALIFORNIA · DENVER, COLORADO

REGISTERED PROFESSIONAL ENGINEER STATE OF NEVADA
LARRY A. NELSON
CIVIL
No. 6128

HDR
HDR Engineering, Inc.
A Member of the HDR Family of Companies

Job No. 740.11
Designed GCW
Drawn GCW
Checked
Approved
Date

No.	By	Revision Description	Date
1	P.K.	CORRECTED ACCORDING TO CONSTRUCTION RECORDS	5-92

G.C. WALLACE
Consulting Engineers, Inc.
1555 South Rainbow Blvd · Las Vegas, Nevada 89102 · 365-1200

CITY OF LAS VEGAS
WASTEWATER TREATMENT PLANT
Main Plant Expansion
Contract 1

GRIT BASIN
SECTIONS

Sheet 52
S-7
of 164

6-1-50

311.21