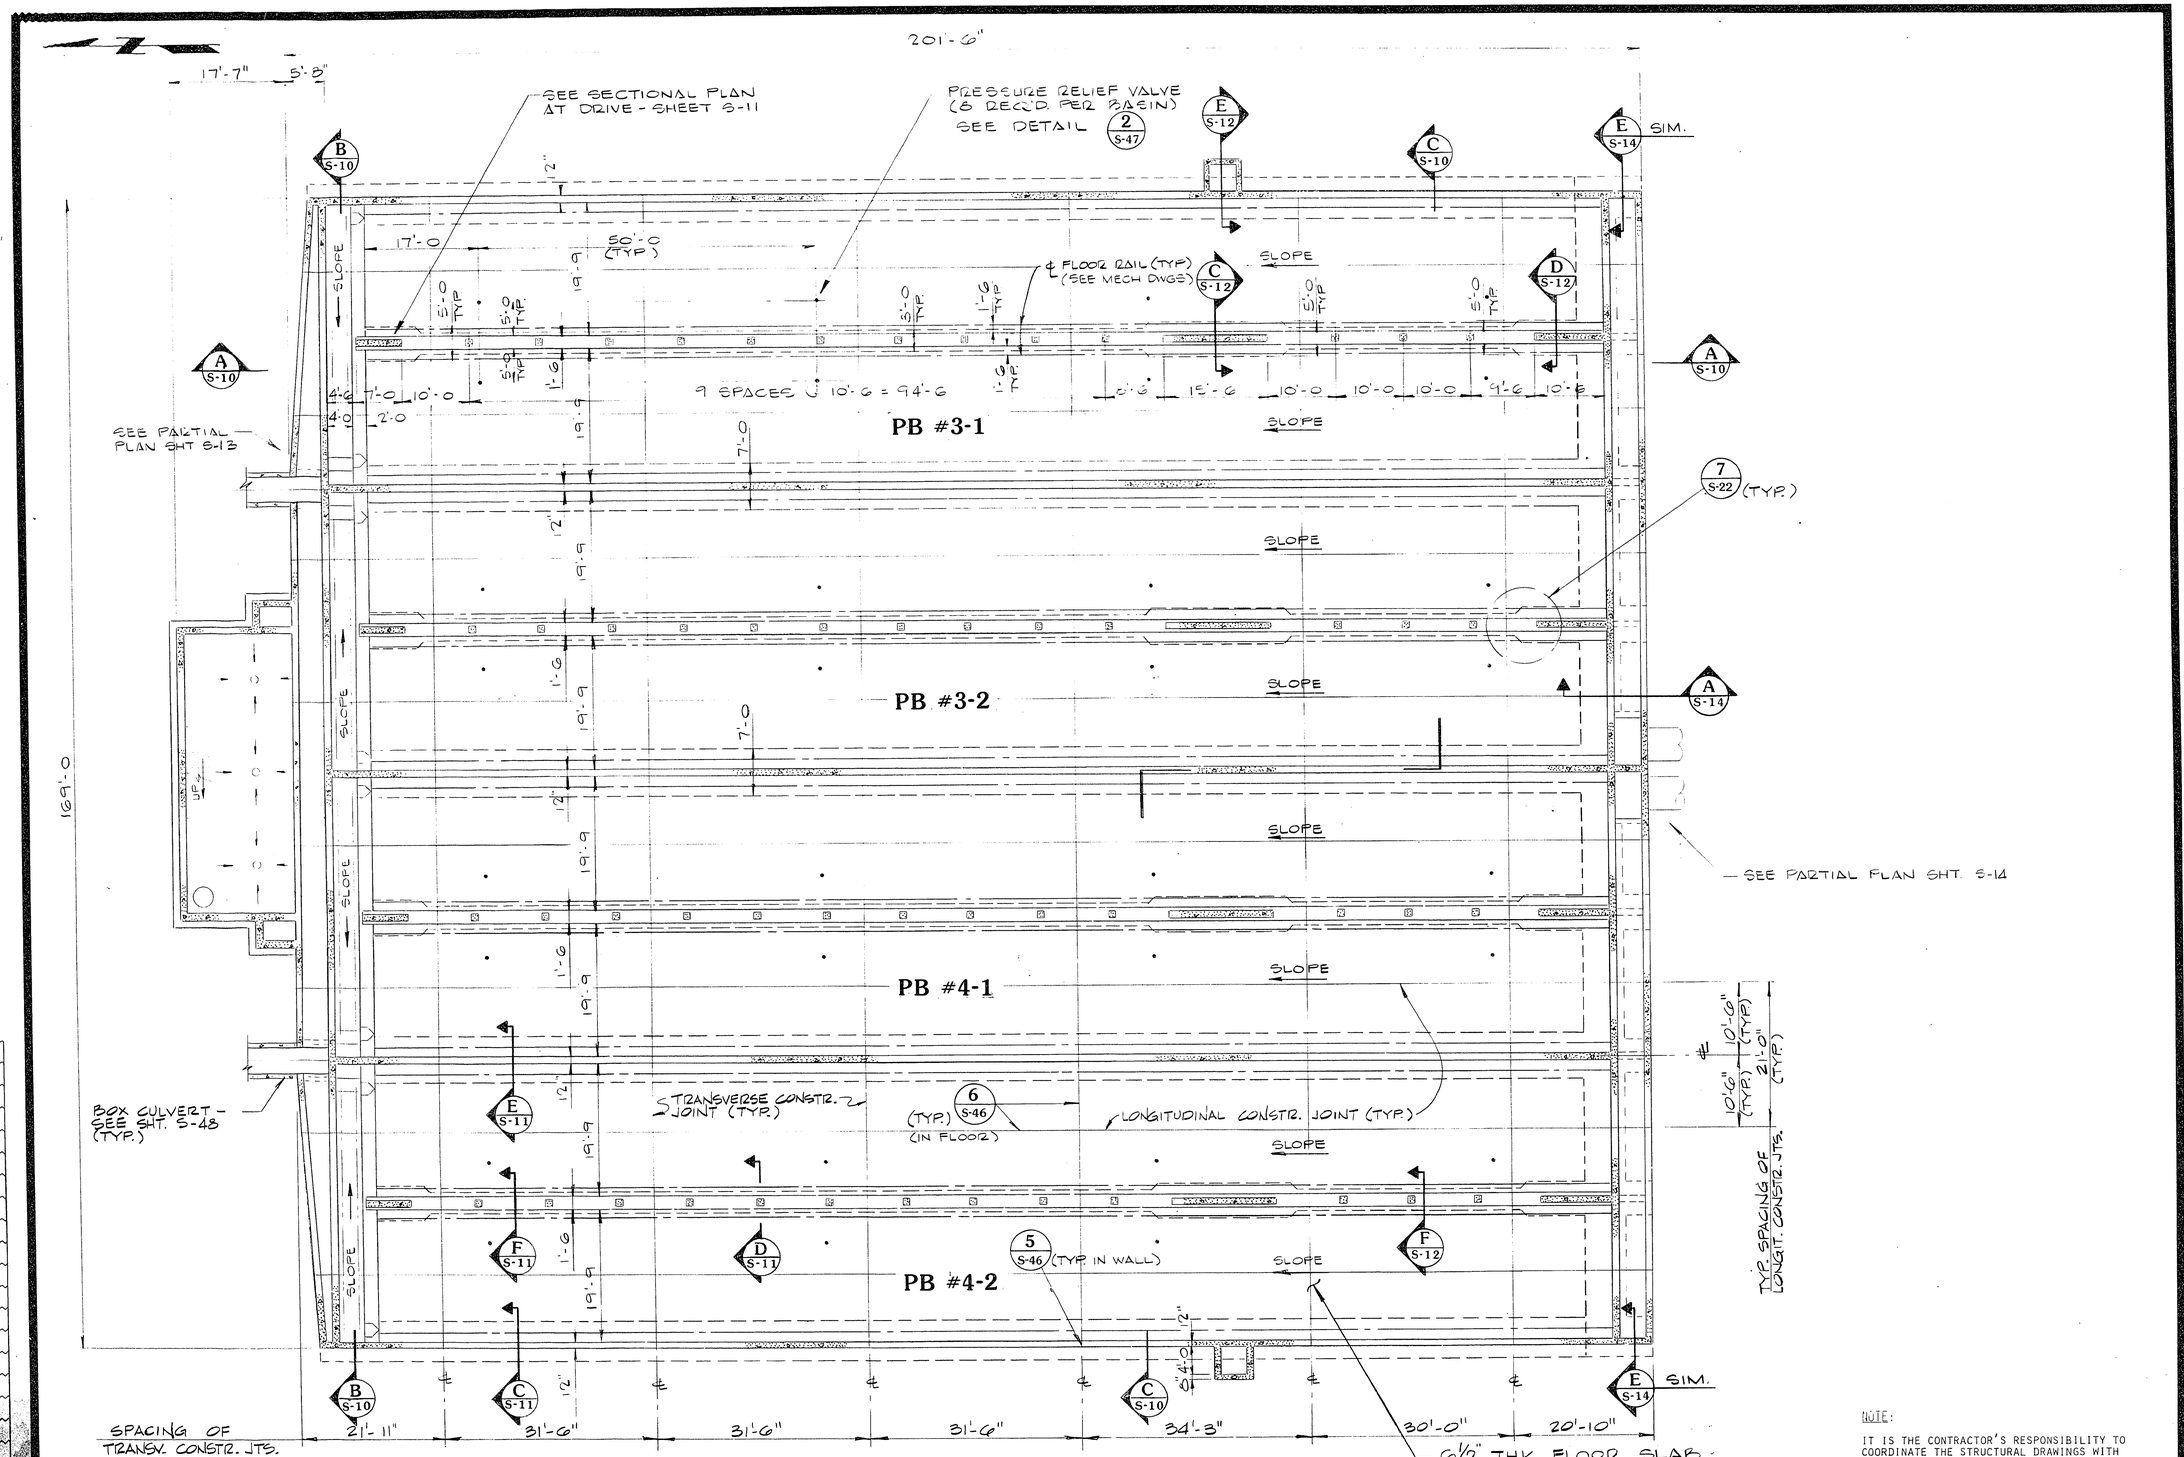

SECTIONAL PLAN

1" = 10'-0

NOTE:

IT IS THE CONTRACTOR'S RESPONSIBILITY TO COORDINATE THE STRUCTURAL DRAWINGS WITH ALL OTHER CONTRACT DOCUMENTS. STRUCTURAL DRAWINGS DO NOT ATTEMPT TO SHOW ALL PENETRATIONS, OPENINGS, ANCHOR BOLTS, MECHANICAL EQUIPMENT SUPPORTS, PIPE SUPPORTS, ELECTRICAL CONDUITS, ETC.

ALL OPENINGS SHALL CONFORM TO TYPICAL DETAILS ON SHEET S-47.

CULP/WESNER/CULP
CAMERON PARK, CALIFORNIA
SANTA ANA, CALIFORNIA DENVER, COLORADO

6/10/85

H D R
Chas. H. Ho. Jr.
Architect Engineers, Inc.
Denver

Job No. 740-11
Designed GCW
Drawn GCW
Checked
Approved
Date

No.	By	Revision Description	Date
1	P.W.	CORRECTED ACCORDING TO CONSTRUCTION DRAWINGS	5-82

G. C. WALLACE
Consulting Engineers, Inc.
1555 South Rancho Drive • Las Vegas, Nevada 89102 • 383-1000

CITY OF LAS VEGAS
WASTEWATER TREATMENT PLANT
Main Plant Expansion
Contract 1

PRIMARY SEDIMENTATION BASINS
SECTIONAL PLAN

Sheet 54
S-9
of 164

6-1-84
311.21