


DATE	PROJECT NO.	COUNTY	SECTION	SHEET NO.	TOTAL SHEETS
7-1-58	SU 549 (1)	CLARK	03-053	19	

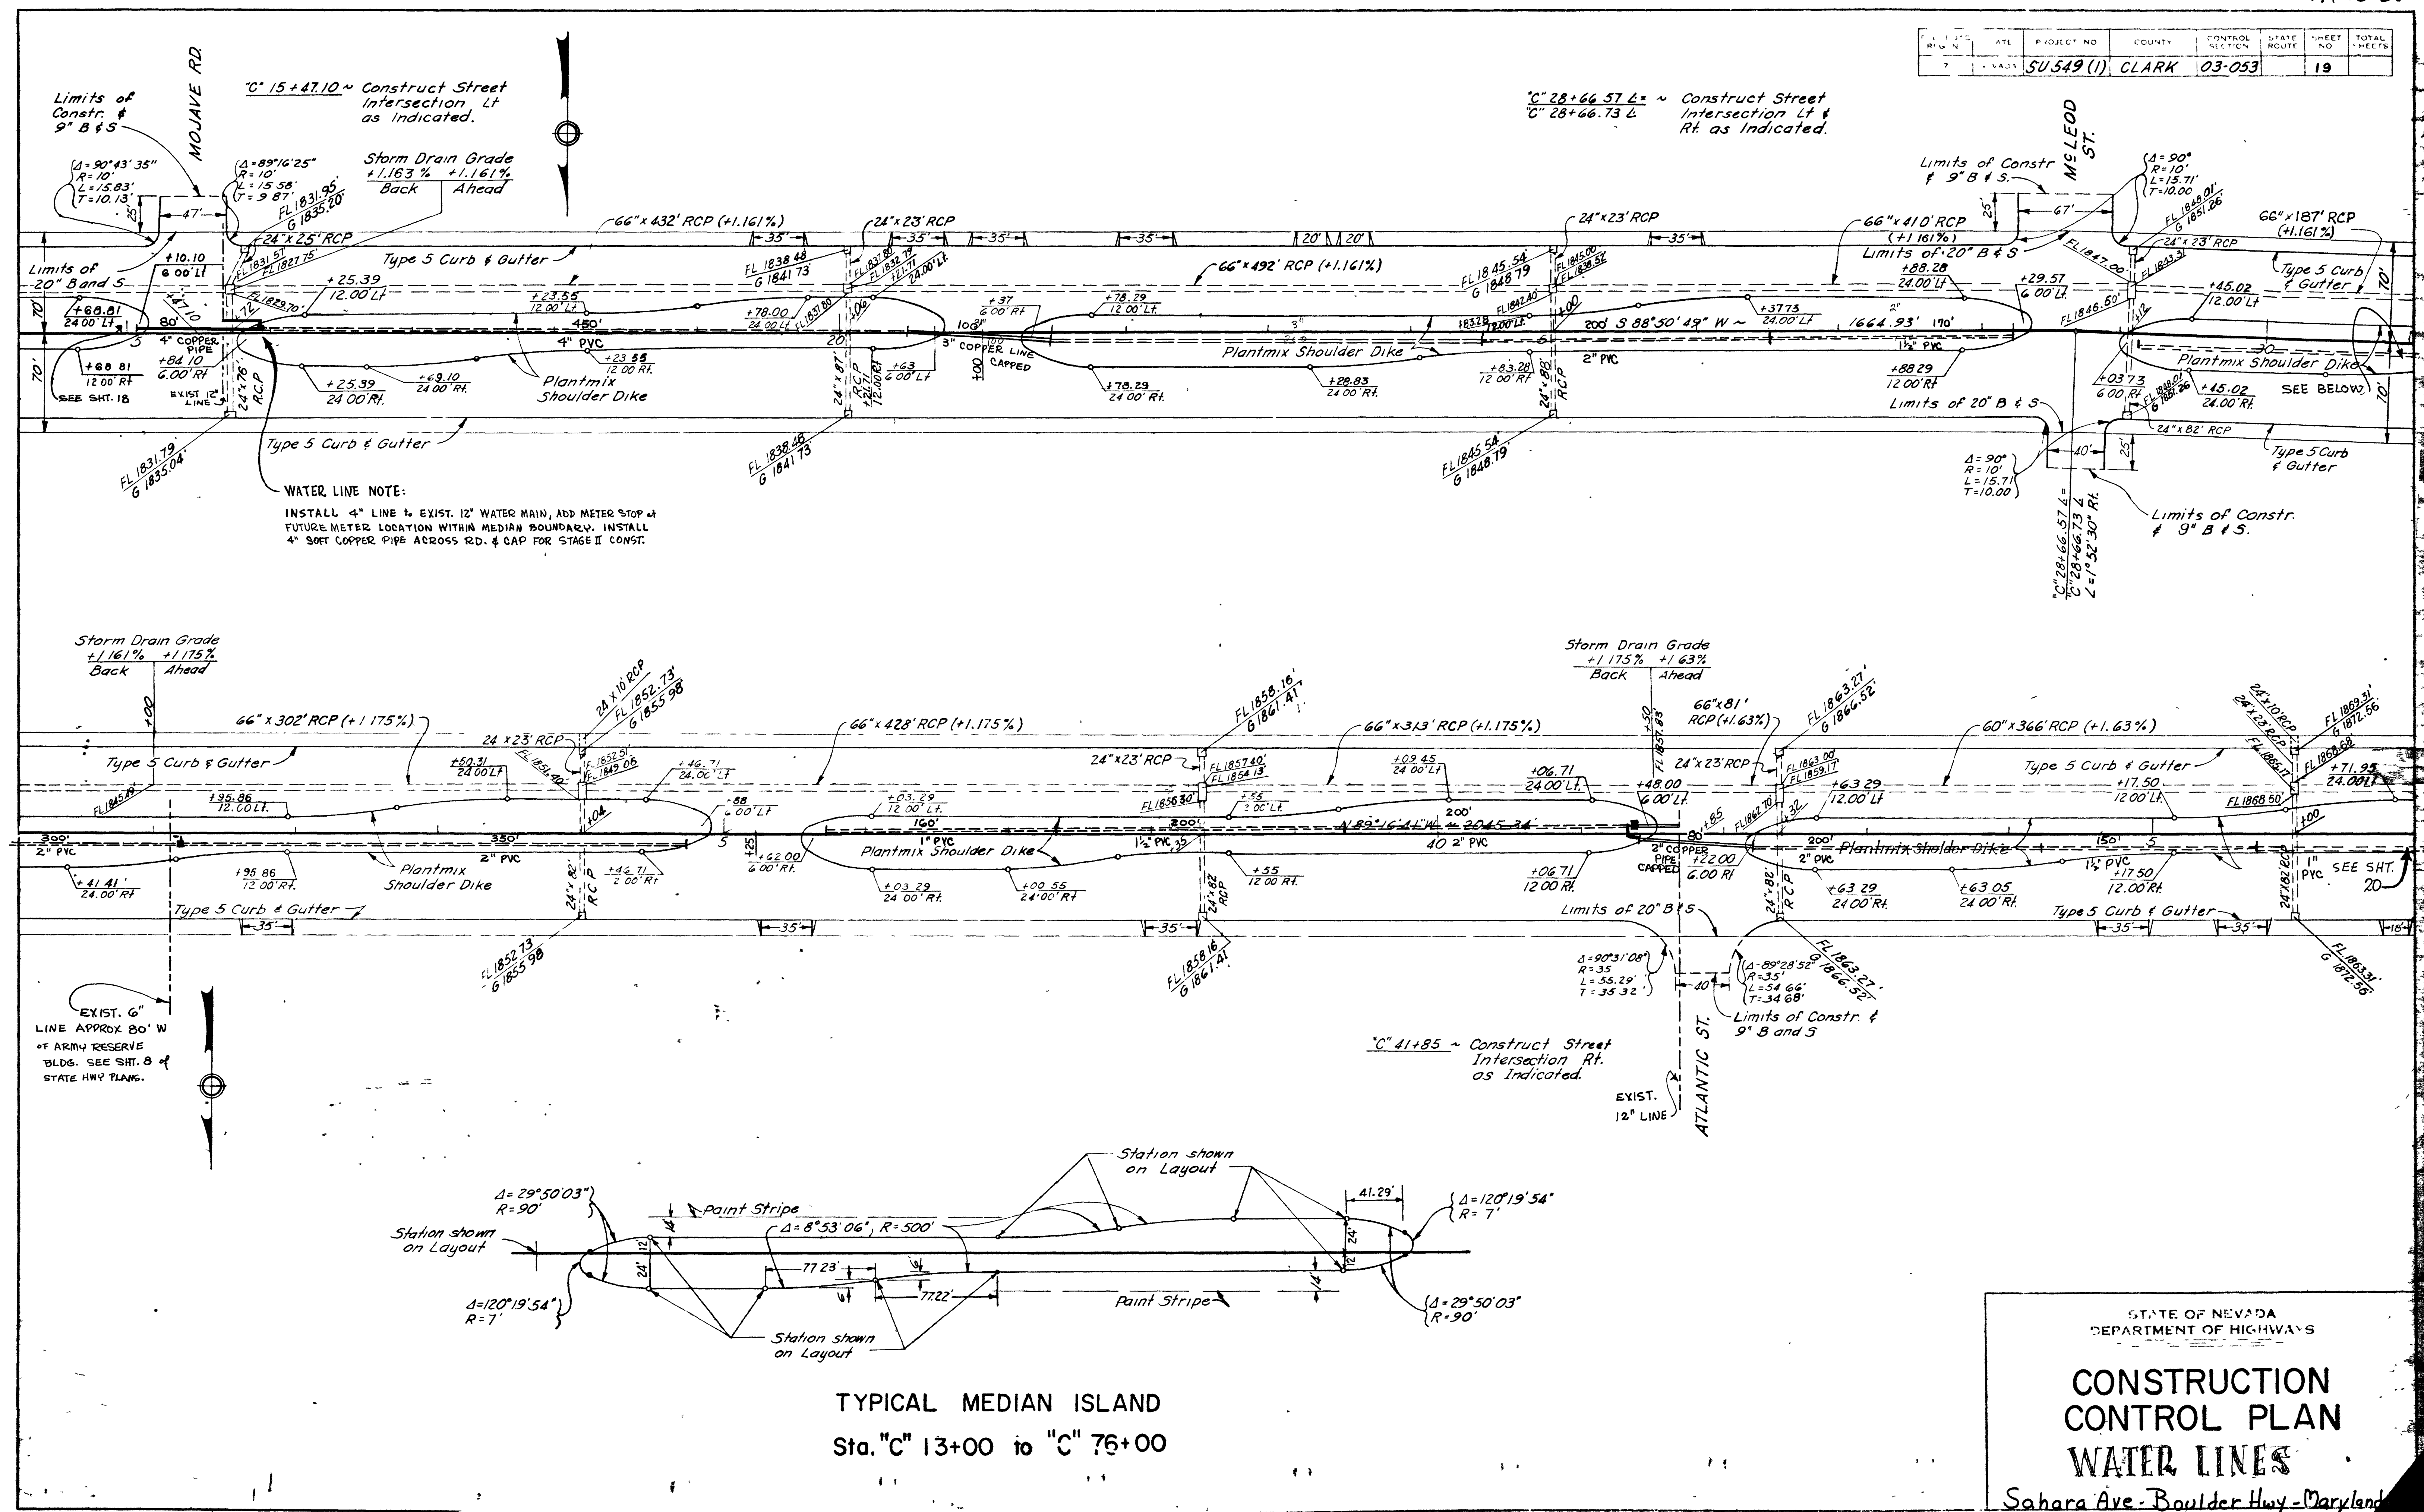

STATE OF NEVADA
 DEPARTMENT OF HIGHWAYS

**CONSTRUCTION
 CONTROL PLAN
 WATER LINES**

Sahara Ave - Boulder Hwy - Maryland

DWG. # 655-9
 SHT. # 2 OF 4

