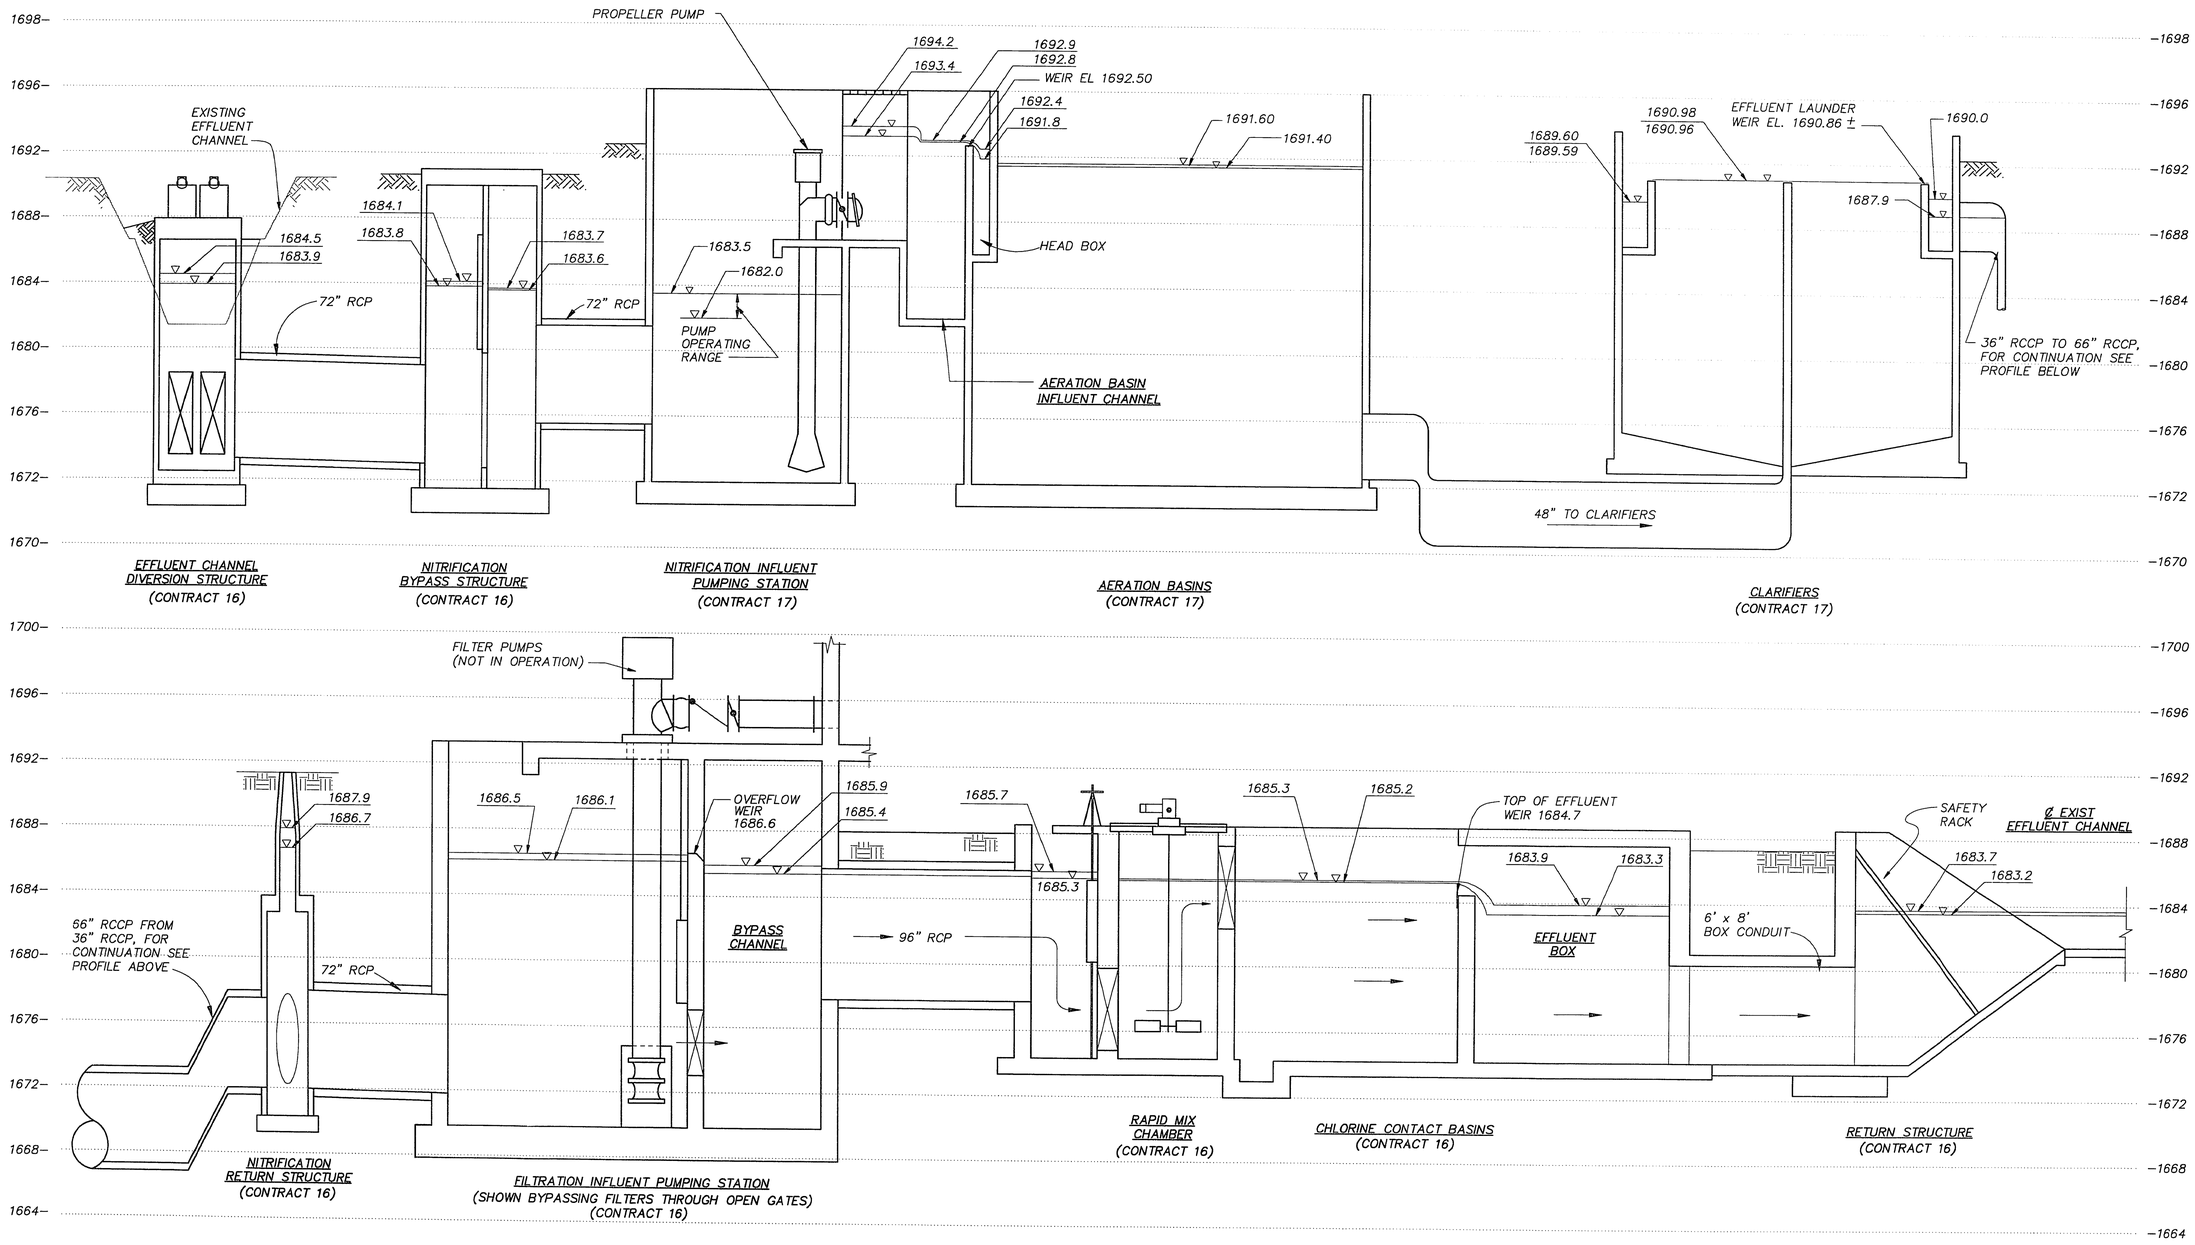

HDR

HDR Engineering, Inc.

Issue No.	Description	Date	Drwn.	Chkd.	Resp. Engr.	Proj. Mgr.
1	CORRECTED ACCORDING TO CONSTRUCTION RECORD	1/95	RRL		MJH	JJC
A	ISSUED FOR BIDS	4/20/92	BMP	GPC	GPC	JJC

Project Manager: JOHN J. CHUEH
Architect
I&C/Process
Civil: G. COSTAN
Mechanical
Electrical
Structural
Drawn By: R. LIVINGSTON

City of Las Vegas

Water Pollution Control Facility
Nitrification / Filtration Facilities

Contract 17
NITRIFICATION COMPLEX

HYDRAULIC PROFILE

66 MGD (AVERAGE DAY)
99 MGD (MAXIMUM DAY)

Date: APRIL 1992
Scale: NONE
Project No.: 00120-084-141
Drawing No.: G-107
Issue: 1

311.35