10-1-9

BAR LENGTH ON ORIGINAL DRAWING EQUALS 2" (50.8mm)

GENERAL NOTES:

1. IMPROVEMENTS ARE ORIENTED DUE NORTH/SOUTH AND EAST/WEST UON.
2. CONTRACTOR TO ADJUST GRADE OF EXISTING VALVE BOXES, MANHOLES, & ELECTRICAL BOXES AS REQUIRED BY NEW GRADING & PAVING
3. SPOT ELEVATIONS ARE FINISH GRADE OF PAVED OR UNPAVED AREAS

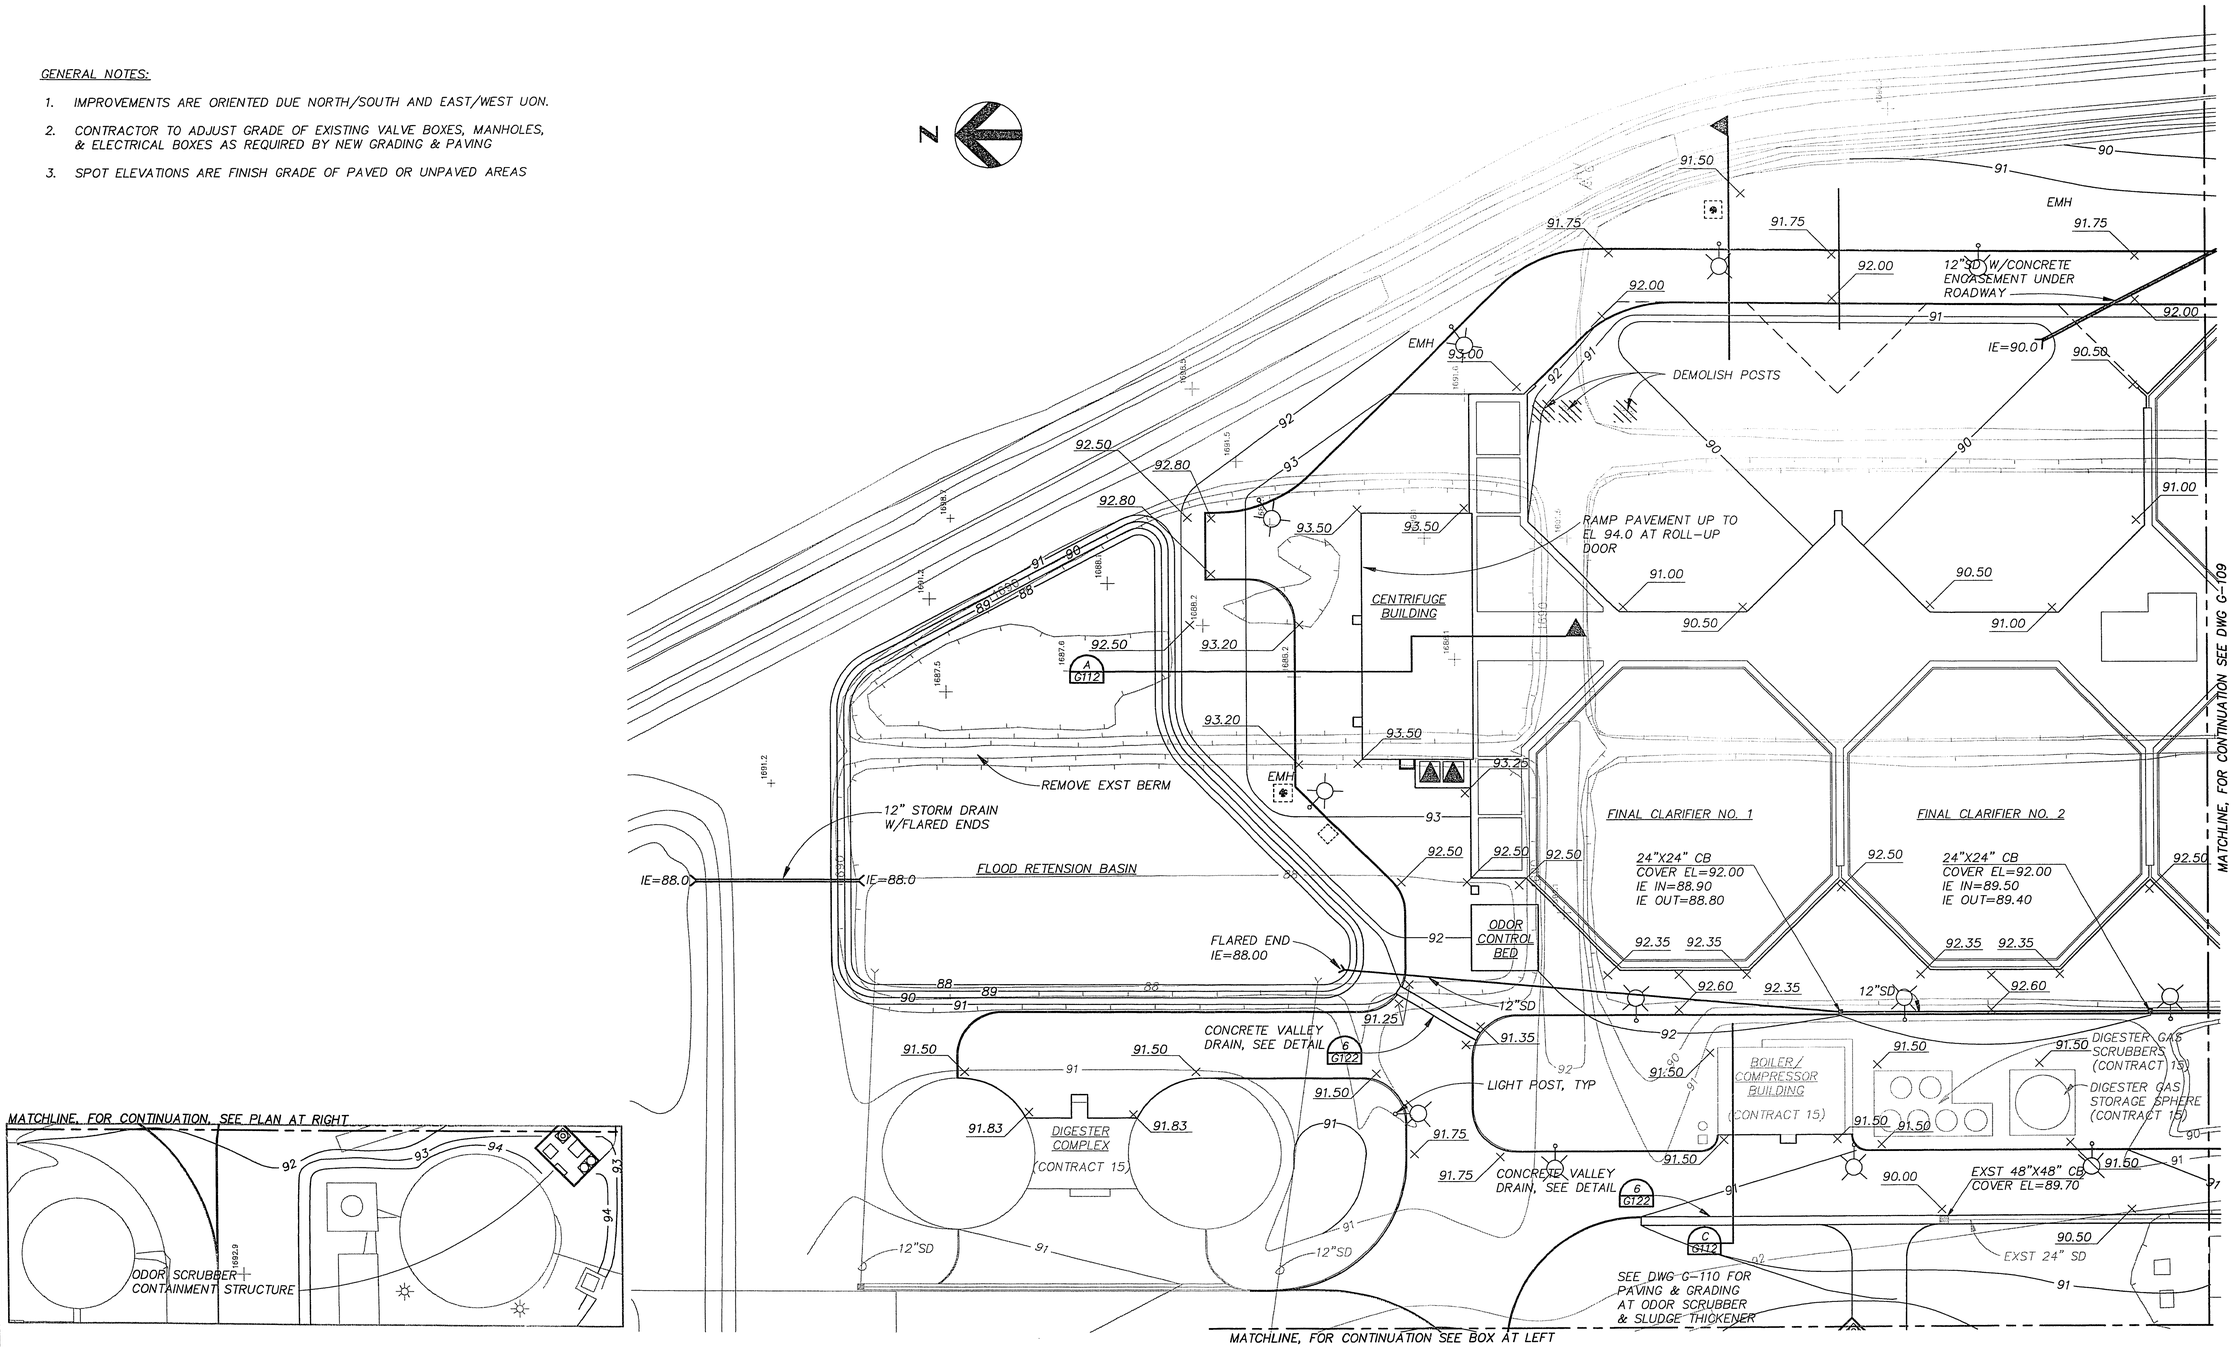

HDR

HDR Engineering, Inc.

Issue No.	Description	Date	Drawn.	Chkd.	Resp. Engr.	Proj. Mgr.
1	CORRECTED ACCORDING TO CONSTRUCTION RECORD	1/95	RRL		MJH	JJC
0	ISSUED FOR CONSTRUCTION	8/20/92	RRL	GPC	GPC	JJC

Project Manager: JOHN J. CHUEH
Architect | I&C/Process
Civil: G. COSTAN | Mechanical
Electrical | Structural
Drawn By: R. LIVINGSTON

City of Las Vegas

Water Pollution Control Facility
Nitrification / Filtration Facilities

Contract 17
NITRIFICATION COMPLEX

GRADING & DRAINAGE PLAN

Date	Project No.	Drawing No.	Issue
AUGUST 1992	00120-084-141	G-108	1

Scale: 1" = 30'

311.35