


- GENERAL NOTES:**
1. DIMENSIONS ARE FACE TO FACE OF CURB U.O.N.
  2. FACILITIES ARE ORIENTED NORTH/SOUTH & EAST/WEST U.O.N.

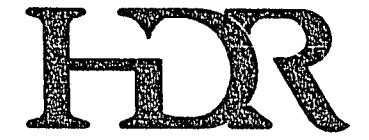

HDR Engineering, Inc.

Issue No.	Description	Date	Drawn	Checked	Responsible	Project Mgr.
1	CORRECTED ACCORDING TO CONSTRUCTION RECORD	1/95	RRL	EFH	MJH	JJC
A	ISSUED FOR BIDS	4/20/92	RRL	GPC	GPC	JJC

Project Manager <b>JOHN J. CHUEH</b>	
Architect	I&C/Process
Civil	Mechanical
Electrical	Structural
Drawn By <b>R. LIVINGSTON</b>	

*City of Las Vegas*  
**Water Pollution Control Facility  
 Nitrification / Filtration Facilities**  
 Contract 17  
**NITRIFICATION COMPLEX**

**PAVING PLAN**

Date APRIL 1992	Project No. 00120-084-141	Drawing No. G-111	Issue 1
Scale 1" = 30'			