
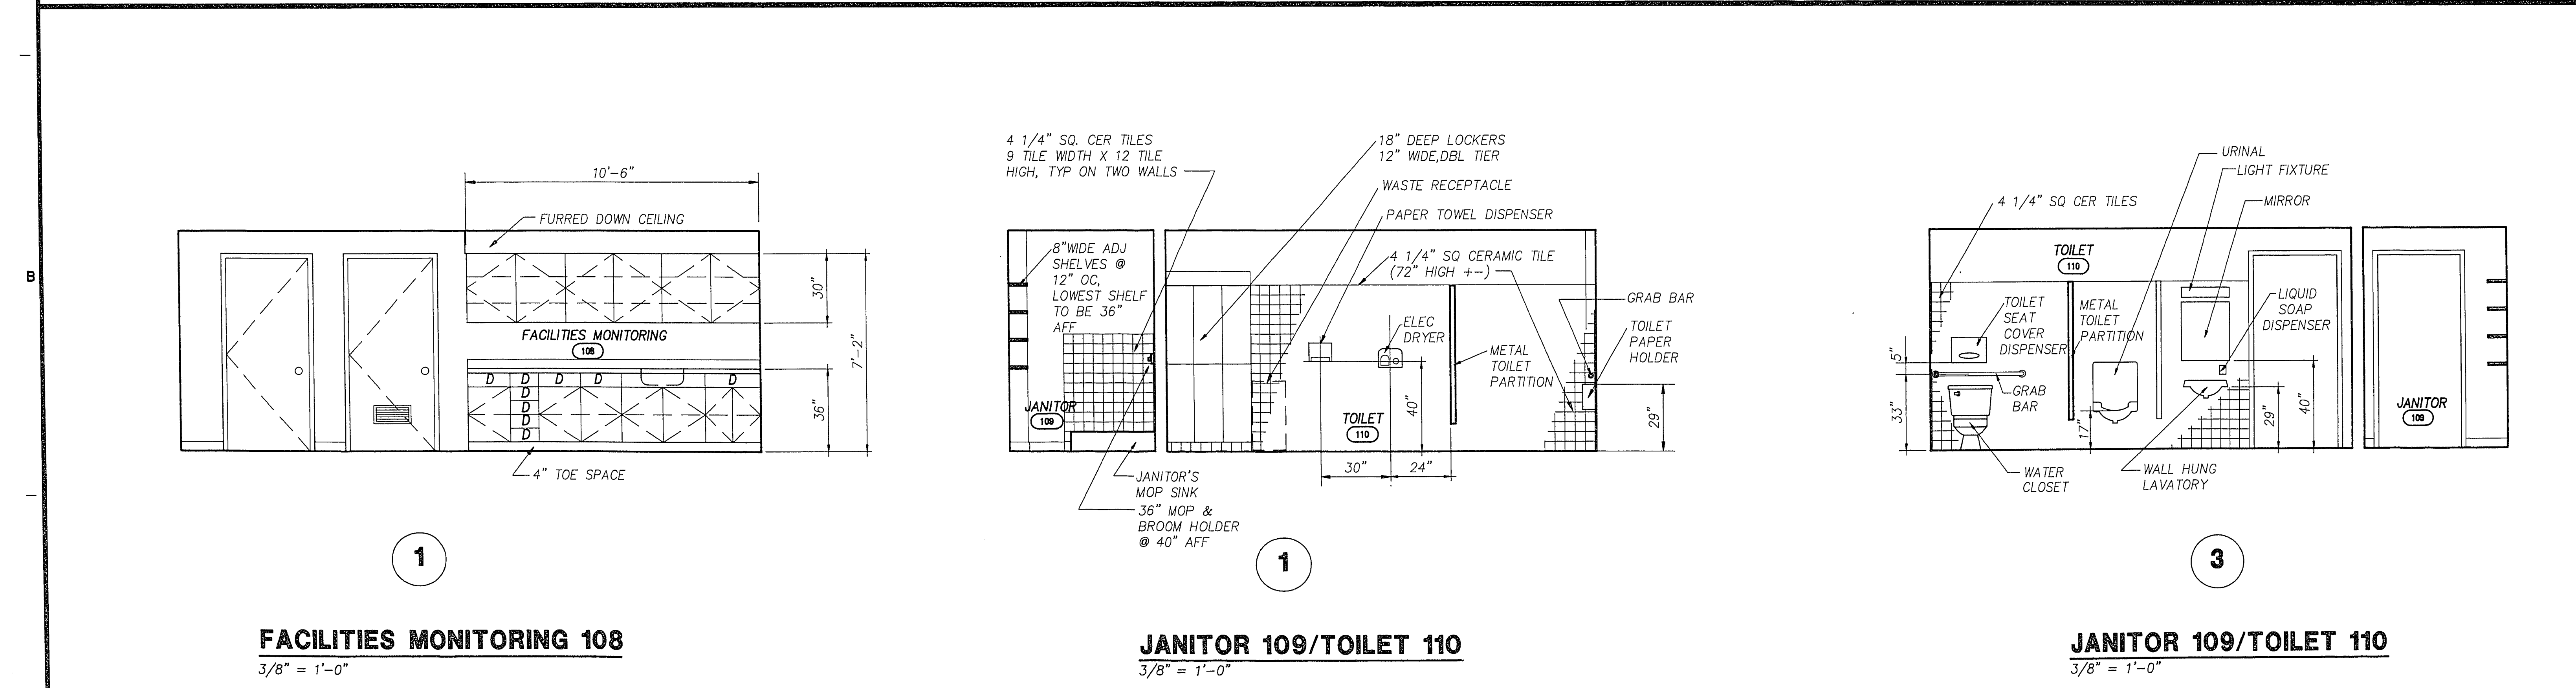
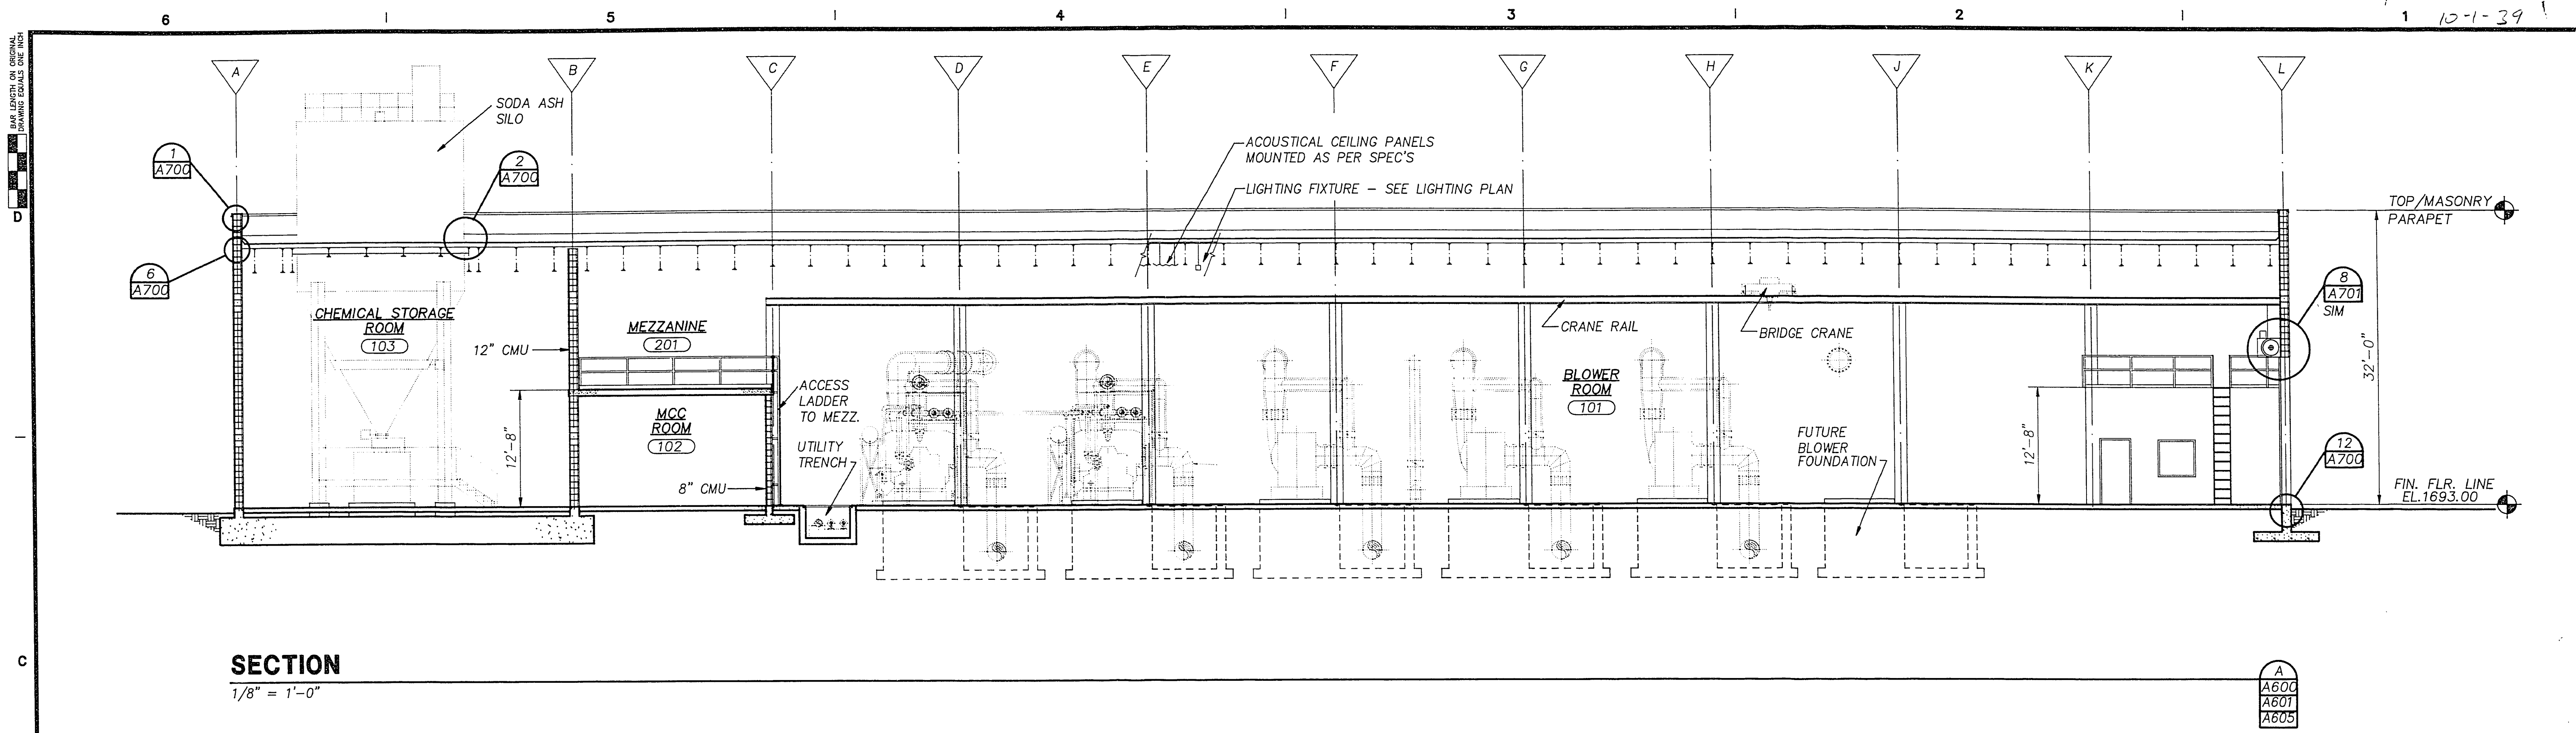


Issue No.	Description	Date	Drawn	Checked	Responsible	Project Manager
1	CORRECTED ACCORDING TO CONSTRUCTION RECORD	1/95	RRL	EFH	MJH	JJC
0	ISSUED FOR CONSTRUCTION	8/20/92	BDeL	DSD	DSD	JJC

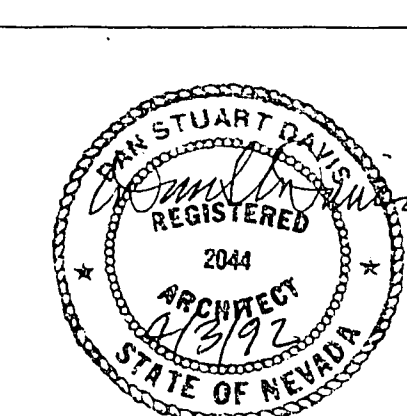

Project Manager	JOHN J. CHUEH
Architect	D. DAVIS
City	
Electrical	
Mechanical	
Structural	
Drawn By	B. DeLUNA

City of Las Vegas
**Water Pollution Control Facility
Nitrification / Filtration Facilities**
Contract 17
NITRIFICATION COMPLEX

BLOWER BUILDING		BUILDING SECTION & INTERIOR ELEVATIONS	
Date	APRIL 1992	Project No.	00120-084-141
Scale	AS NOTED	Drawing No.	A-603
		Issue	1