

6 5 4 3 2 1 10-1-43

D


C

B


A

39


4/10/92 12:00 PM 7/28/92

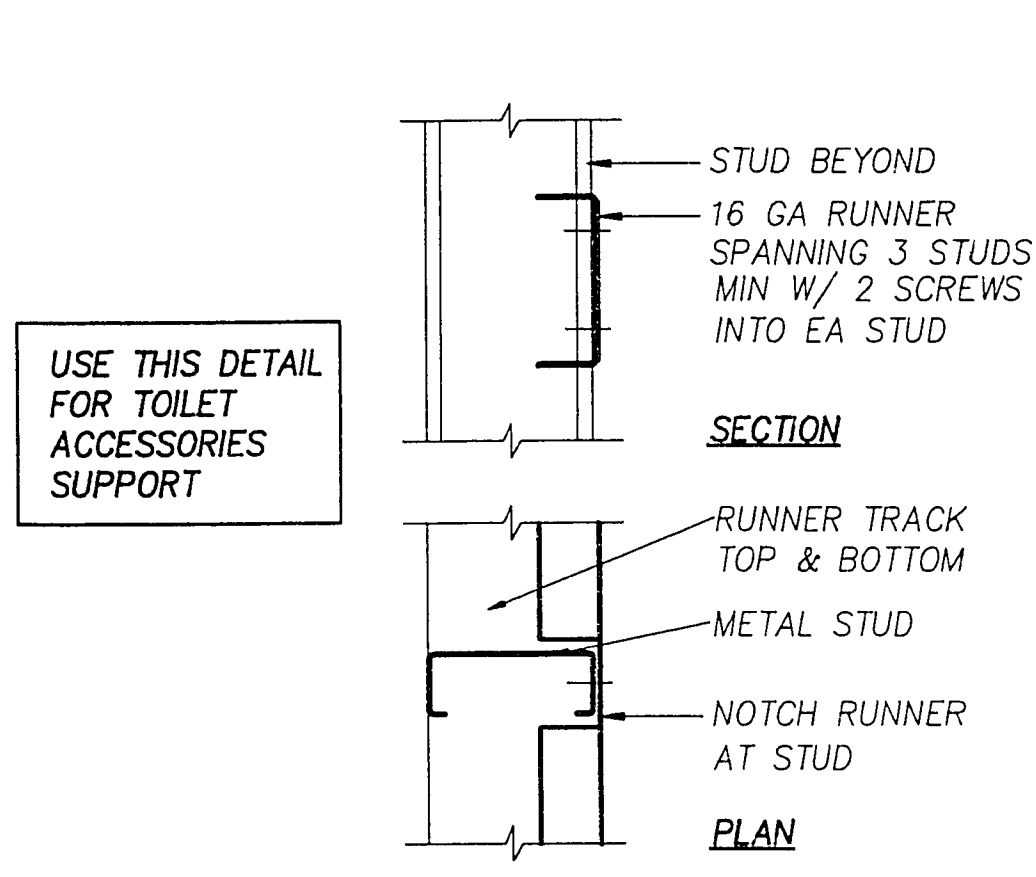


BACKING PLATE FRAMING 1 A702 3"=1'-0"

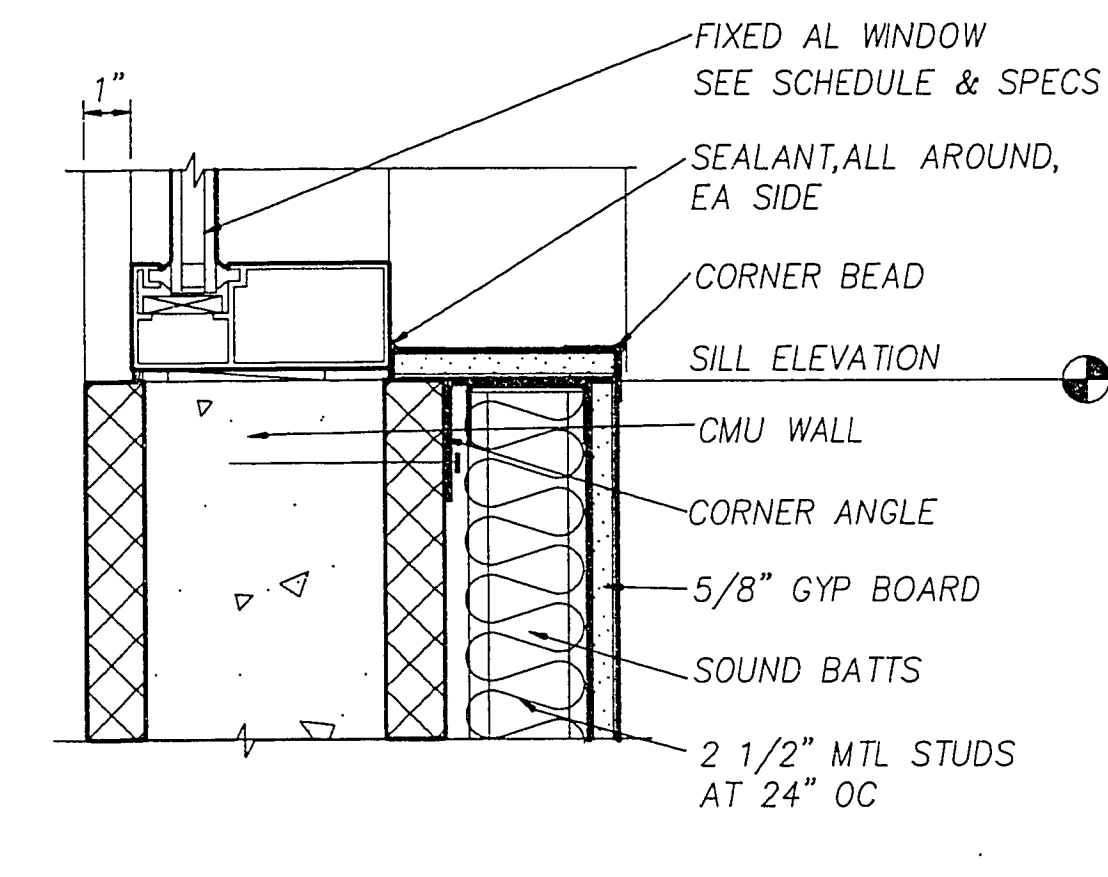


WINDOW SILL HEAD & JAMB SIMILAR 2 A602 3"=1'-0"

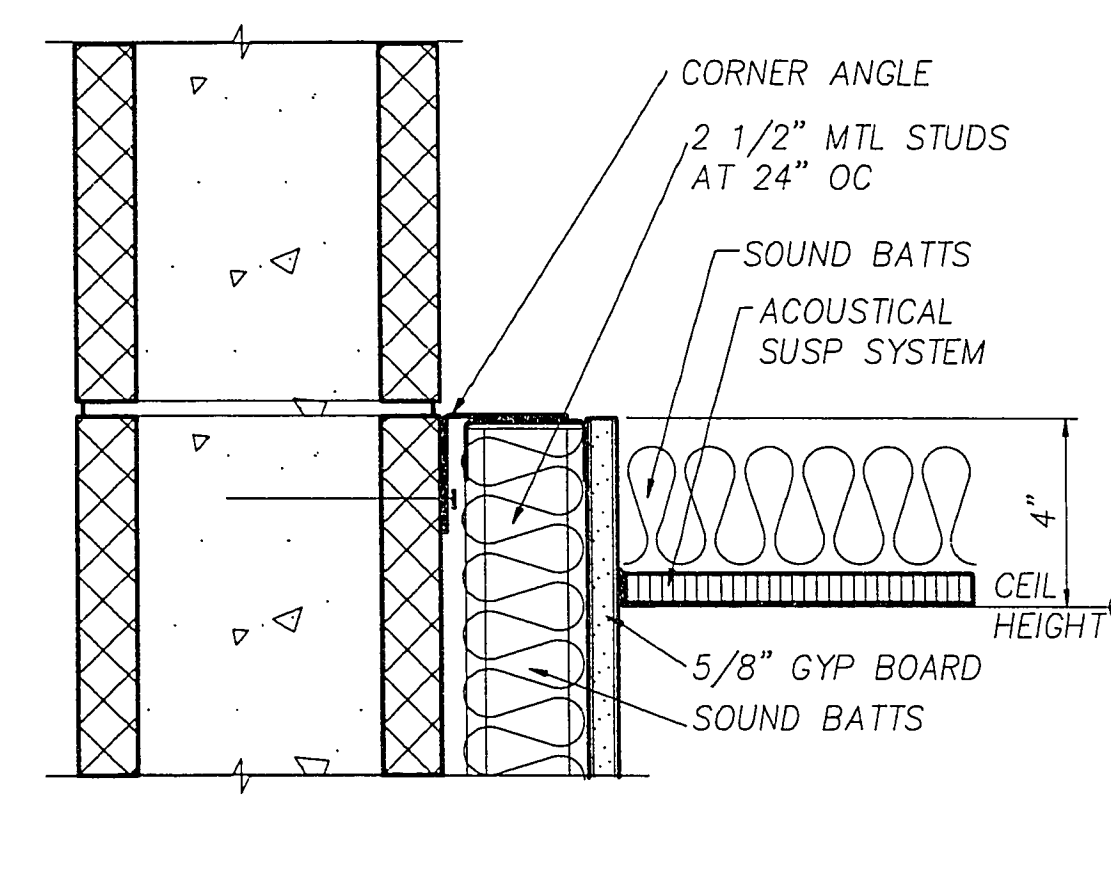


WALL /CEILING DETAIL 3 A600 3"=1'-0"

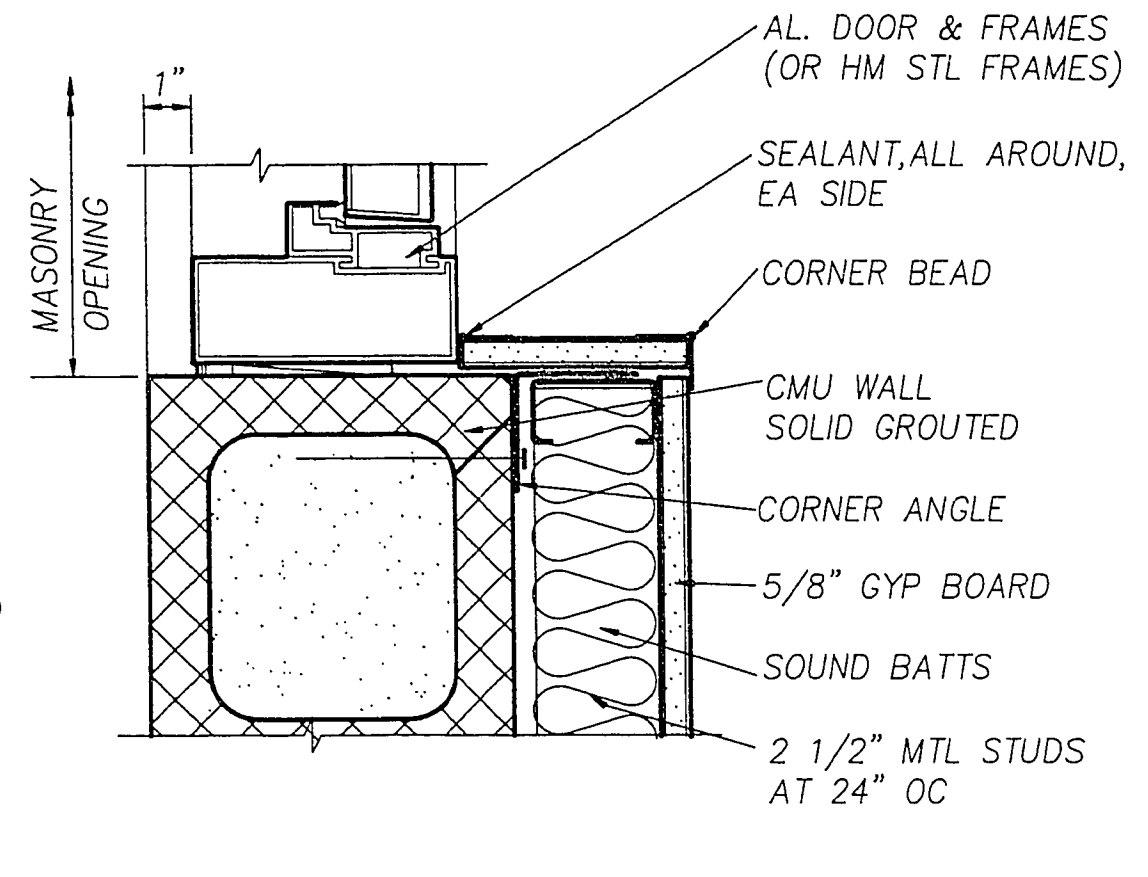


JAMB/FURRED CMU WALL 4 A600 3"=1'-0"

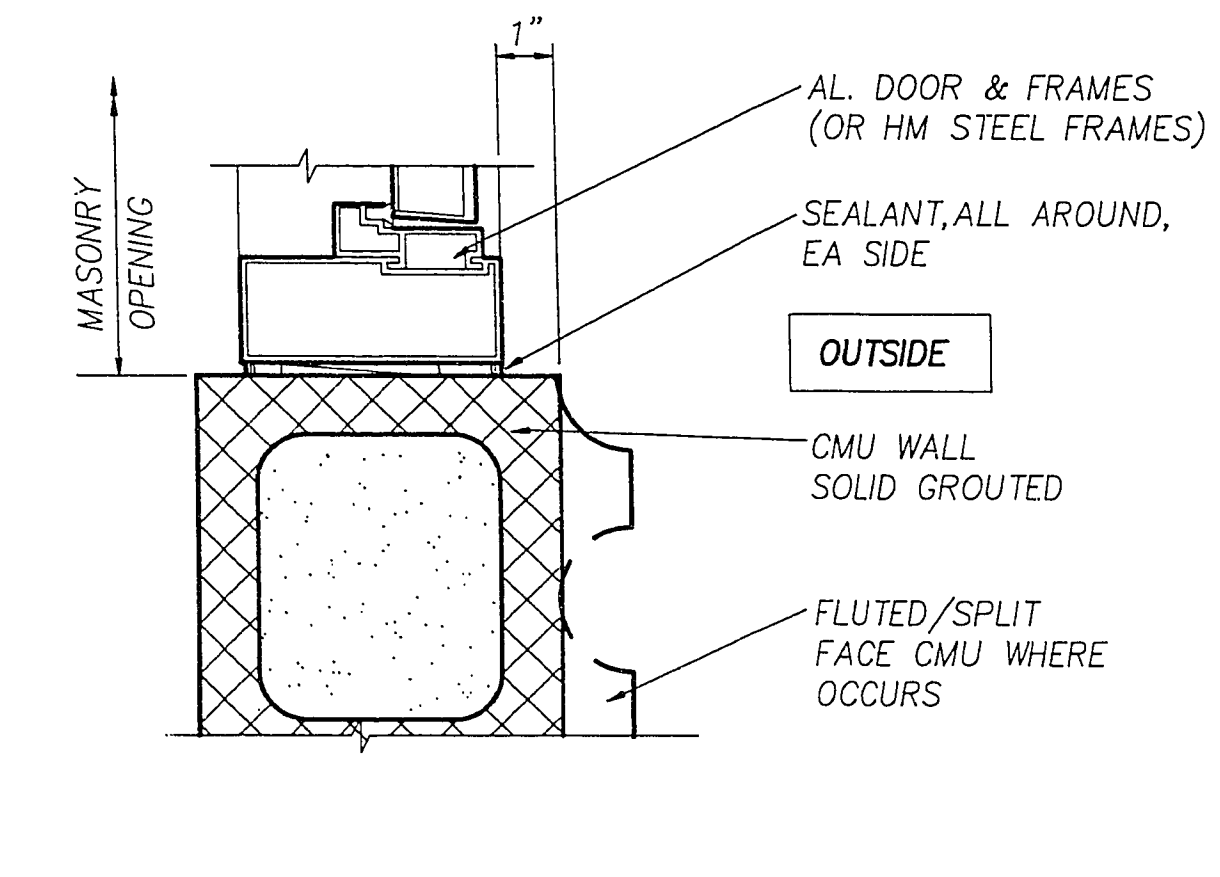


DOOR JAMB 5 A600 3"=1'-0"

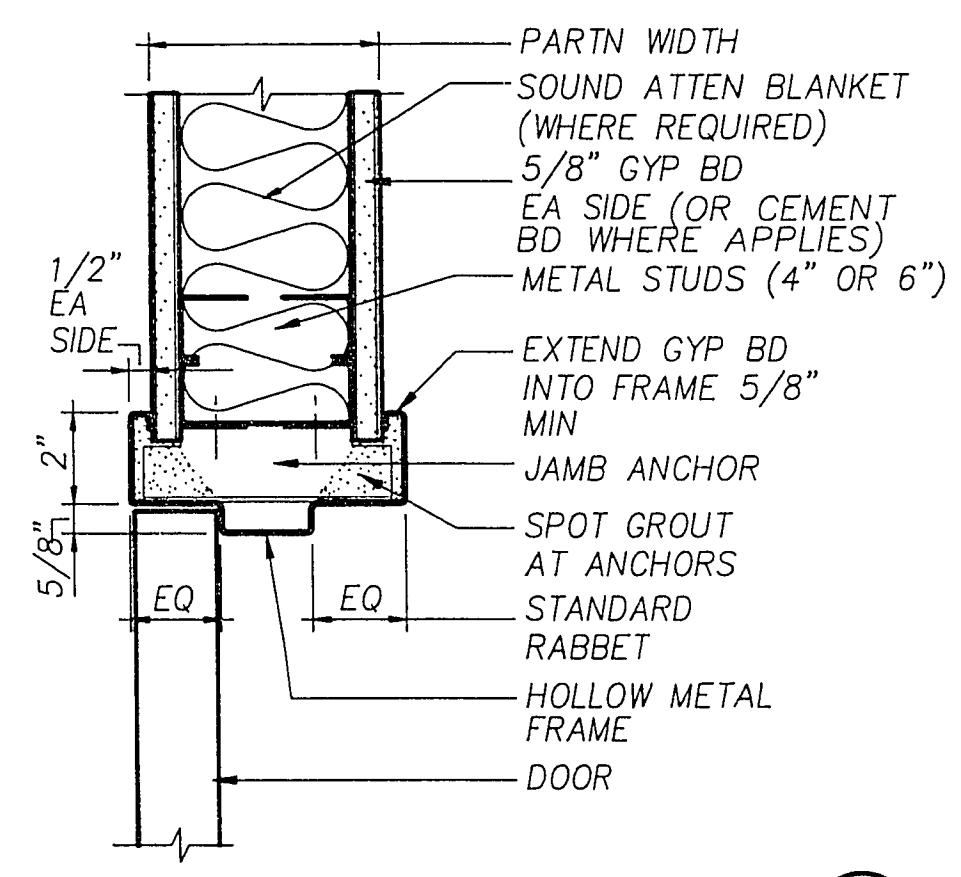


TYP DOOR JAMB- HM 6 A603 3"=1'-0"

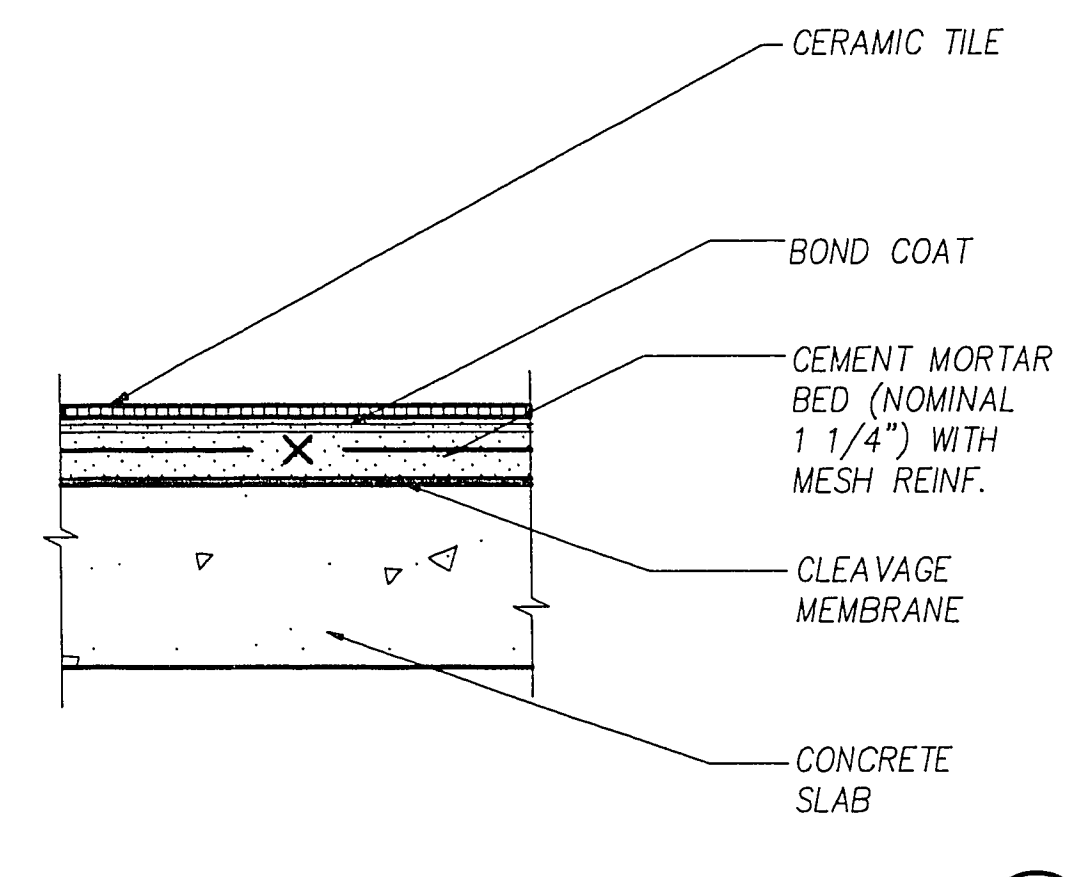


CERAMIC TILE SETTING 7 A600 3"=1'-0"

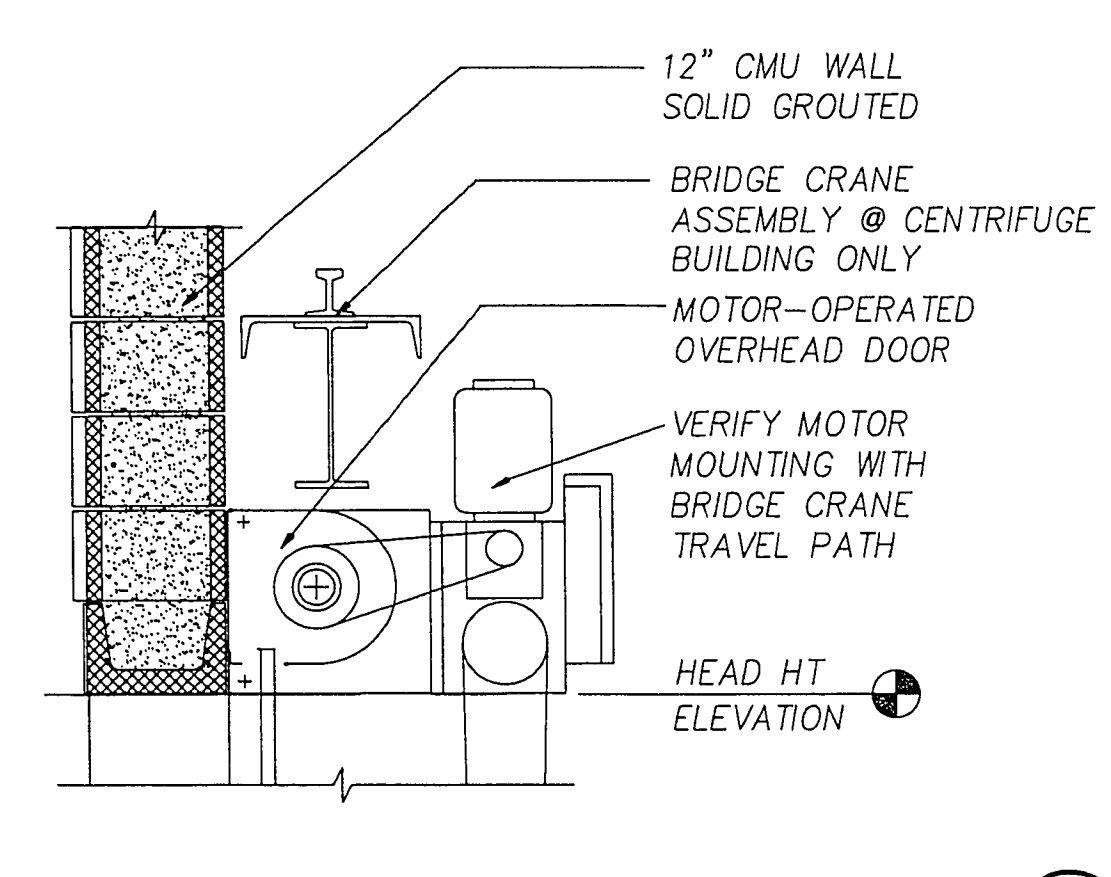

OVERHEAD DOOR HEAD 8 A602 A502 3/4"=1'-0"

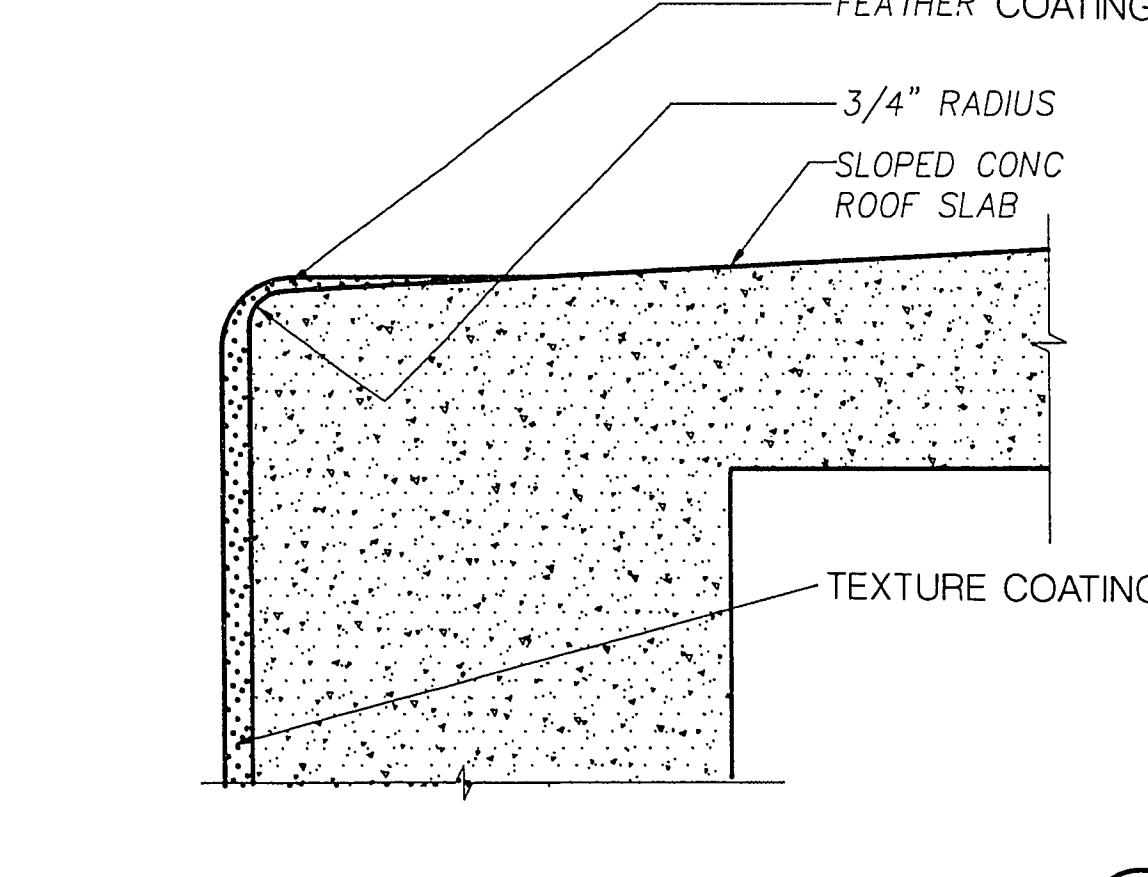

CONC ROOF DETAIL 9 A300 3"=1'-0"

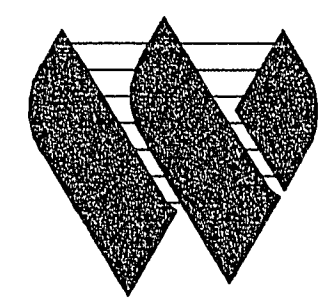


G.C. WALLACE, INC.
Engineering/Architecture



HDR Engineering, Inc.

Issue No.	Description	Date	Drawn	Checked	Prep. Engr.	Proj. Mgr.
1	CORRECTED ACCORDING TO CONSTRUCTION RECORD	1/95	RRL	EFH	MJH	JJC
0	ISSUED FOR CONSTRUCTION	9/20/92	BDel	DSD	DSD	JJC

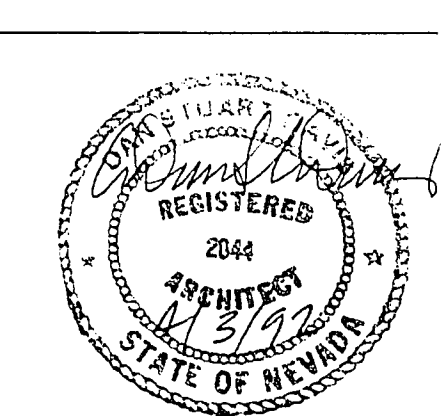

Project Manager	JOHN J CHUEH
Architect	DAN S DAVIS
Civil	
Electrical	
Structural	
Drawn By	BERT DeLUNA

City of Las Vegas
Water Pollution Control Facility
Nitrification / Filtration Facilities
Contract 17
NITRIFICATION COMPLEX

ARCHITECTURAL DETAILS

Date	APRIL 1992	Project No.	00120-084-141	Drawing No.	A-701	Issue	1
Scale	AS NOTED						

311.35