


1/4" = 1'-0"

D



C

B


A

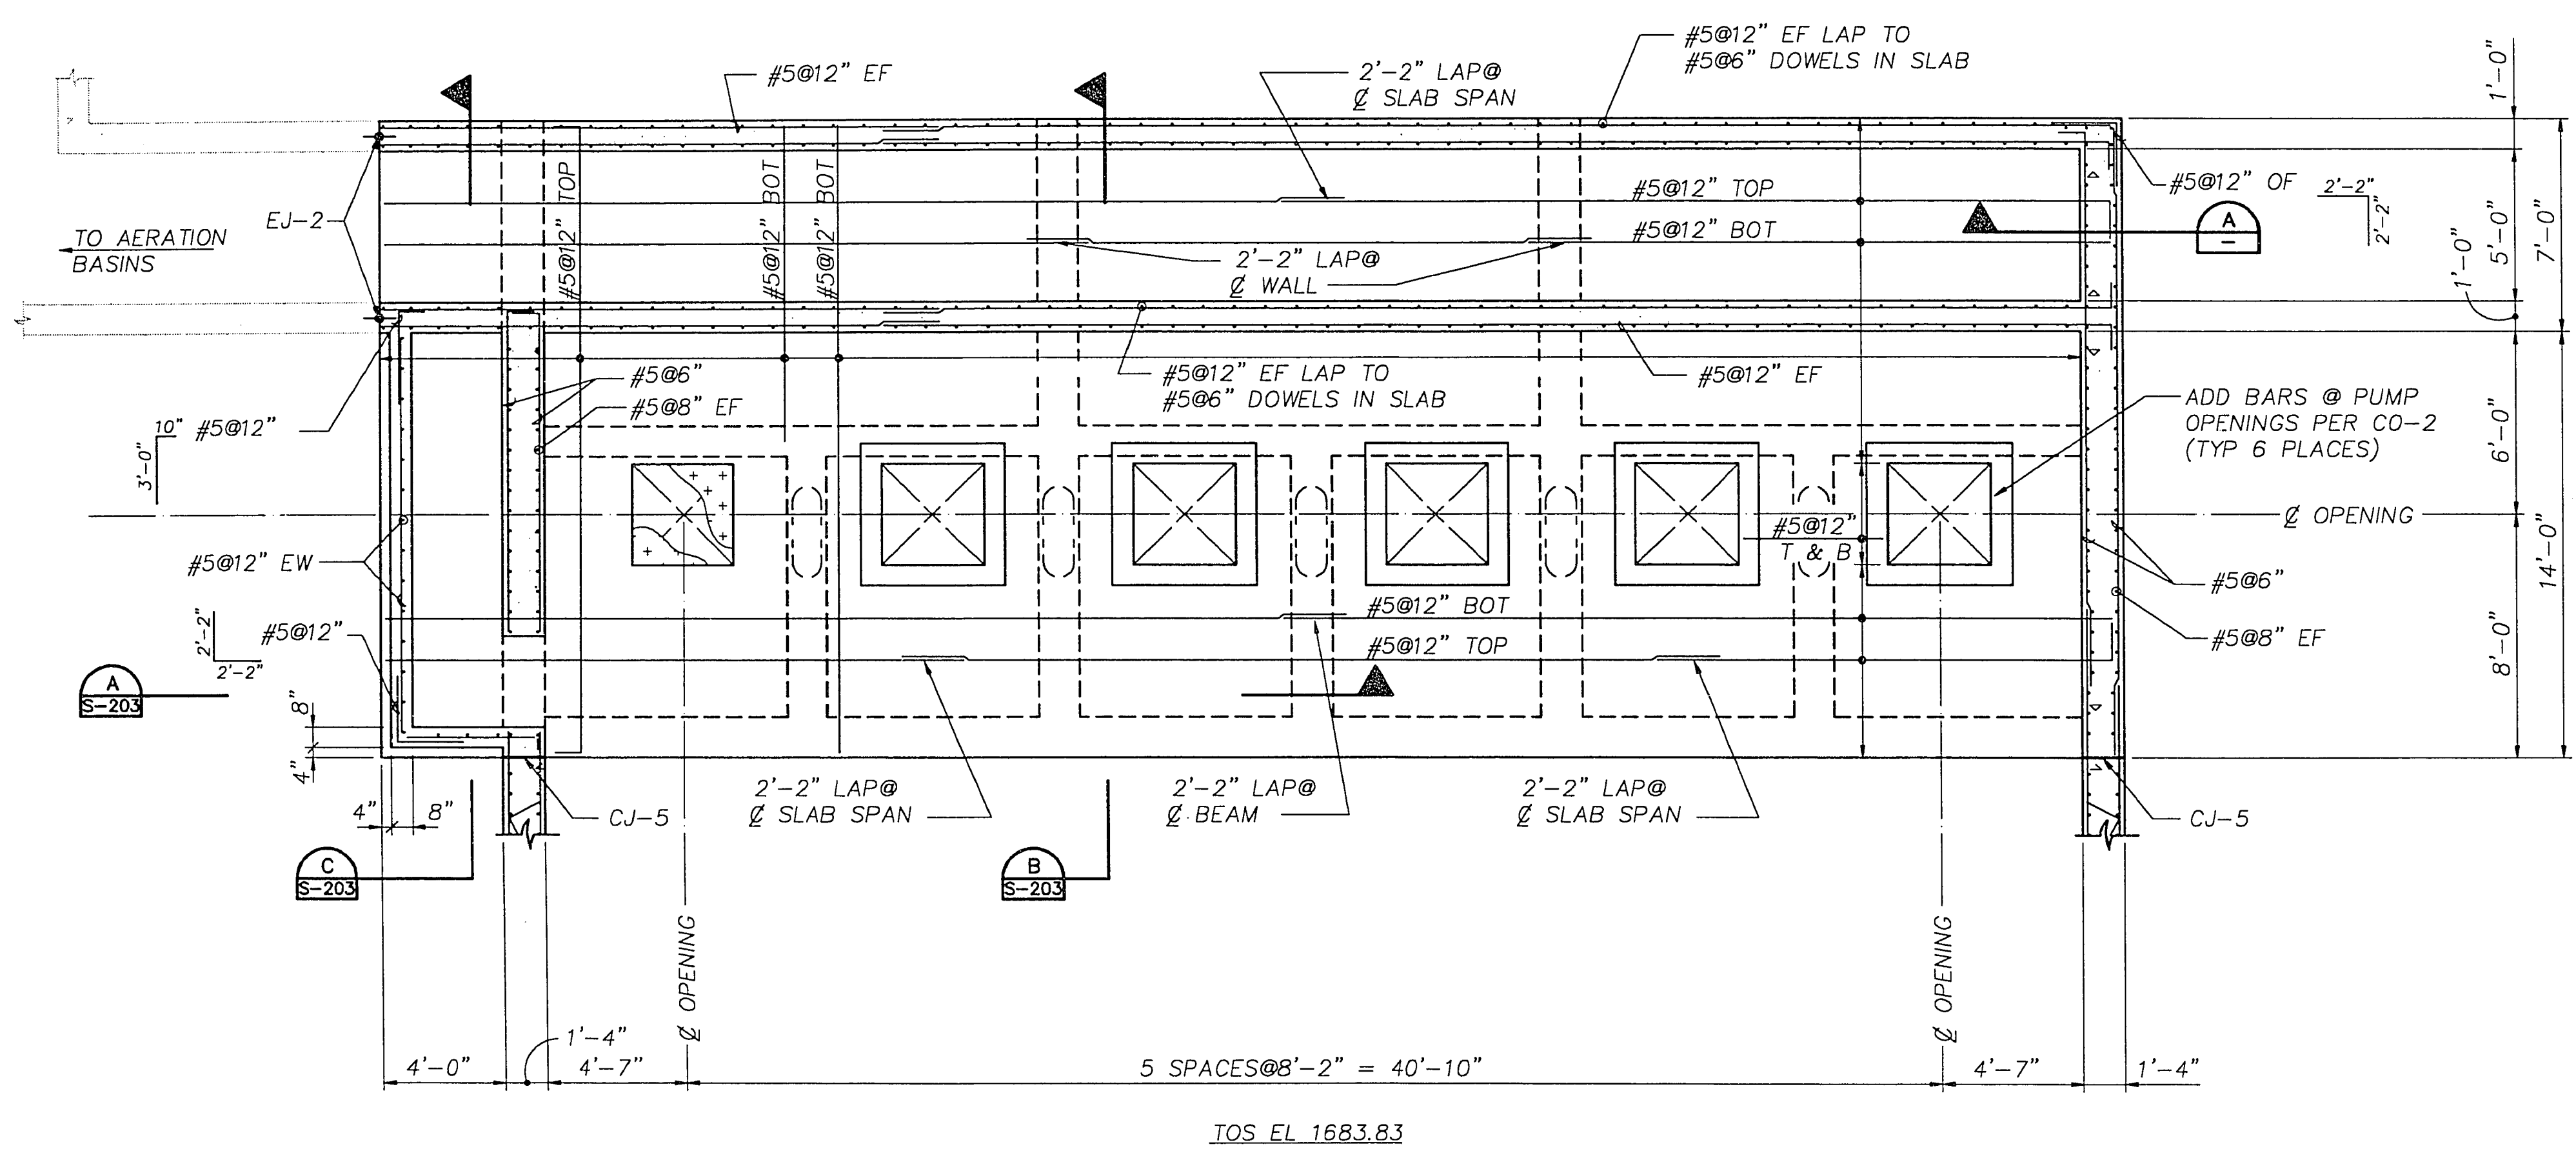


MEZZANINE PLAN @ EL 1687.0
1/4"=1'-0"

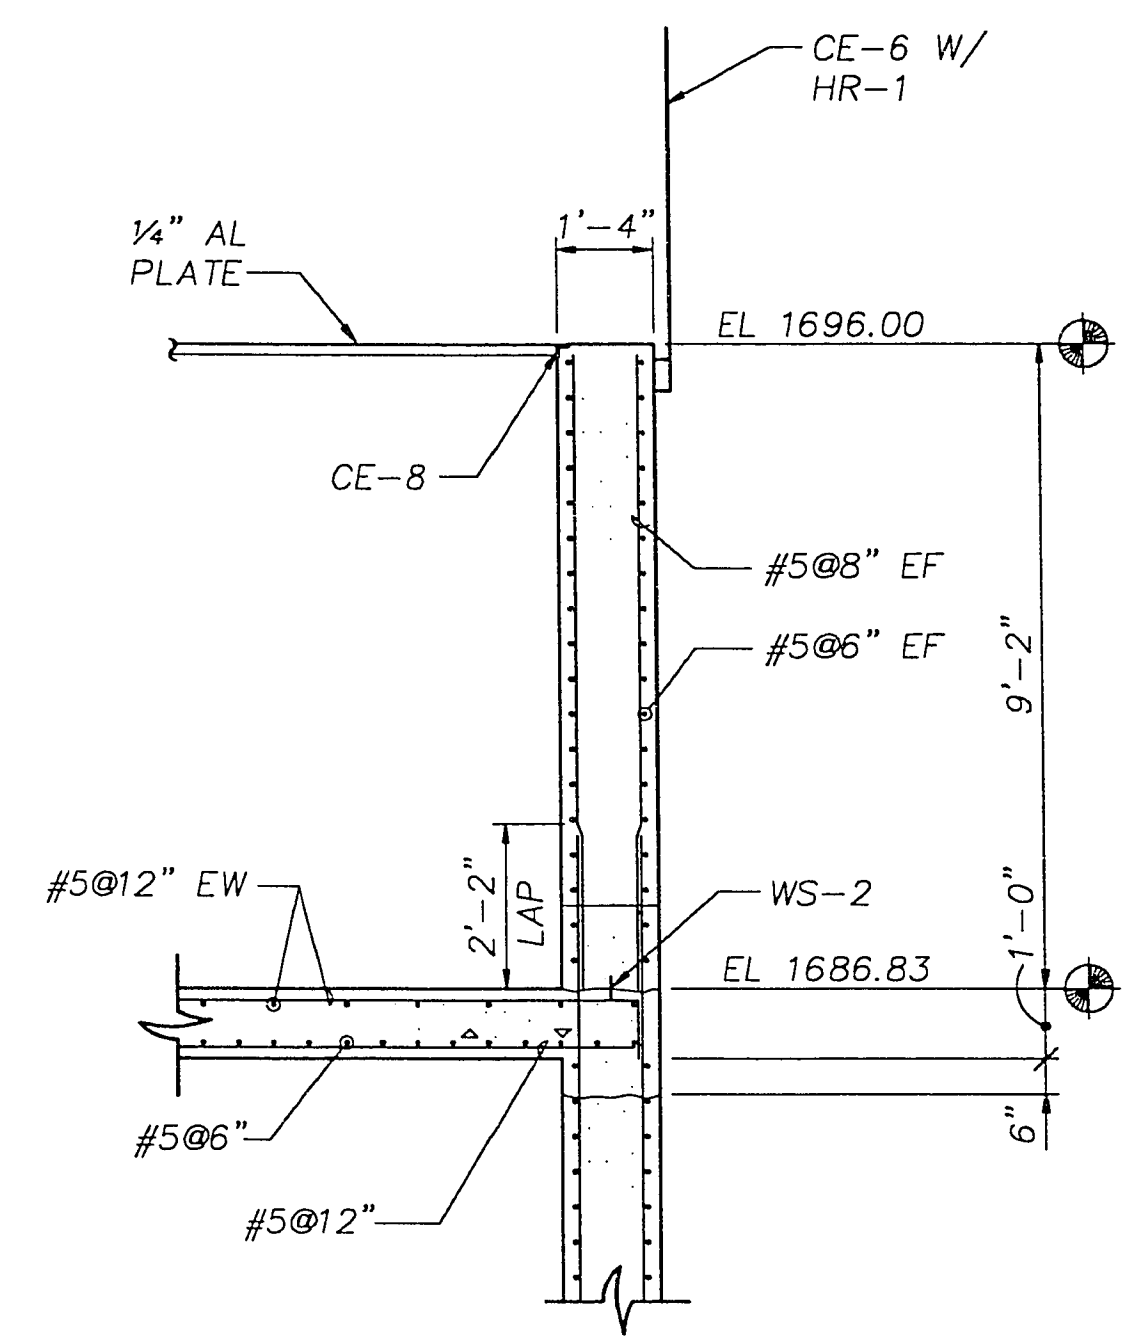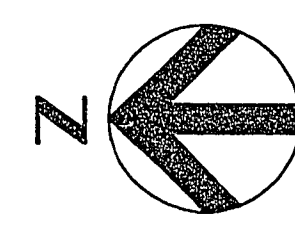


SECTION
3/8"=1'-0"

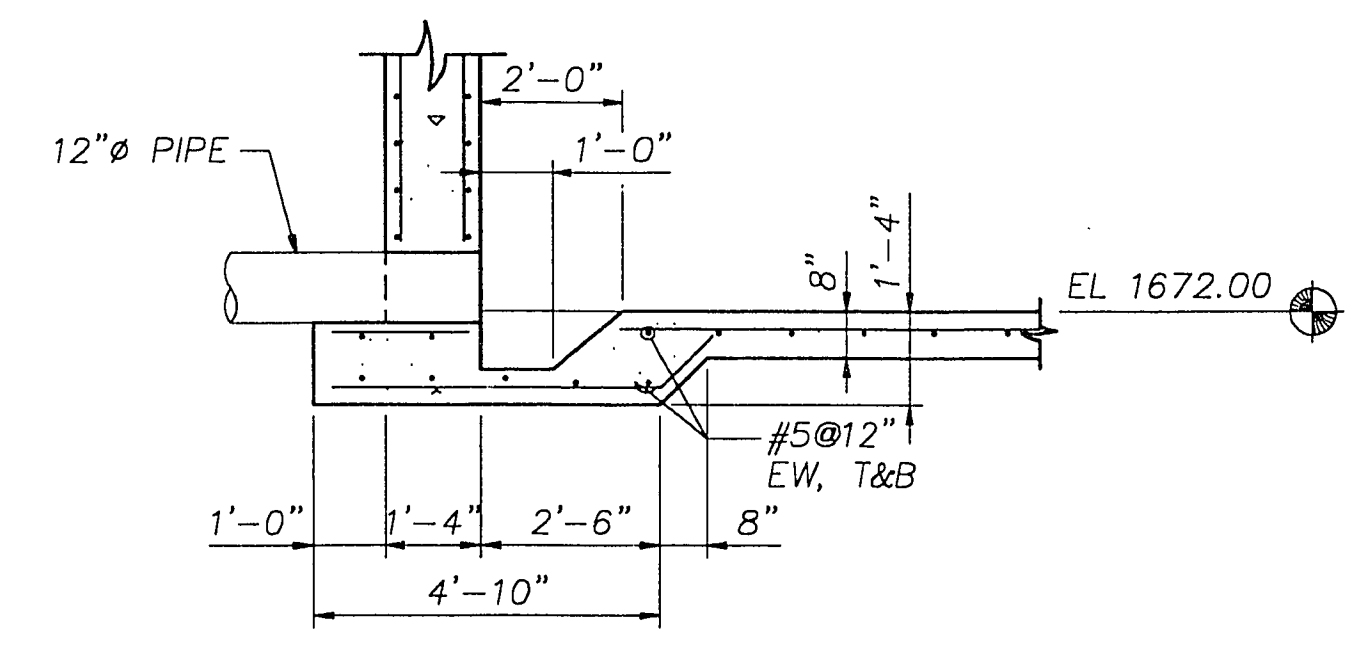

SECTION
3/8"=1'-0"

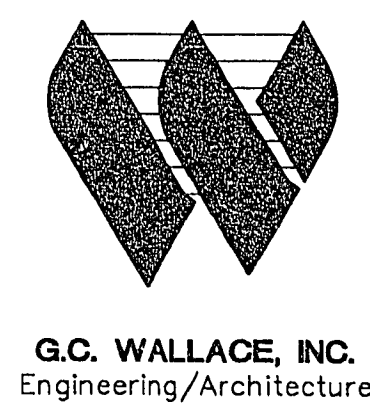

Issue No.	Description	Date	Drawn	Chk'd	Rep. Engr.	Proj. Mgr.
1	CORRECTED ACCORDING TO CONSTRUCTION RECORD	1/95	RRL	EFH	MJH	JJC
0	ISSUED FOR CONSTRUCTION	8/20/92	JH	CLS	CRD	JJC
A	ISSUED FOR BID	4/20/92	JH	CLS	CRD	JJC

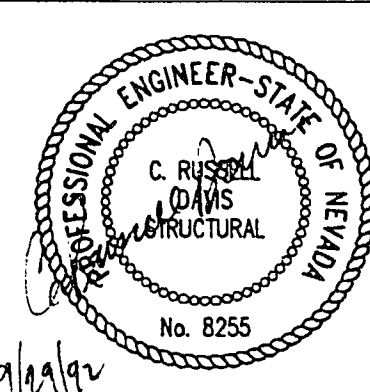

Project Manager	JOHN J. CHUEH
Architect	JAC/Process
Civil	Mechanical
Electrical	Structural
Drawn By	R. DAVIS
	J. HIRSHOUER

City of Las Vegas
Water Pollution Control Facility
Nitrification / Filtration Facilities
Contract 17
NITRIFICATION COMPLEX

NITRIFICATION INFLUENT PUMP STATION
MEZZANINE PLAN & SECTIONS

Date	APRIL 1992	Project No.	00120-084-141	Drawing No.	S-202	Issue	1
Scale	AS NOTED						