



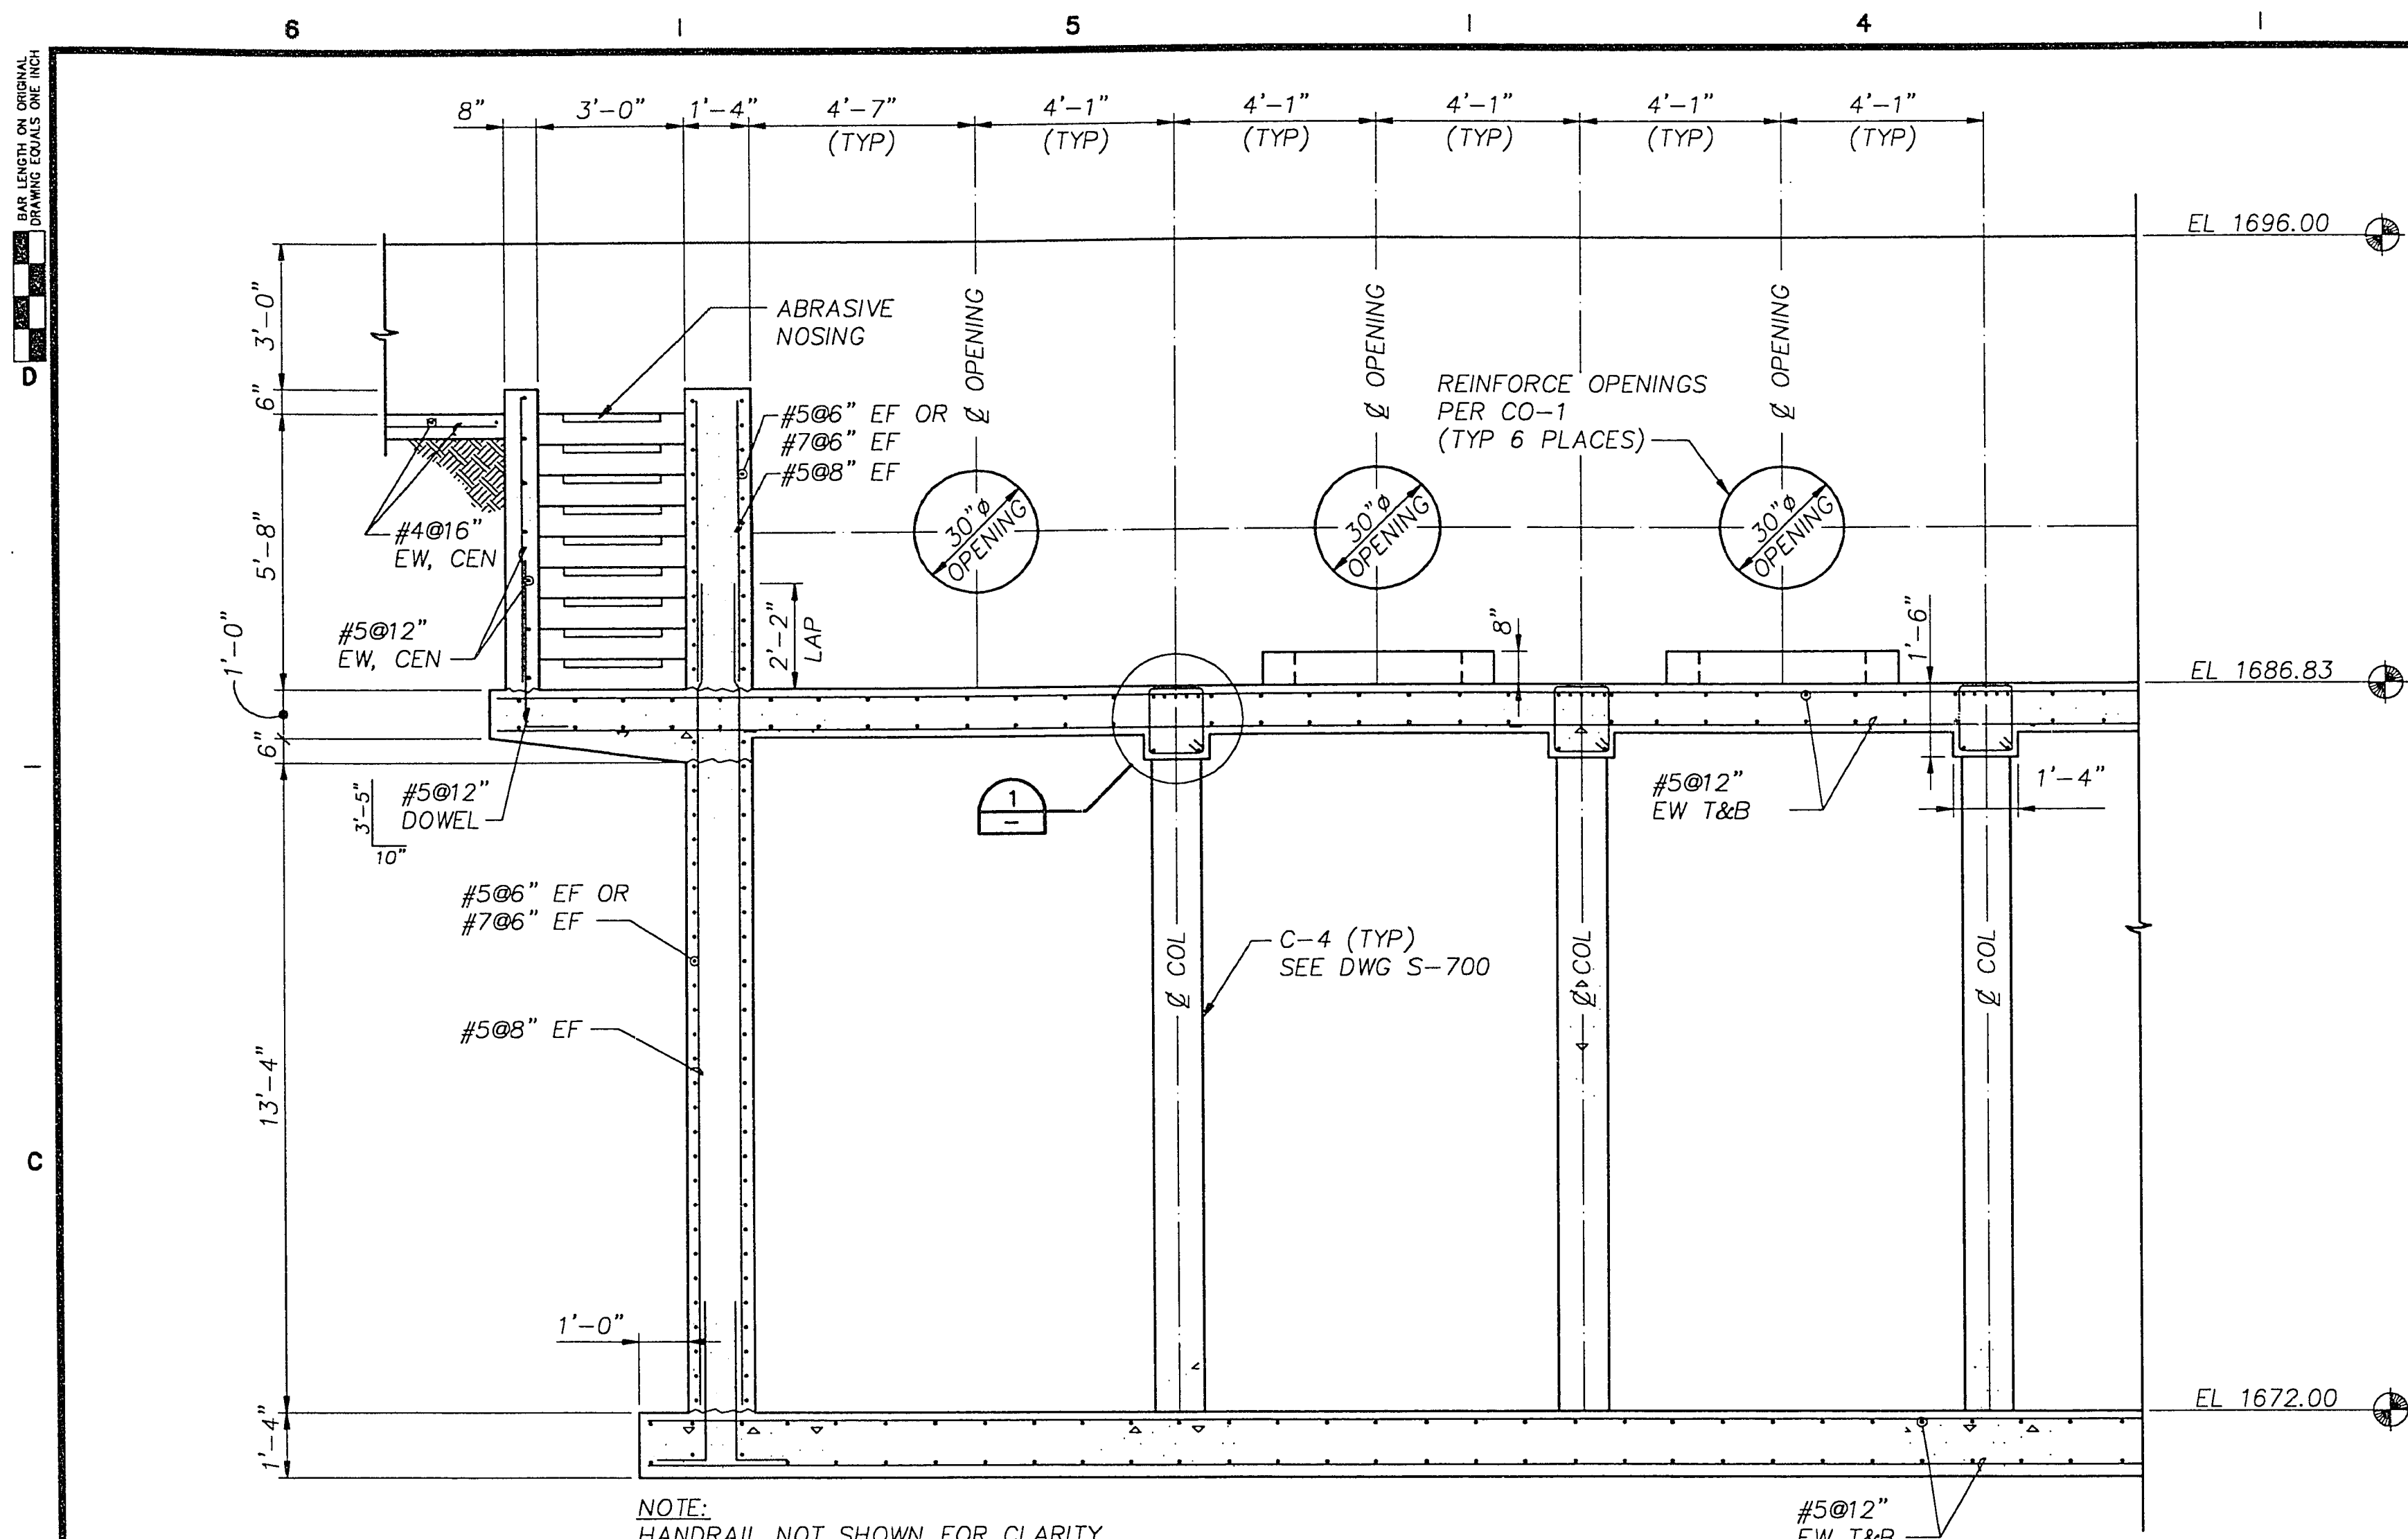


SECTION

3/8"=1'-0"

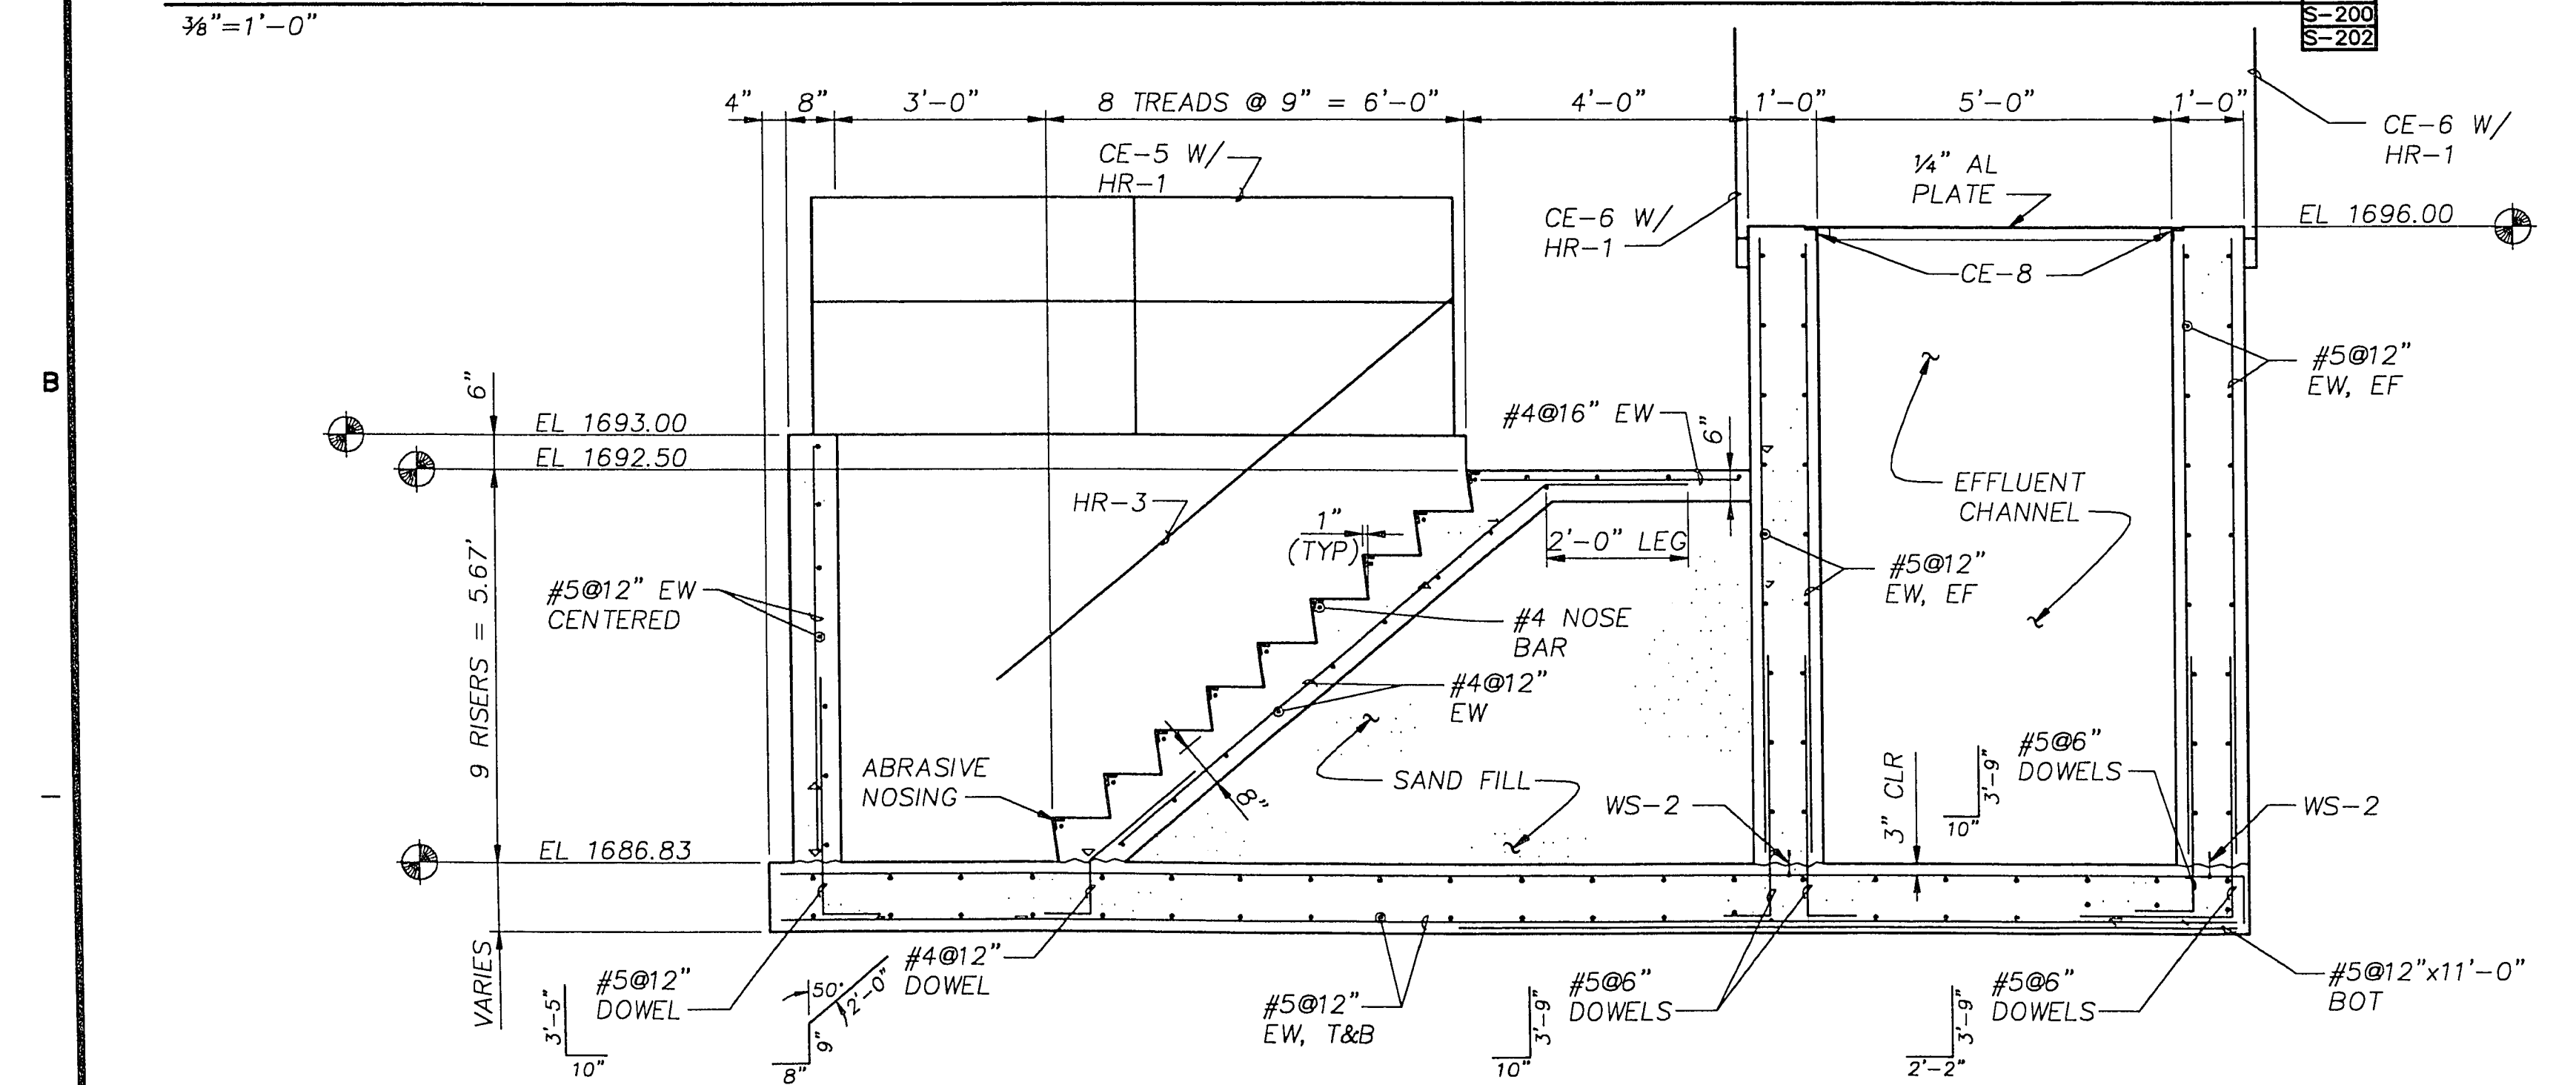


SECTION

1/2"=1'-0"

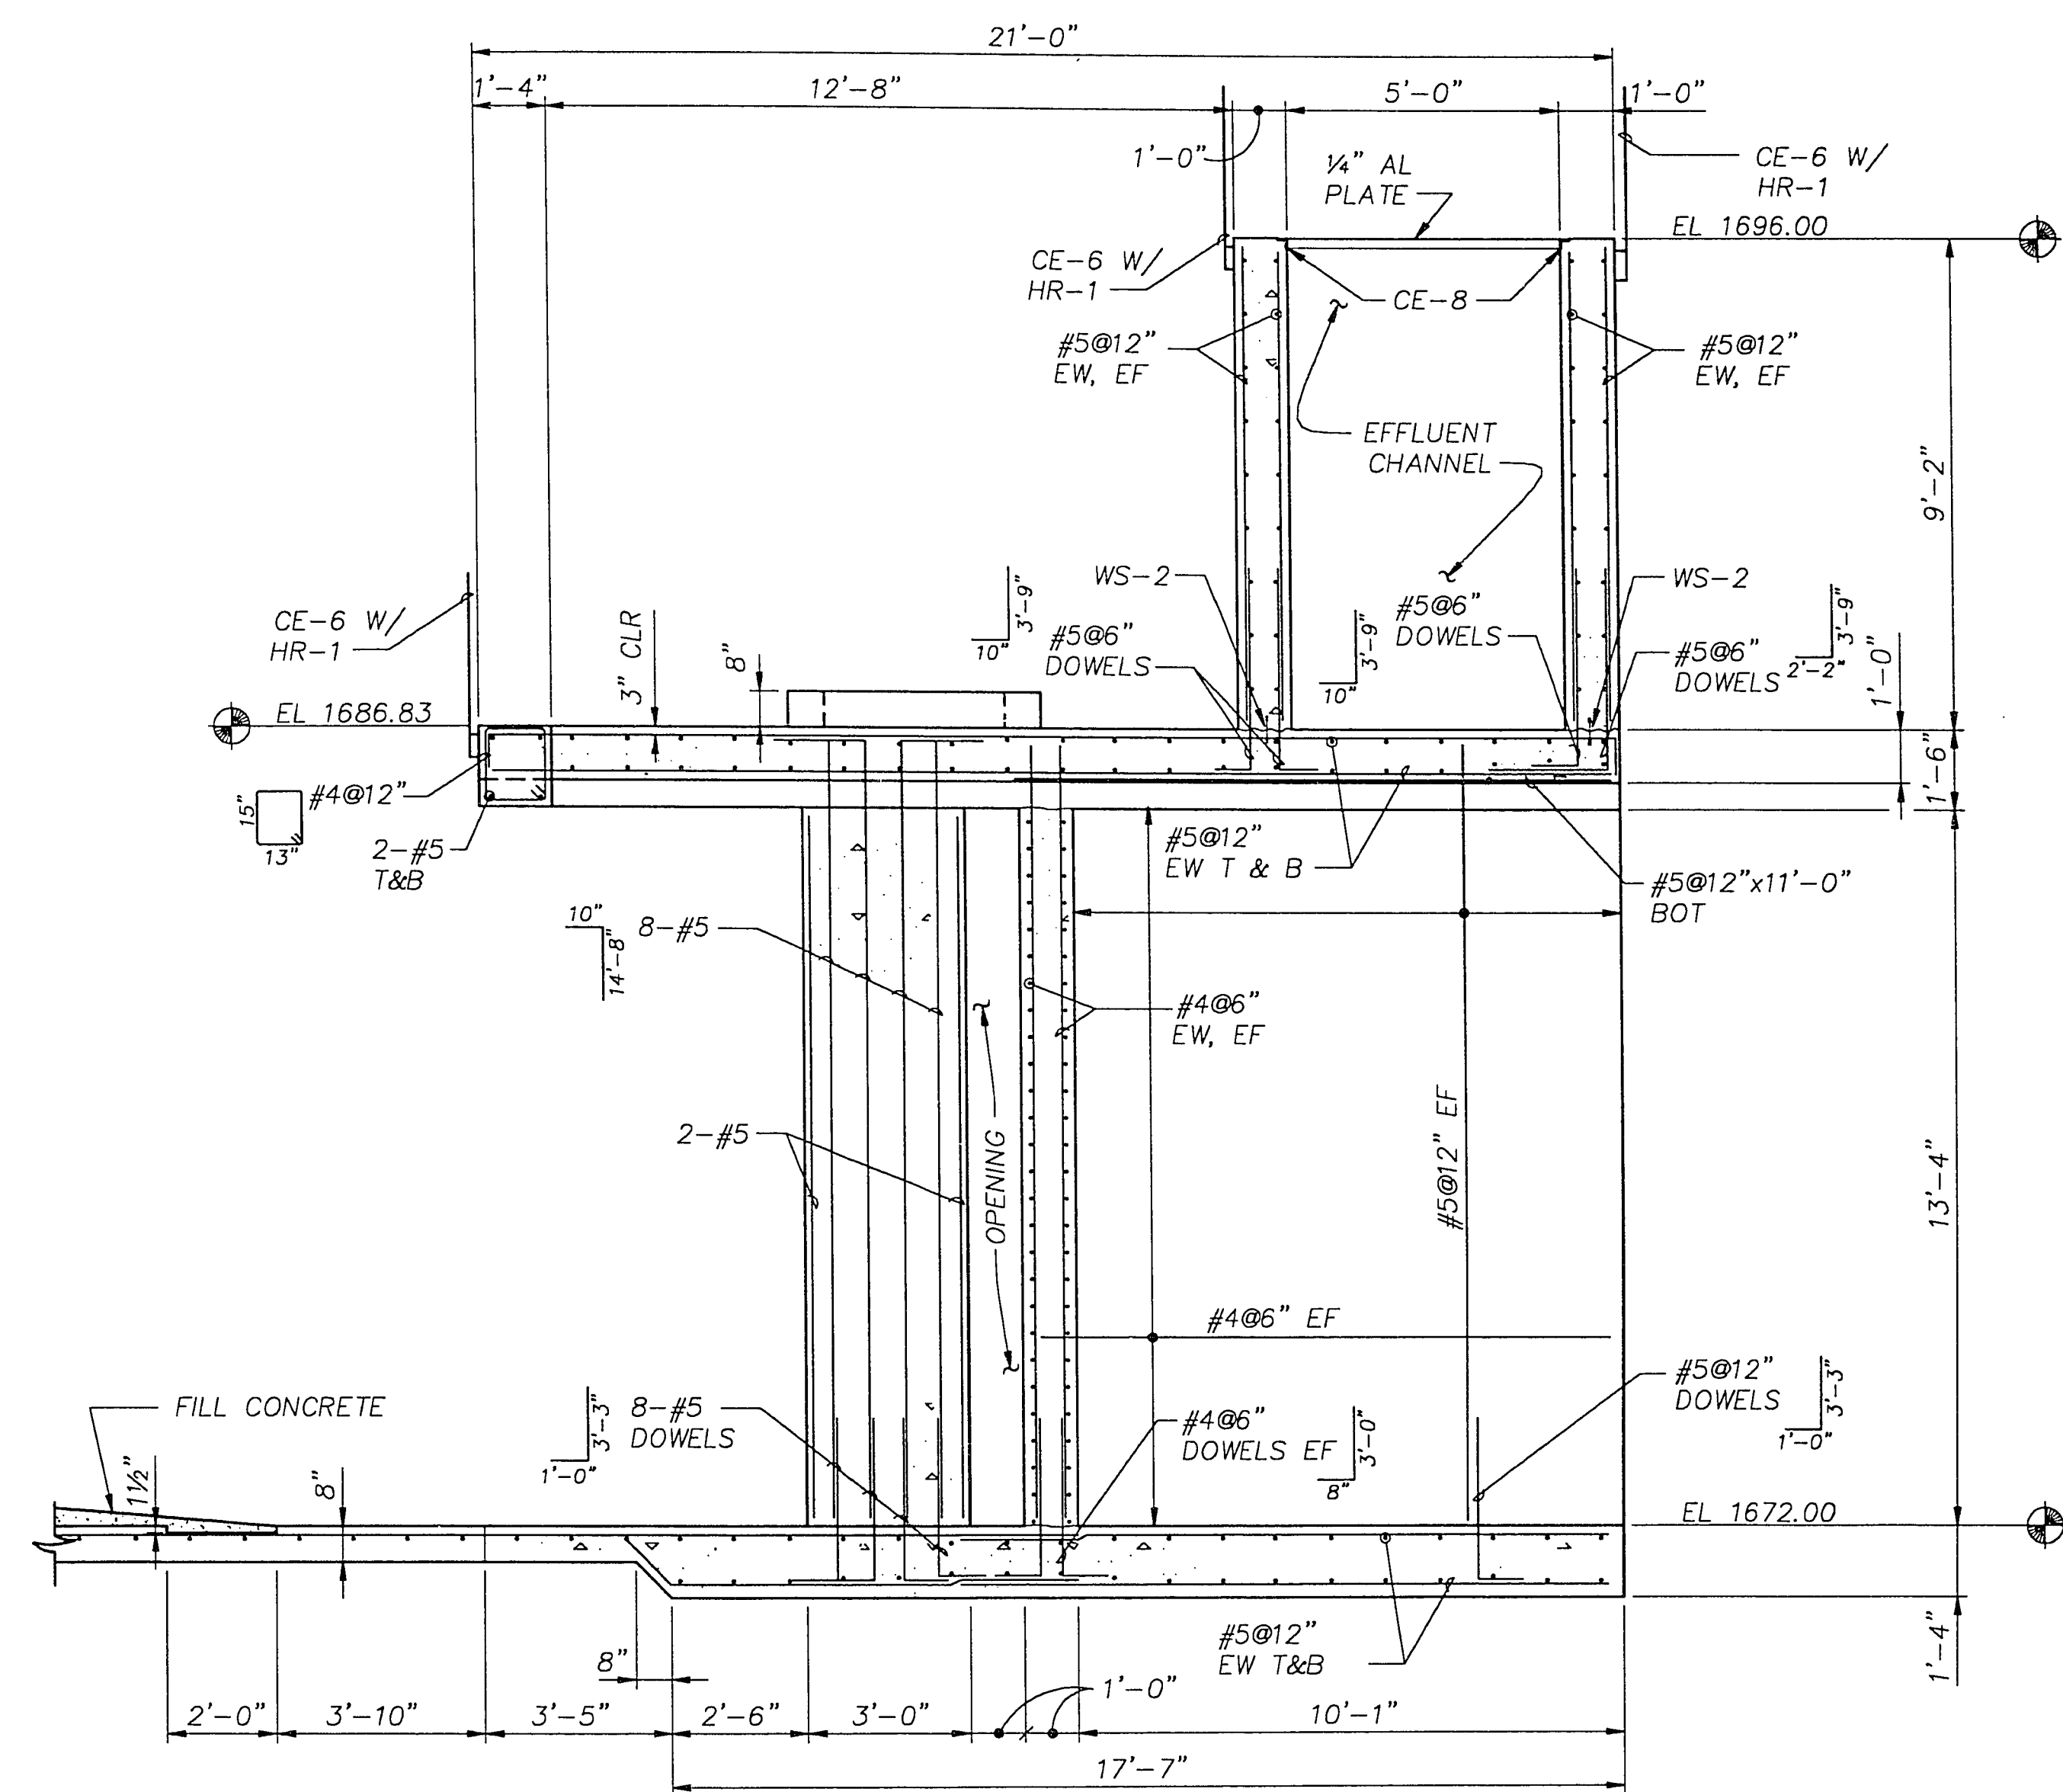



SECTION

3/8"=1'-0"

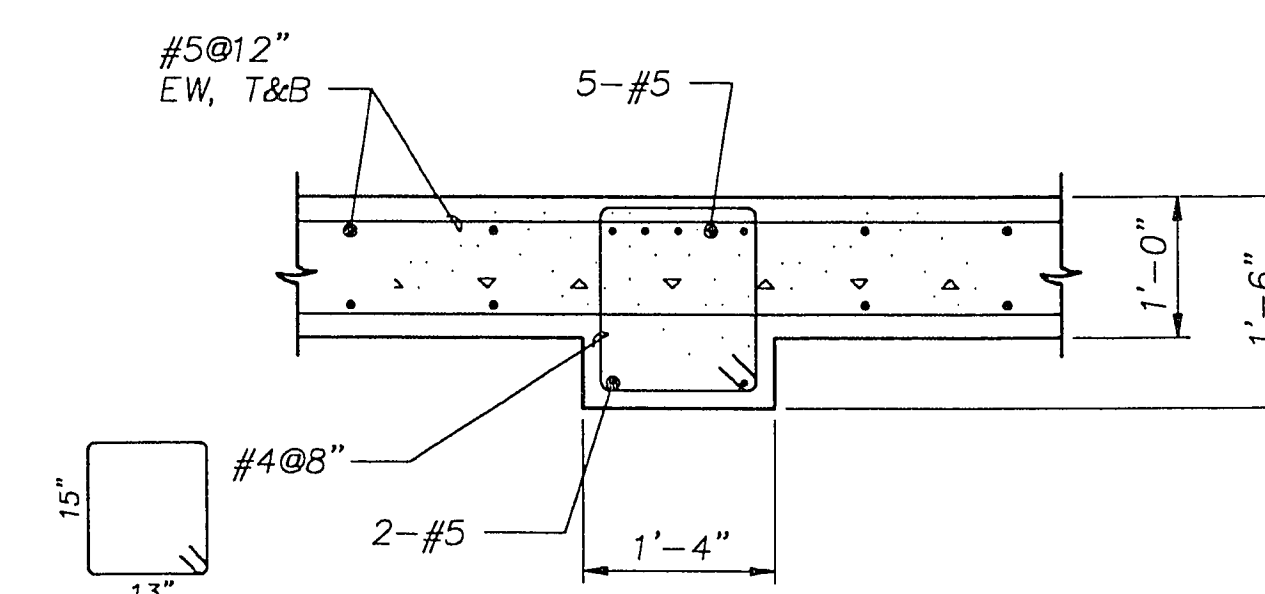


DETAIL

3/4"=1'-0"

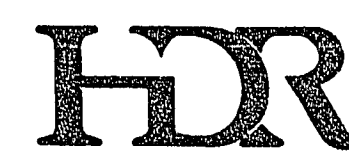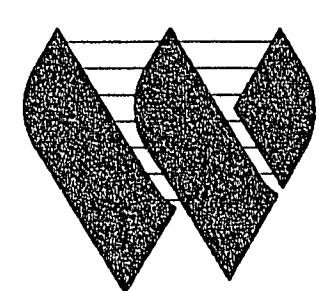

No.	Description	Date	Drawn	Checked	Reviewed	Approved
1	CORRECTED ACCORDING TO CONSTRUCTION RECORD	1/95	RRL	EFH	MJH	JJC
0	ISSUED FOR CONSTRUCTION	8/20/92	JH	CLS	CRD	JJC
A	ISSUED FOR BID	4/20/92	JH	CLS	CRD	JJC

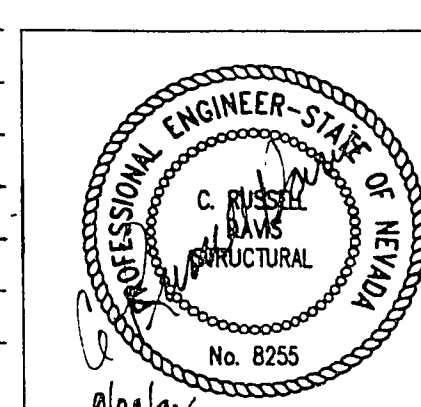

Project Manager	JOHN J. CHUEH
Architect	16C/Process
Civil	Mechanical
Electrical	Structural
Drawn By	R. DAVIS
Checked By	J. HIRSHOUER

City of Las Vegas
Water Pollution Control Facility
Nitrification / Filtration Facilities
Contract 17
NITRIFICATION COMPLEX

NITRIFICATION INFLUENT PUMP STATION			
SECTIONS AND DETAILS			
Date	APRIL 1992	Project No.	00120-084-141
Scale	AS NOTED	Drawing No.	S-203

1