



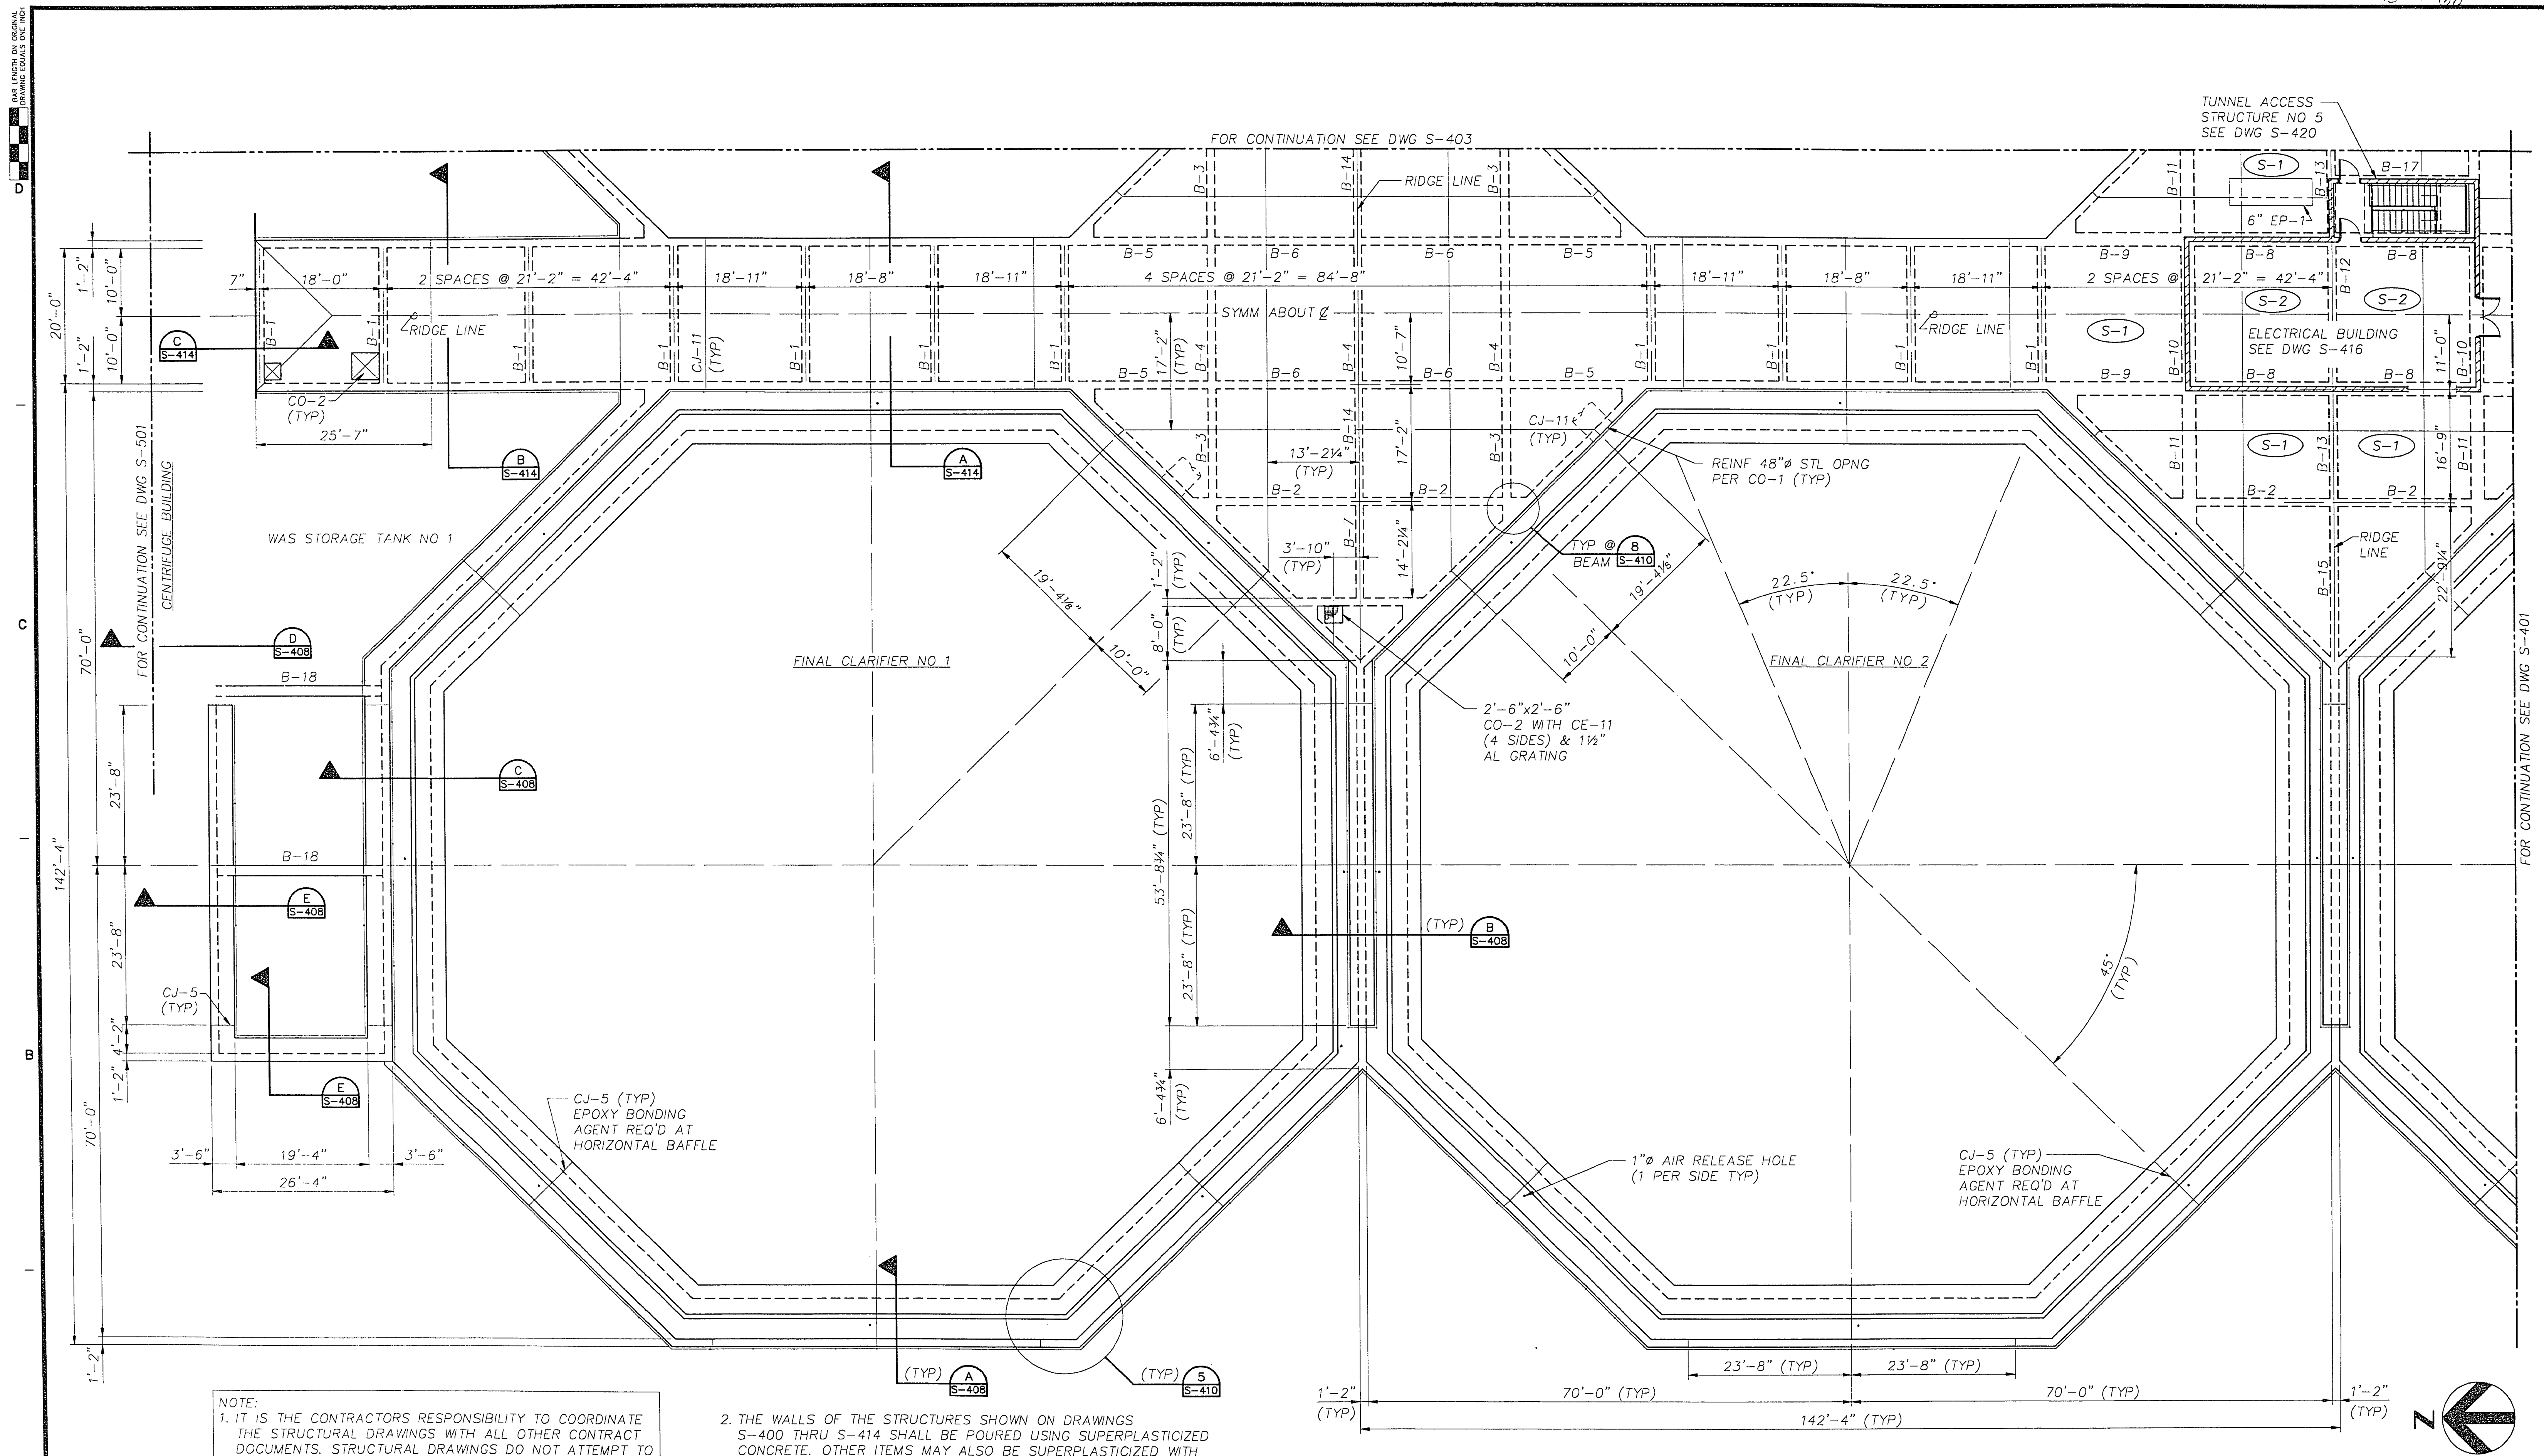


NOTE:
1. IT IS THE CONTRACTORS RESPONSIBILITY TO COORDINATE THE STRUCTURAL DRAWINGS WITH ALL OTHER CONTRACT DOCUMENTS. STRUCTURAL DRAWINGS DO NOT ATTEMPT TO SHOW ALL MECHANICAL AND ELECTRICAL PENETRATIONS AND ROUTING.

2. THE WALLS OF THE STRUCTURES SHOWN ON DRAWINGS S-400 THRU S-414 SHALL BE POURED USING SUPERPLASTICIZED CONCRETE. OTHER ITEMS MAY ALSO BE SUPERPLASTICIZED WITH APPROVAL OF THE ENGINEER.

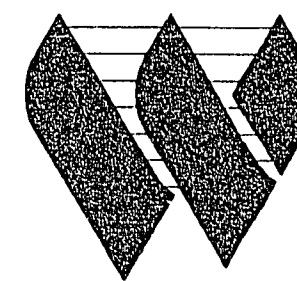

HDR Engineering, Inc.

1	CORRECTED ACCORDING TO CONSTRUCTION RECORD	1/95	RRL	EFH	MJH	JJC
O	ISSUED FOR CONSTRUCTION	8/20/92	JH	RCH	CRD	JJC
A	ISSUED FOR BID	4/20/92	JH	RCH	CRD	JJC
Issue No.	Description	Date	Dwn.	Chkd.	Resp. Engr.	Proj. Mgr.

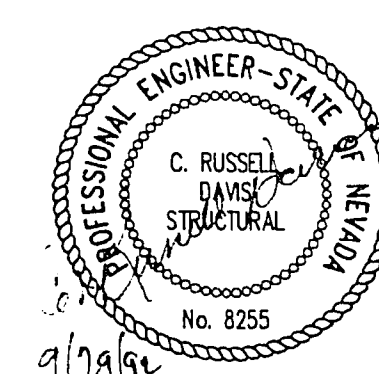

Project Manager	
JOHN J. CHUEH	
Architect	I&C/Process
Civil	Mechanical
Electrical	Structural
	R. DAVIS
	Drawn By
	J. HIRSHOUER

City of Las Vegas
Water Pollution Control Facility
Nitrification / Filtration Facilities
Contract 17
NITRIFICATION COMPLEX

FINAL CLARIFIERS

FINAL CLARIFIERS NO. 1 & 2
TOP PLAN

Date <i>APRIL 1992</i>	Project No. 00120-084-141	Drawing No. S-400	Issue 1
Scale <i>3/32" = 1'-0"</i>			