



BAR LENGTH ON ORIGINAL DRAWING EQUALS ONE INCH

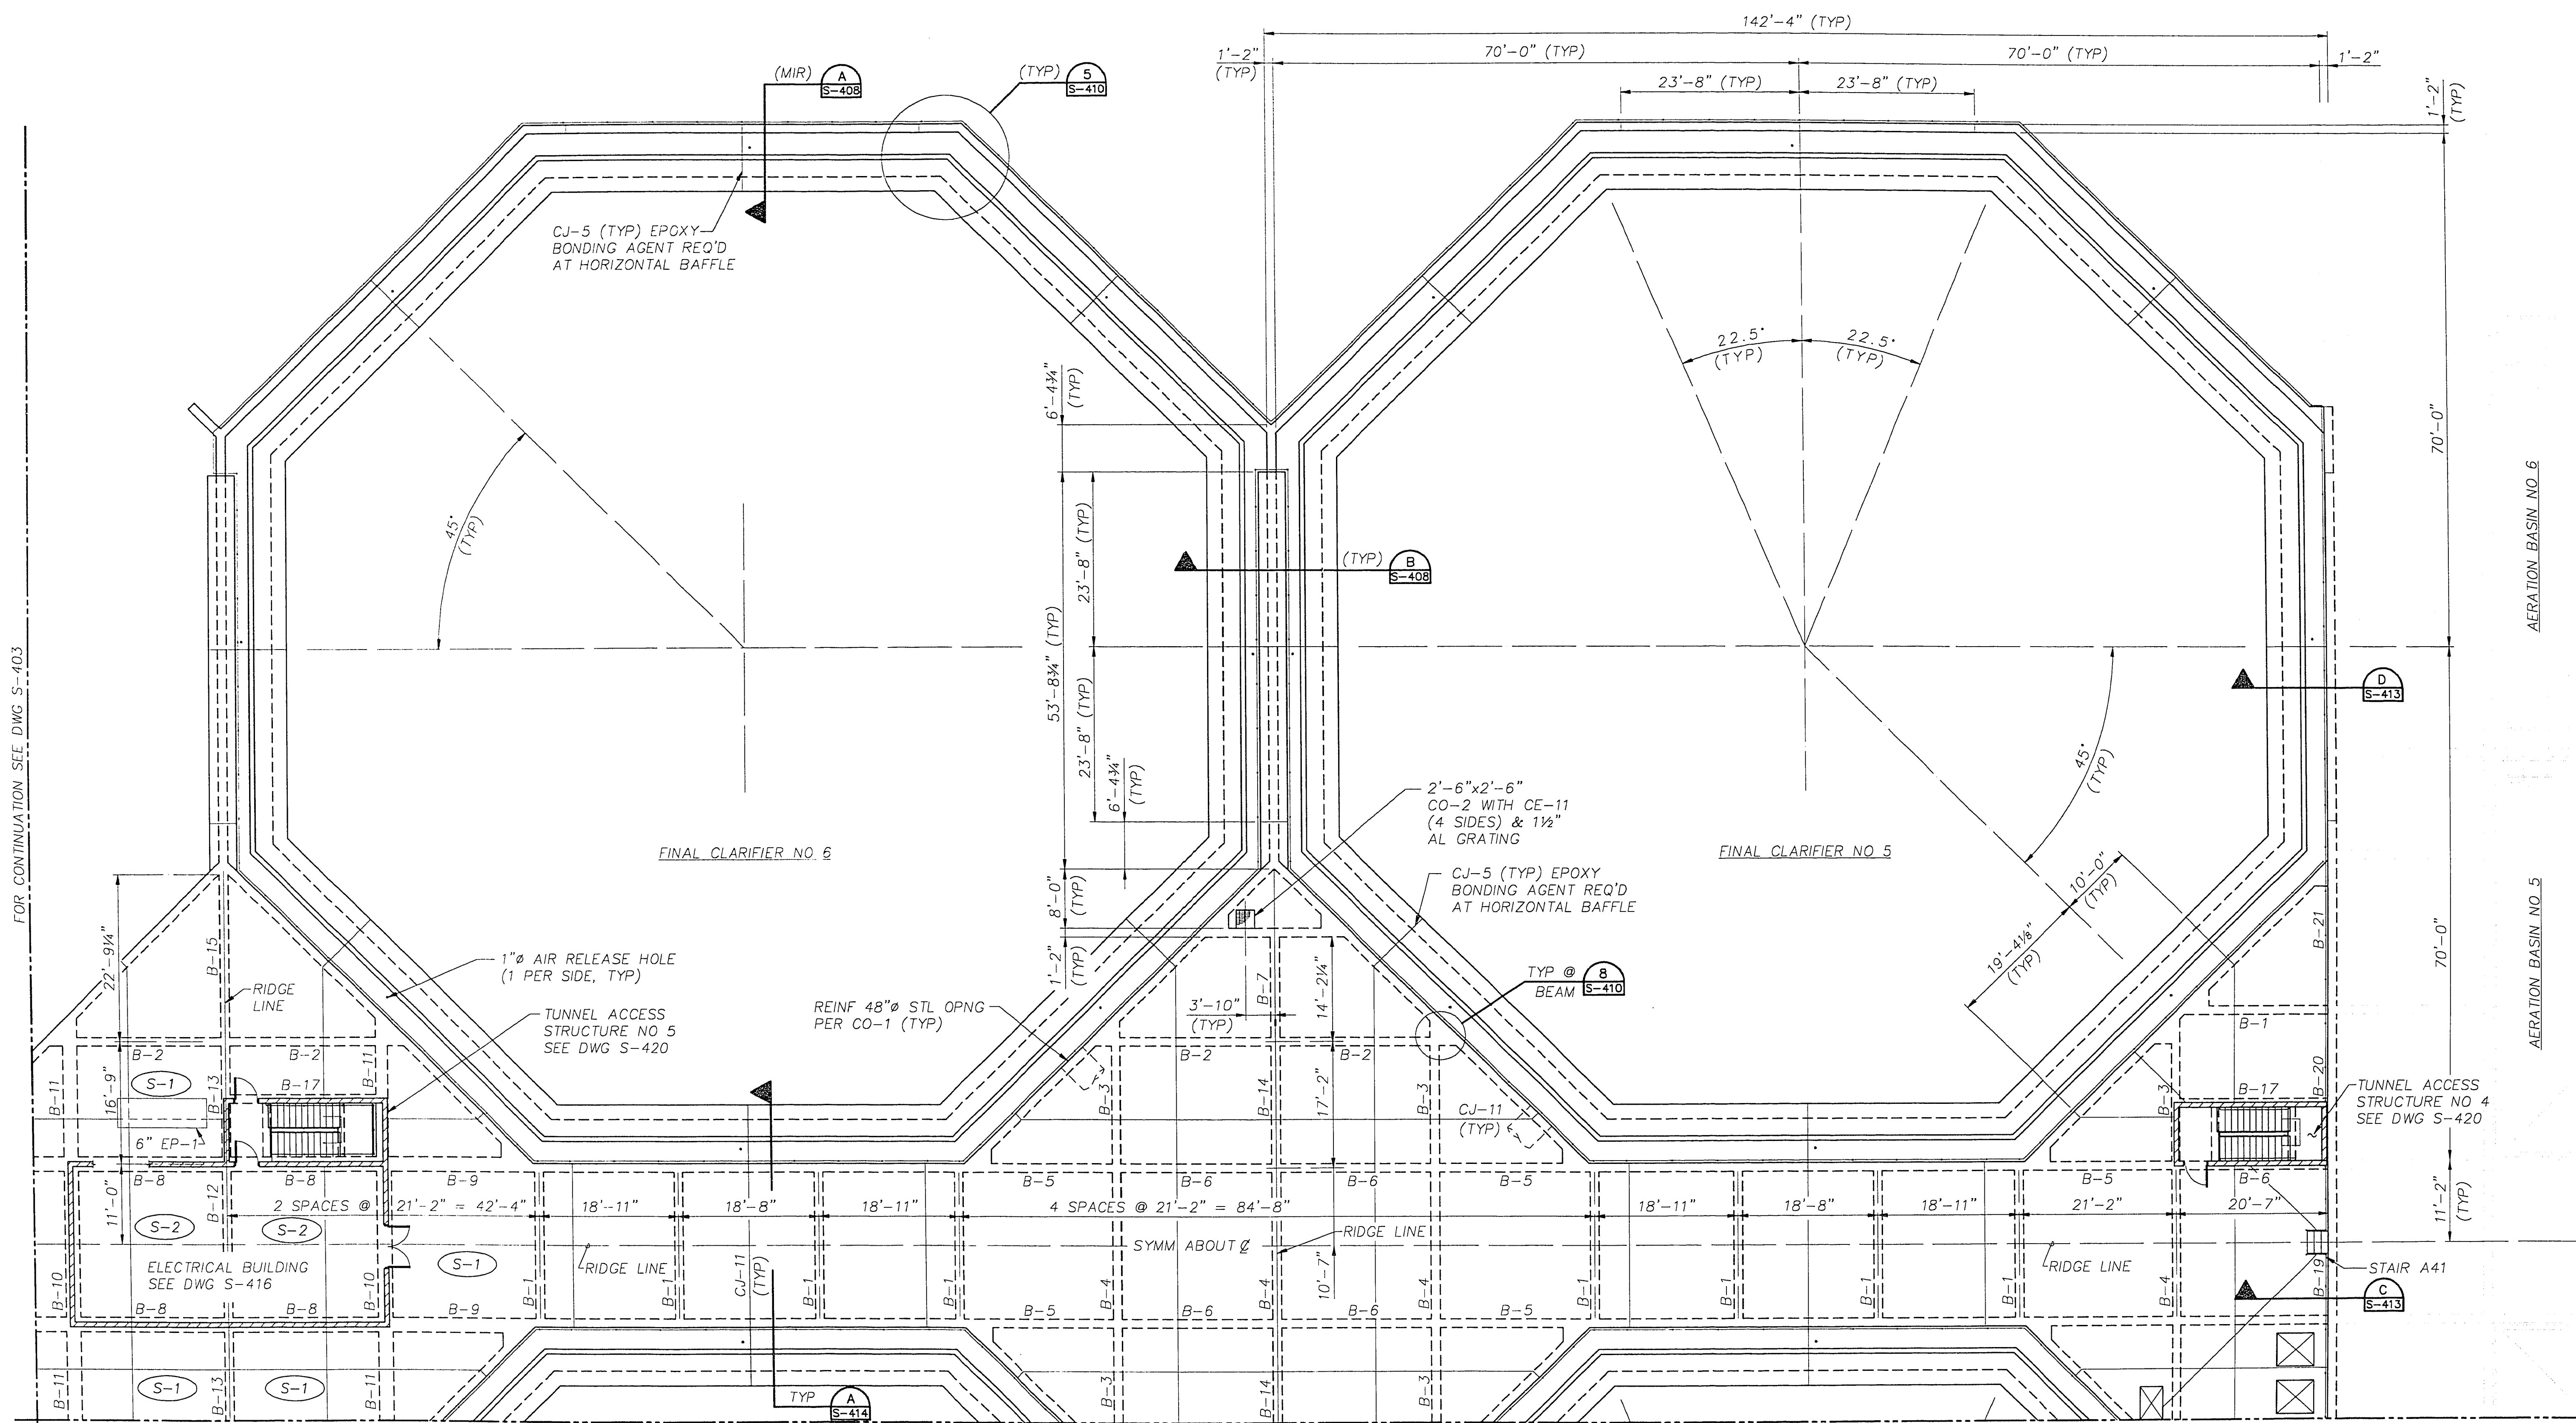


FOR CONTINUATION SEE DWG S-403

FOR CONTINUATION SEE DWG S-302

FOR CONTINUATION SEE DWG S-401

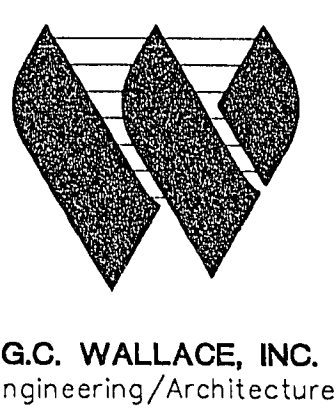

1	CORRECTED ACCORDING TO CONSTRUCTION RECORD	1/95	RRL	EFH	MJH	JJC
0	ISSUED FOR CONSTRUCTION	8/20/92	JH	RCH	CRD	JJC
A	ISSUED FOR BID	4/20/92	JH	RCH	CRD	JJC
Issue No.	Description	Date	Drawn	Chk.	Rev. Engr.	Proj. Mgr.

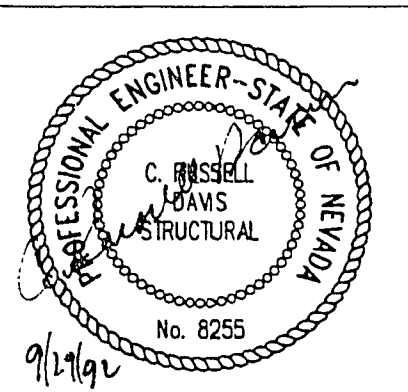

Project Manager	JOHN J. CHUEH
Architect	IAC/Process
Civil	Mechanical
Electrical	Structural
	R. DAVIS
	Drawn By
	J. HIRSHOUER

Water Pollution Control Facility
   
 Nitrification / Filtration Facilities
   
 Contract 17
   
 NITRIFICATION COMPLEX

FINAL CLARIFIERS			
FINAL CLARIFIERS NO. 5 & 6			
TOP PLAN			
Date	APRIL 1992	Project No.	00120-084-141
Scale	3/32" = 1'-0"	Drawing No.	S-402
		Issue	1

