


1	CORRECTED ACCORDING TO CONSTRUCTION RECORD	1/95	RRL	EFH	MJH	JJC
0	ISSUED FOR CONSTRUCTION	8/20/92	JH	RCH	CRD	JJC
A	ISSUED FOR BID	4/20/92	JH	RCH	CRD	JJC
Issue No.	Description	Date	Drawn	Checked	Engineer	Project Mgr.

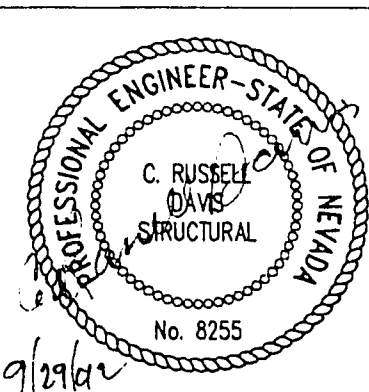

Project Manager	JOHN J. CHUEH
Architect	
Civil	
Electrical	
Mechanical	
Structural	R. DAVIS
Drawn By	J. HIRSHOUER

City of Las Vegas  
 Water Pollution Control Facility  
 Nitrification / Filtration Facilities  
 Contract 17  
 NITRIFICATION COMPLEX

**FINAL CLARIFIERS**  
**FINAL CLARIFIERS NO. 1 & 2**  
**FOUNDATION PLAN**

Date	APRIL 1992	Project No.	00120-084-141	Drawing No.	S-404	Issue	1
Scale	3/32" = 1'-0"						