


MASONRY ELEVATION

1/4"=1'-0"


A
S-416

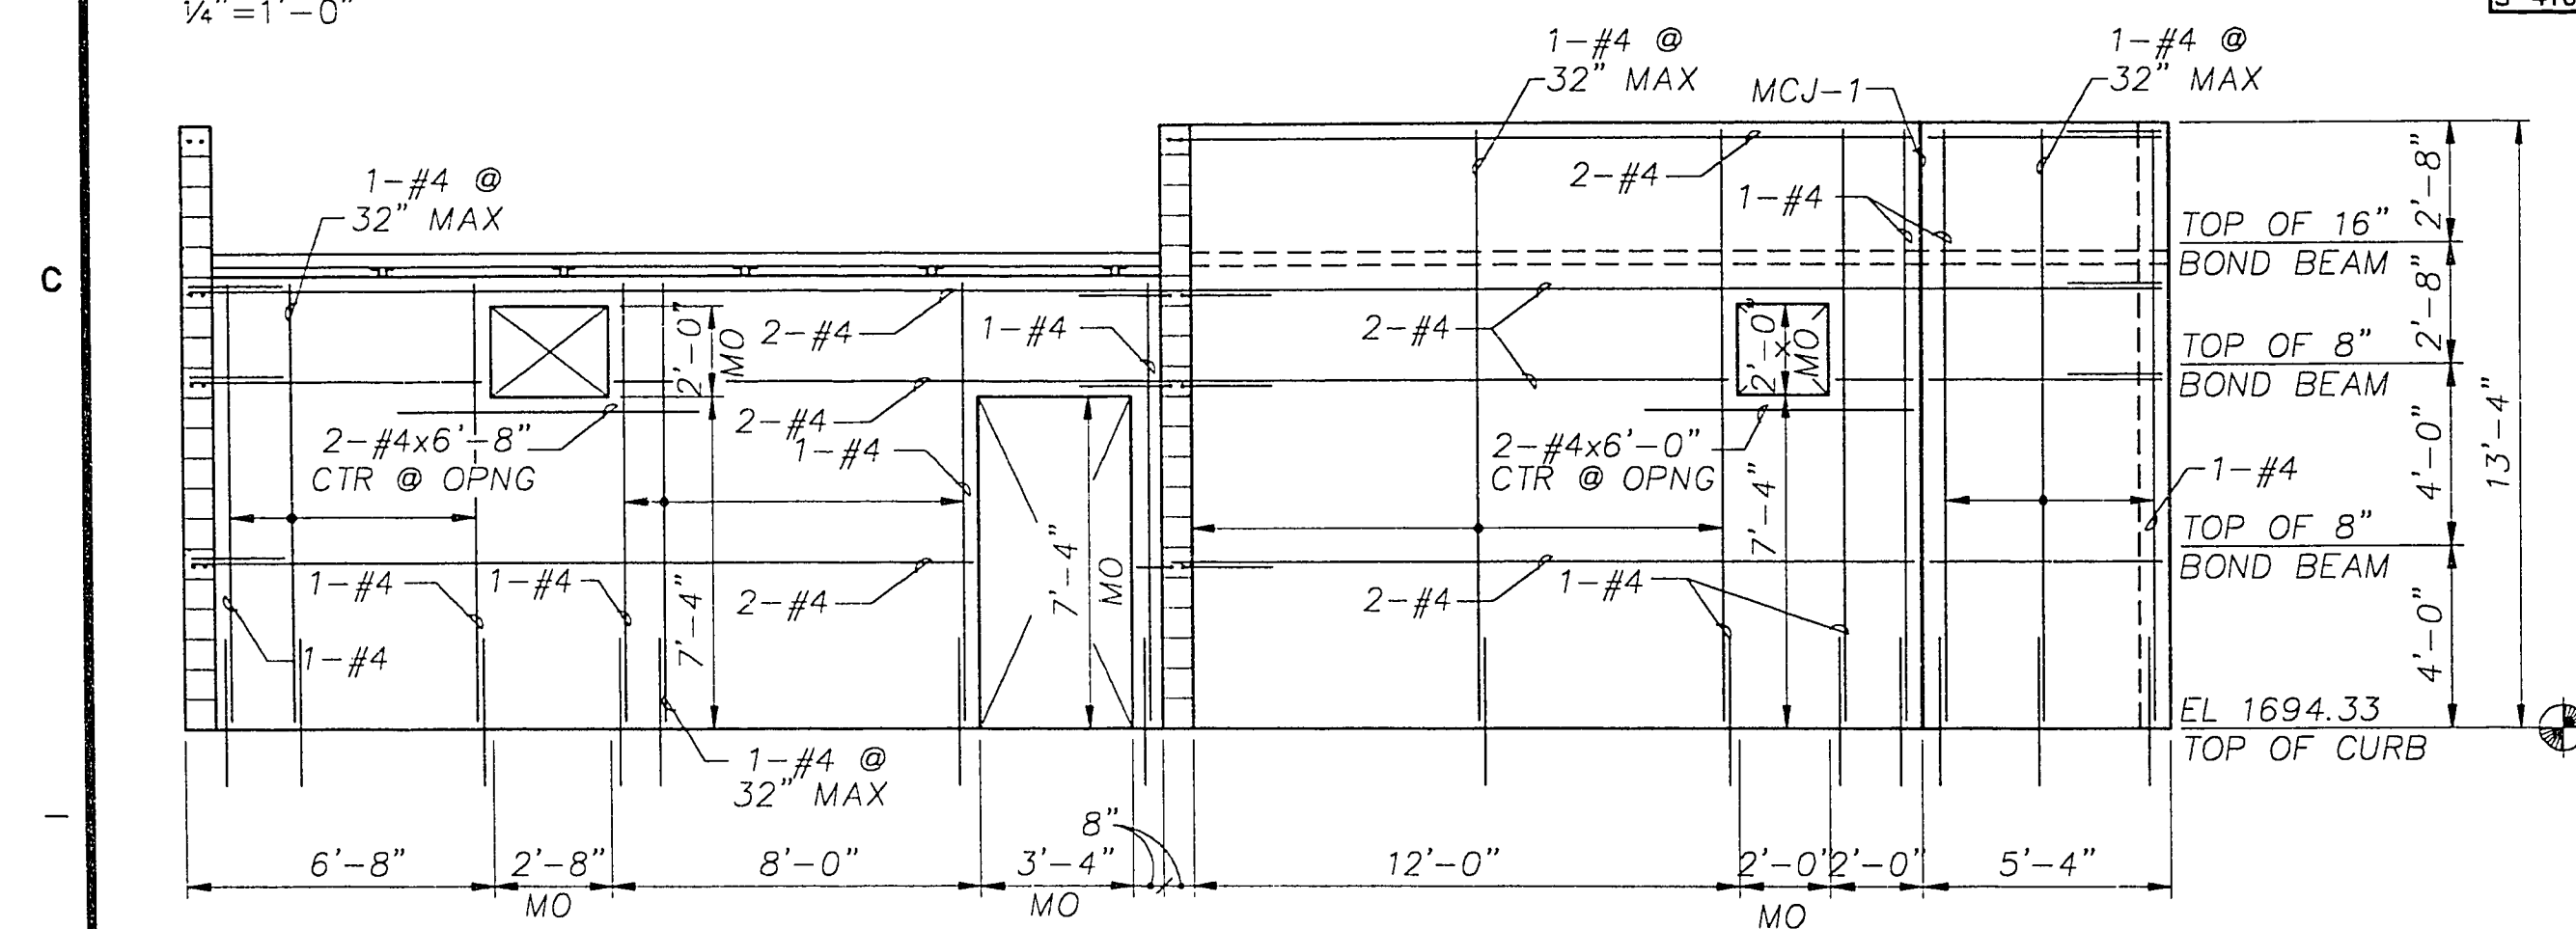

MASONRY ELEVATION

1/4"=1'-0"

D
S-416

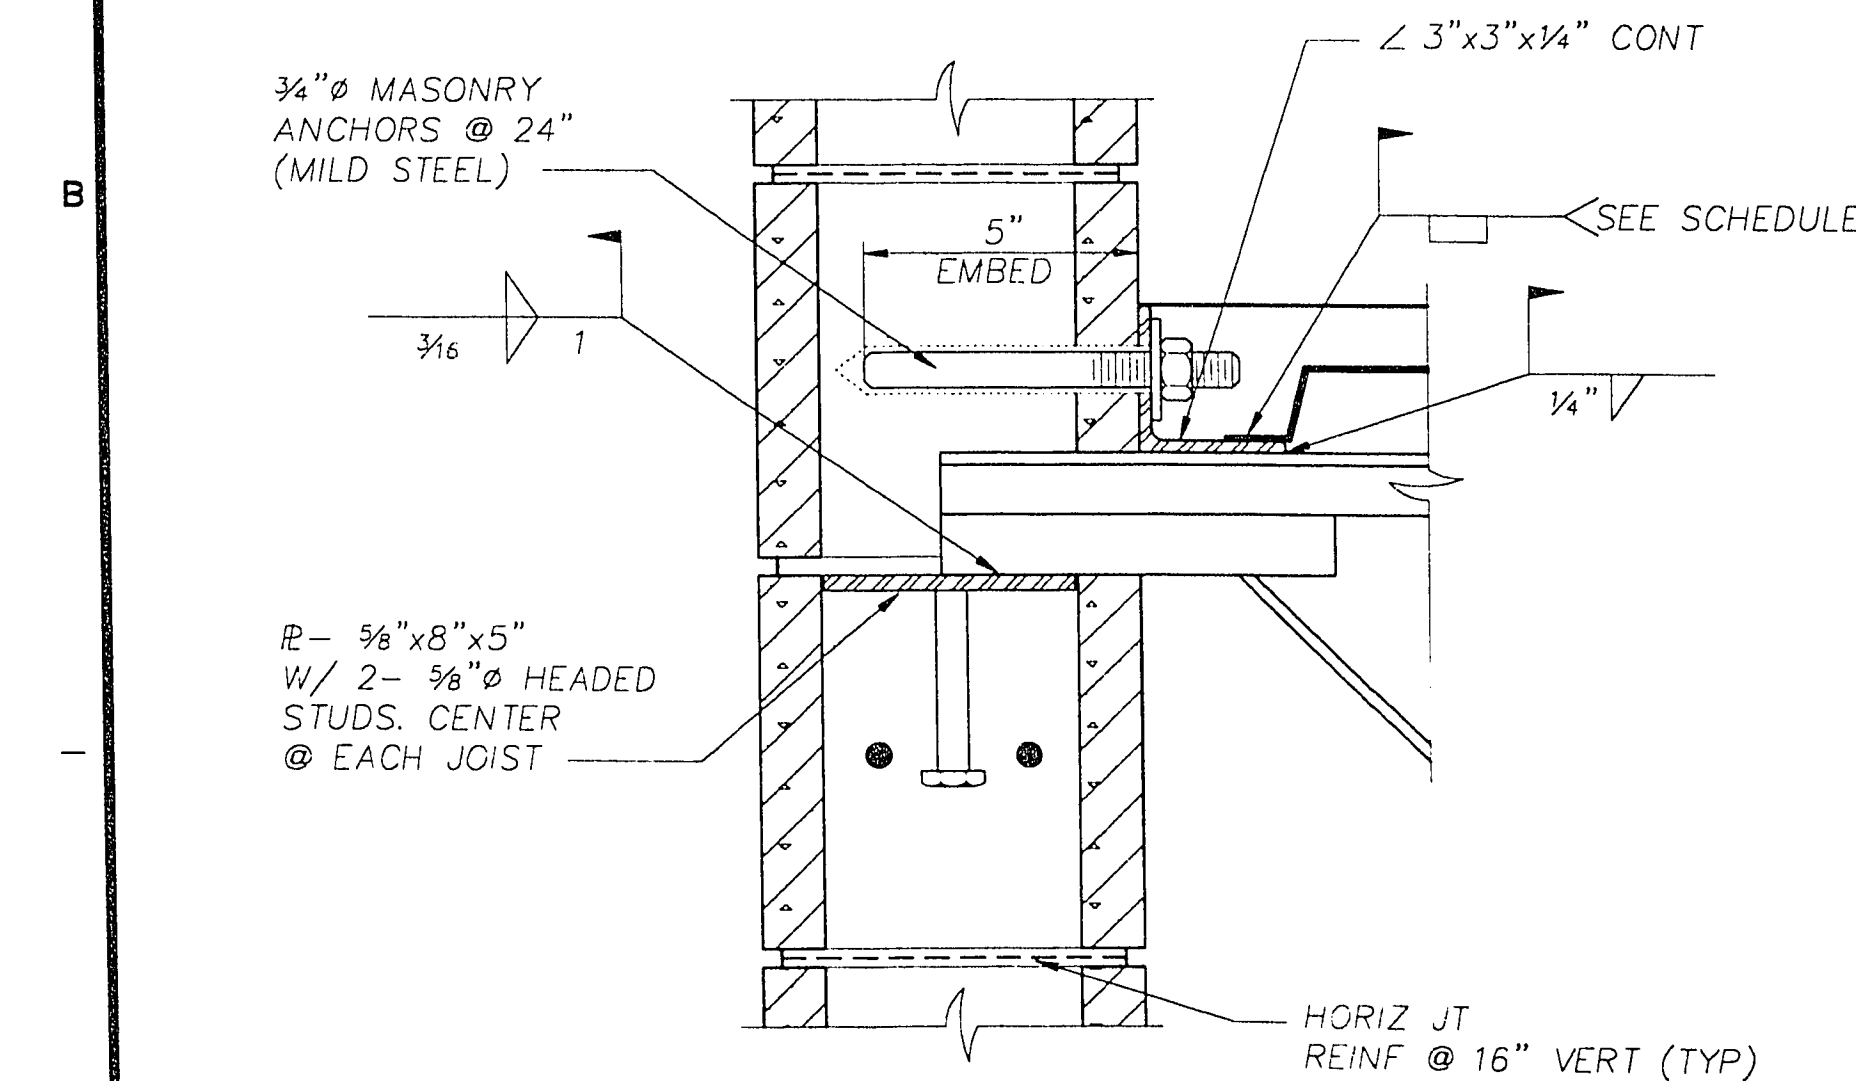

DETAIL


3"=1'-0"

1
S-417

MASONRY ELEVATION

1/4"=1'-0"


B
S-416

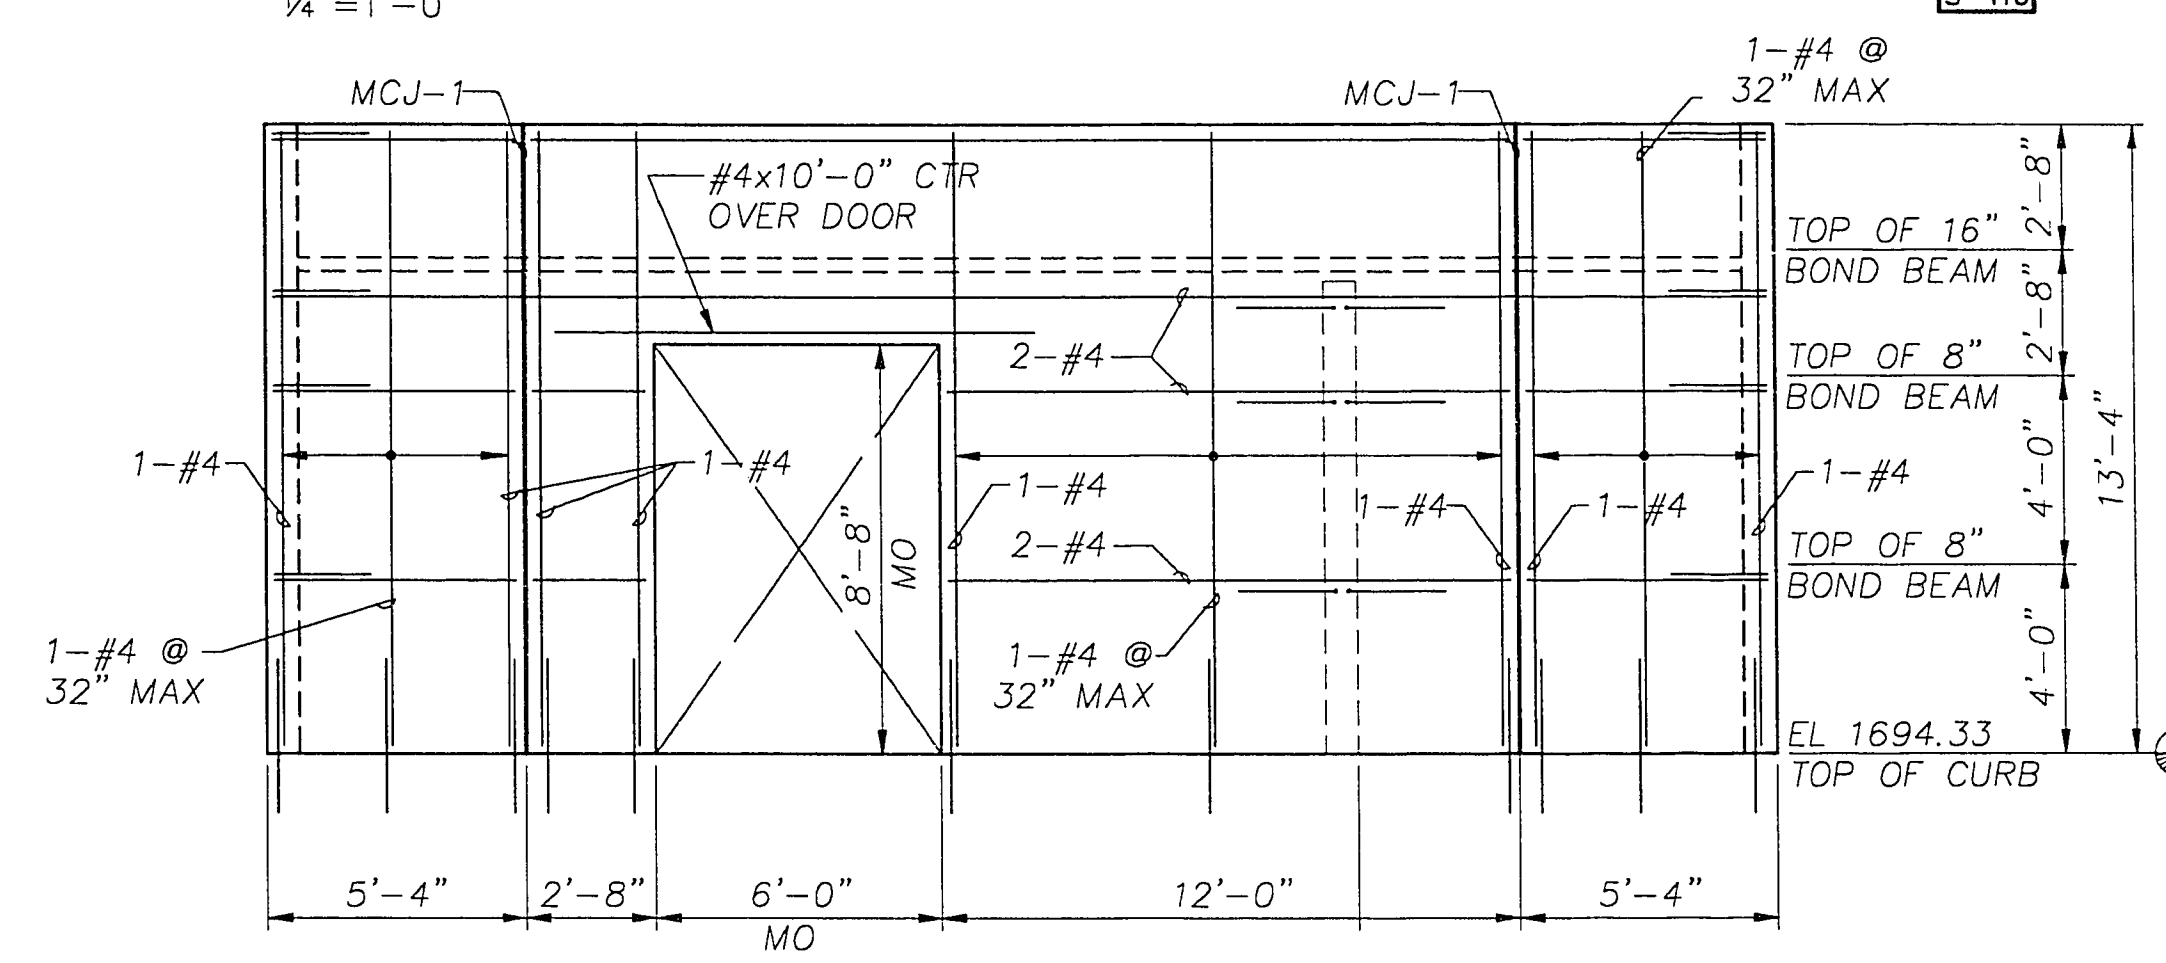

MASONRY ELEVATION

1/4"=1'-0"

E
S-416

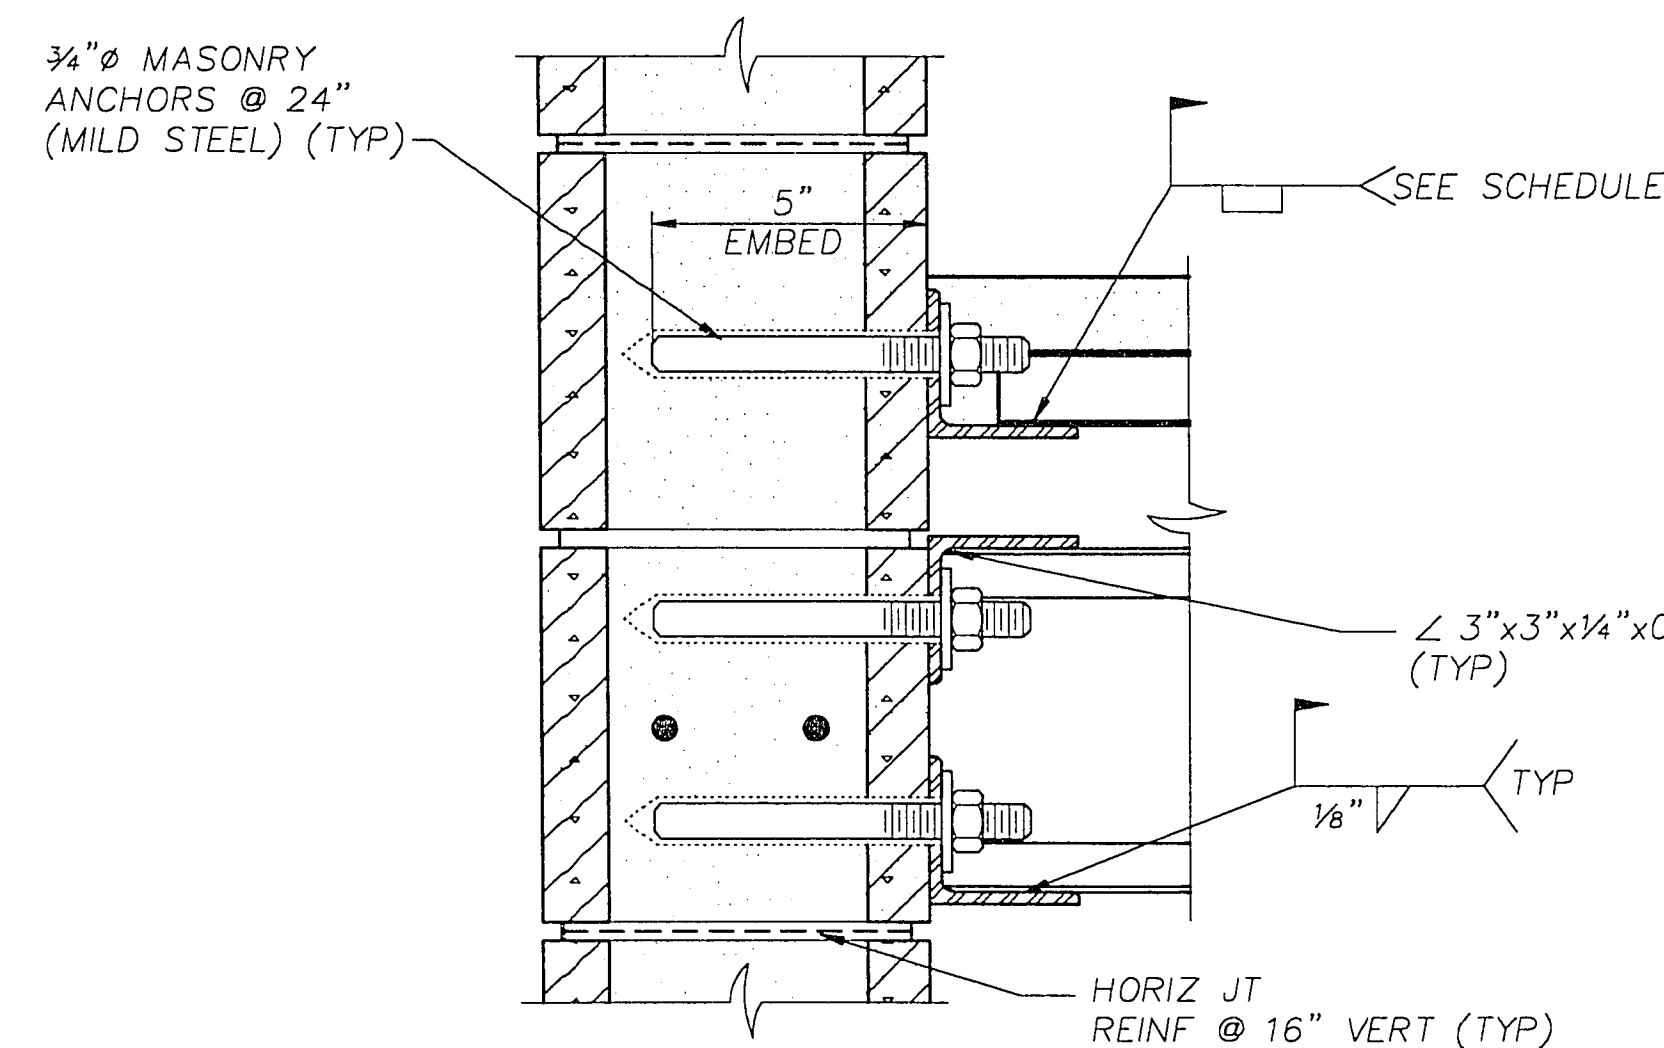

DETAIL


3"=1'-0"

2
S-417

MASONRY ELEVATION

1/4"=1'-0"


C
S-416

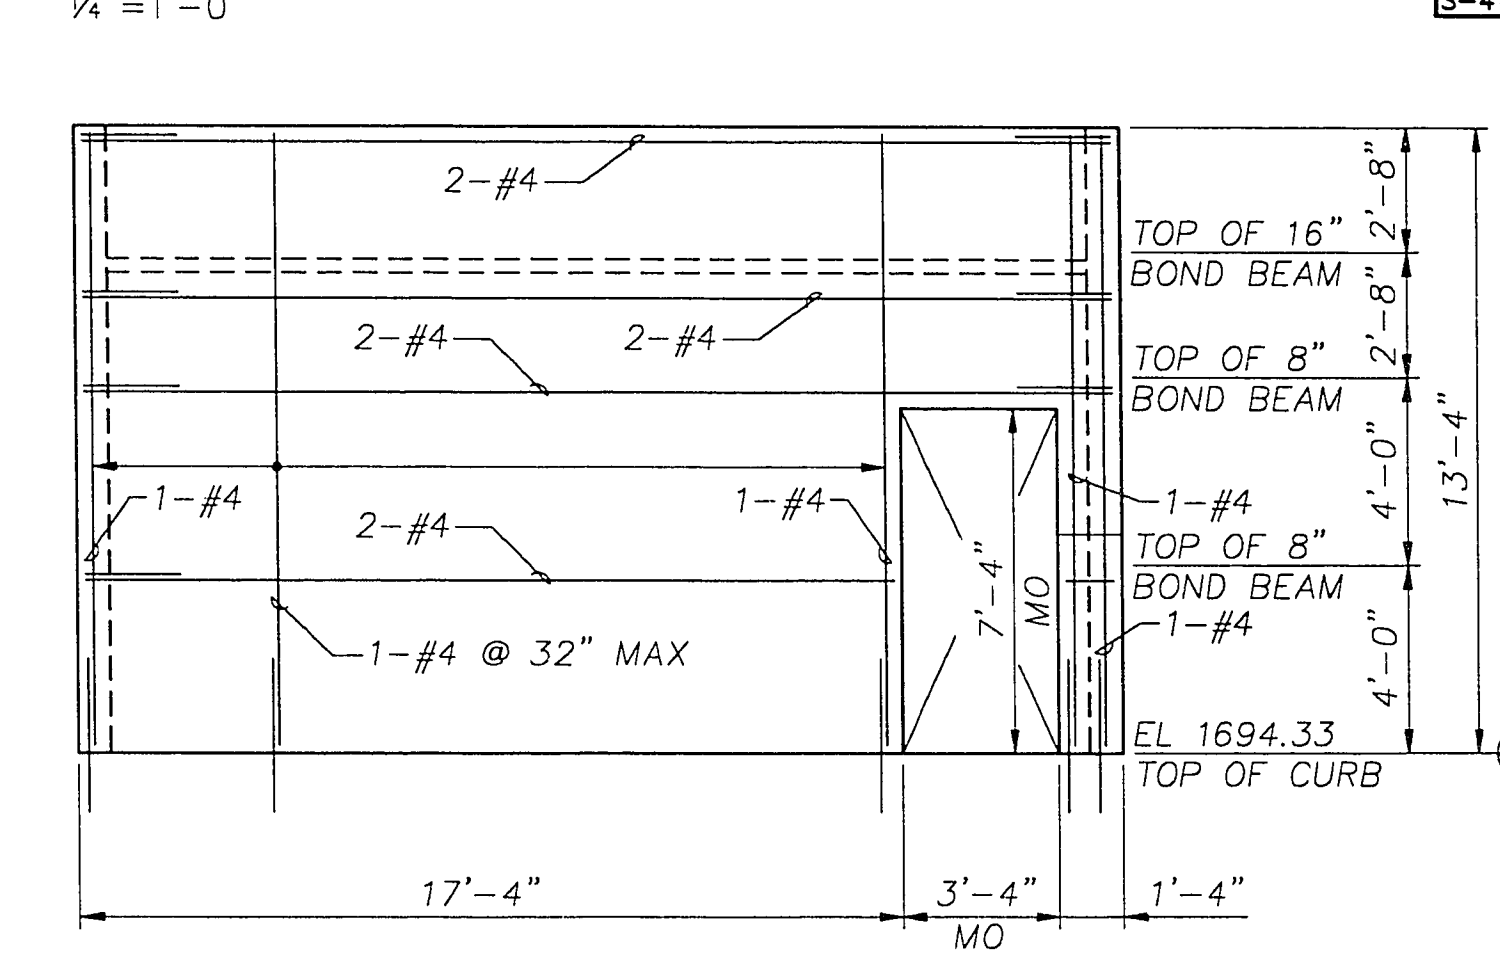

MASONRY ELEVATION

1/4"=1'-0"


F
S-416

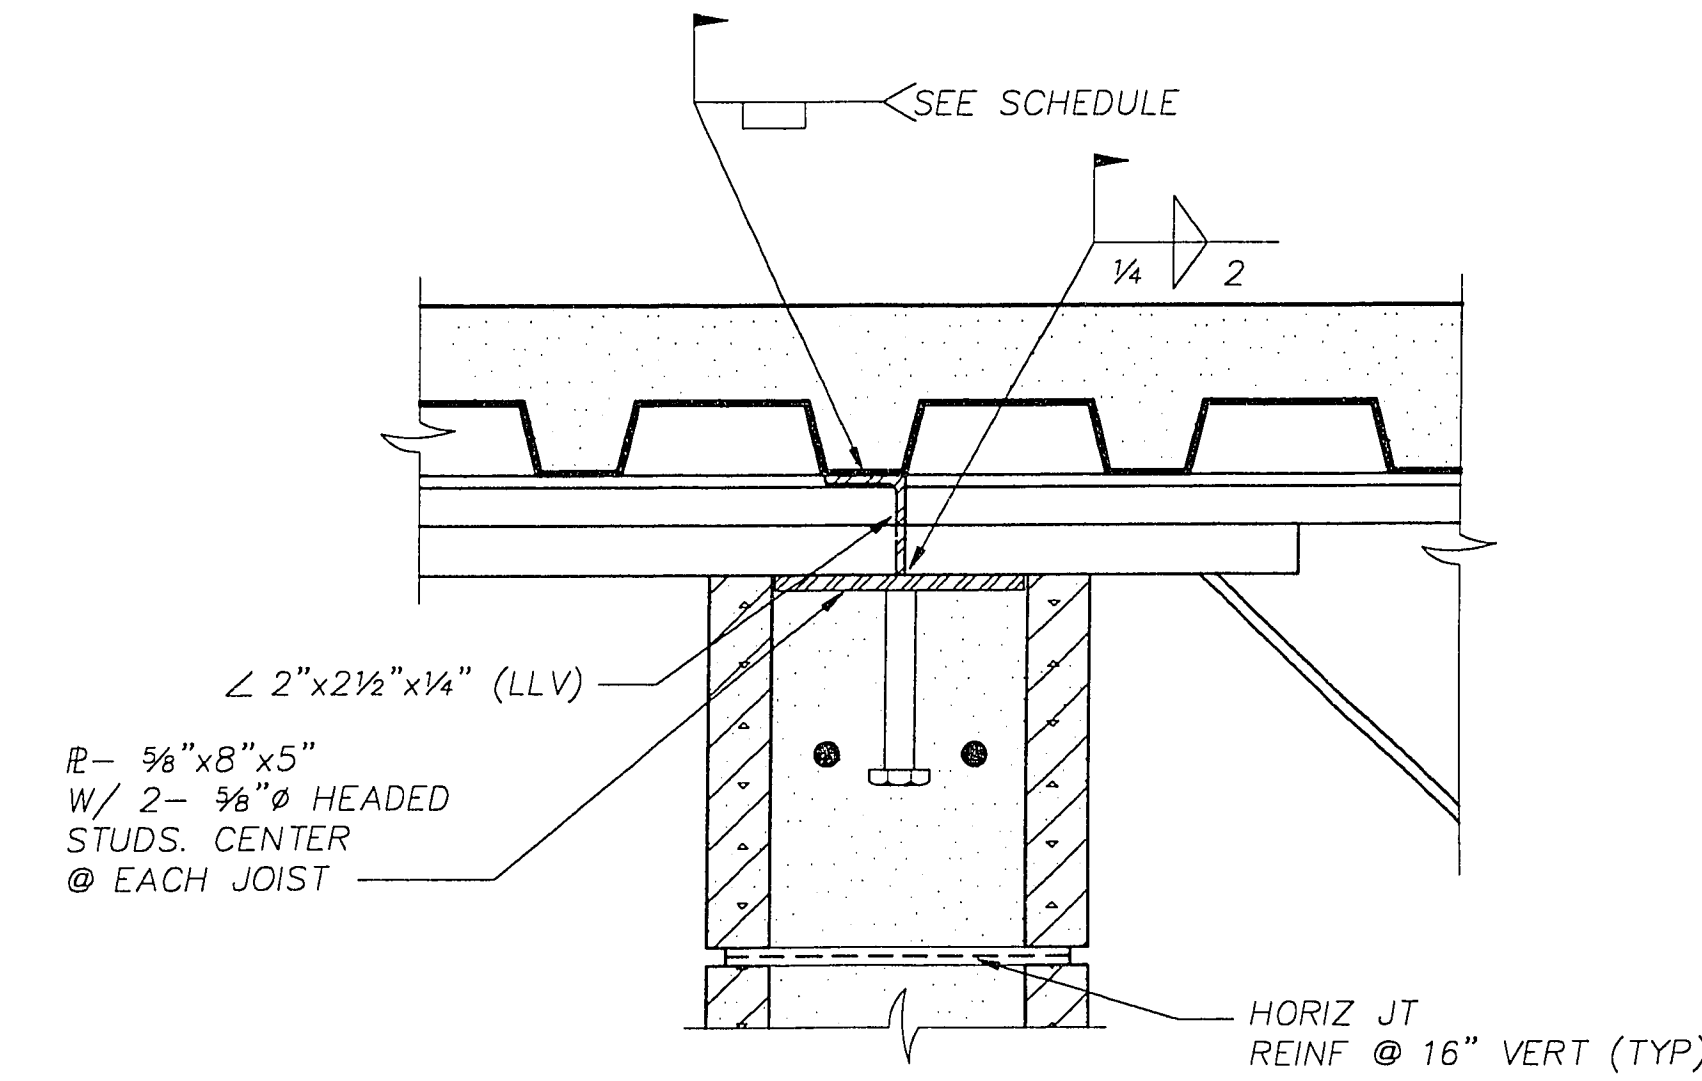

DETAIL

3"=1'-0"

3
S-417

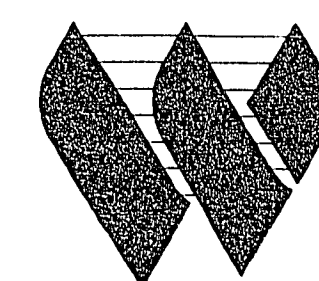


G.C. WALLACE, INC.
Engineering/Architecture



HDR Engineering, Inc.

Issue No.	Description	Date	Drawn	Checked	Responsible	Project Mgr.
1	CORRECTED ACCORDING TO CONSTRUCTION RECORD	1/95	RRL	EFH	MJH	JJC
0	ISSUED FOR CONSTRUCTION	8/20/92	RCH	CRD	CRD	JJC
A	ISSUED FOR BID	4/20/92	JH	RCH	CRD	JJC

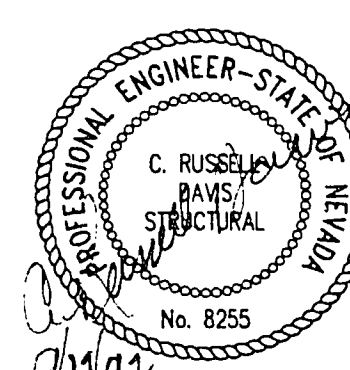

Project Manager	JOHN J. CHUEH
Architect	AC/Process
Civil	Mechanical
Electrical	Structural
	R. DAVIS
	J. HIRSHOUER

City of Las Vegas
Water Pollution Control Facility
Nitrification / Filtration Facilities
Contract 17
NITRIFICATION COMPLEX

FINAL CLARIFIERS
ELECTRICAL BUILDING
MASONRY ELEVATIONS

Date	APRIL 1992	Project No.	00120-084-141	Drawing No.	S-418	Issue	1
Scale	1/4" = 1'-0"						