



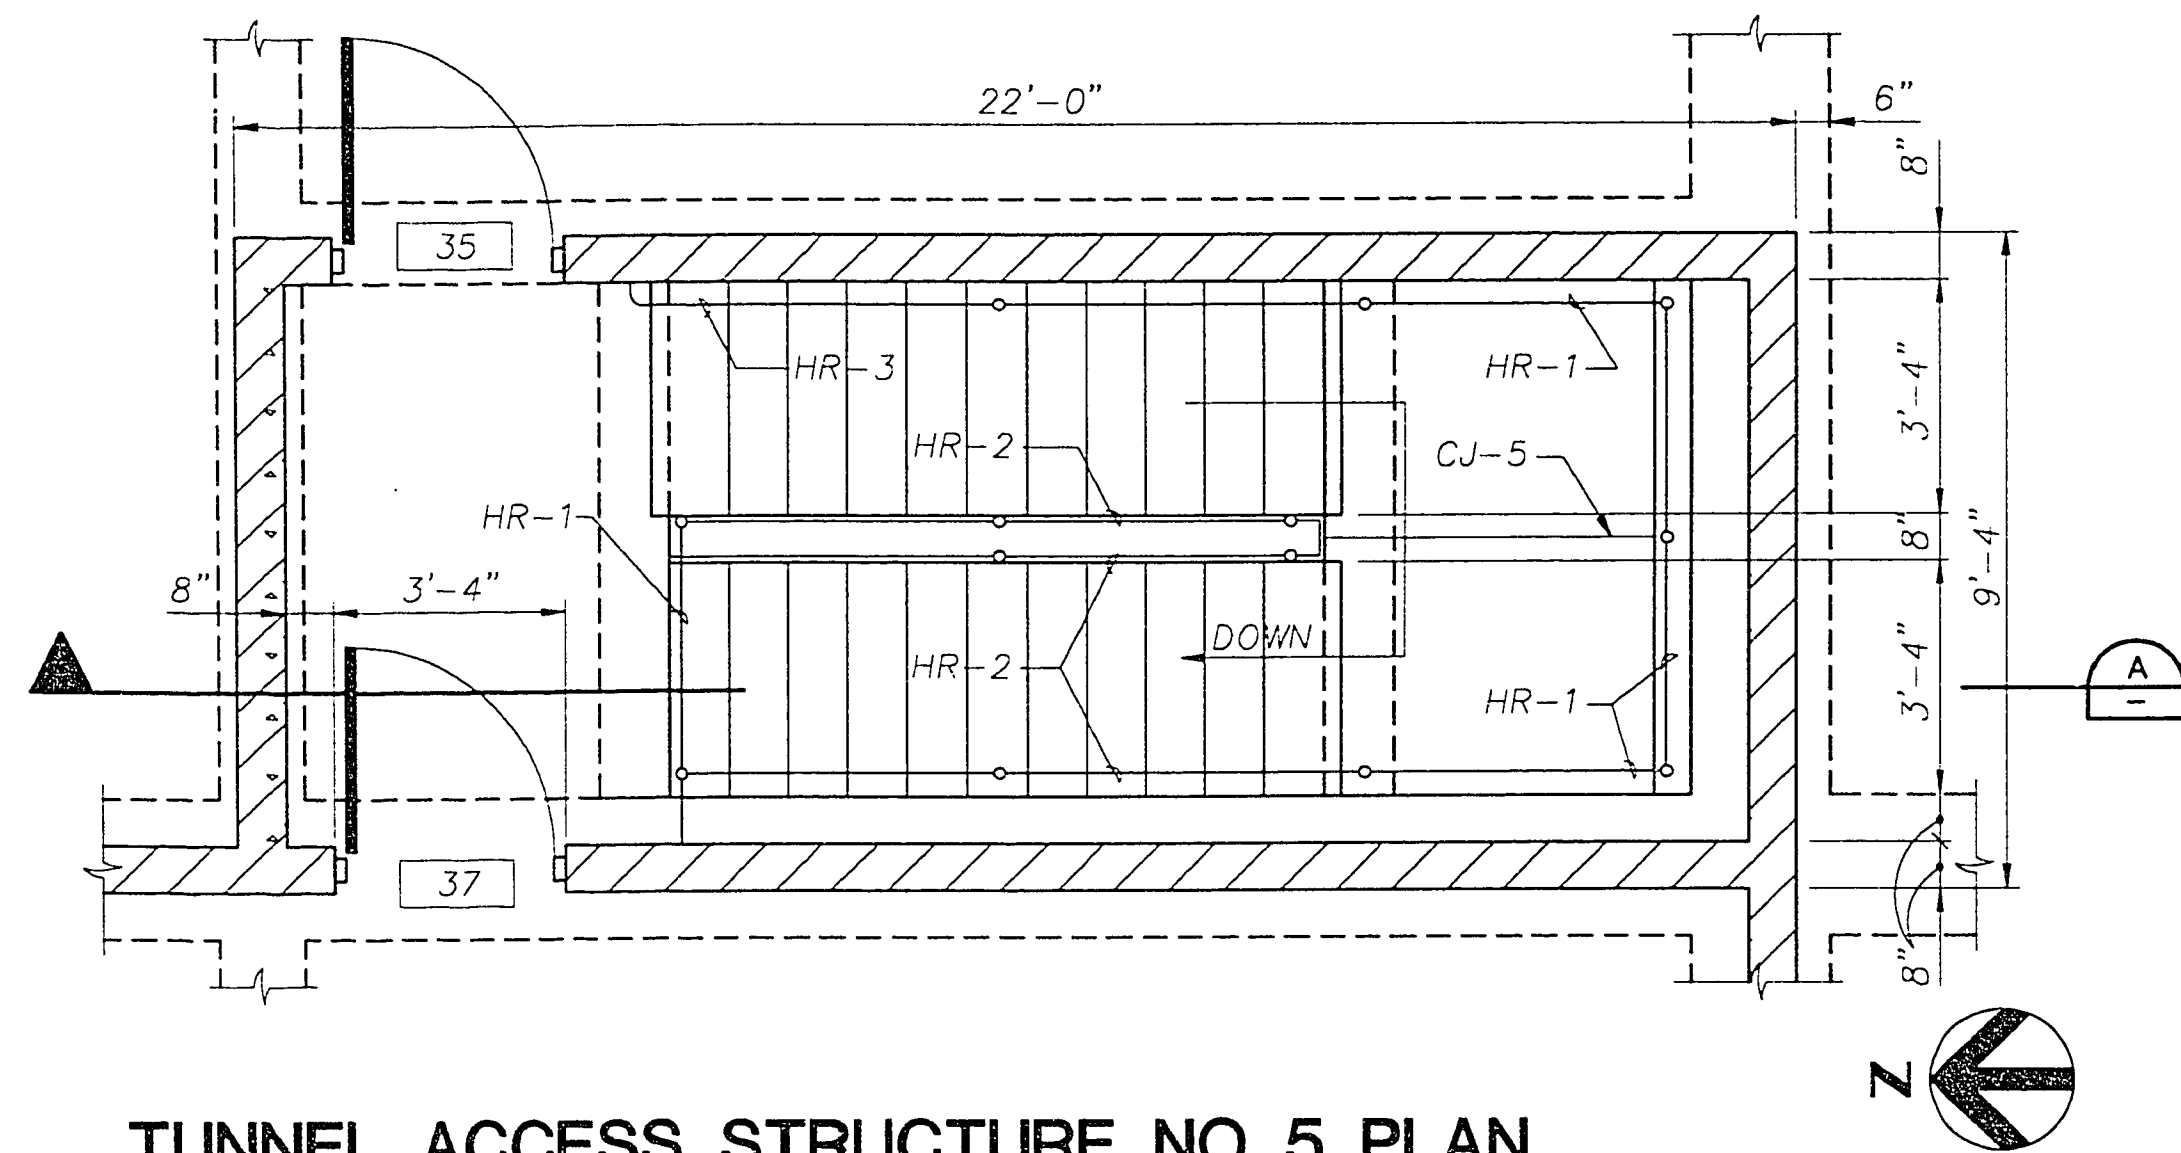


TUNNEL ACCESS STRUCTURE NO 5 PLAN

3/8"=1'-0"

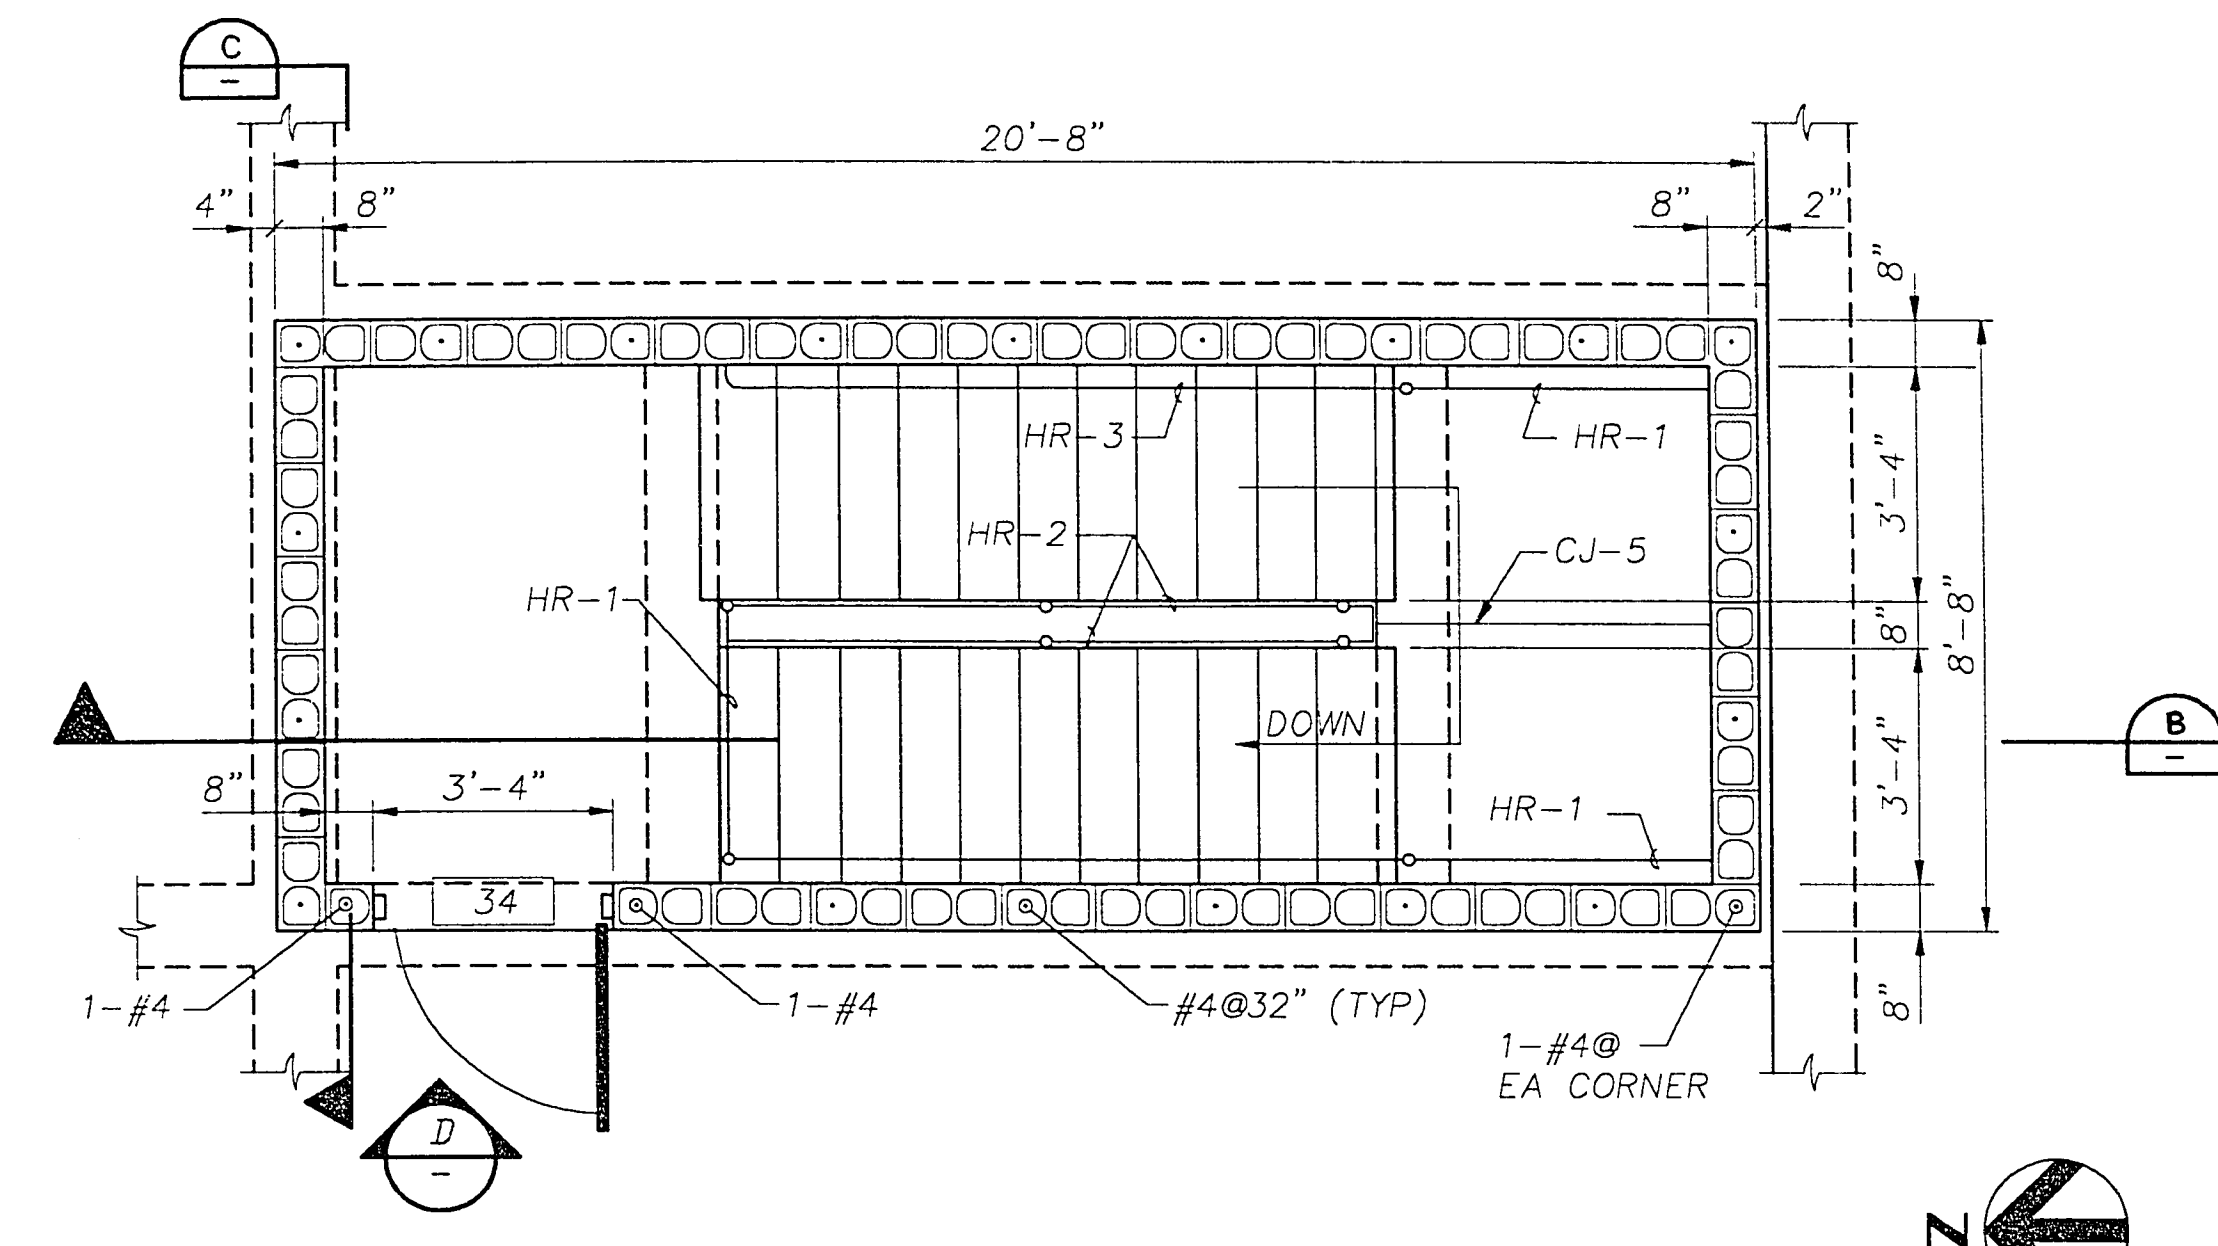


TUNNEL ACCESS STRUCTURE NO 4 PLAN

3/8"=1'-0"

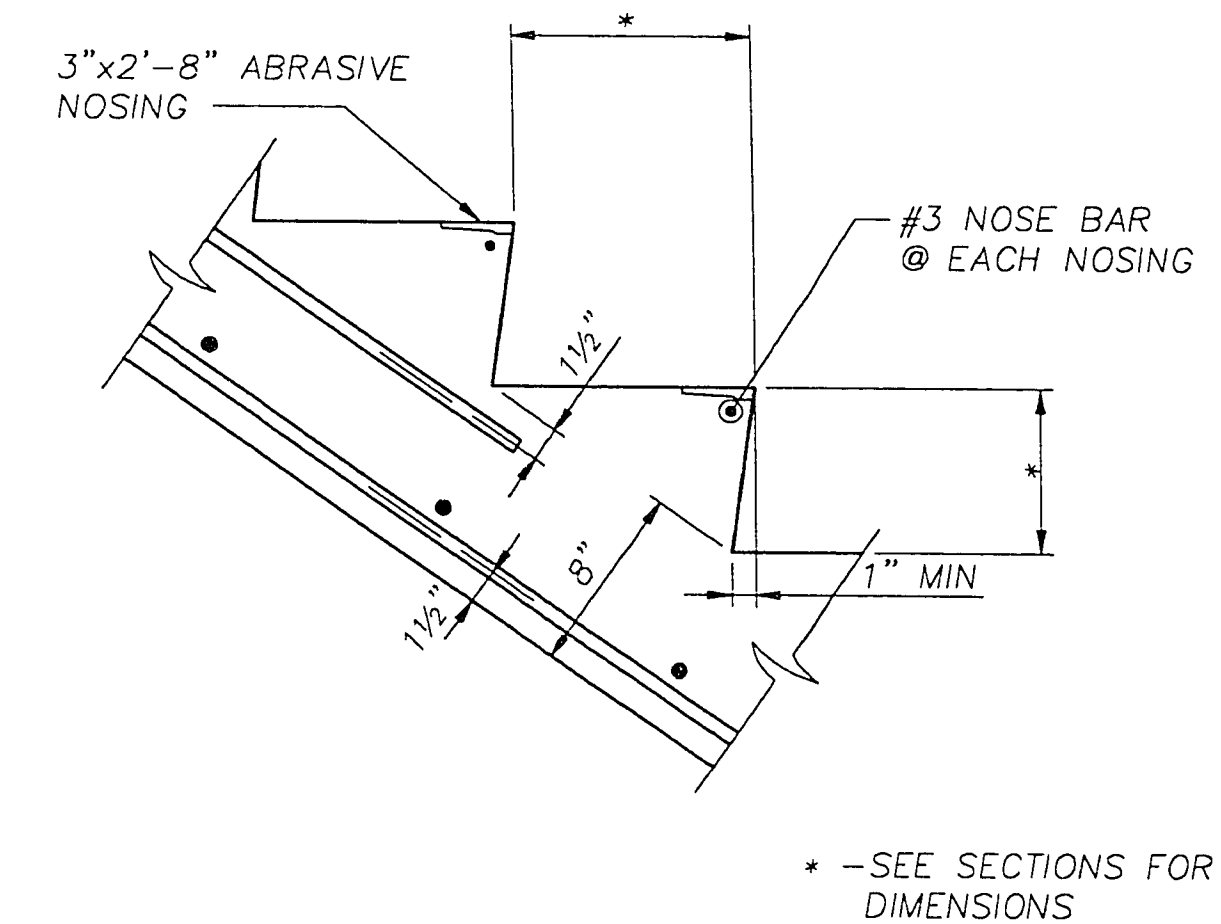


DETAIL

1 1/2"=1'-0"

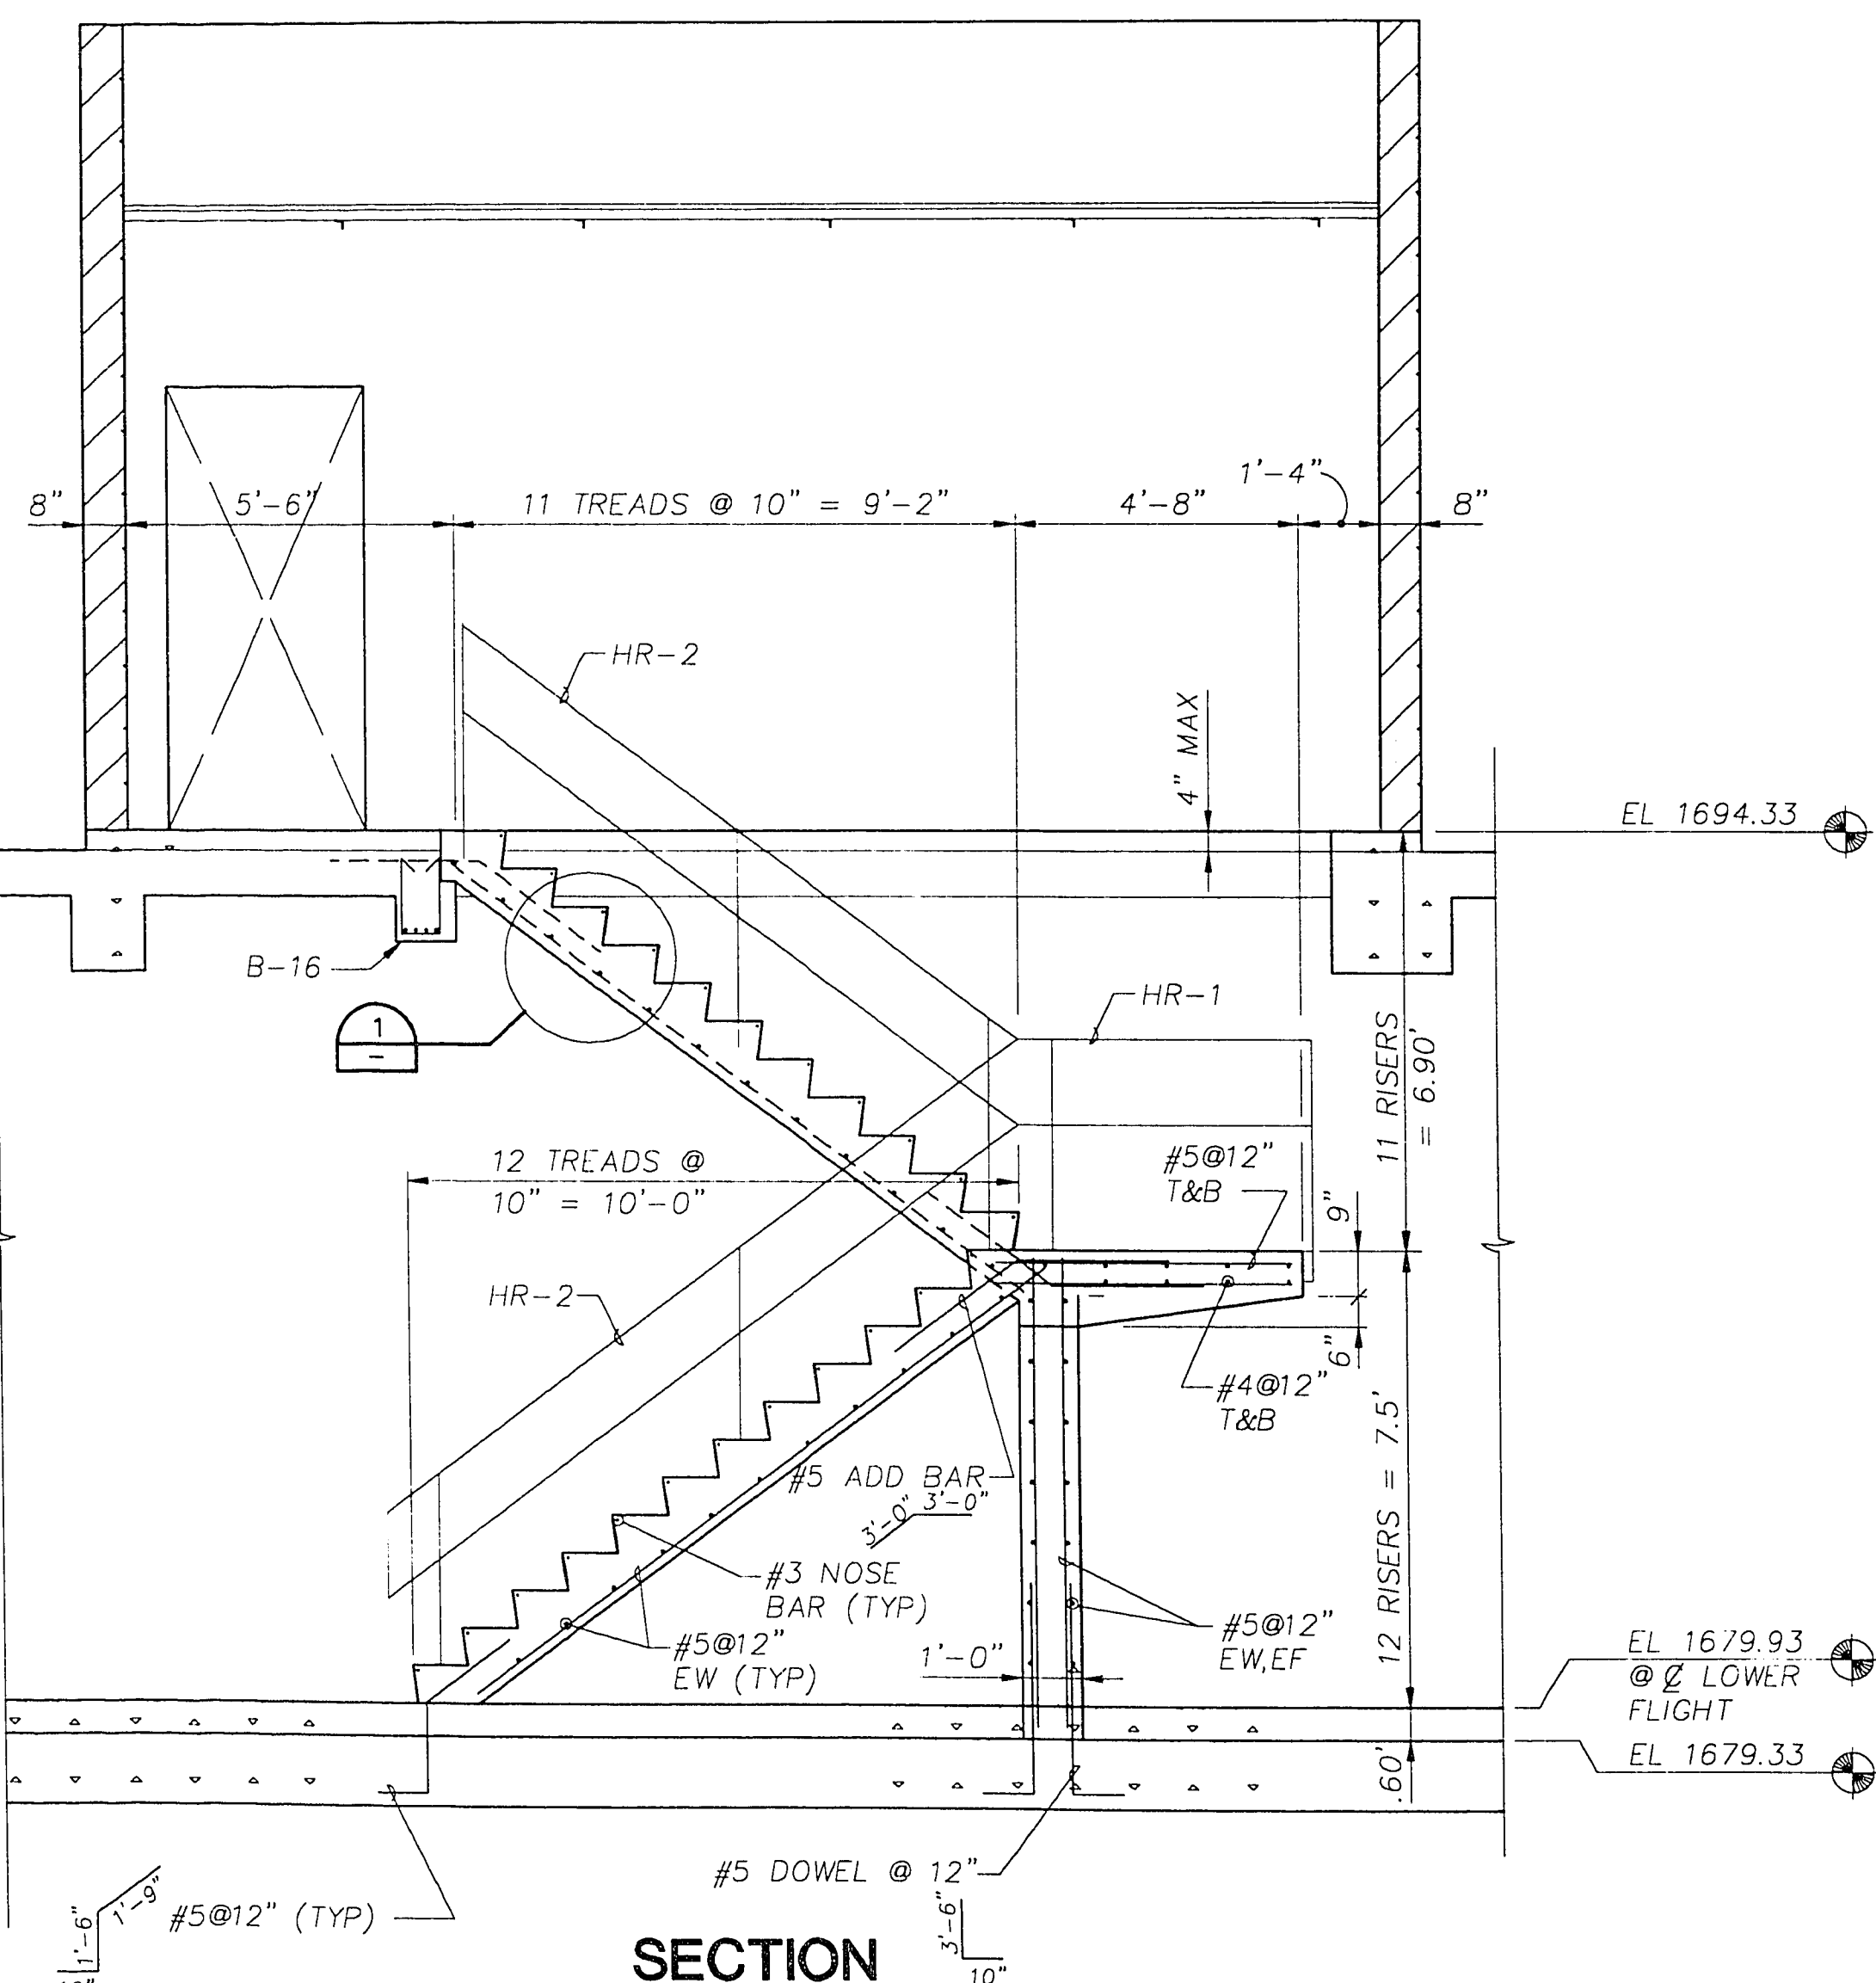


STAIR DETAIL

3/8"=1'-0"

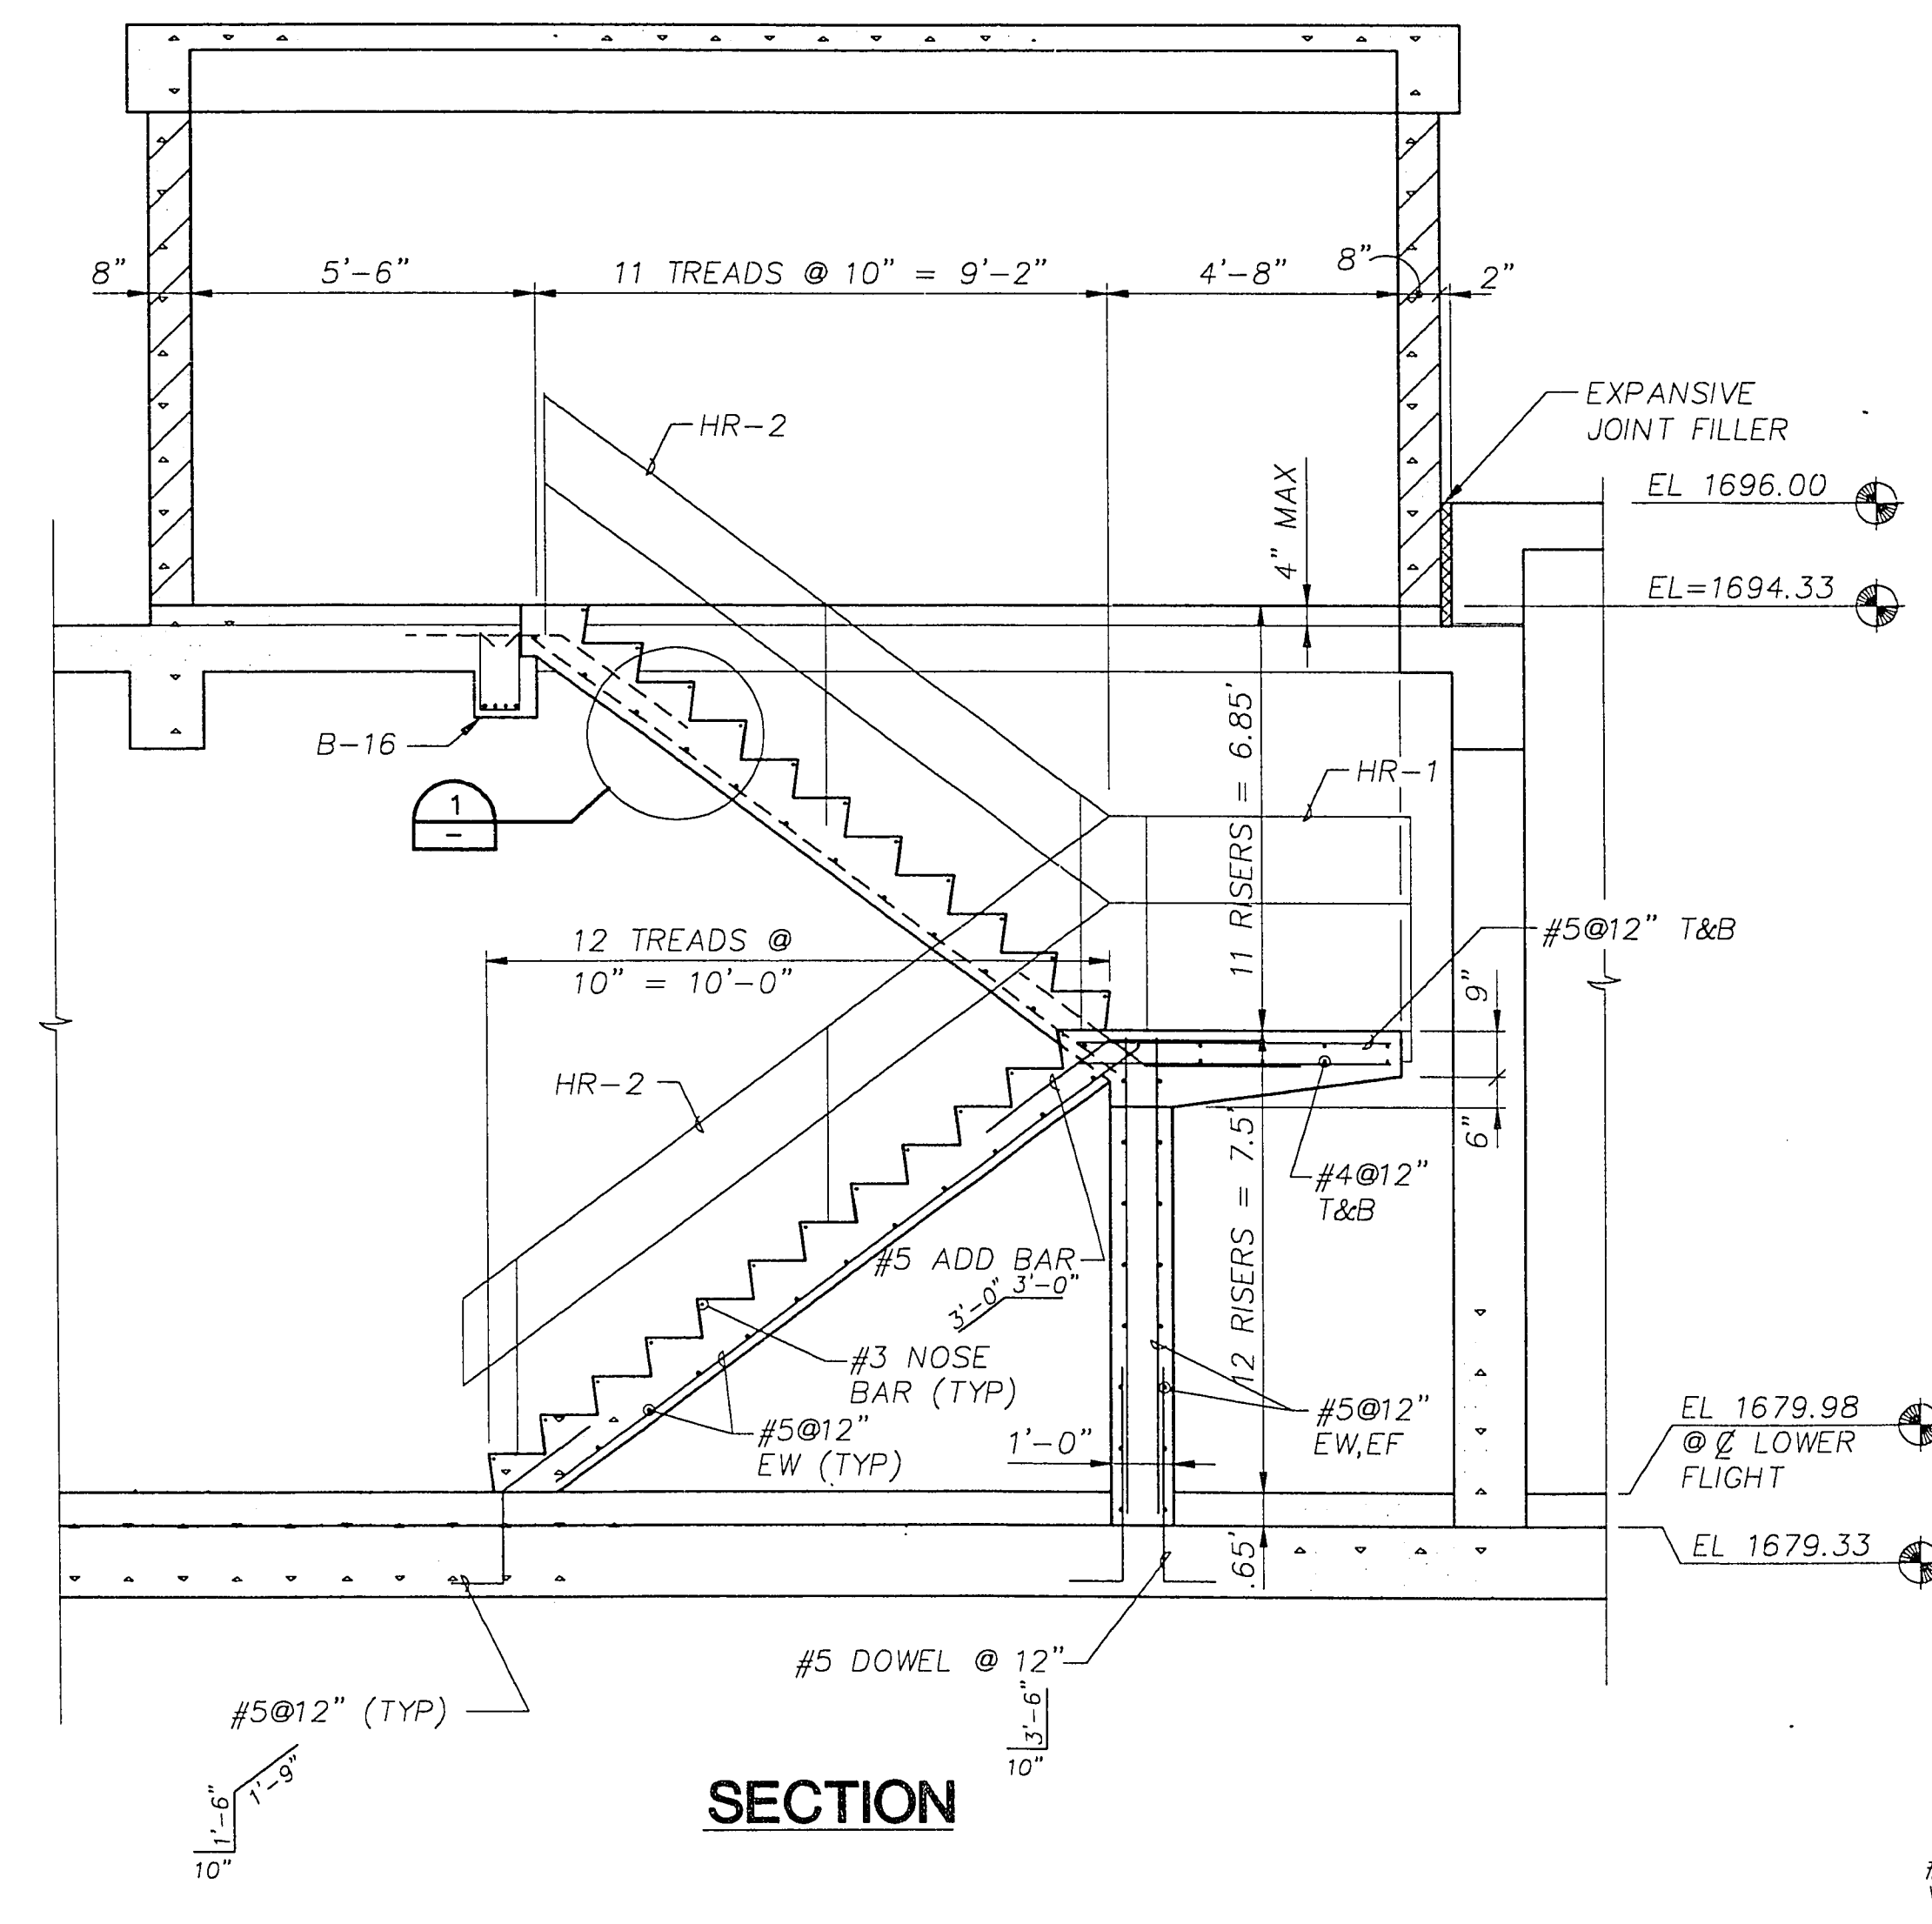


STAIR DETAIL

3/8"=1'-0"

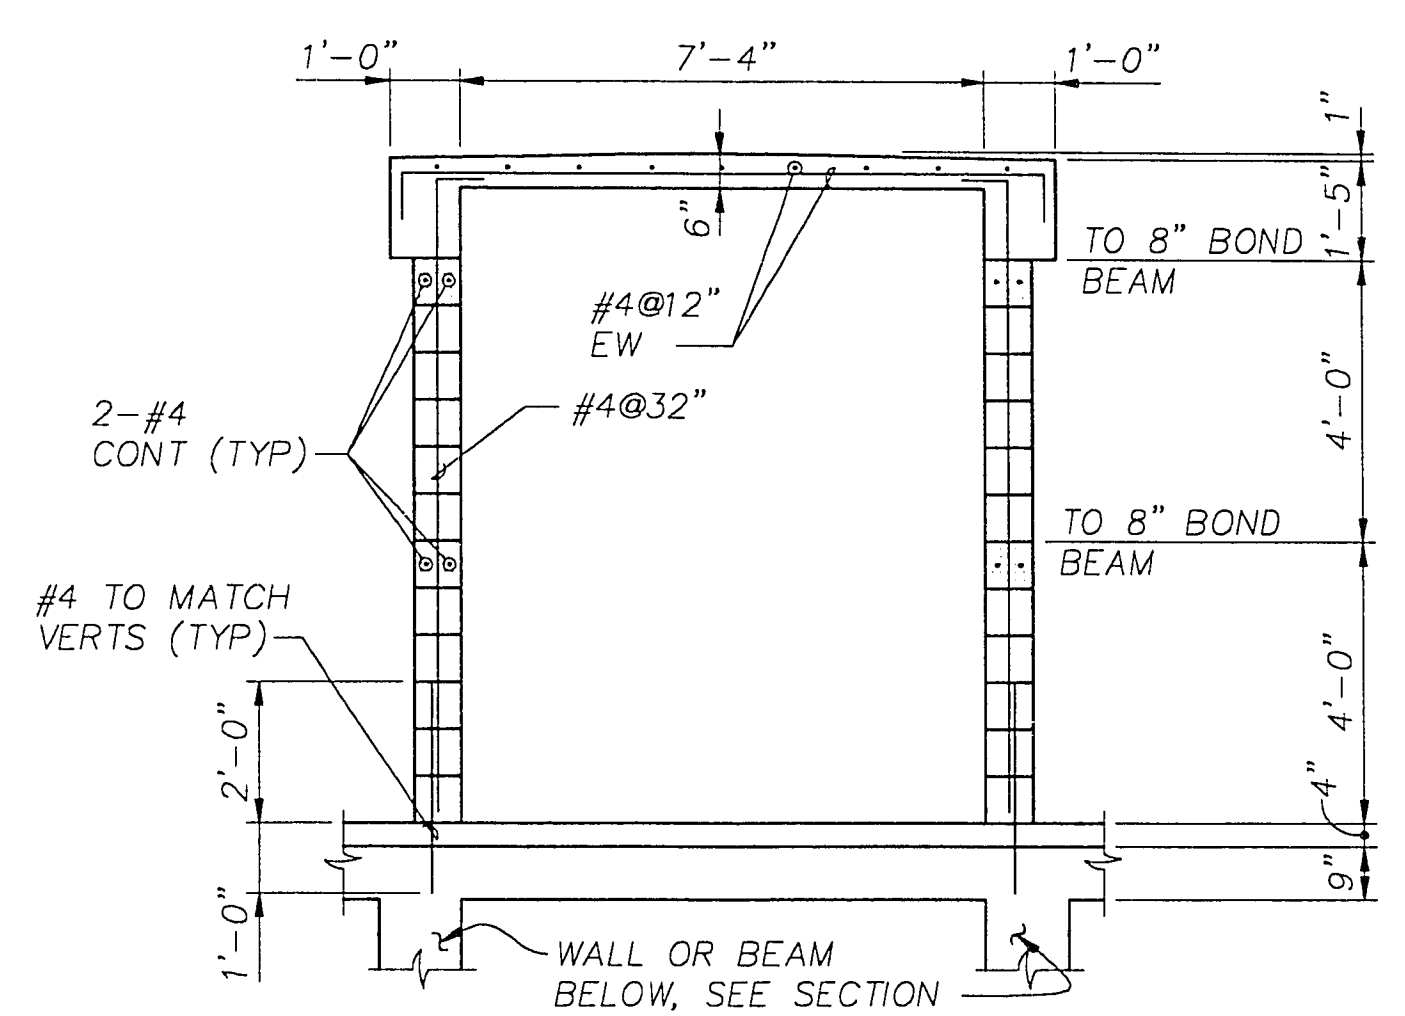


SECTION

3/8"=1'-0"

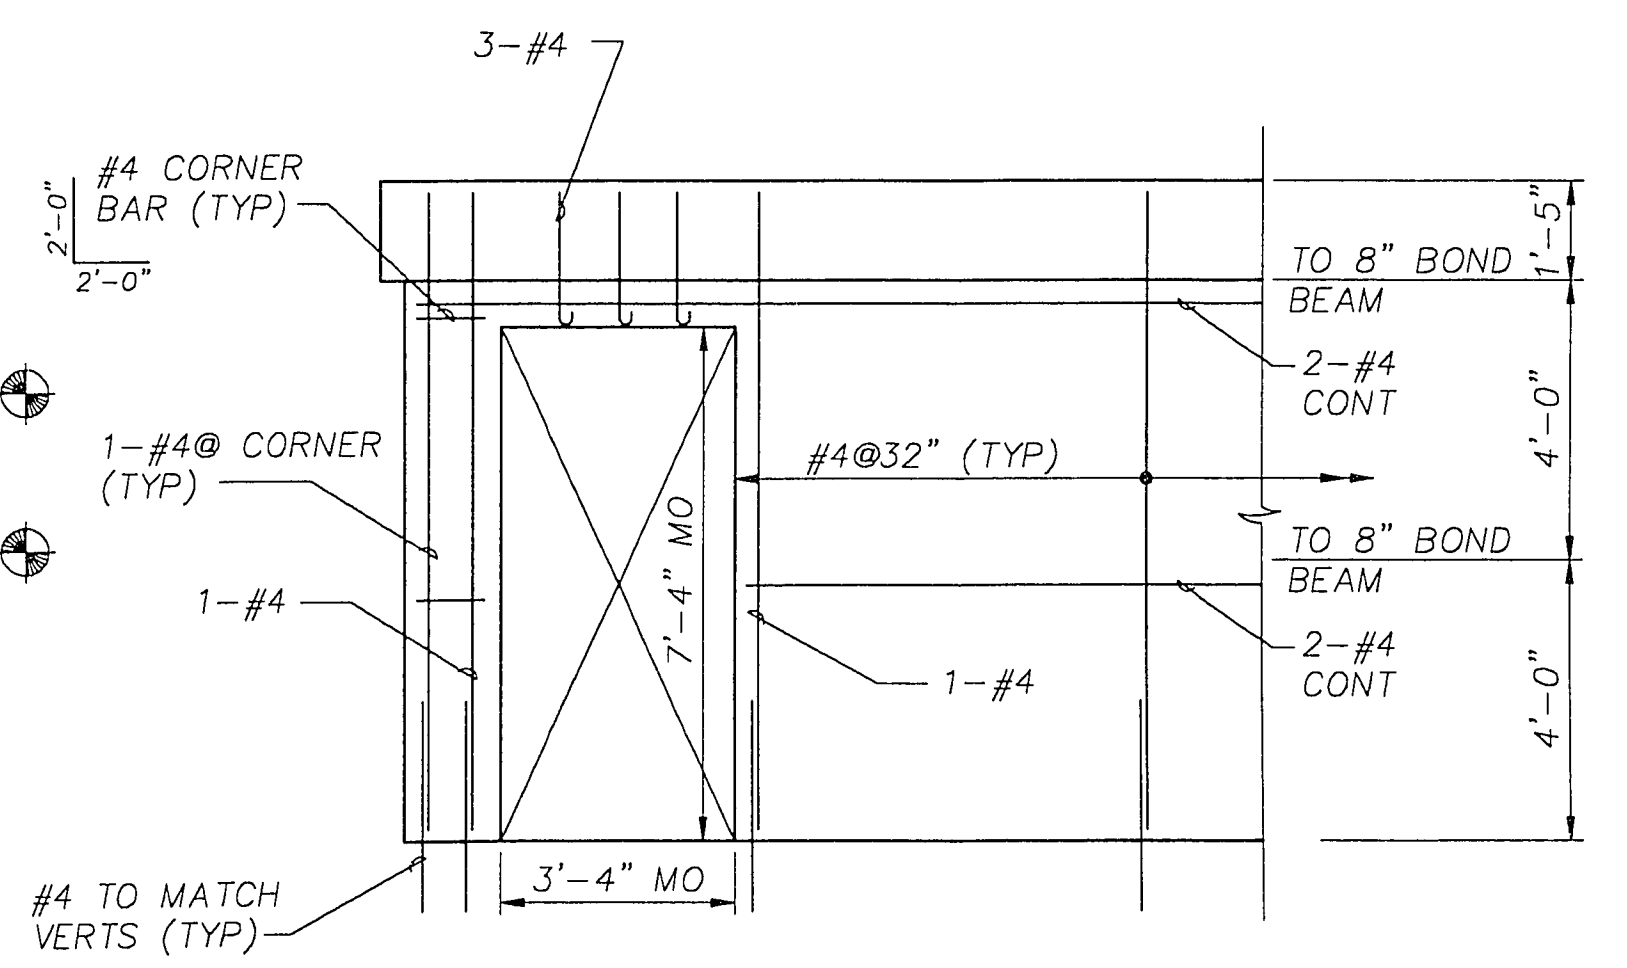

PARTIAL ELEVATION

3/8"=1'-0"

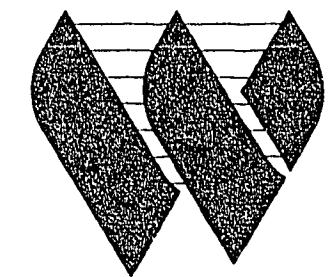


G.C. WALLACE, INC.
Engineering/Architecture



HDR Engineering, Inc.

Issue No.	Description	Date	Drawn	Checkd.	Resp. Engr.	Proj. Mgr.
1	CORRECTED ACCORDING TO CONSTRUCTION RECORD	1/95	RRL	EFH	M.JH	JJC
0	ISSUED FOR CONSTRUCTION	8/20/92	RCH	CRD	CRD	JJC
A	ISSUED FOR BID	4/20/92	JH	RCH	CRD	JJC

Issue No.	Description	Date	Drawn	Checkd.	Resp. Engr.	Proj. Mgr.
1	CORRECTED ACCORDING TO CONSTRUCTION RECORD	1/95	RRL	EFH	M.JH	JJC
0	ISSUED FOR CONSTRUCTION	8/20/92	RCH	CRD	CRD	JJC
A	ISSUED FOR BID	4/20/92	JH	RCH	CRD	JJC

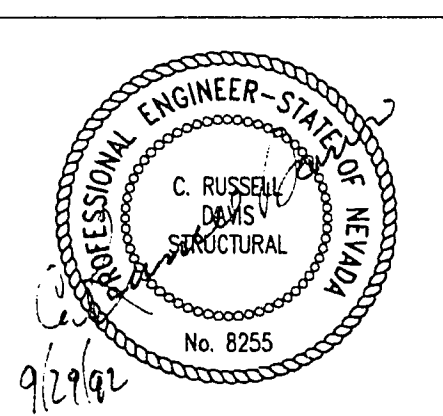

Project Manager	JOHN J. CHUEH
Architect	I&C/Process
Civil	
Electrical	
Structural	R. DAVIS
Drawn By	J. HIRSHOUER

City of Las Vegas
Water Pollution Control Facility
Nitrification / Filtration Facilities
Contract 17
NITRIFICATION COMPLEX

FINAL CLARIFIERS			
STAIR PLANS AND SECTIONS			
Date	APRIL 1992	Project No.	00120-084-141
Scale	AS NOTED	Drawing No.	S-420
		Issue	1