



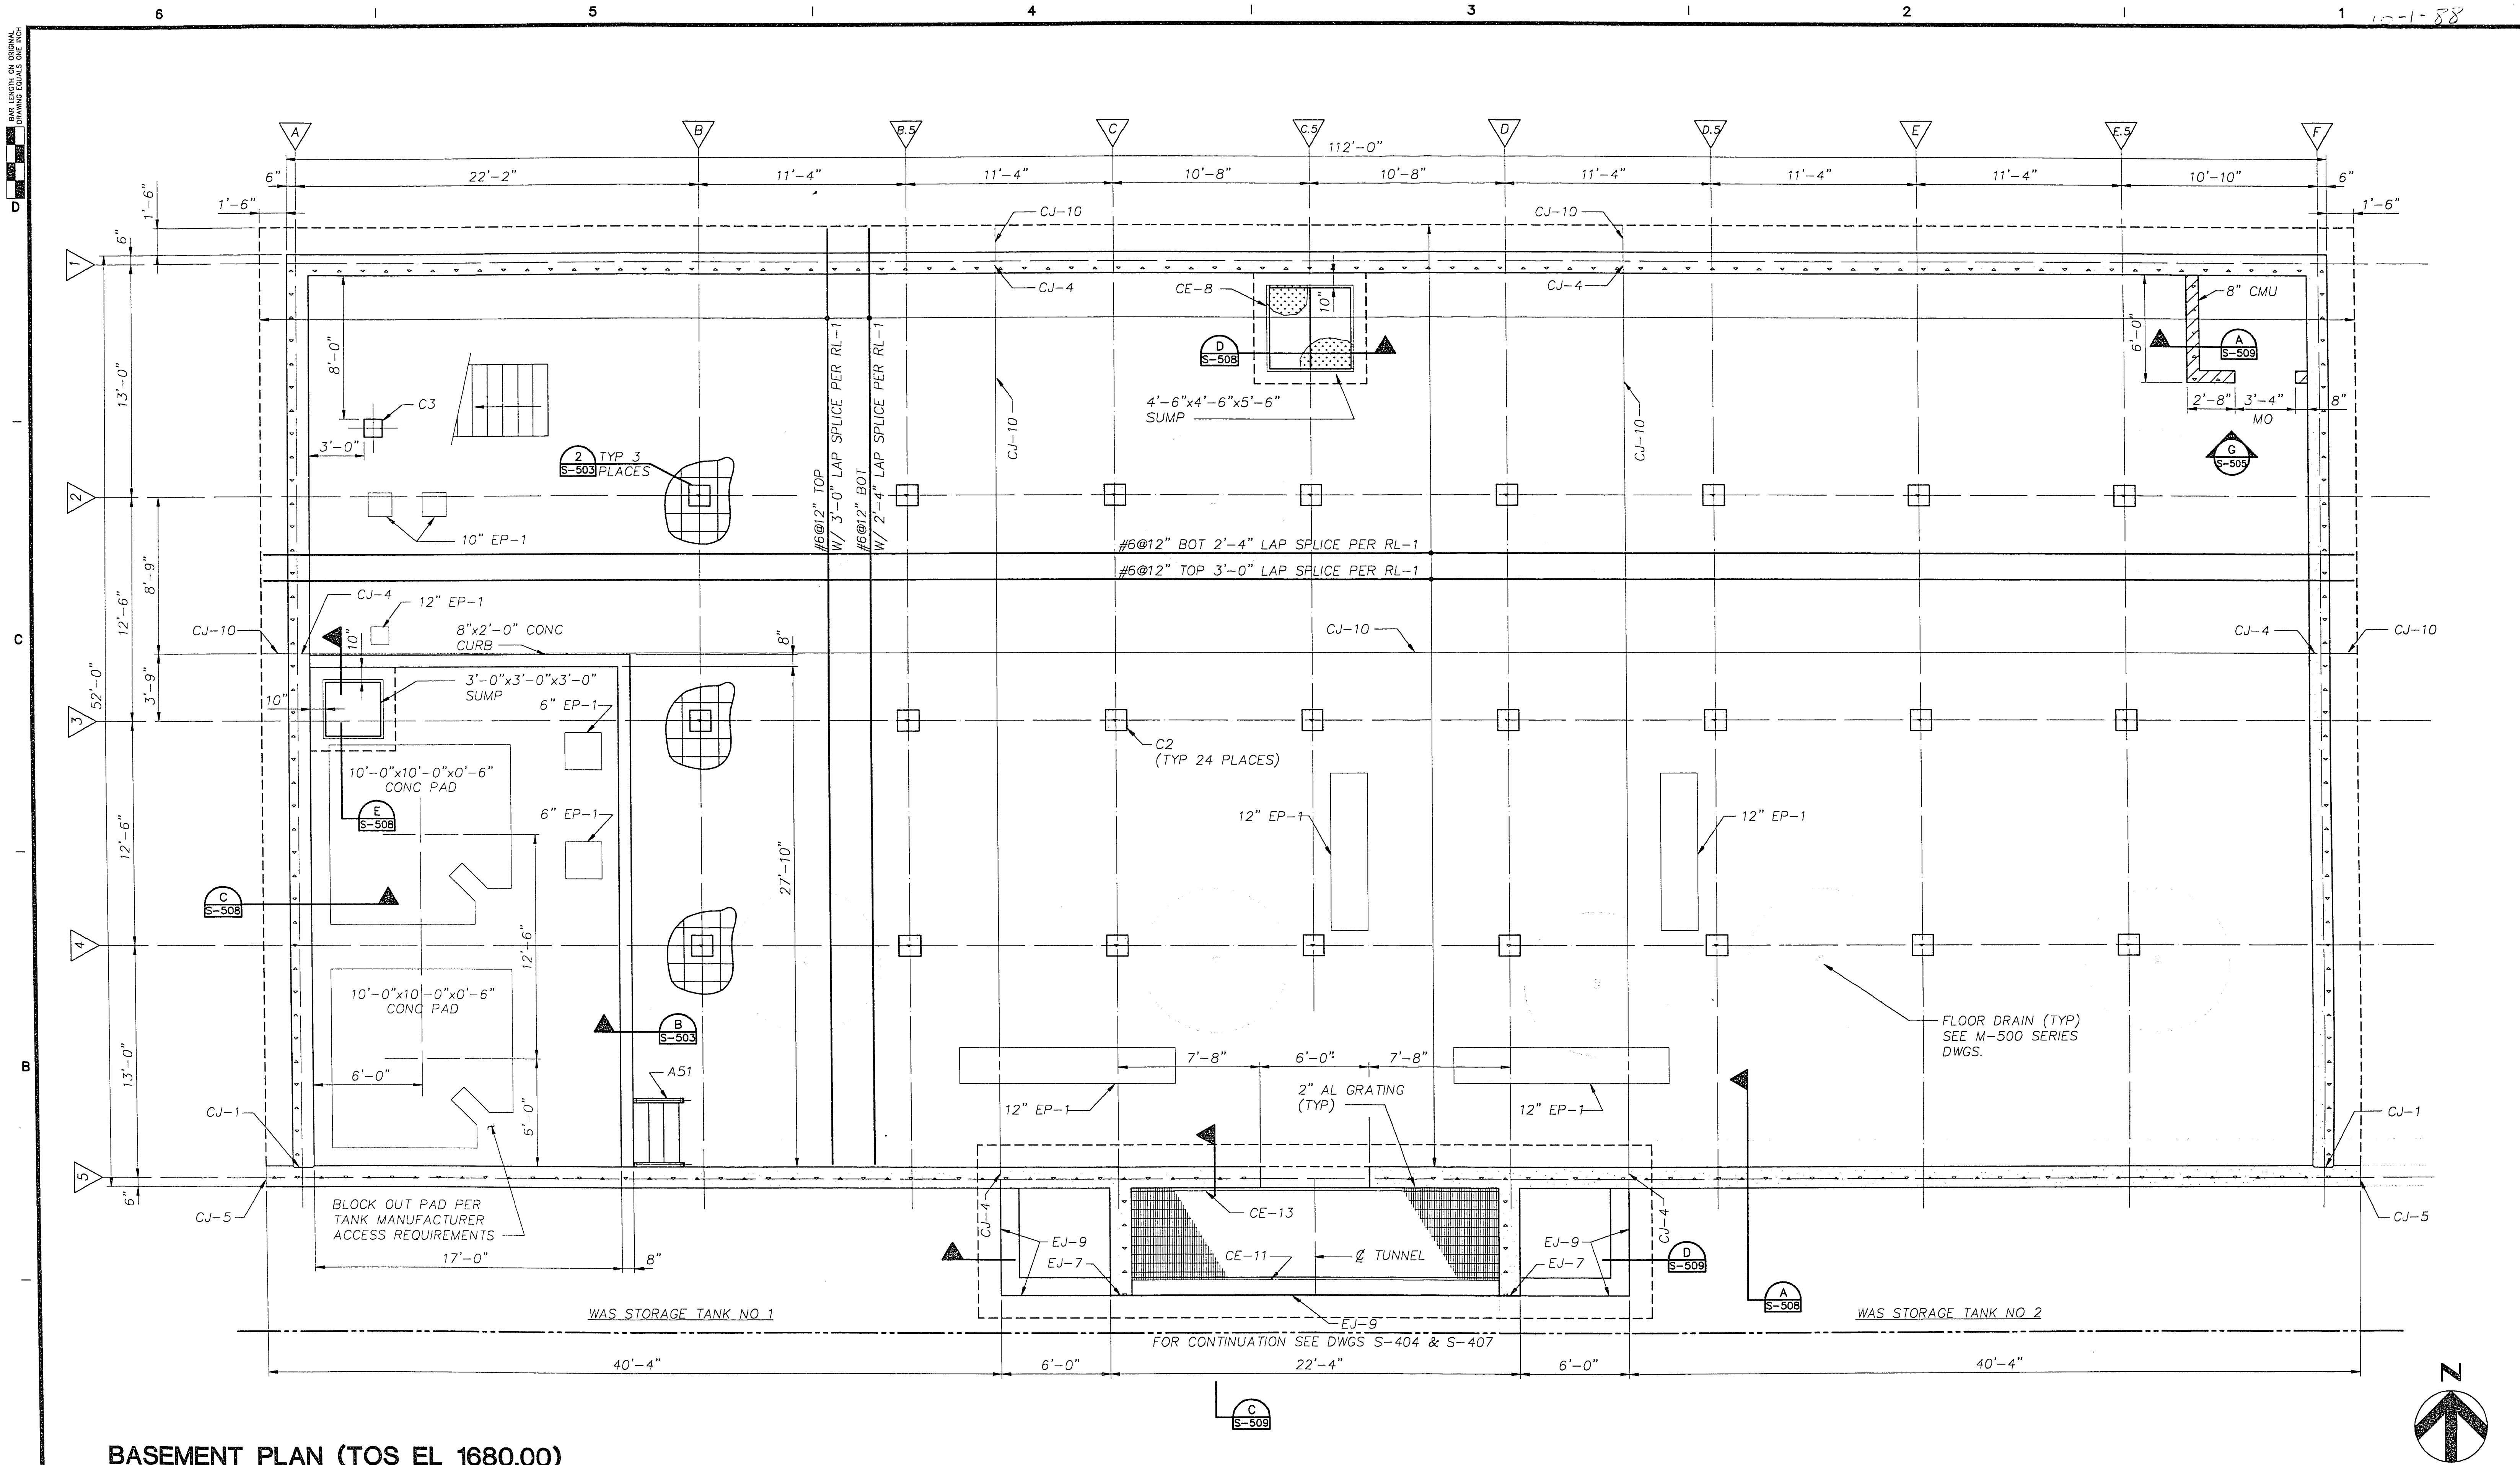

BASEMENT PLAN (TOS EL 1680.00)

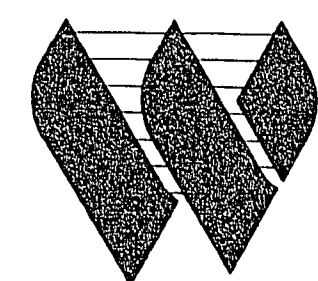


G.C. WALLACE, INC.
Engineering/Architecture




HDR Engineering, Inc.

Issue No.	Description	Date	Drawn	Chkd.	Rep. Drg.	Proj. Mgr.
1	CORRECTED ACCORDING TO CONSTRUCTION RECORD	1/95	RRL	EFH	MJH	JJC
0	ISSUED FOR CONSTRUCTION	8/20/92	RCH	CRD	CRD	JJC
A	ISSUED FOR BID	4/20/92	JH	CLS	CRD	JJC

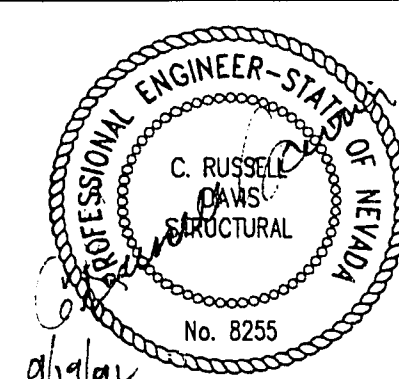

Project Manager	JOHN J. CHUEH
Architect	
Civil	
Electrical	
Mechanical	
Structural	R. DAVIS
Drawn By	J. HIRSHOUER

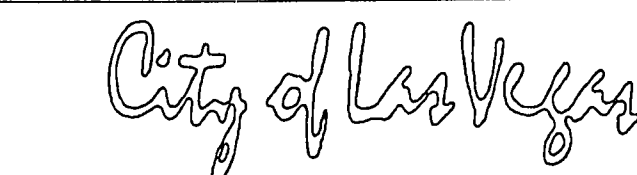

Water Pollution Control Facility
Nitrification / Filtration Facilities

Contract 17
NITRIFICATION COMPLEX

CENTRIFUGE BUILDING
BASEMENT PLAN

Date	APRIL 1992	Project No.	00120-084-141	Drawing No.	S-502	Issue	1
Scale	1/4" = 1'-0"						

311.35