




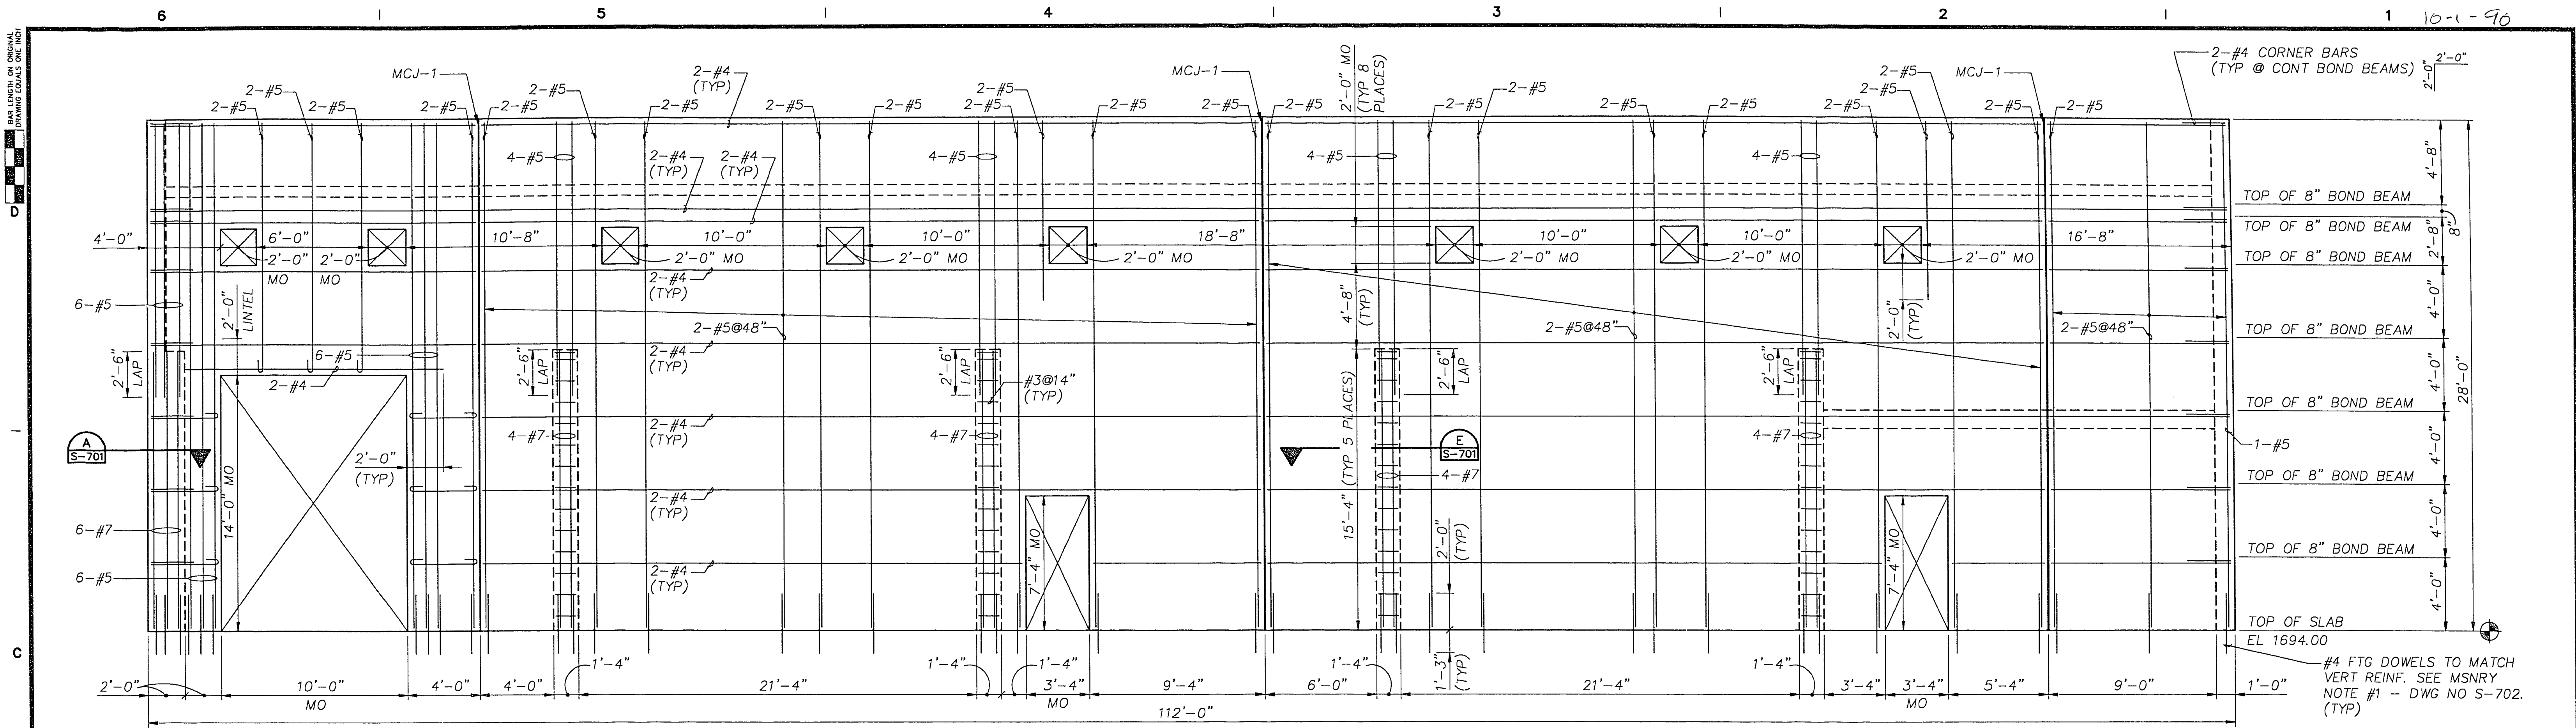


MASONRY ELEVATION (NORTH)

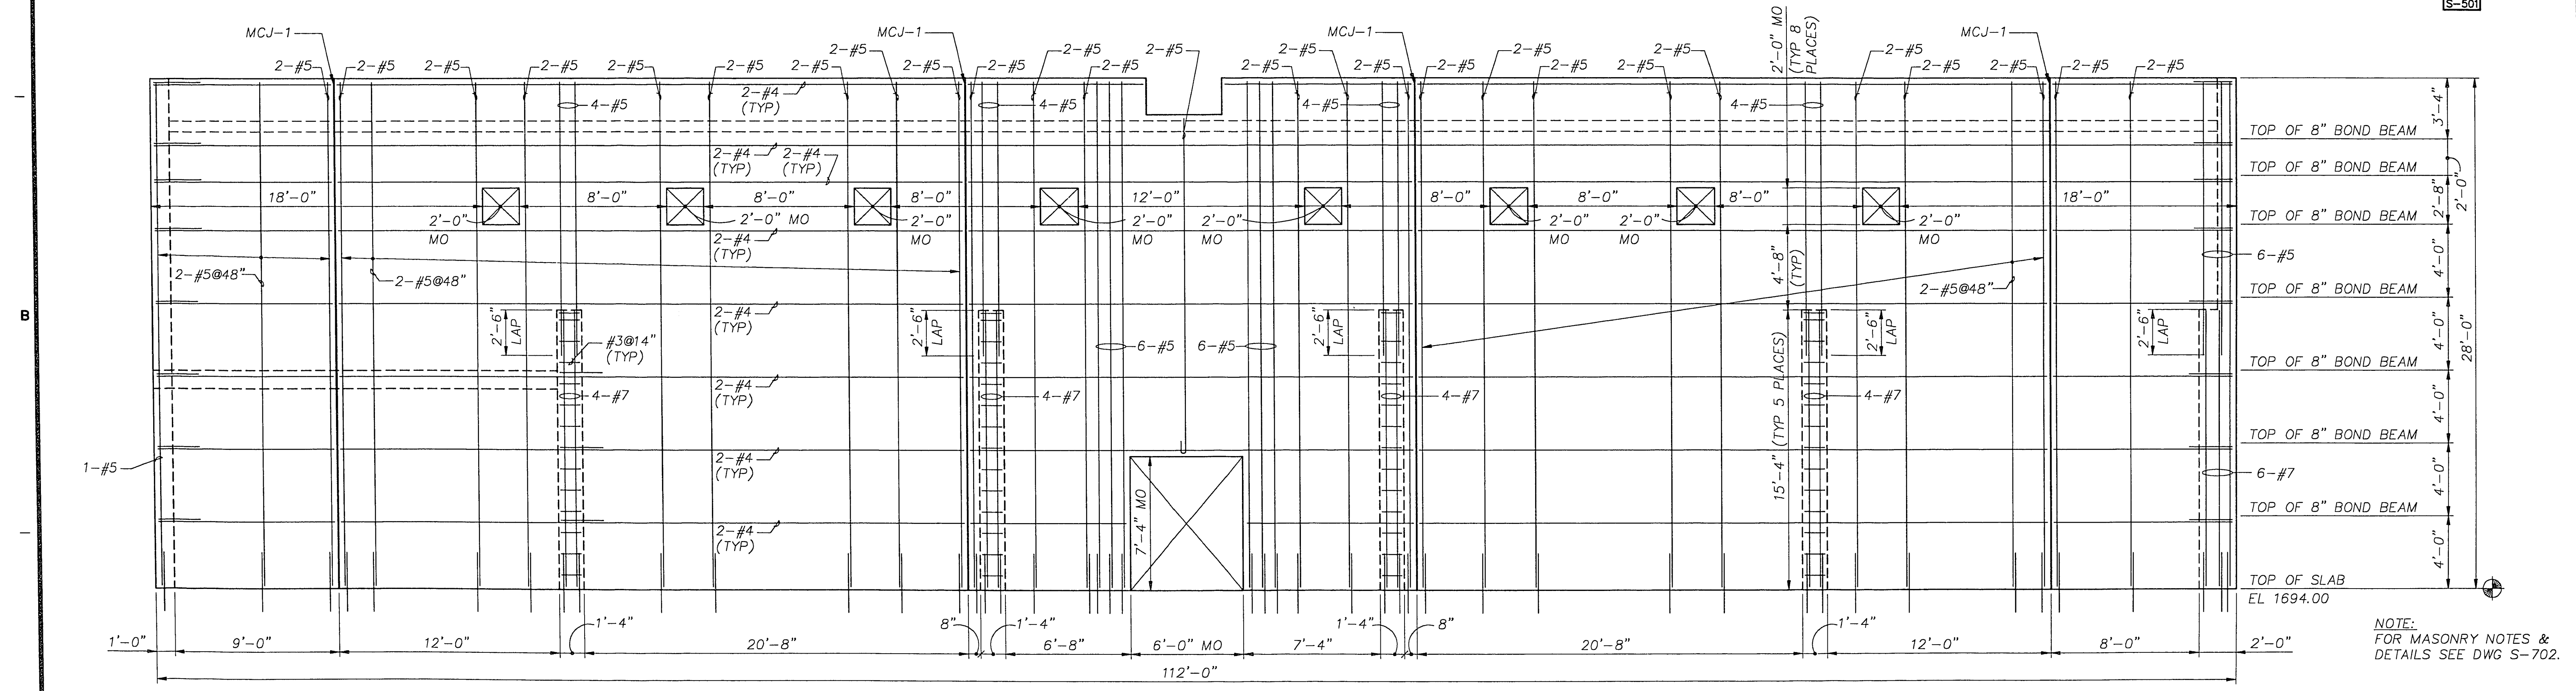

MASONRY ELEVATION (SOUTH)

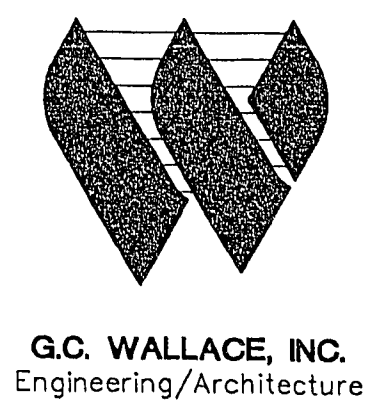

|           |                                            |         |       |       |            |            |
|-----------|--------------------------------------------|---------|-------|-------|------------|------------|
| 1         | CORRECTED ACCORDING TO CONSTRUCTION RECORD | 1/95    | RRL   | EFH   | MJH        | JJC        |
| 0         | ISSUED FOR CONSTRUCTION                    | 8/20/92 | RCH   | CRD   | CRD        | JJC        |
| A         | ISSUED FOR BID                             | 4/20/92 | JH    | CLS   | CRD        | JJC        |
| Issue No. | Description                                | Date    | Drawn | Chkd. | Res. Engr. | Proj. Mgr. |

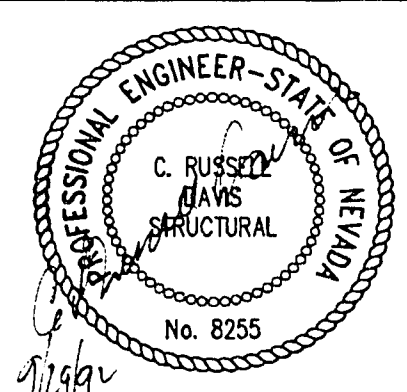

|                 |               |
|-----------------|---------------|
| Project Manager | JOHN J. CHUEH |
| Architect       |               |
| Civil           |               |
| Electrical      |               |
| Mechanical      |               |
| Structural      | R. DAVIS      |
| Drawn By        | J. HIRSHOUER  |

City of Las Vegas  
Water Pollution Control Facility  
Nitrification / Filtration Facilities  
Contract 17  
NITRIFICATION COMPLEX

CENTRIFUGE BUILDING  
MASONRY ELEVATIONS

|       |              |             |               |             |       |       |   |
|-------|--------------|-------------|---------------|-------------|-------|-------|---|
| Date  | APRIL 1992   | Project No. | 00120-084-141 | Drawing No. | S-504 | Issue | 1 |
| Scale | 1/4" = 1'-0" |             |               |             |       |       |   |