
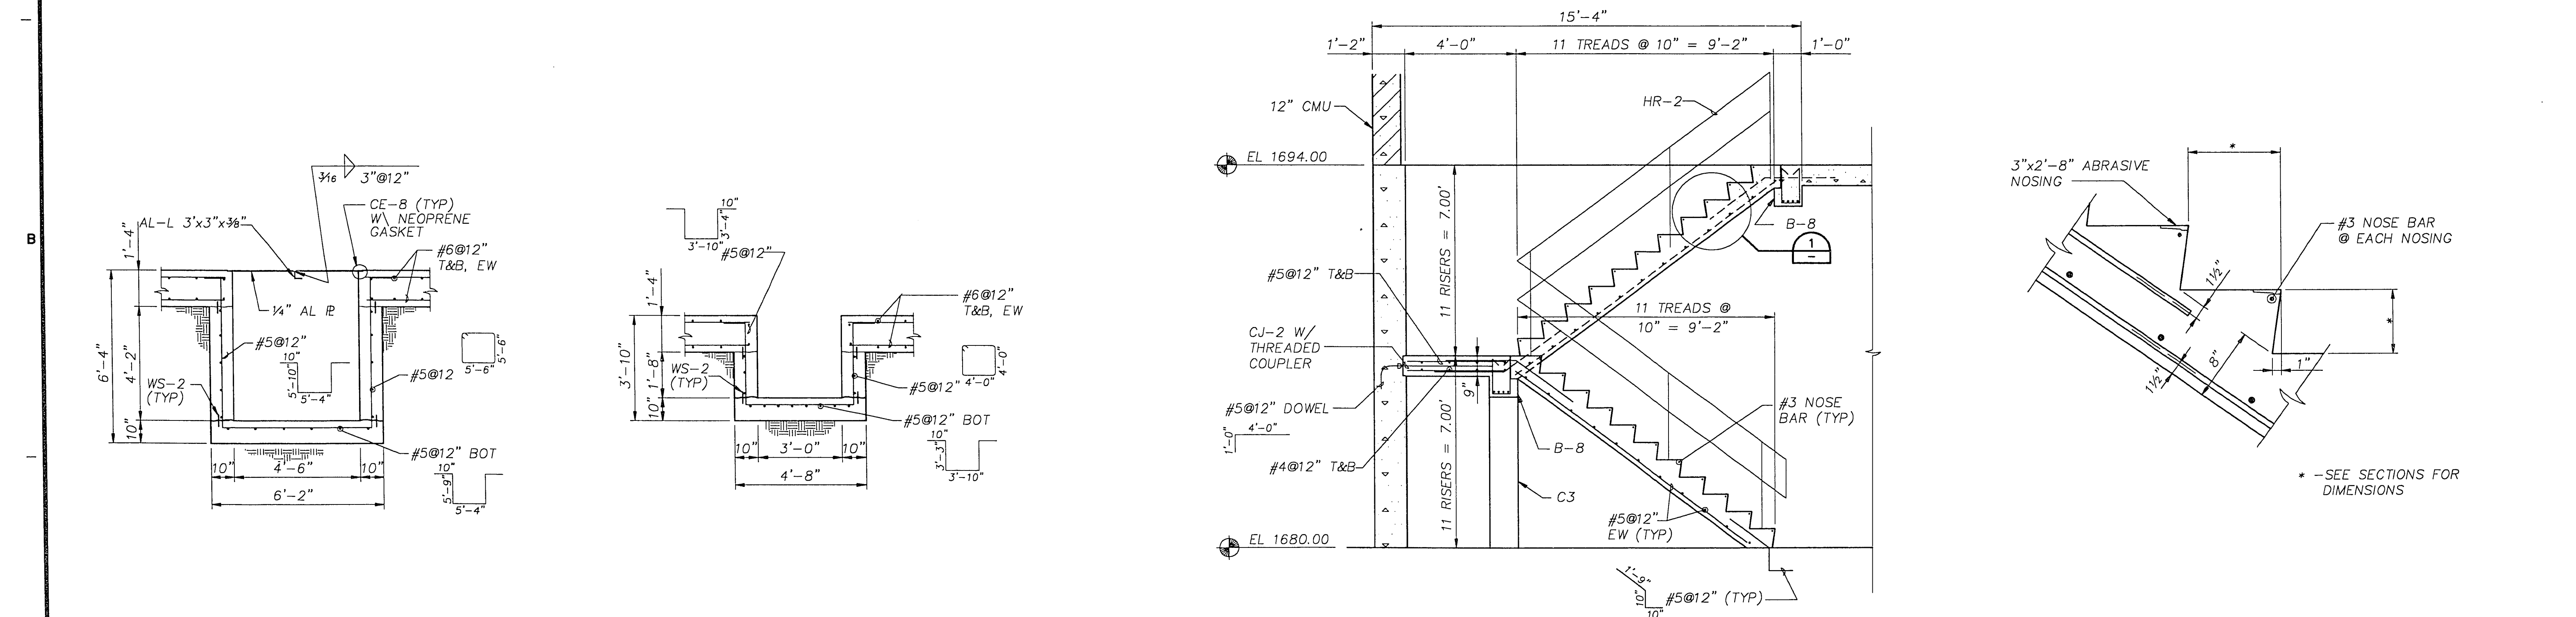


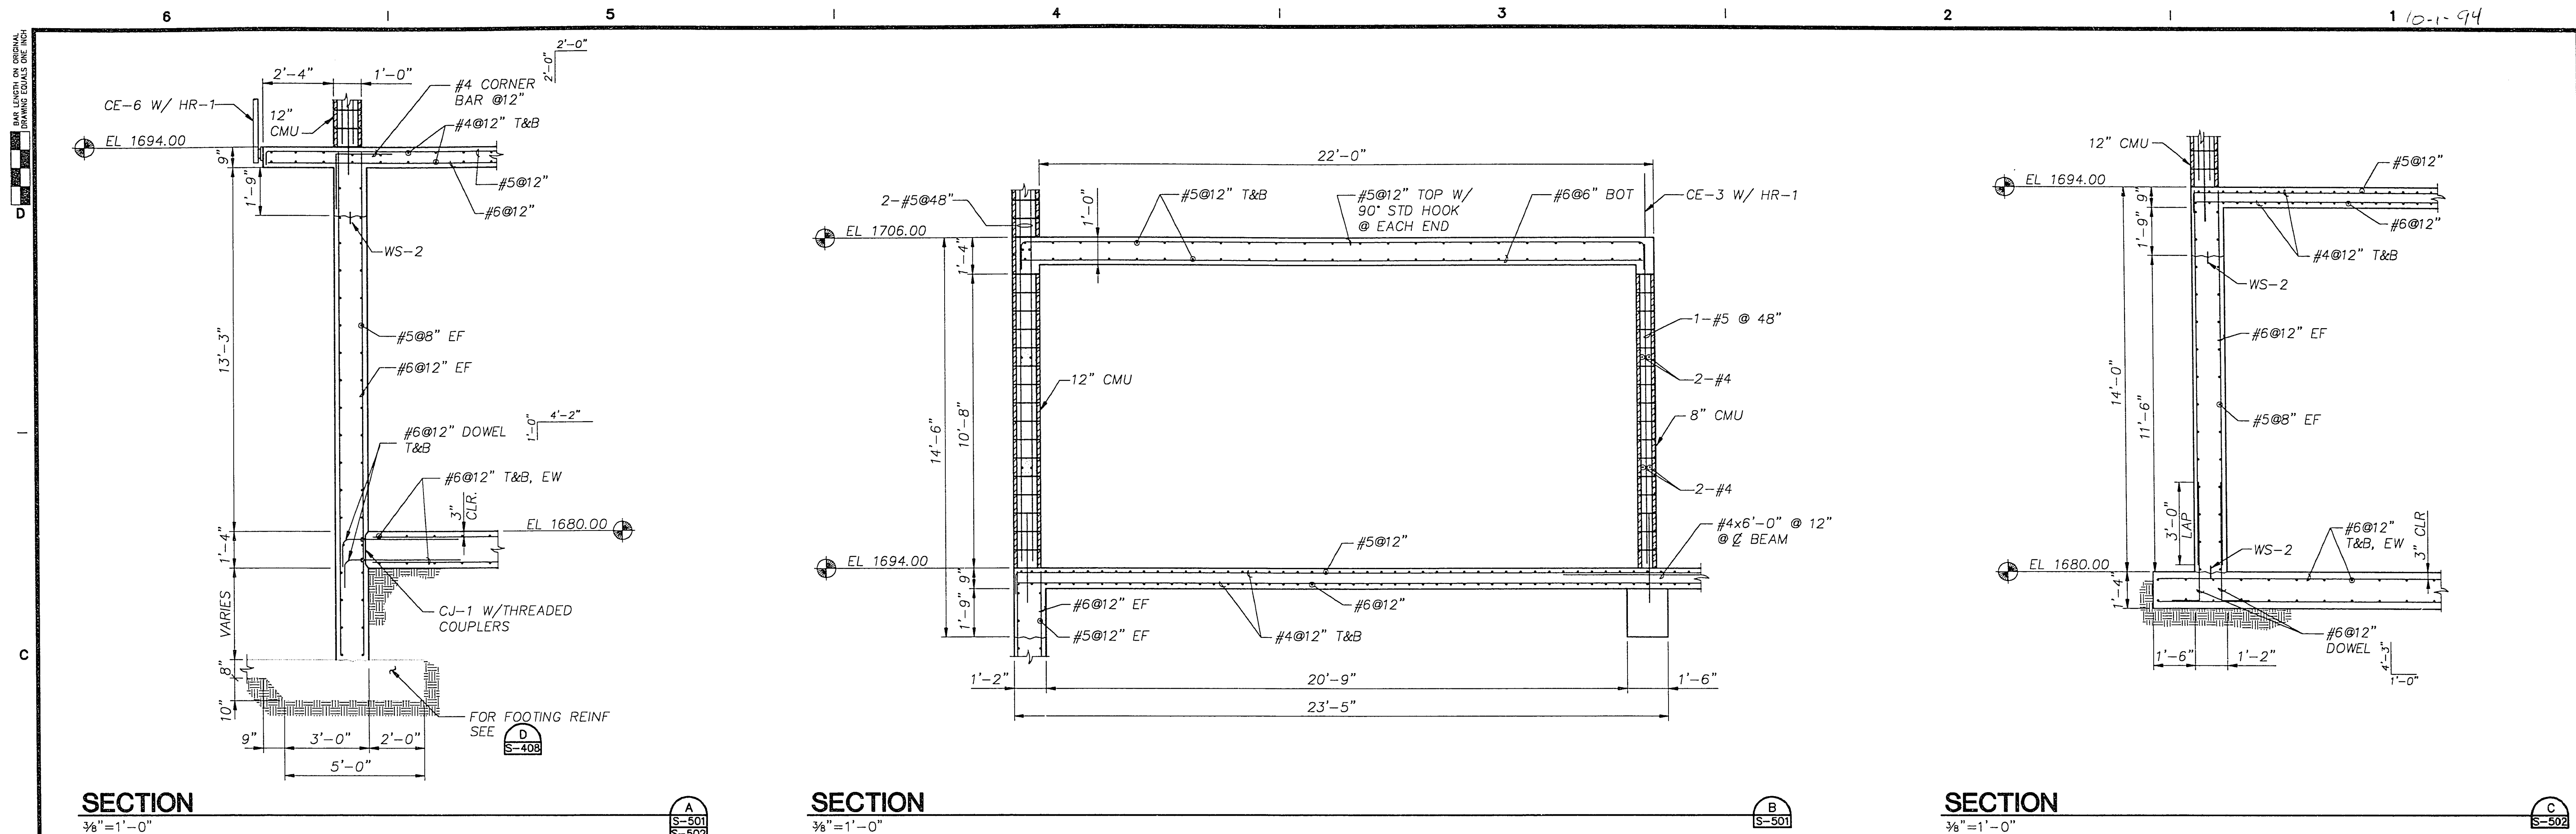

1	CORRECTED ACCORDING TO CONSTRUCTION RECORD	1/95	RRL	EFH	MJH	JJC
0	ISSUED FOR CONSTRUCTION	8/20/92	RCH	CRD	CRD	JJC
A	ISSUED FOR BID	4/20/92	JH	CLS	CRD	JJC
Issue No.	Description	Date	Drawn	Chkd.	Revis. Engr.	Proj. Mgr.

Project Manager
JOHN J. CHUEH

Architect
City of Las Vegas

Water Pollution Control Facility
Nitrification / Filtration Facilities

Contract 17
NITRIFICATION COMPLEX

CENTRIFUGE BUILDING

SECTIONS

Date APRIL 1992	Project No. 00120-084-141	Drawing No. S-508	Issue 1
Scale AS NOTED			