
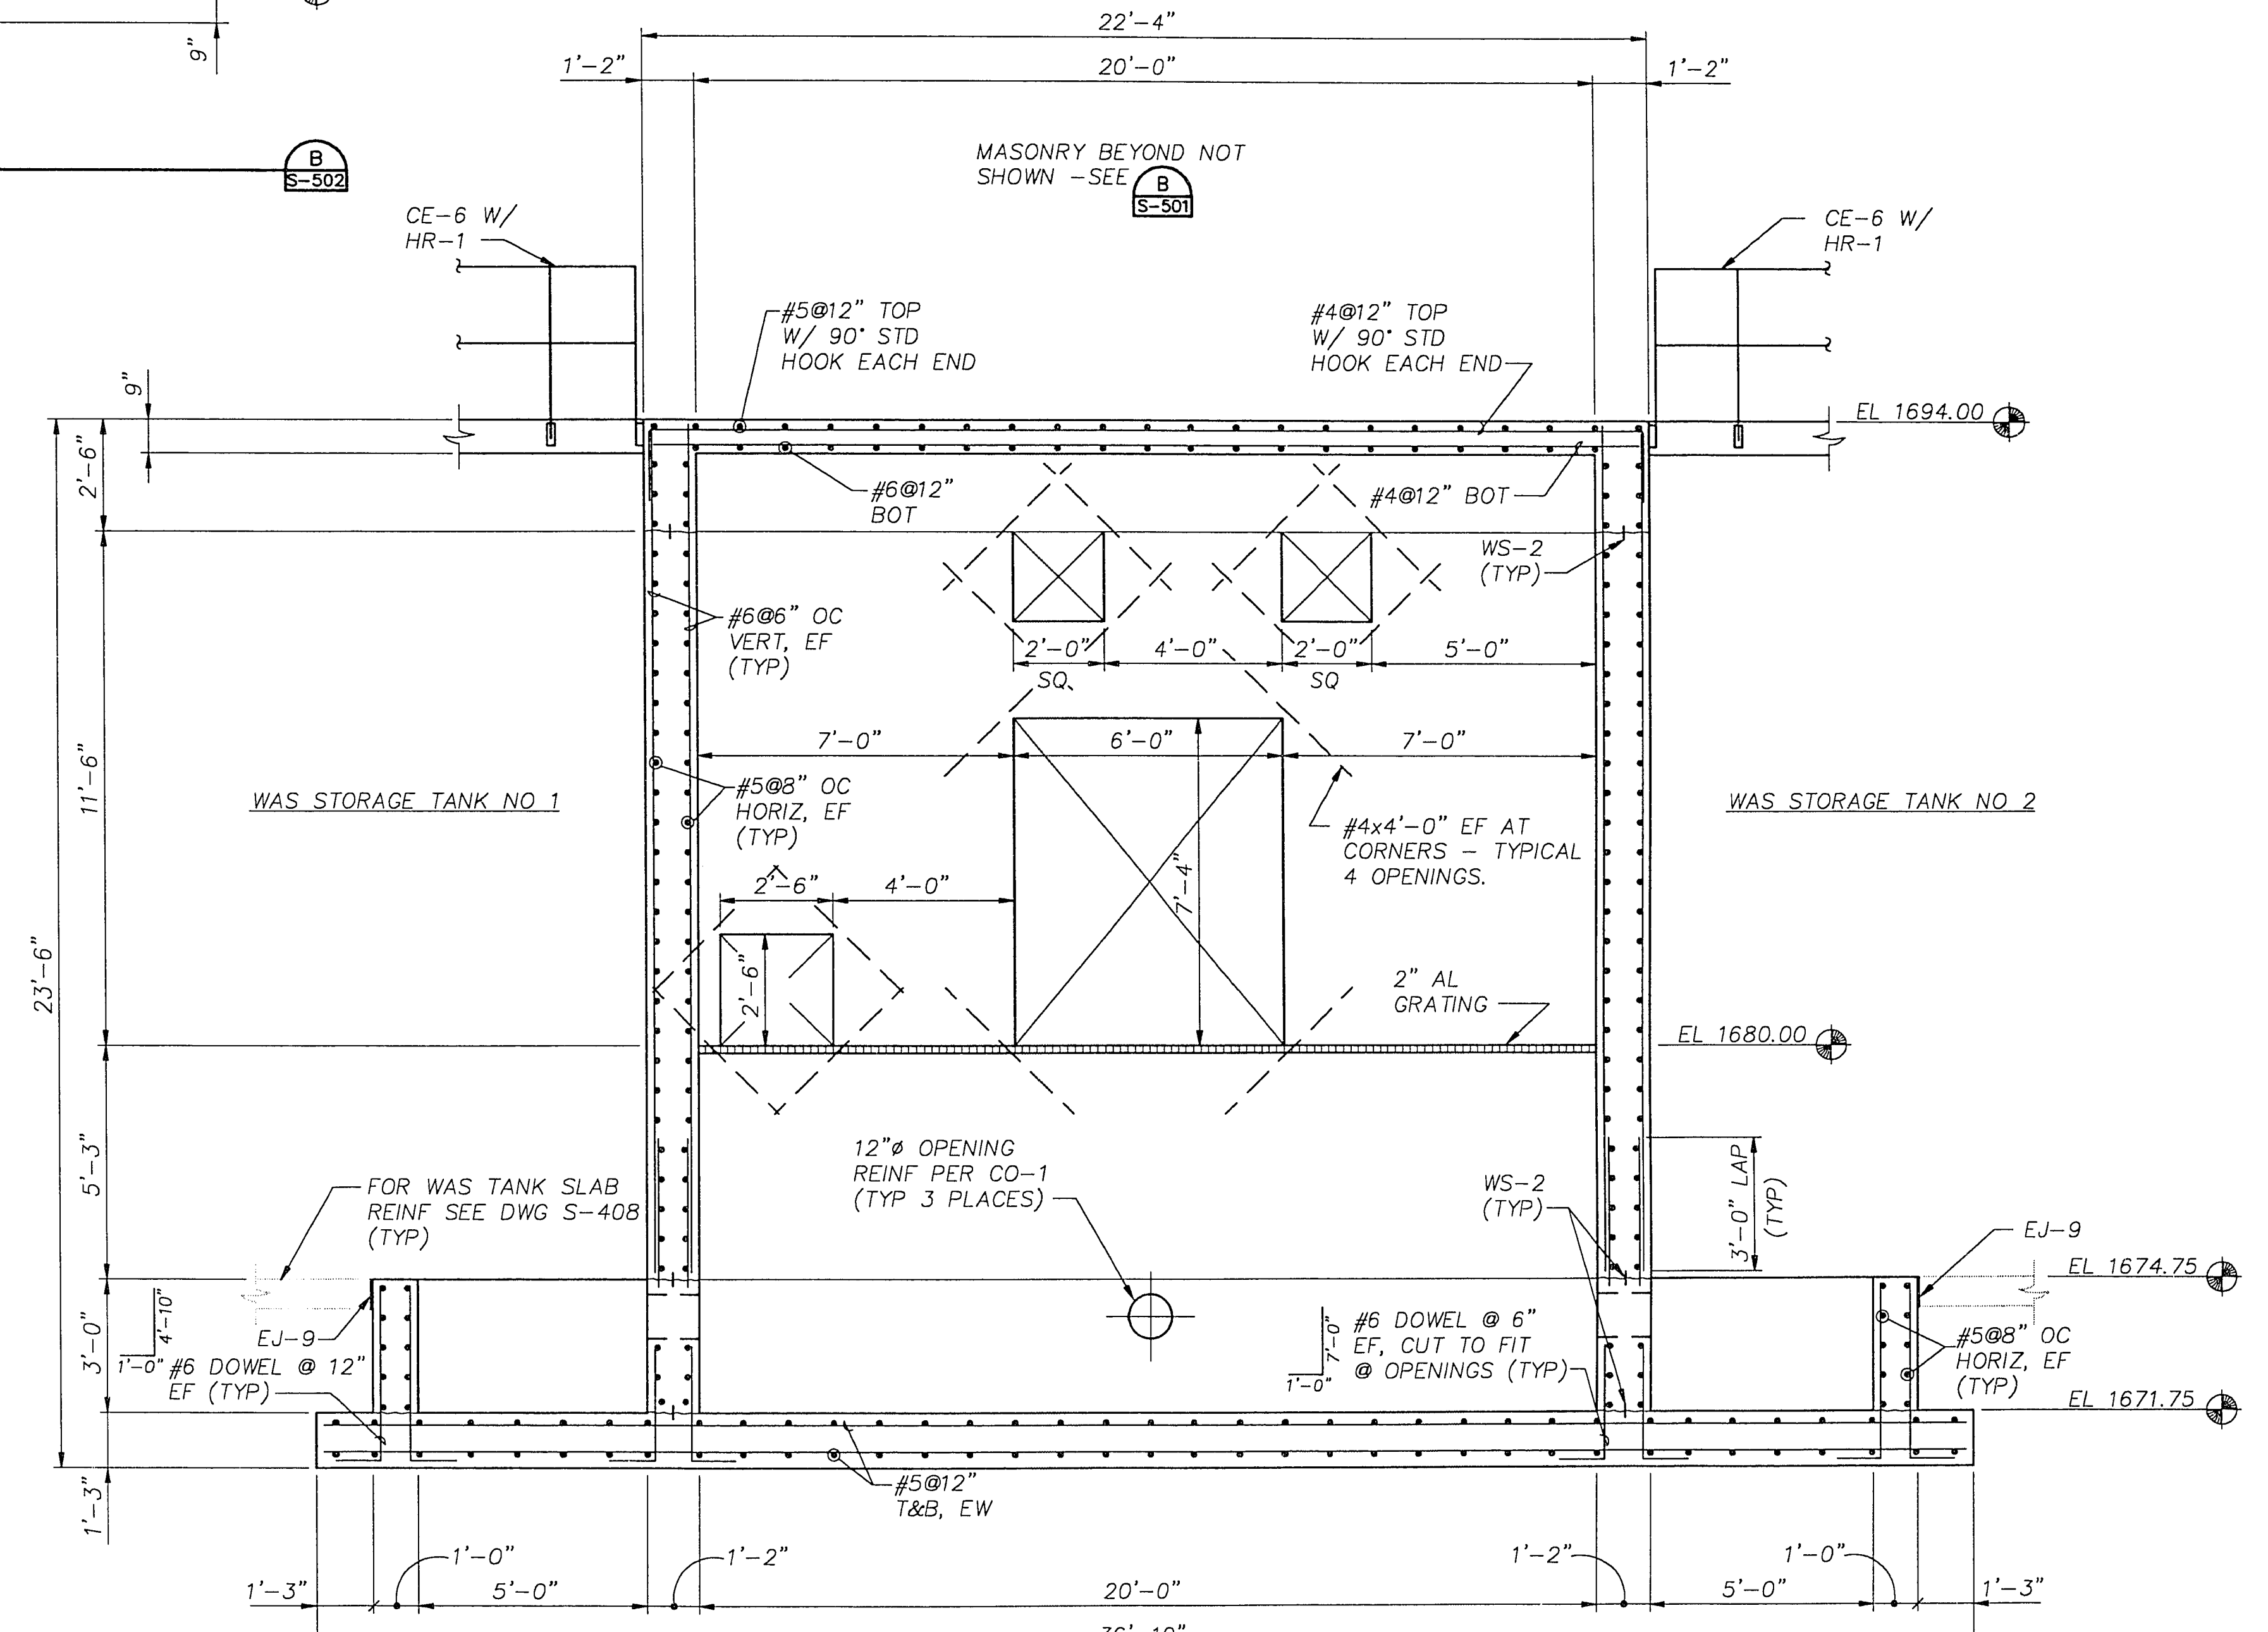
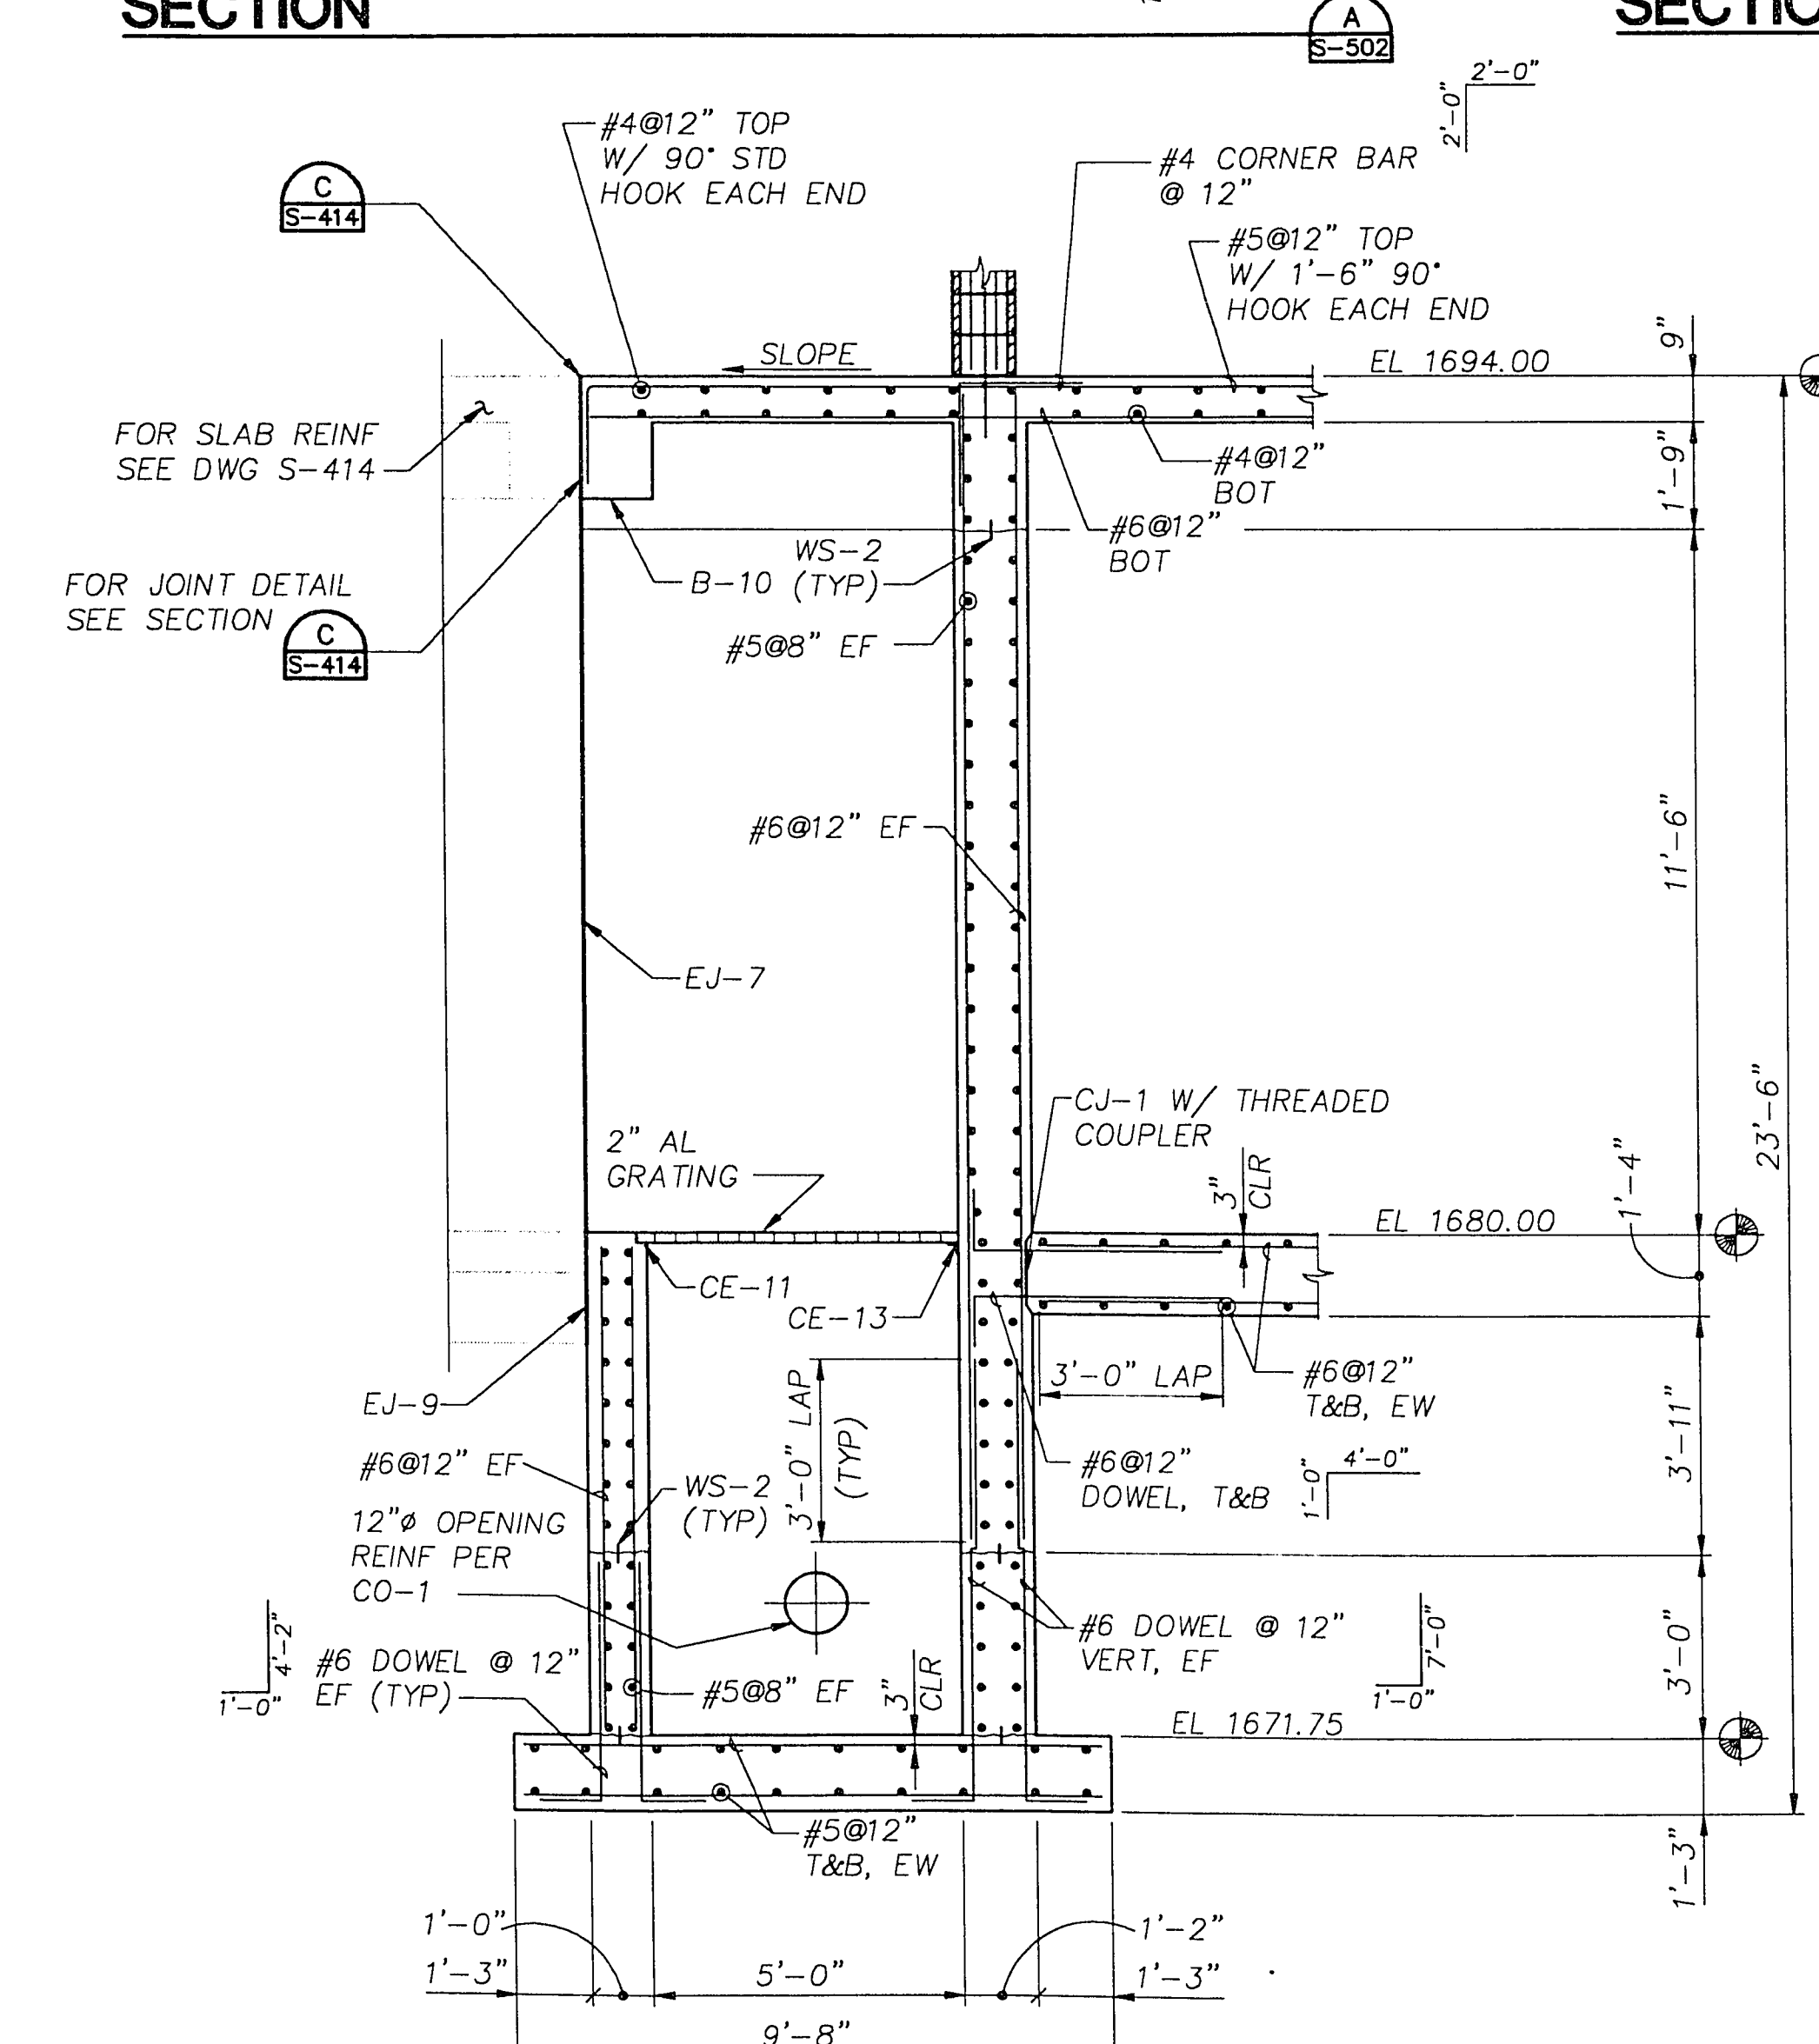
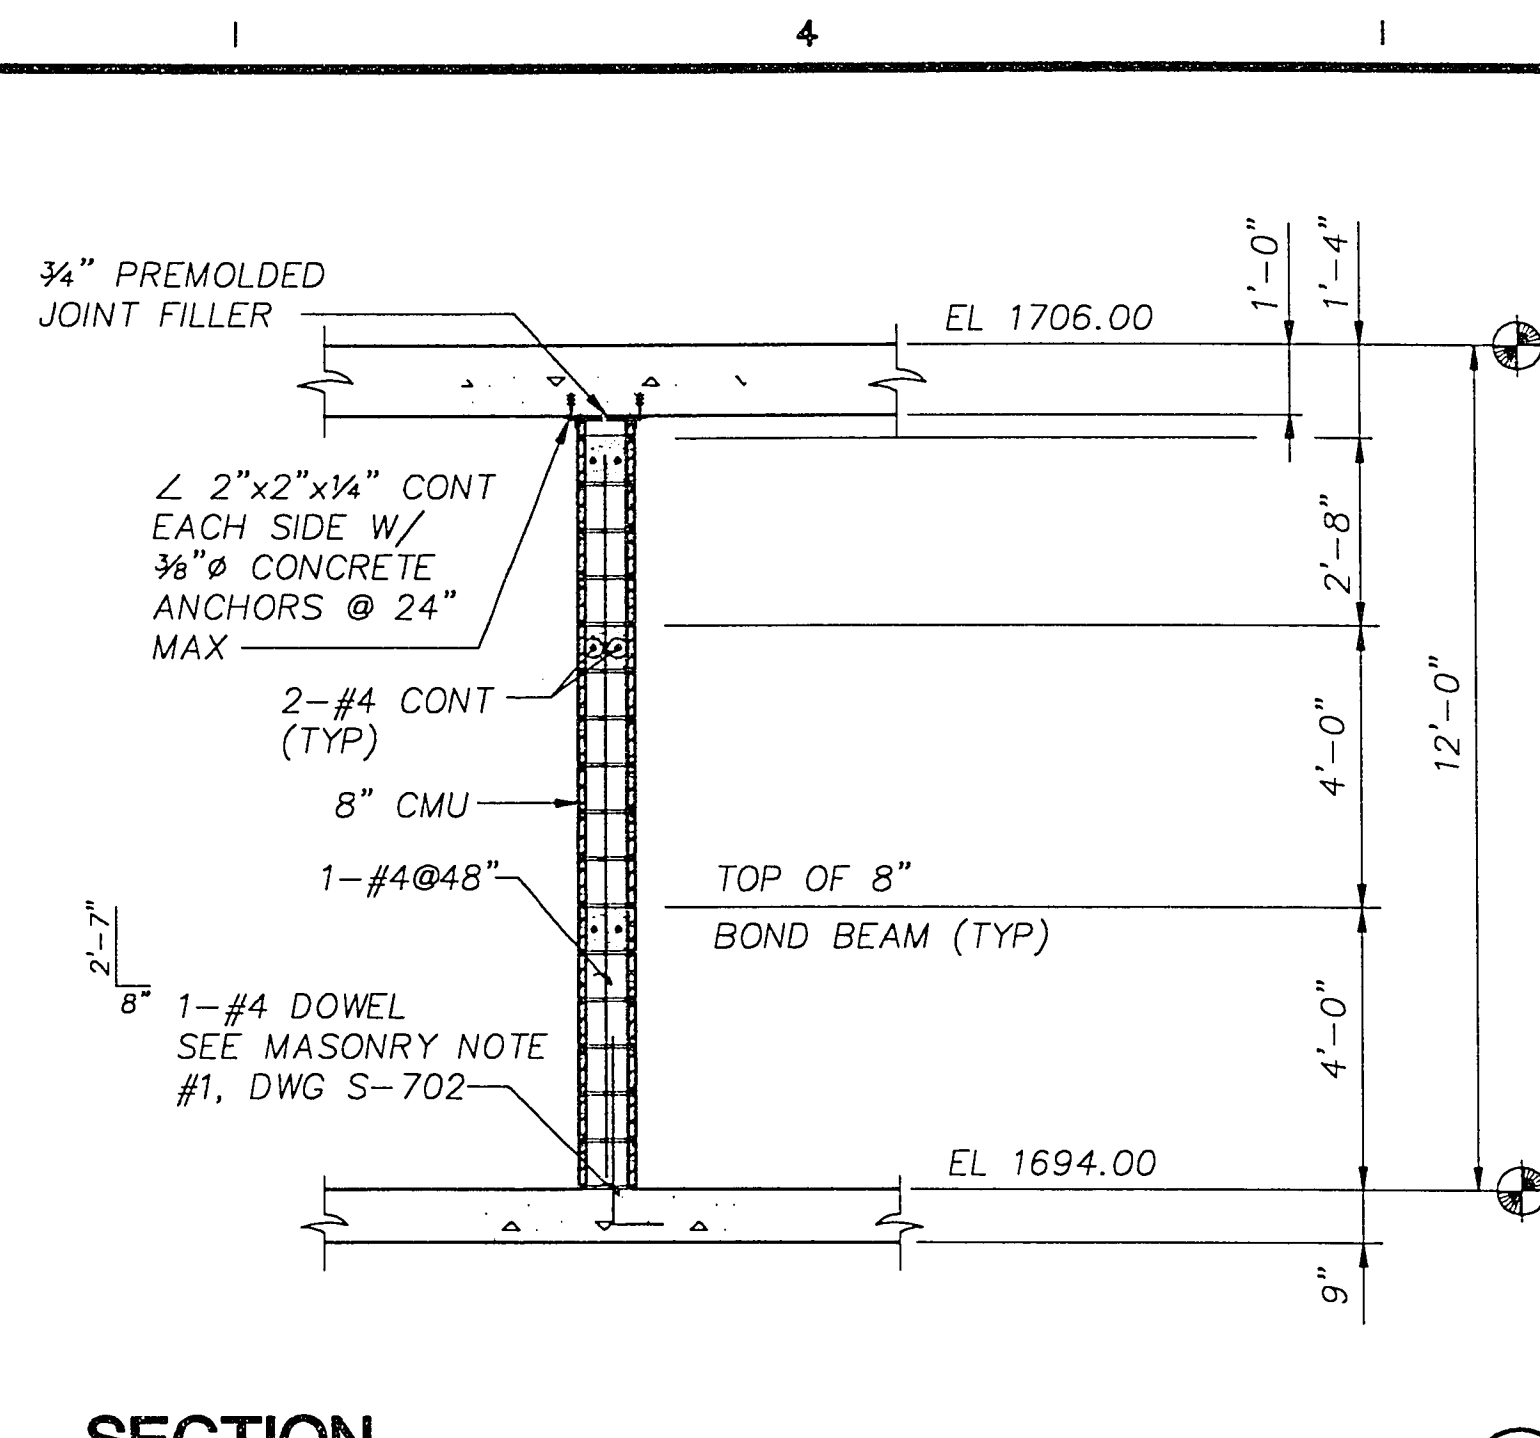
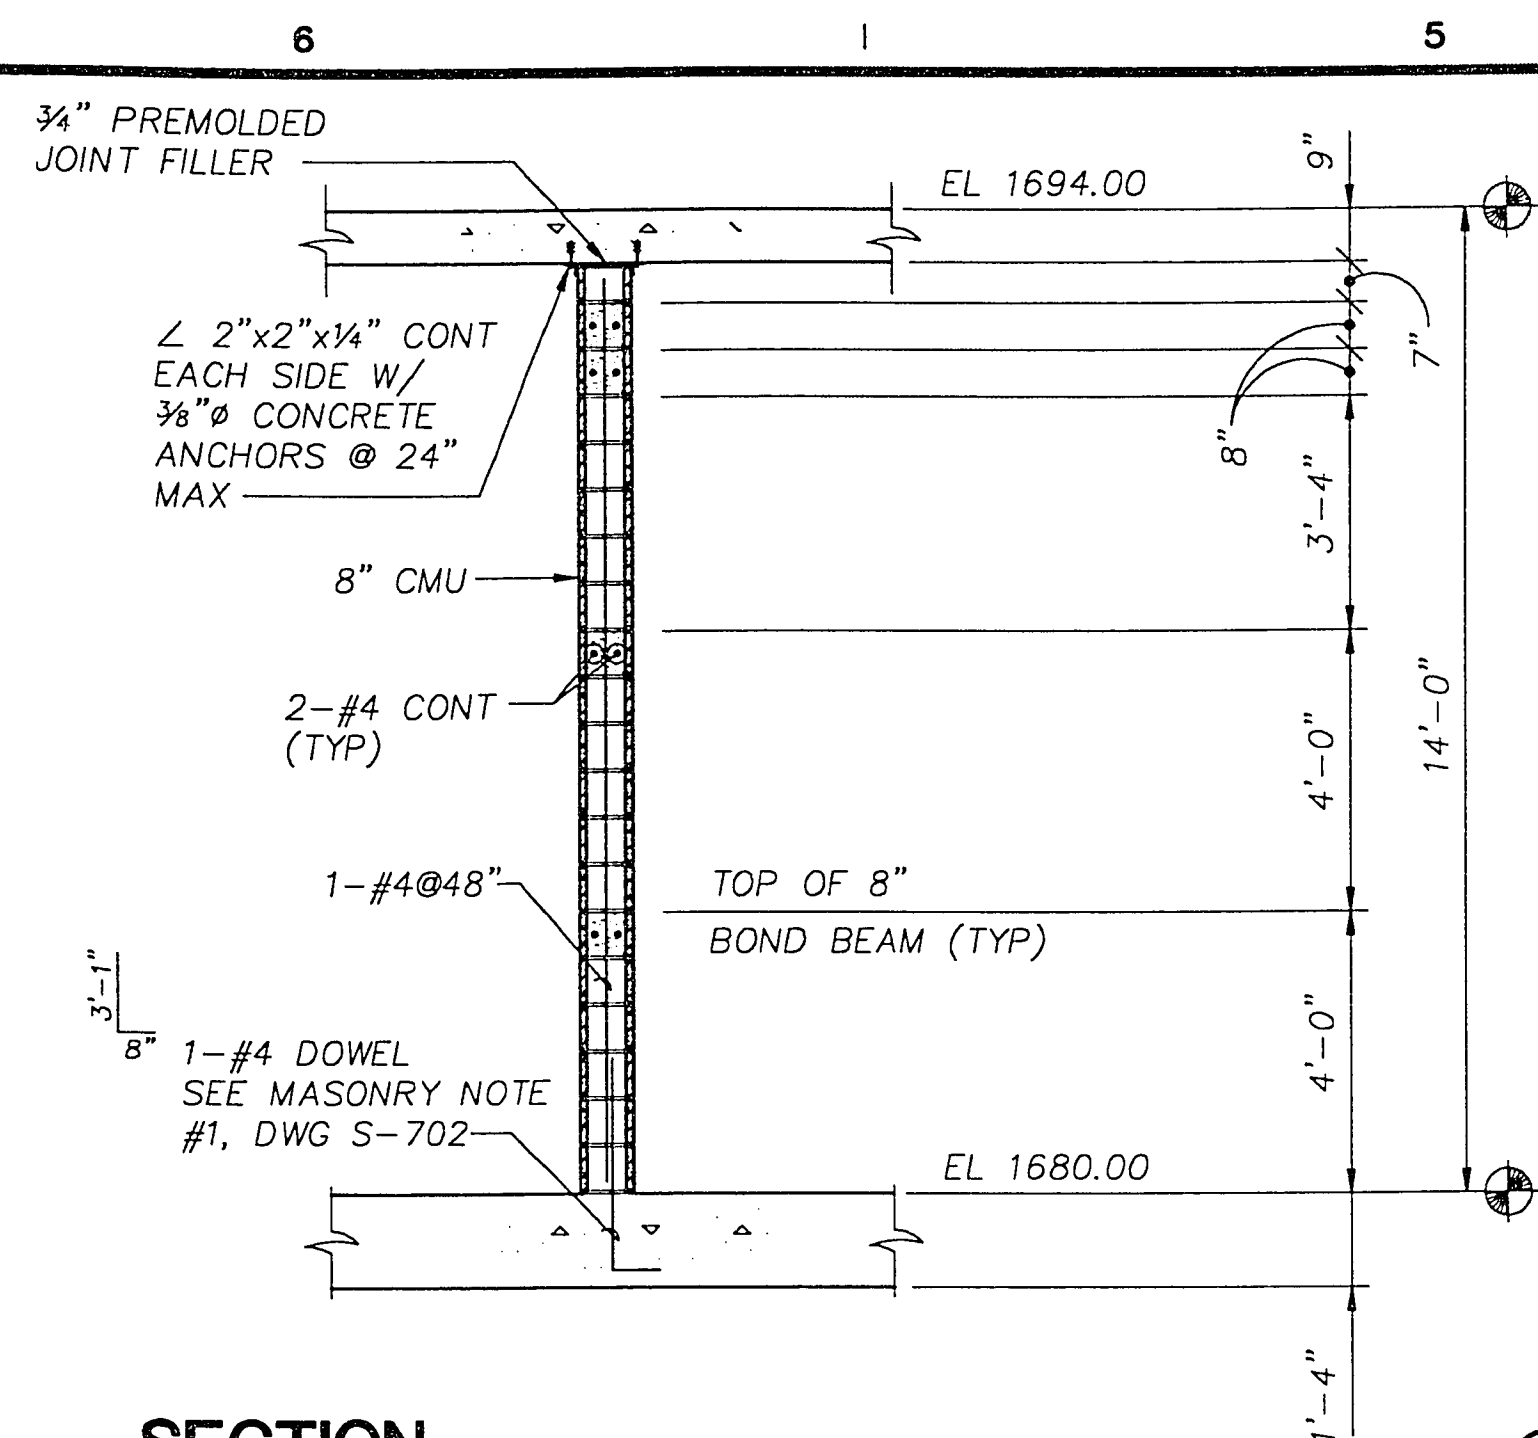


1	CORRECTED ACCORDING TO CONSTRUCTION RECORD	1/95	RRL	EFH	MJH	JJC			
O	ISSUED FOR CONSTRUCTION	8/20/92	RCH	CRD	CRD	JJC			
A	ISSUED TO BID	4/20/92	JH	CLS	CRD	JJC			
Issue No.	Description	Date	Dwn.	Chcd.	Resp. Engr.	Proj. Mgr.			

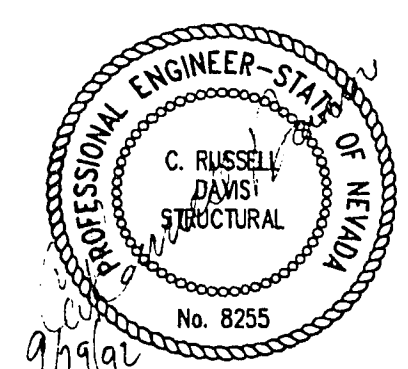

Project Manager	
JOHN J. CHUEH	
Architect	I&C/Process
Civil	Mechanical
Electrical	Structural
	R. DAVIS
	Drawn By
	J. HIRSHOUVER

City of Las Vegas
Water Pollution Control Facility
Nitrification / Filtration Facilities
Contract 17
NITRIFICATION COMPLEX

CENTRIFUGE BUILDING SECTIONS

Date <i>APRIL 1992</i>	Project No. 00120-084-141	Drawing No. S-509	Issue 1
Scale <i>3/8" = 1'-0"</i>			