


5532.0310

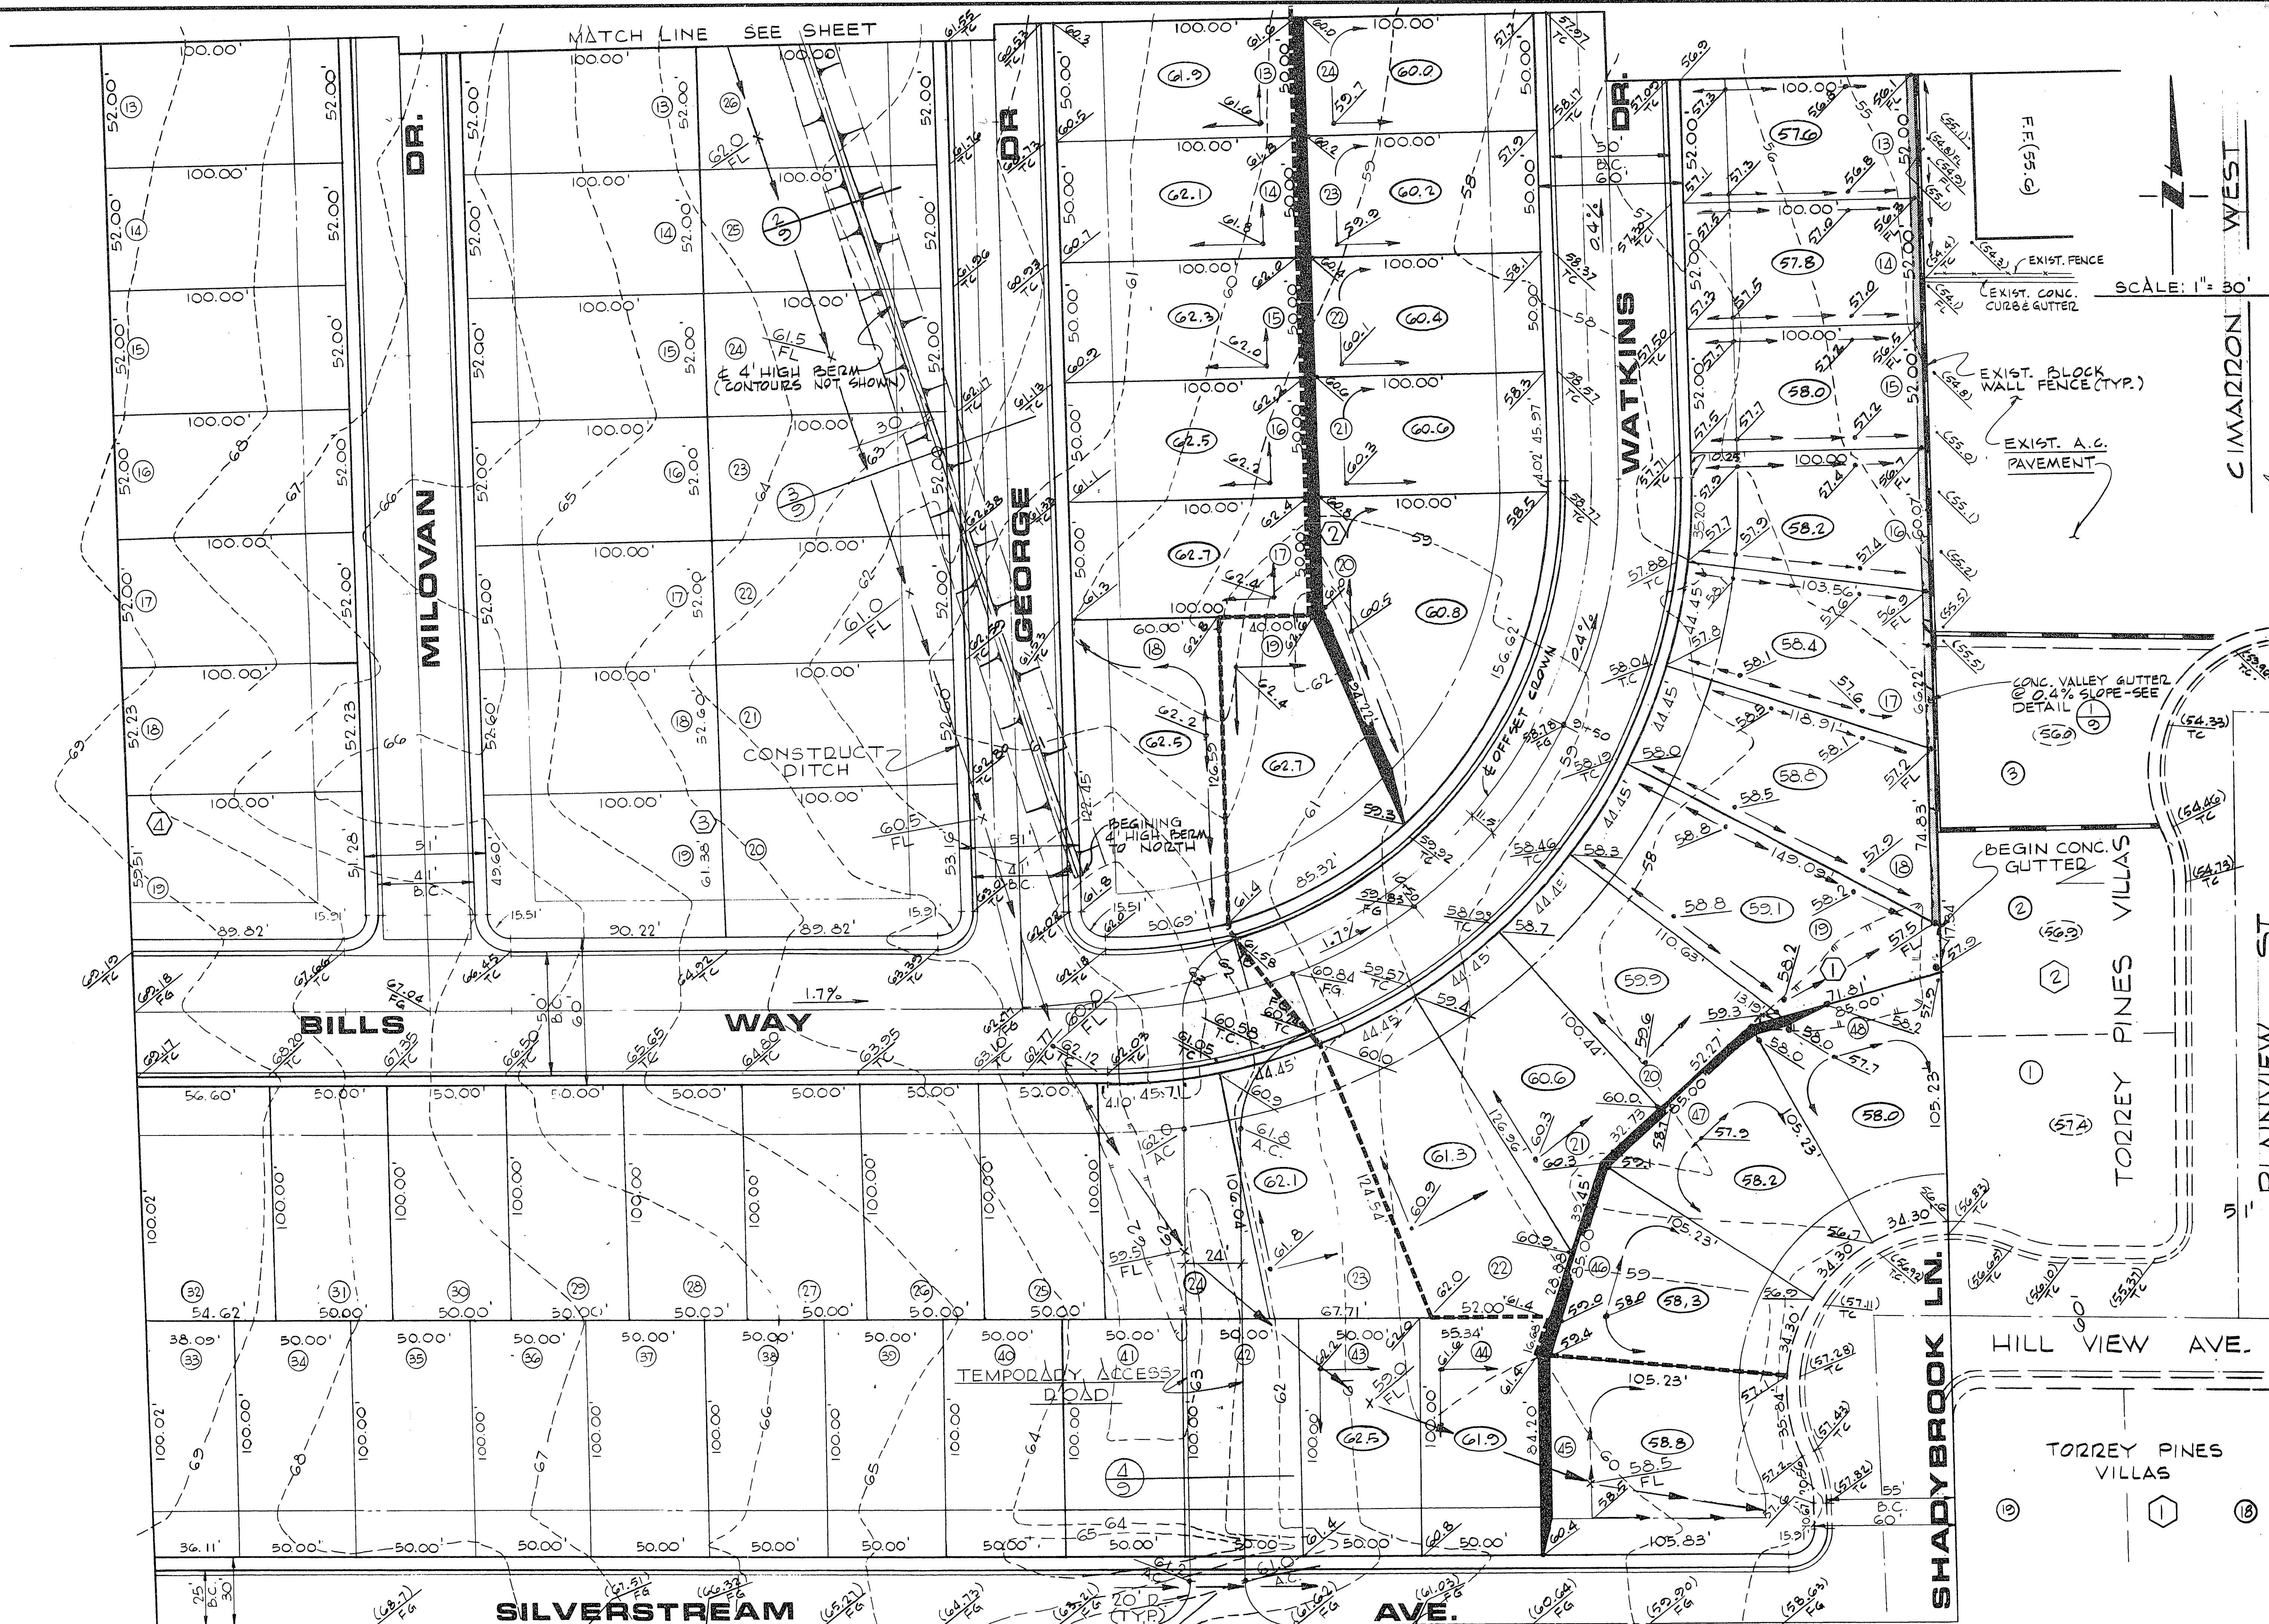

RECOMMENDED DATE 12/15/2015 BY G. C. WALLACE		DESCRIPTION EXIST. DEV. GRADES ADDED DITCH ALONG WEST SIDE
WATKINS DEVELOPMENT CO. WATKINS MANOR NO. 1 GRADING PLAN II		WALLACE - MONTGOMERY, A JOINT VENTURE G. C. WALLACE, Consulting Engineer MONTGOMERY ENGINEERS OF NEVADA 735-7158 LAS VEGAS, NEVADA
SHEET 10 OF 10 SHEETS		

2-9-63

107Y-3277-1

