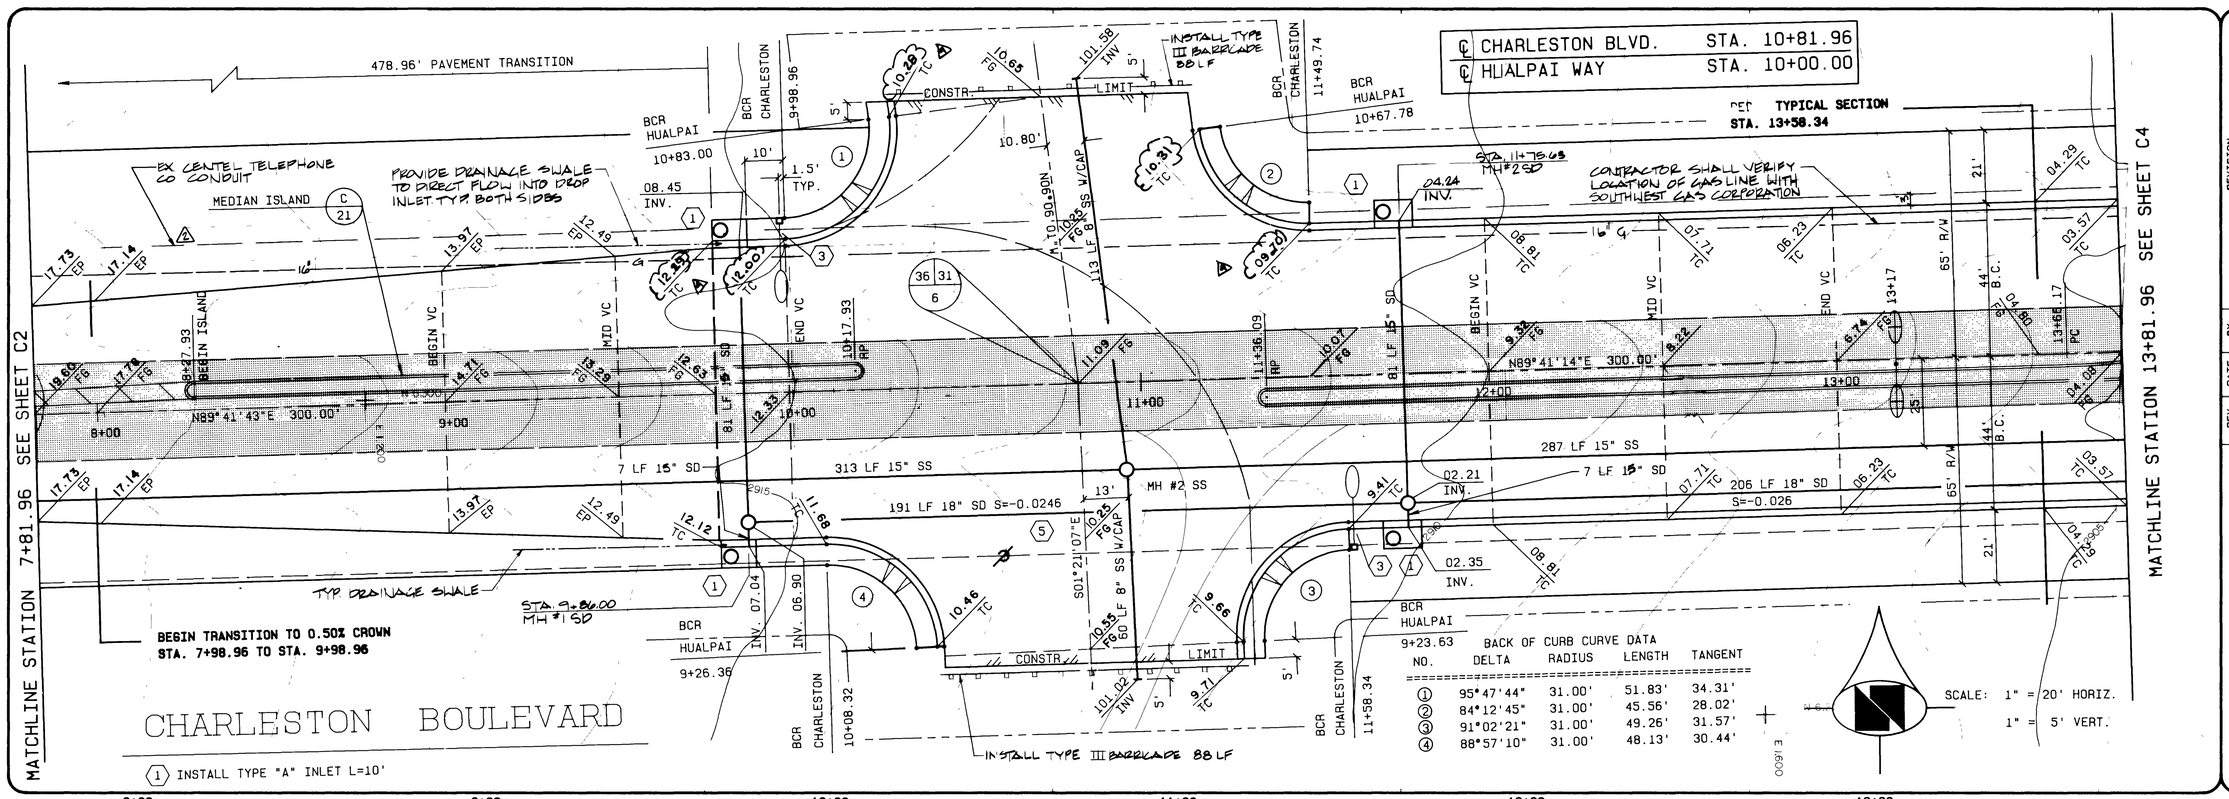

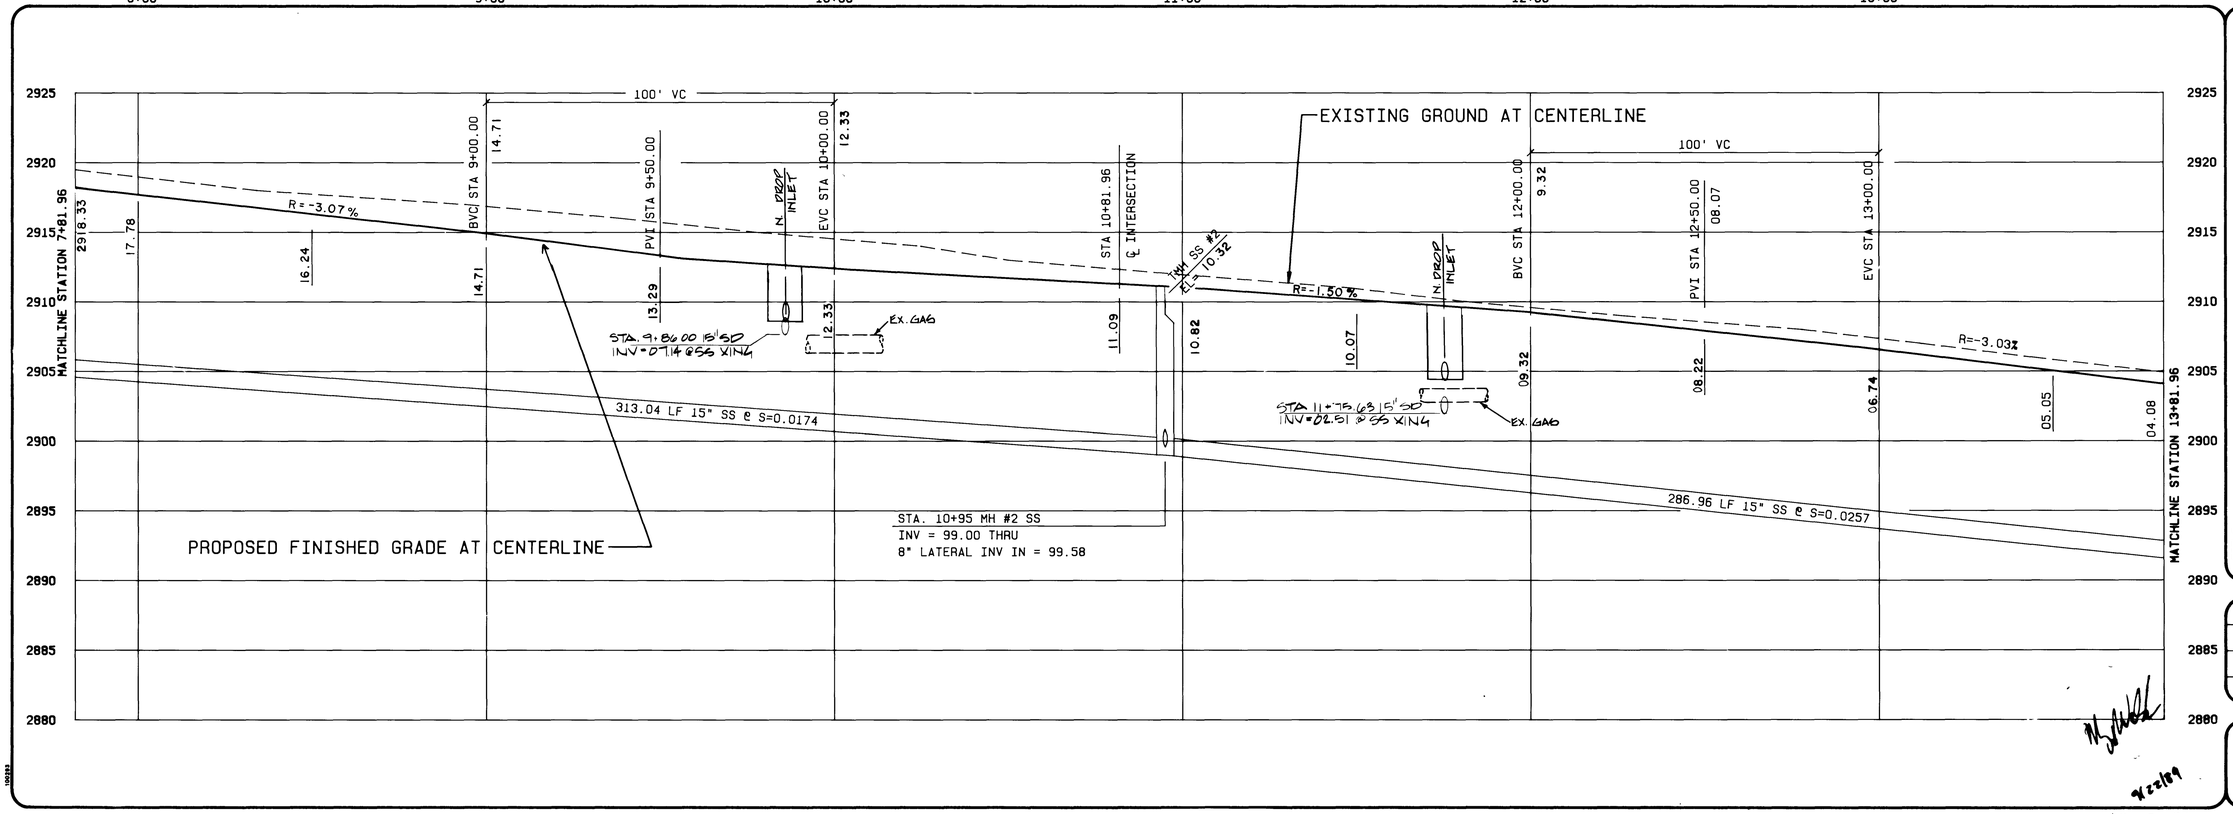

REV	DATE	BY	REVISION
4	10/8/90	MW	REV GRADES TO MATCH COUST.
3	10/4/90	DP	REV. GRADES
2	3/28/90	RBB	ADD CENTEL CONDUIT W/NOTE
1	10/16/89	RBB	REV PER ADD'L GAS LINE & NOTE

ENGINEER'S STAMP

DATE

NAME

vtn nevada

CONSULTING ENGINEERS – PLANNERS
2300 PASEO DEL PRADO BUILDING A SUITE 100
LAS VEGAS, NEVADA 89102 PHONE (702) 873-7550

TITLE: STA. 7+81.96 TO STA. 13+81.96

PROJECT: WEST CHARLESTON BOULEVARD
HUALPAI WAY TO DURANGO DRIVE

WO NO.	3464
BY	MH / RB
DATE	09/25/89
SCALE	1" = 20' H. 1" = 5' V.

SHEET 4 C3 OF 29 SHEETS

P 6917

1857

15-3-1

107-V-1697

 

 

STA. 7+81.96 TO STA. 13+81.96

WEST CHARLESTON BOULEVARD

HUALPAI WAY TO DURANGO DRIVE

C3