



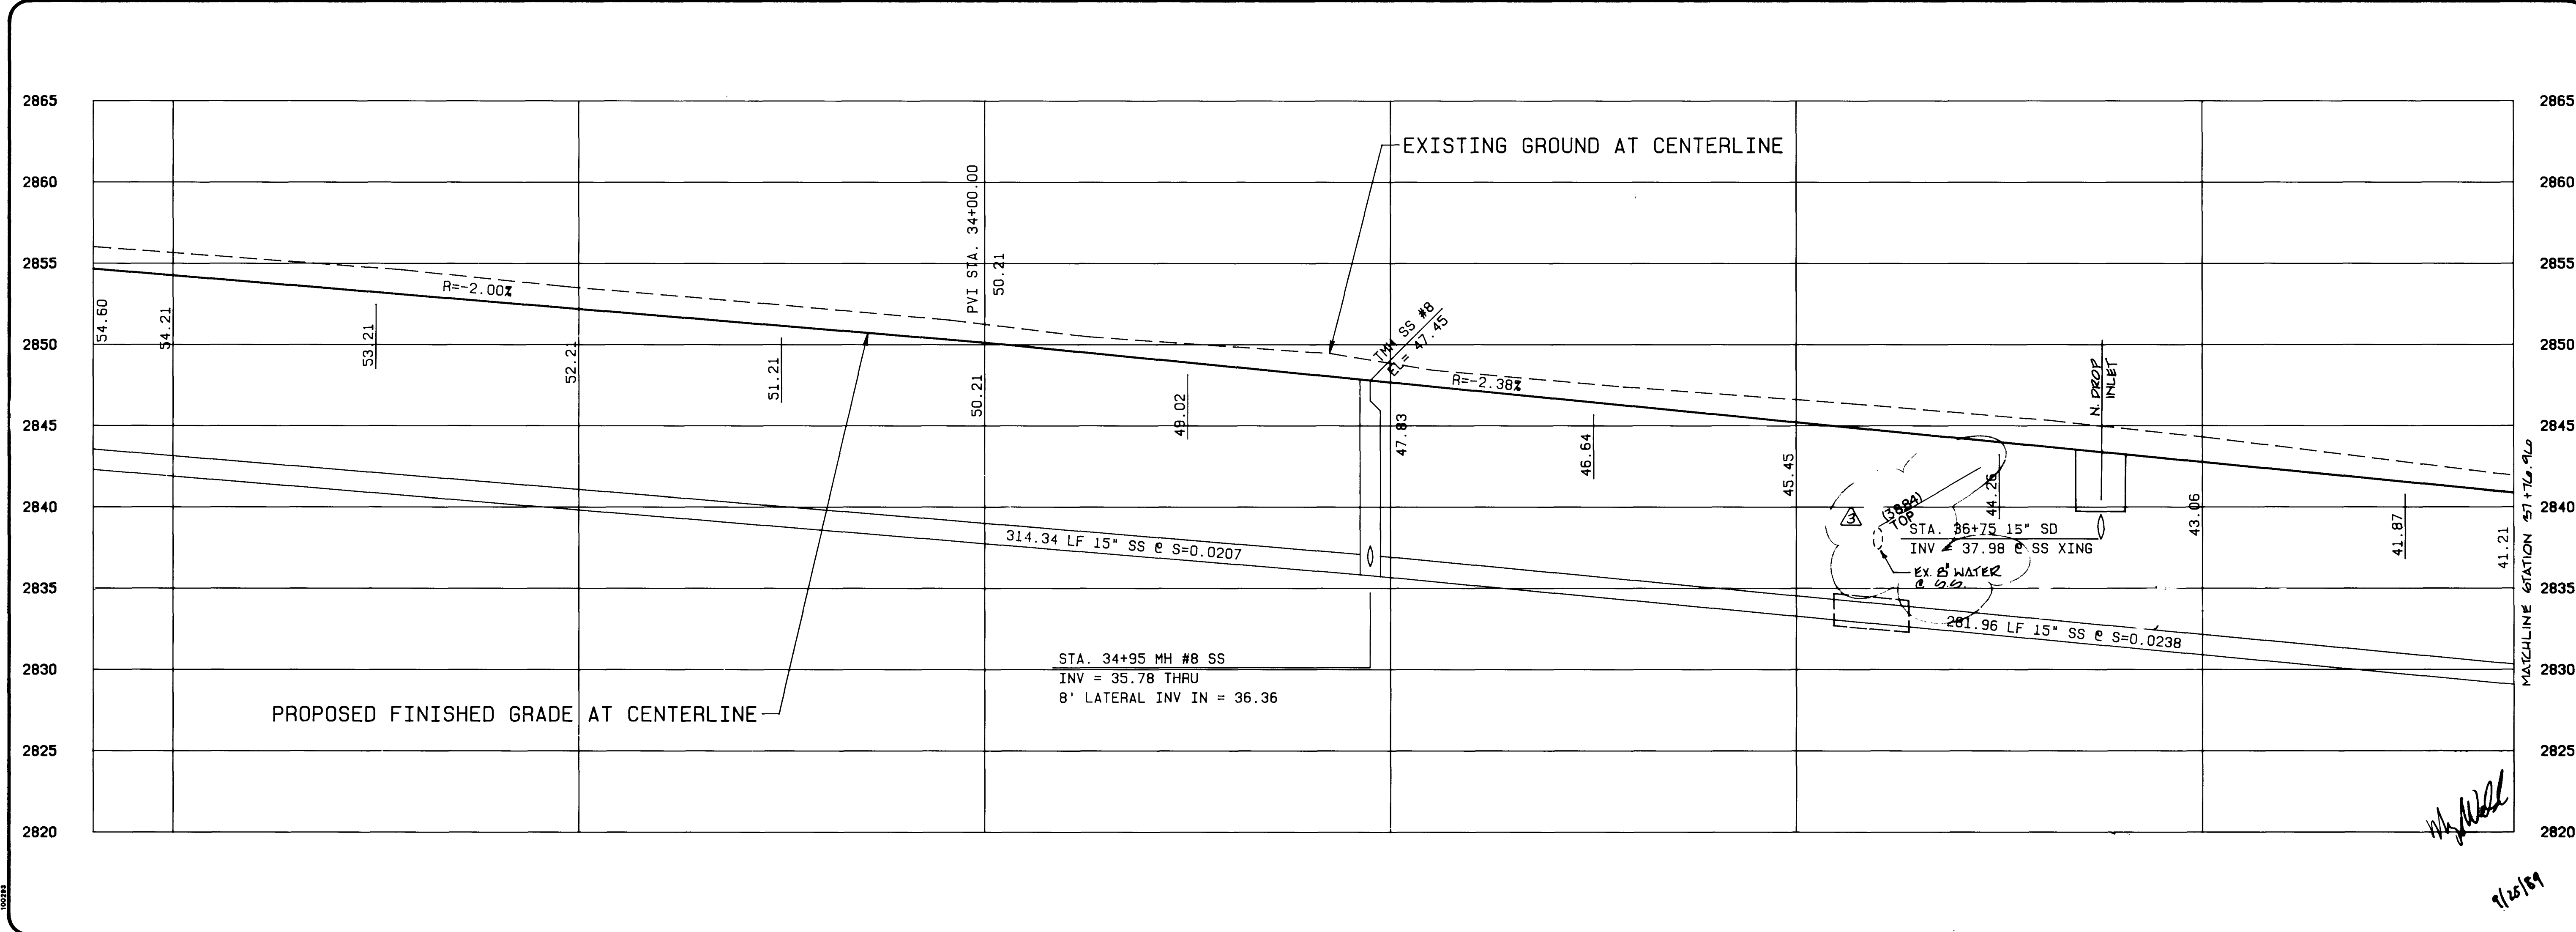

ENGINEER'S STAMP		NAME		DATE	
REVISION		BY		DATE	
REV		DATE		BY	
1		09/25/89		MH / RB	
2		09/25/89		09/25/89	
3		09/25/89		09/25/89	
TITLE		STA. 31+80.66 TO STA. 37+76.96	
PROJECT		WEST CHARLESTON BOULEVARD	
HUALPAI WAY TO DURANGO DRIVE			
NO. NO.		3464	
BY		MH / RB	
DATE		09/25/89	
SCALE		1" = 20' H. 1" = 5' V.	
SHEET		8	
OF		29 SHEETS	

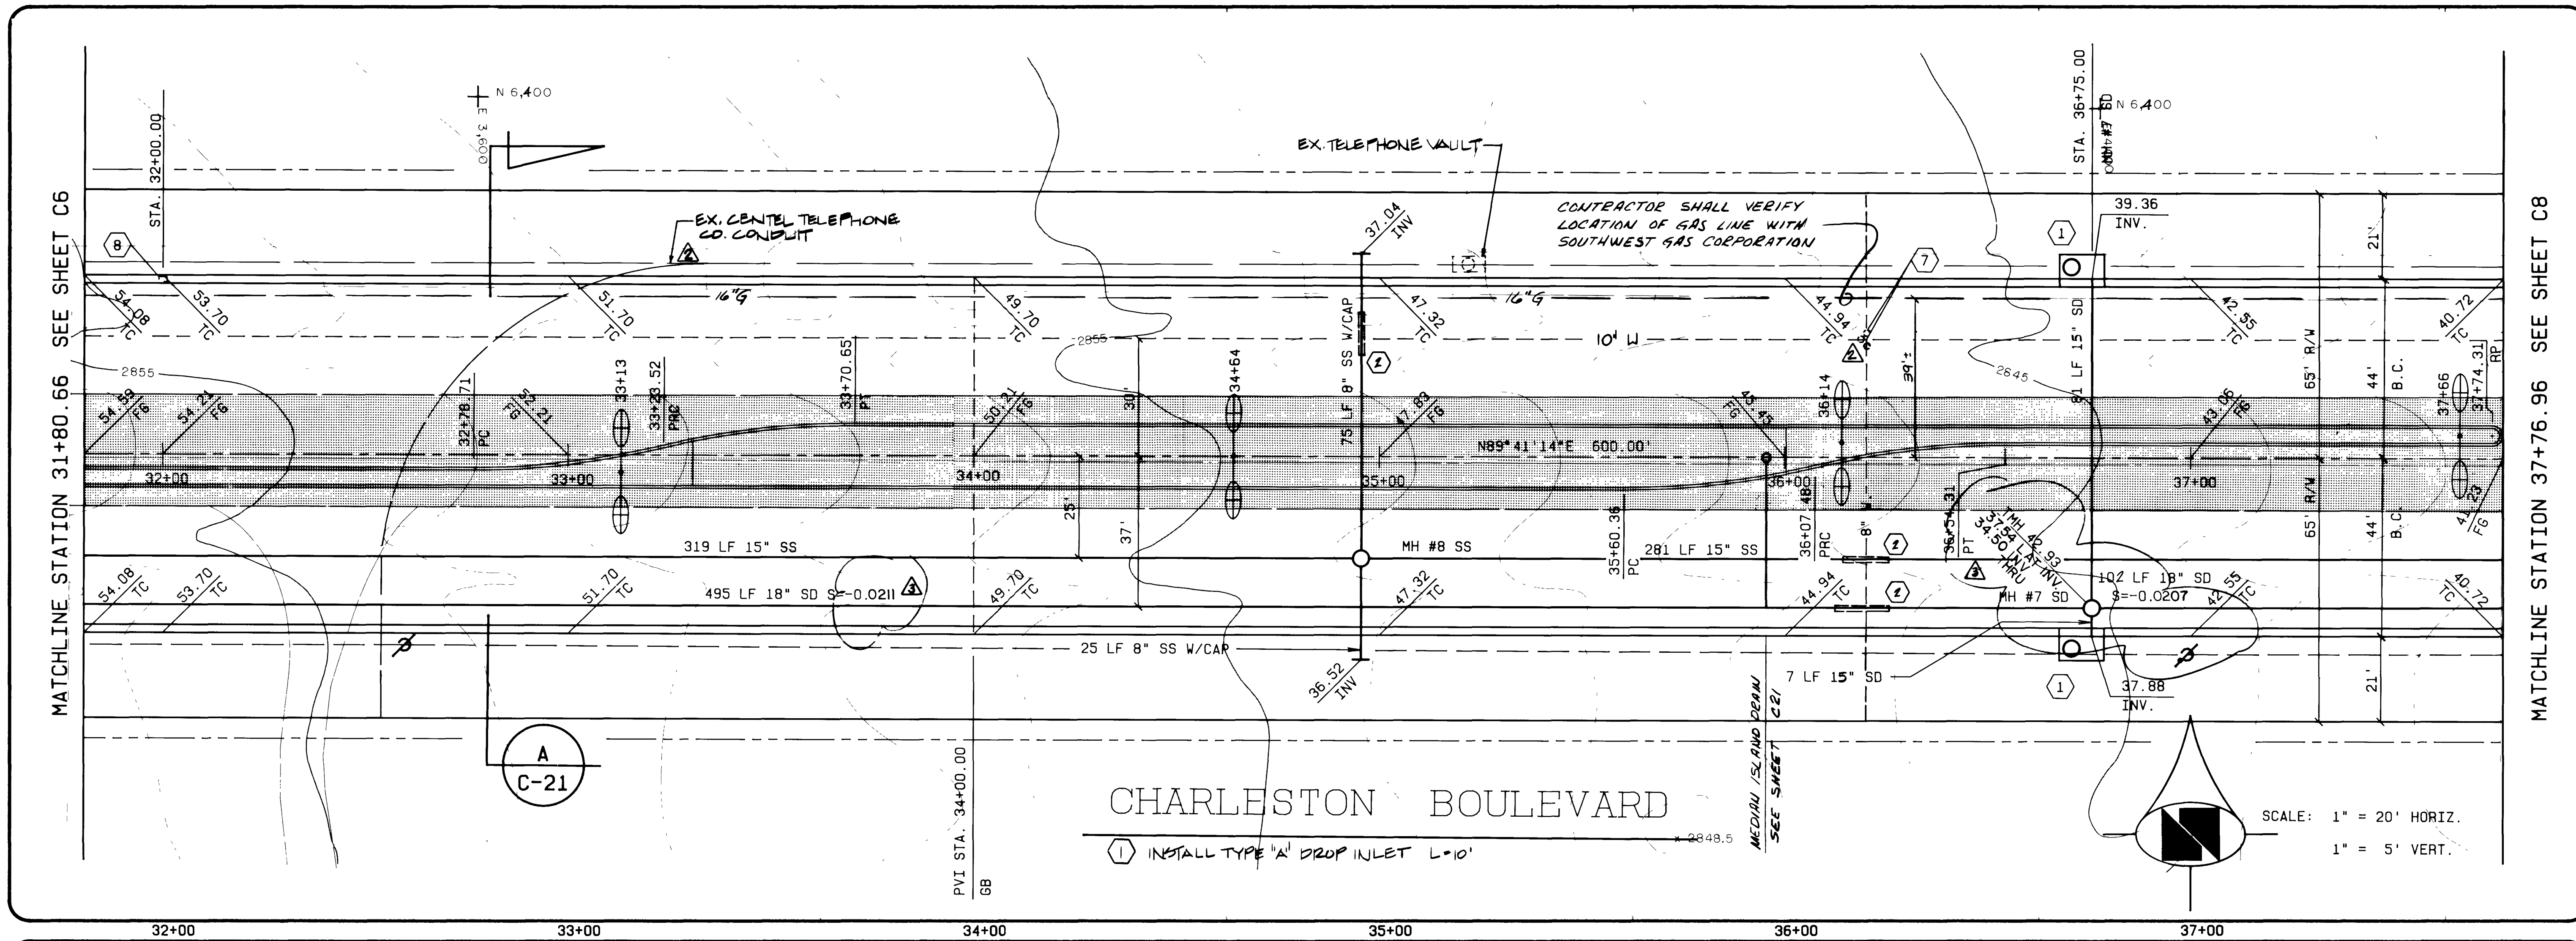