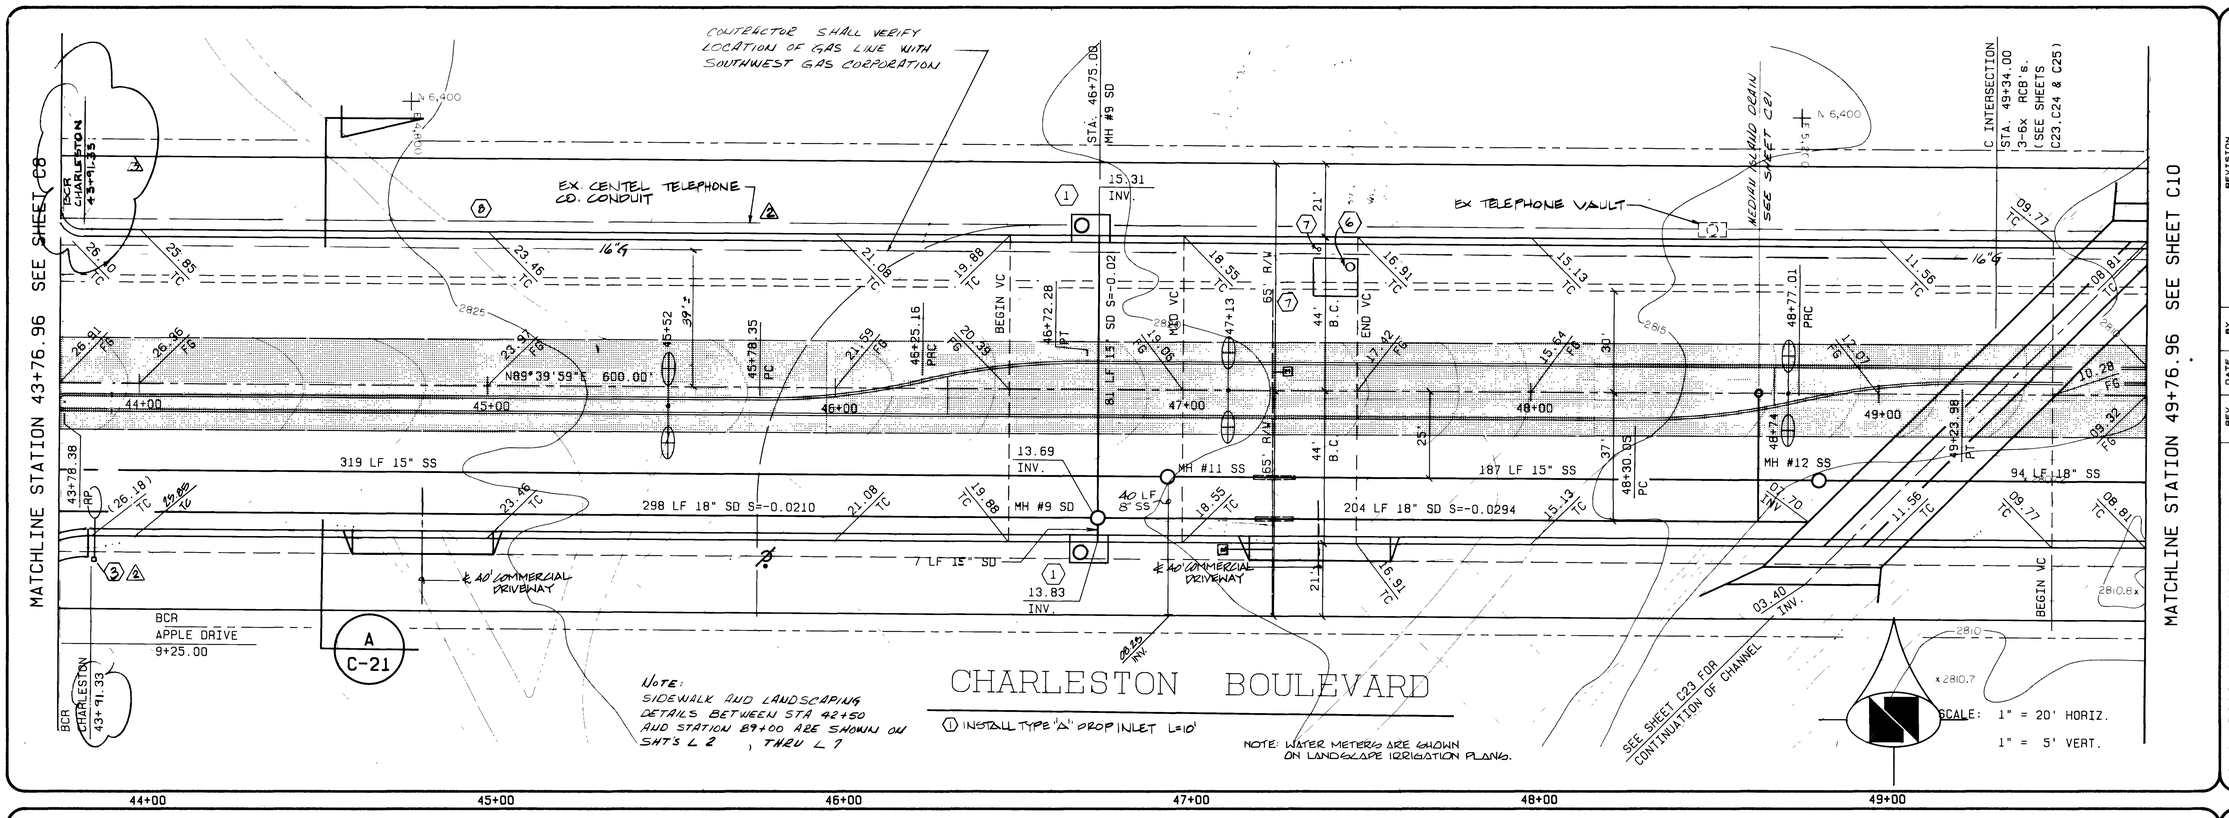

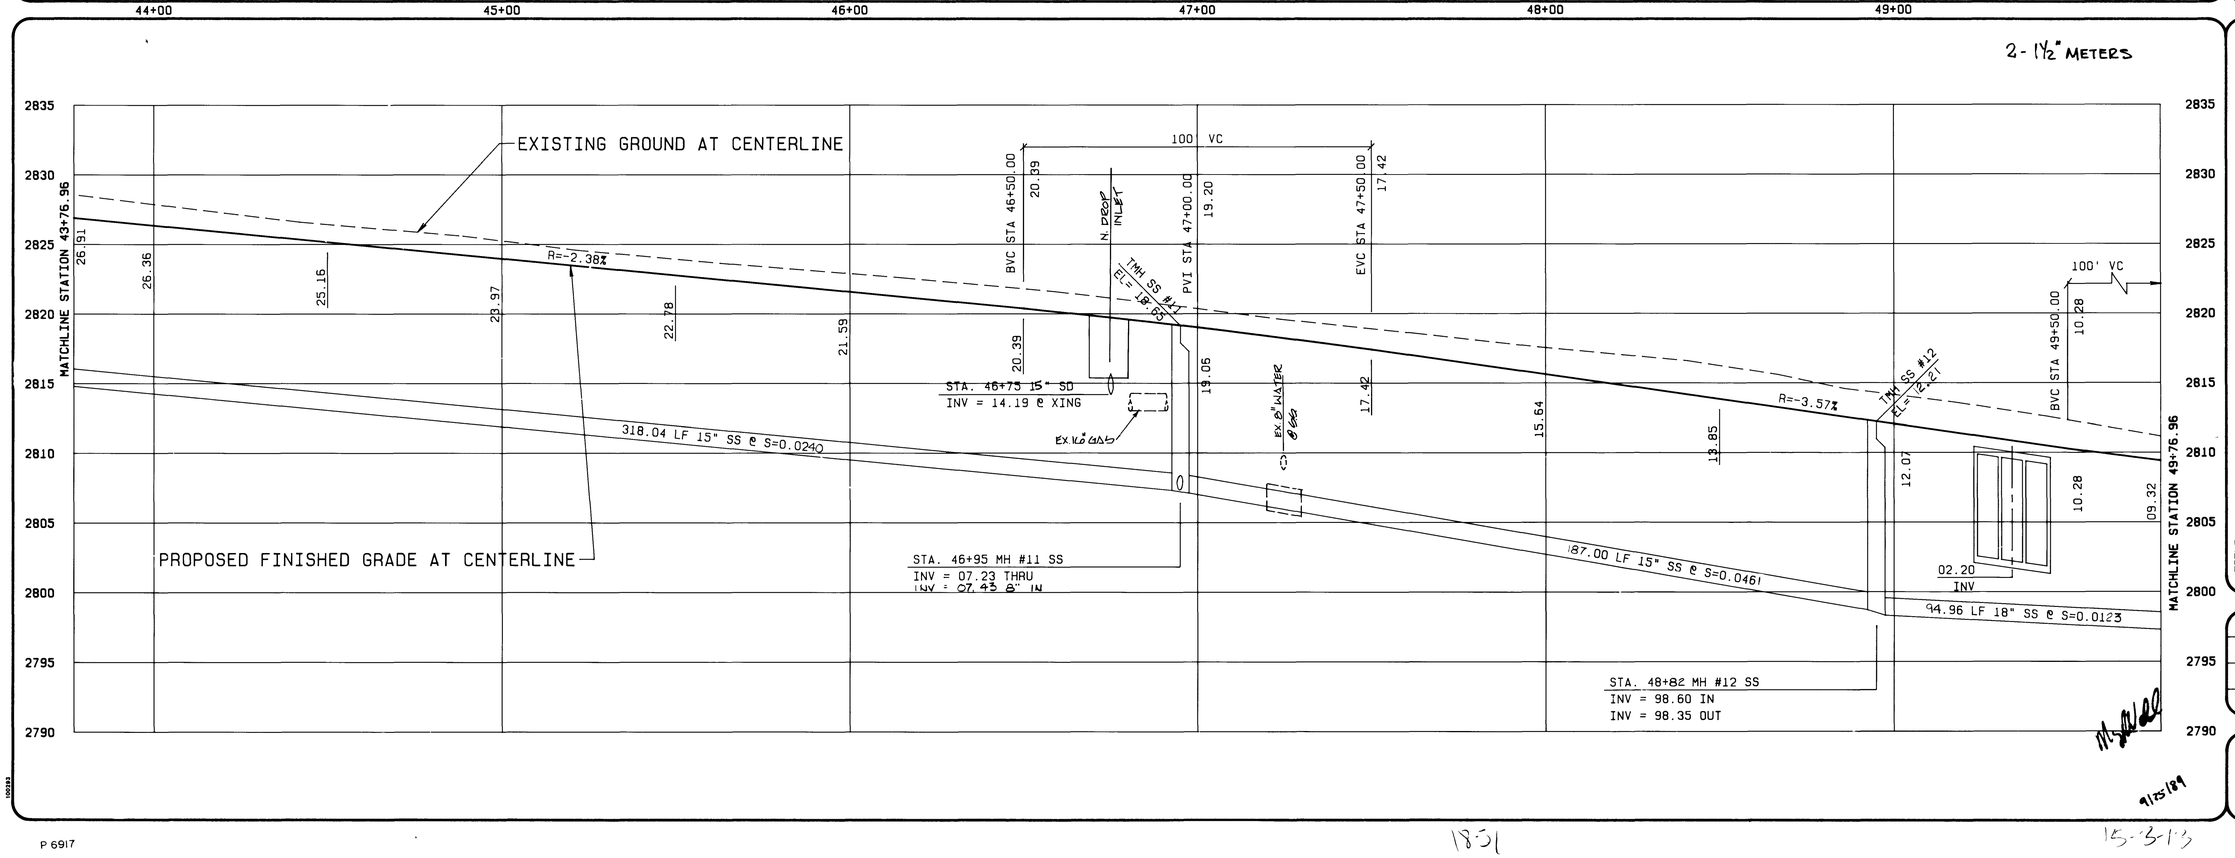

REV	DATE	BY	REVISION
2	7-3-90	DMH	REV BCR STA ON CHARLESTON
1	10-16-89	DH	REV PER CLV ADD 16" G.L. & JUNE

LAS VEGAS VALLEY WATER DISTRICT

NAME — DATE 6/27/90

CONSULTING ENGINEERS — PLANNERS
2300 PASEO DEL PRADO BUILDING A SUITE 100
LAS VEGAS, NEVADA 89102 PHONE (702) 873-7550

vtn nevada

TITLE: STA. 43+76.96 TO STA. 49+76.96

PROJECT: WEST CHARLESTON BOULEVARD
HUALPAI WAY TO DURANGO DRIVE

WO NO.	3464
BY	MH / RB
DATE	09/25/89
SCALE	1" = 20' H. 1" = 5' V.

SHEET 12 C9 OF 29 SHEETS

P 6917

18-51

15-3-13

107-V-1697

 

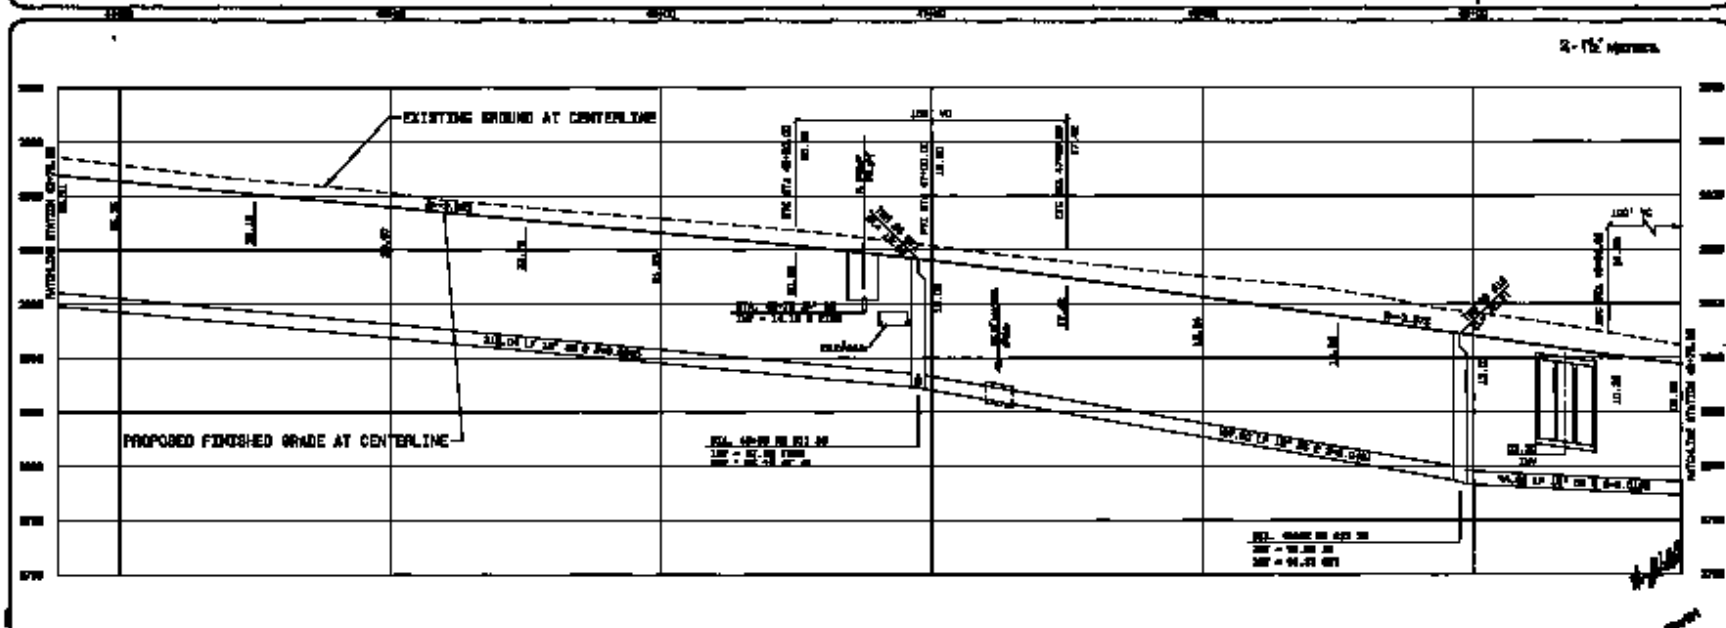

LAS VEGAS VALLEY WATER DISTRICT

CONSULTANTS ENGINEERING - PLANNING

STA. 43+78.96 TO STA. 49+78.96

WEST CHARLESTON BOULEVARD

HUALPAI WAY TO DURANGO DRIVE

C9