
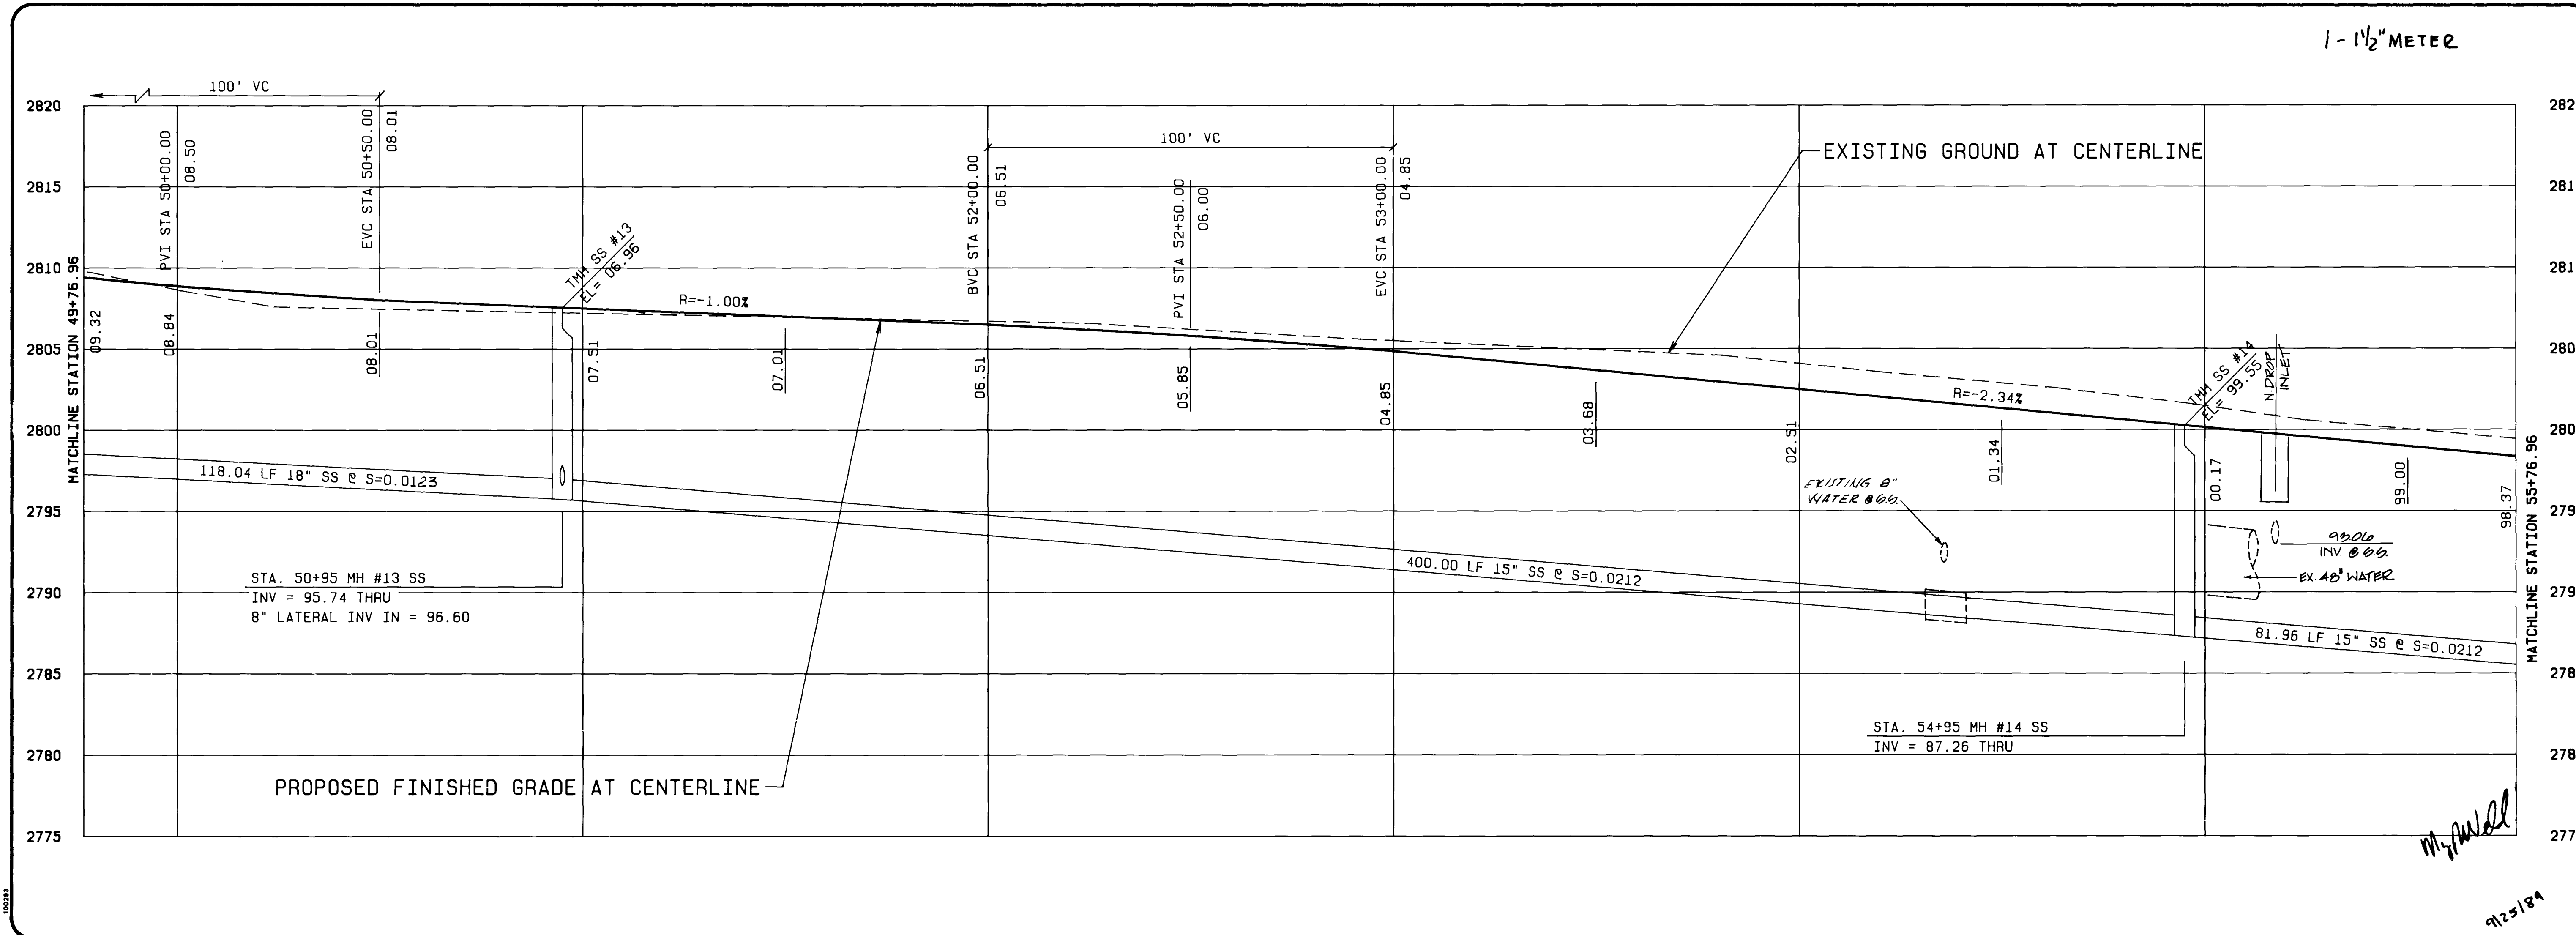
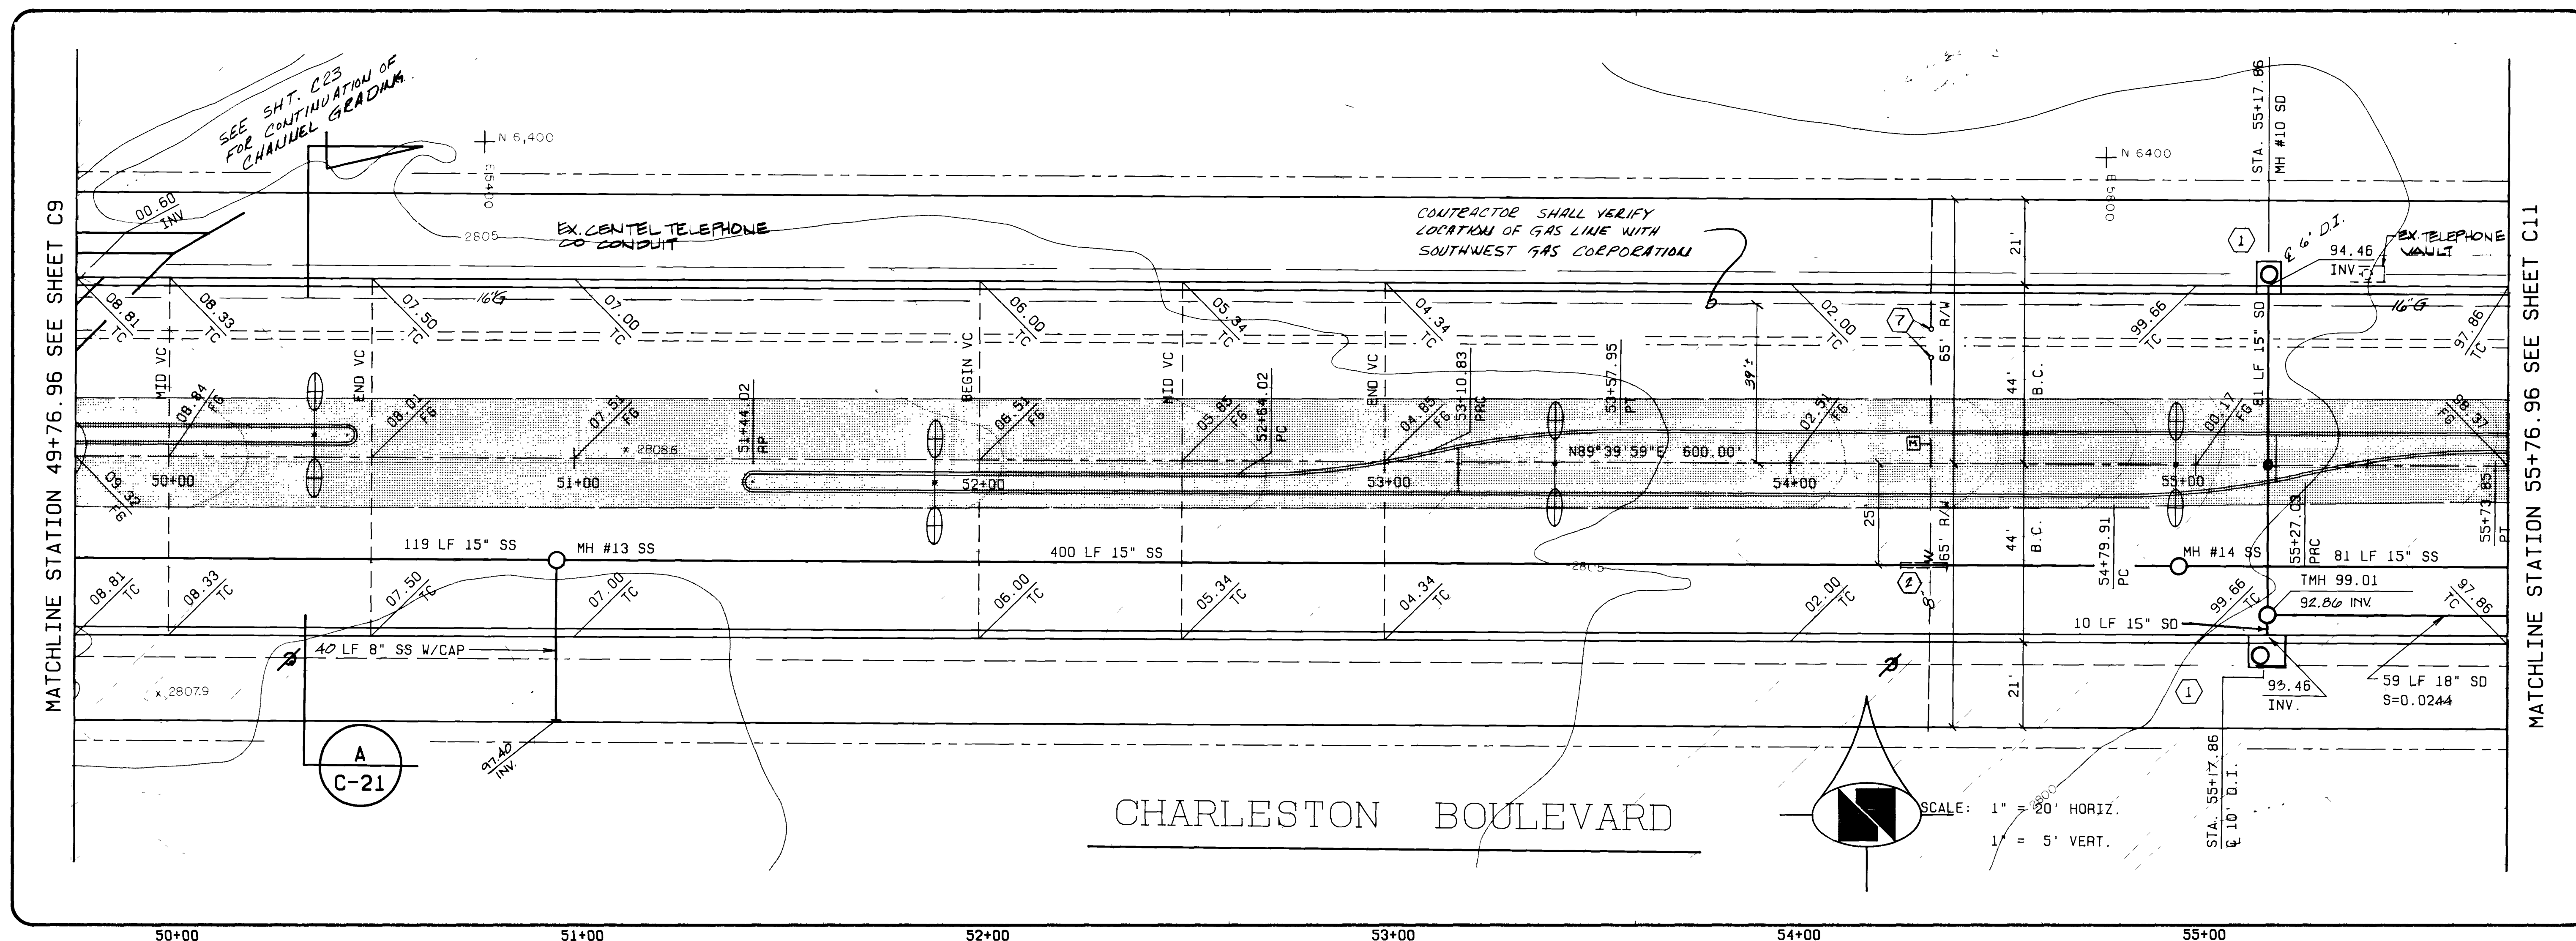
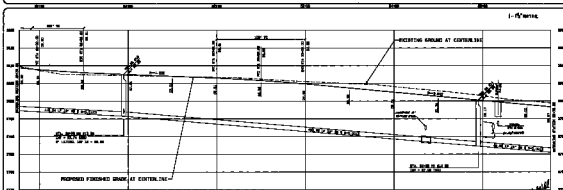


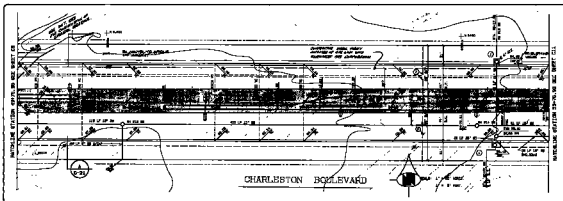

[illegible]

PROJECT	WEST CHARLESTON BOULEVARD JULIA B.P. MAY, INC., FARMERS, MOORE

C10