
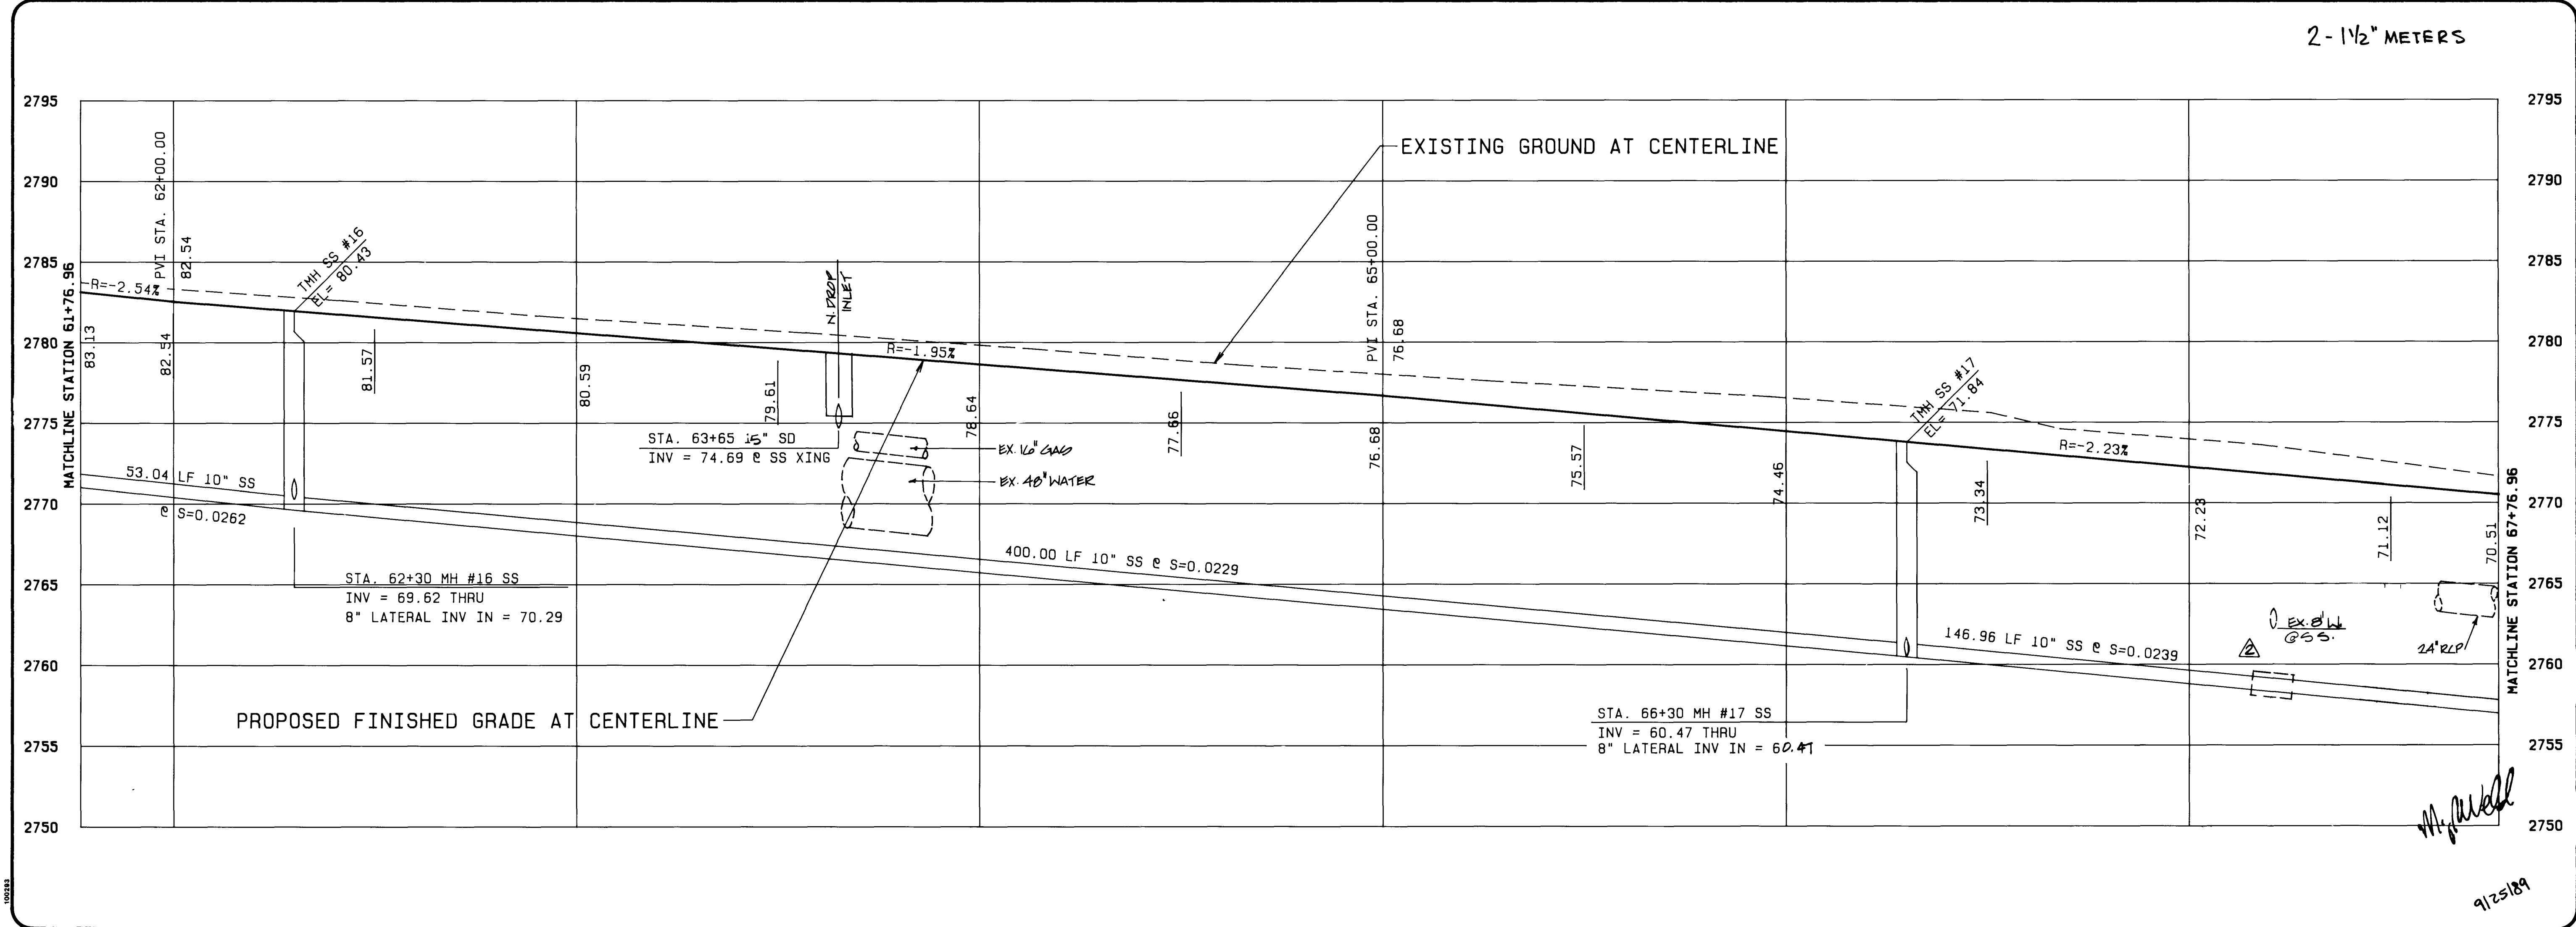


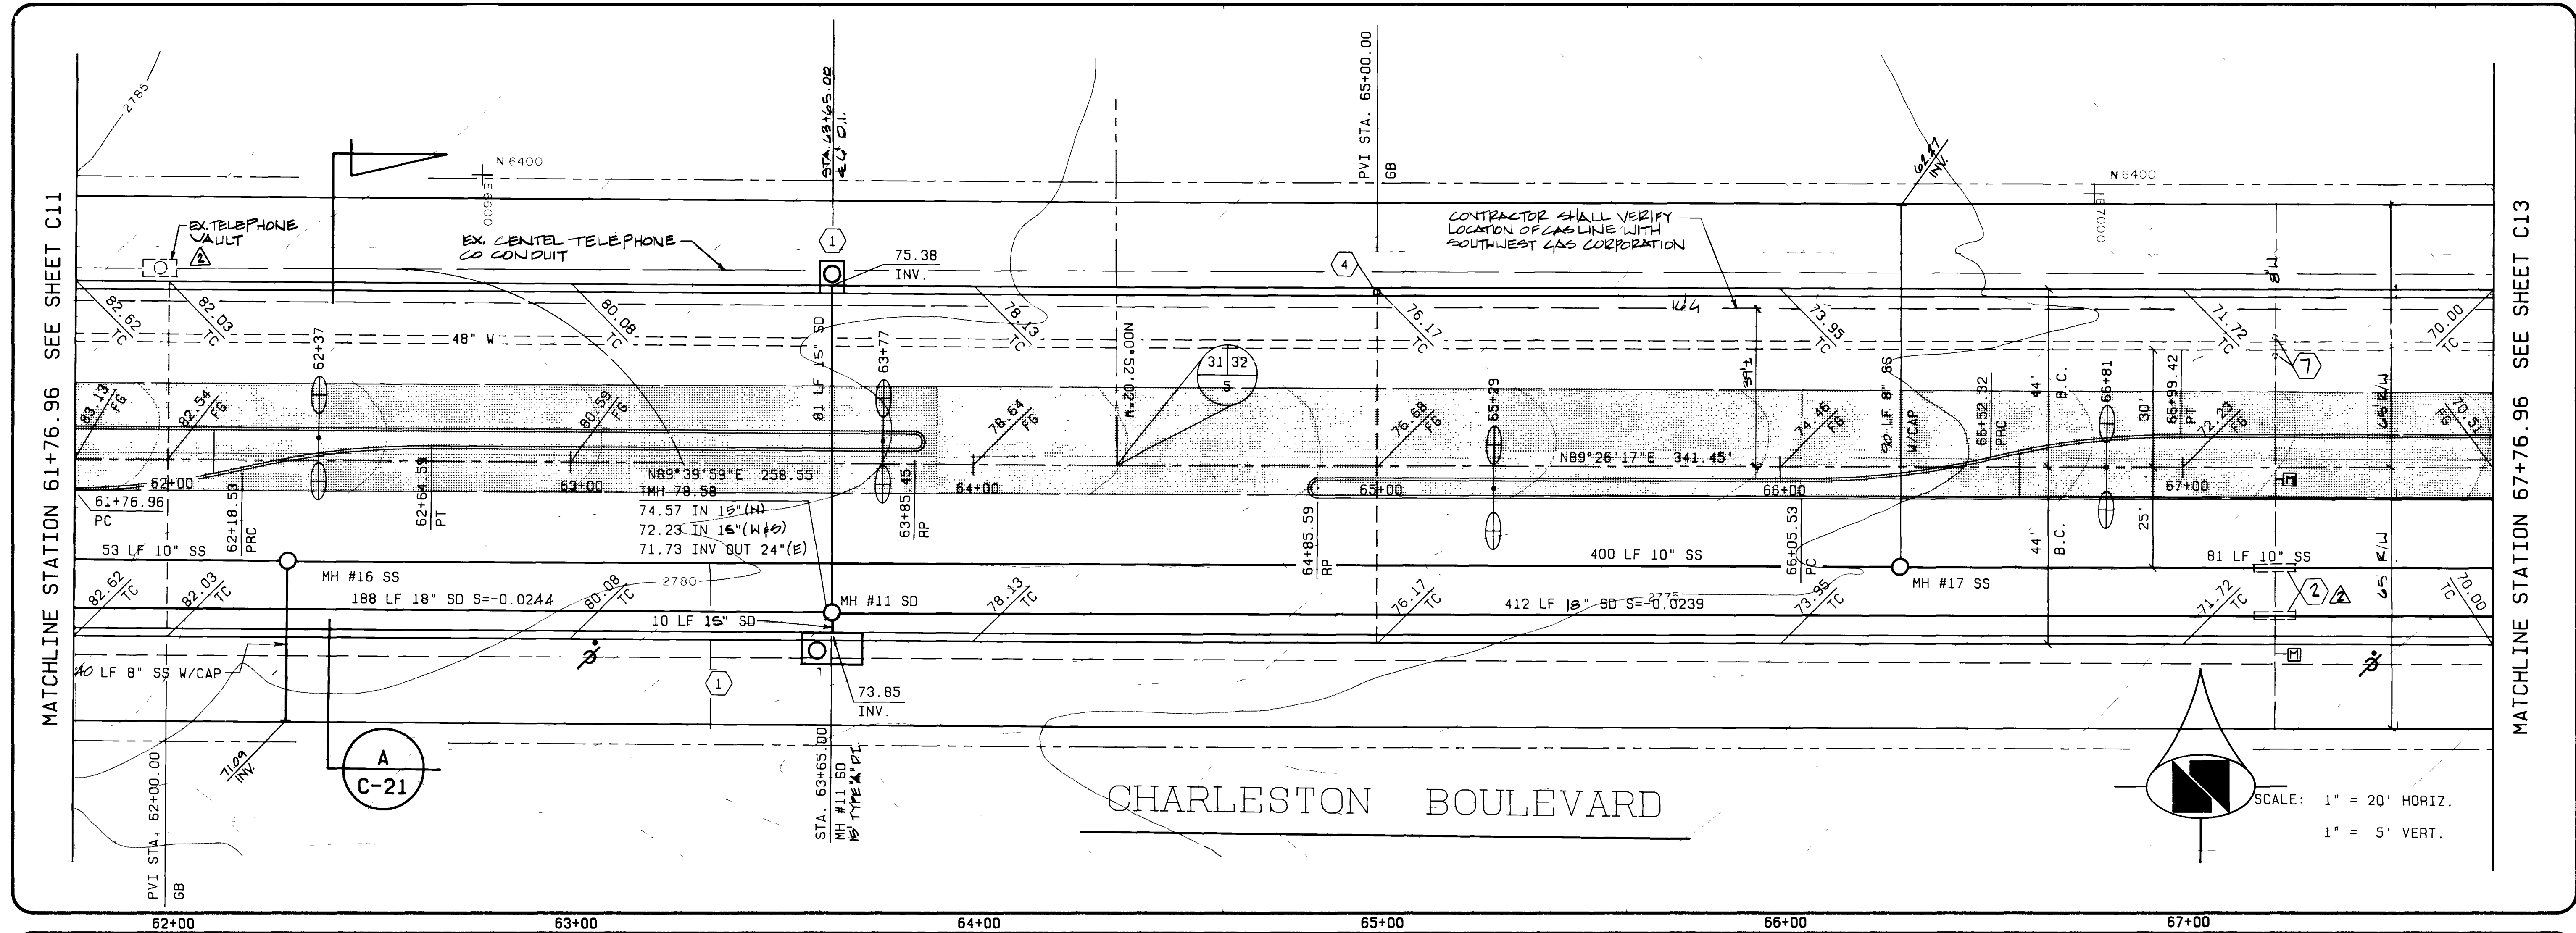

LAS VEGAS VALLEY WATER DISTRICT		REV	DATE	BY
TITLE		NAME		
PROJECT		DATE		
STATION		REVISION		

CONSULTING ENGINEERS - PLANNERS
2300 PASEO DEL PRADO, BUILDING A, SUITE 100
LAS VEGAS, NEVADA 89102 PHONE (702) 873-7550

DATE: 09/25/89

NAME: [Signature]

SCALE: 1" = 20' HORIZ.
1" = 5' VERT.

STA. 61+76.96 TO STA. 67+76.96

WEST CHARLESTON BOULEVARD
HUALPAI WAY TO DURANGO DRIVE

PROJECT

NO. 3464

BY: MH / RB



DATE: 09/25/89

SCALE: 1" = 20' H.
1" = 5' V.

SHEET 13

C12

OF 29 SHEETS

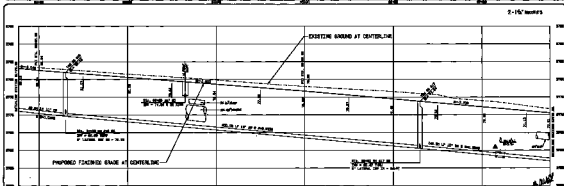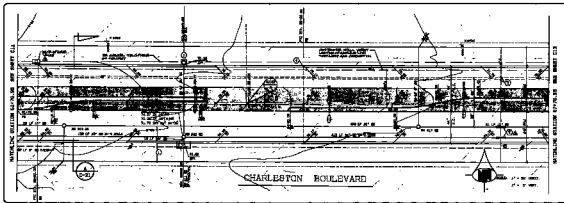















WEST CHARLESTON BOULEVARD

PROPOSED FINISHED GRADE AT CENTERLINE

EXISTING GRADE AT CENTERLINE














