
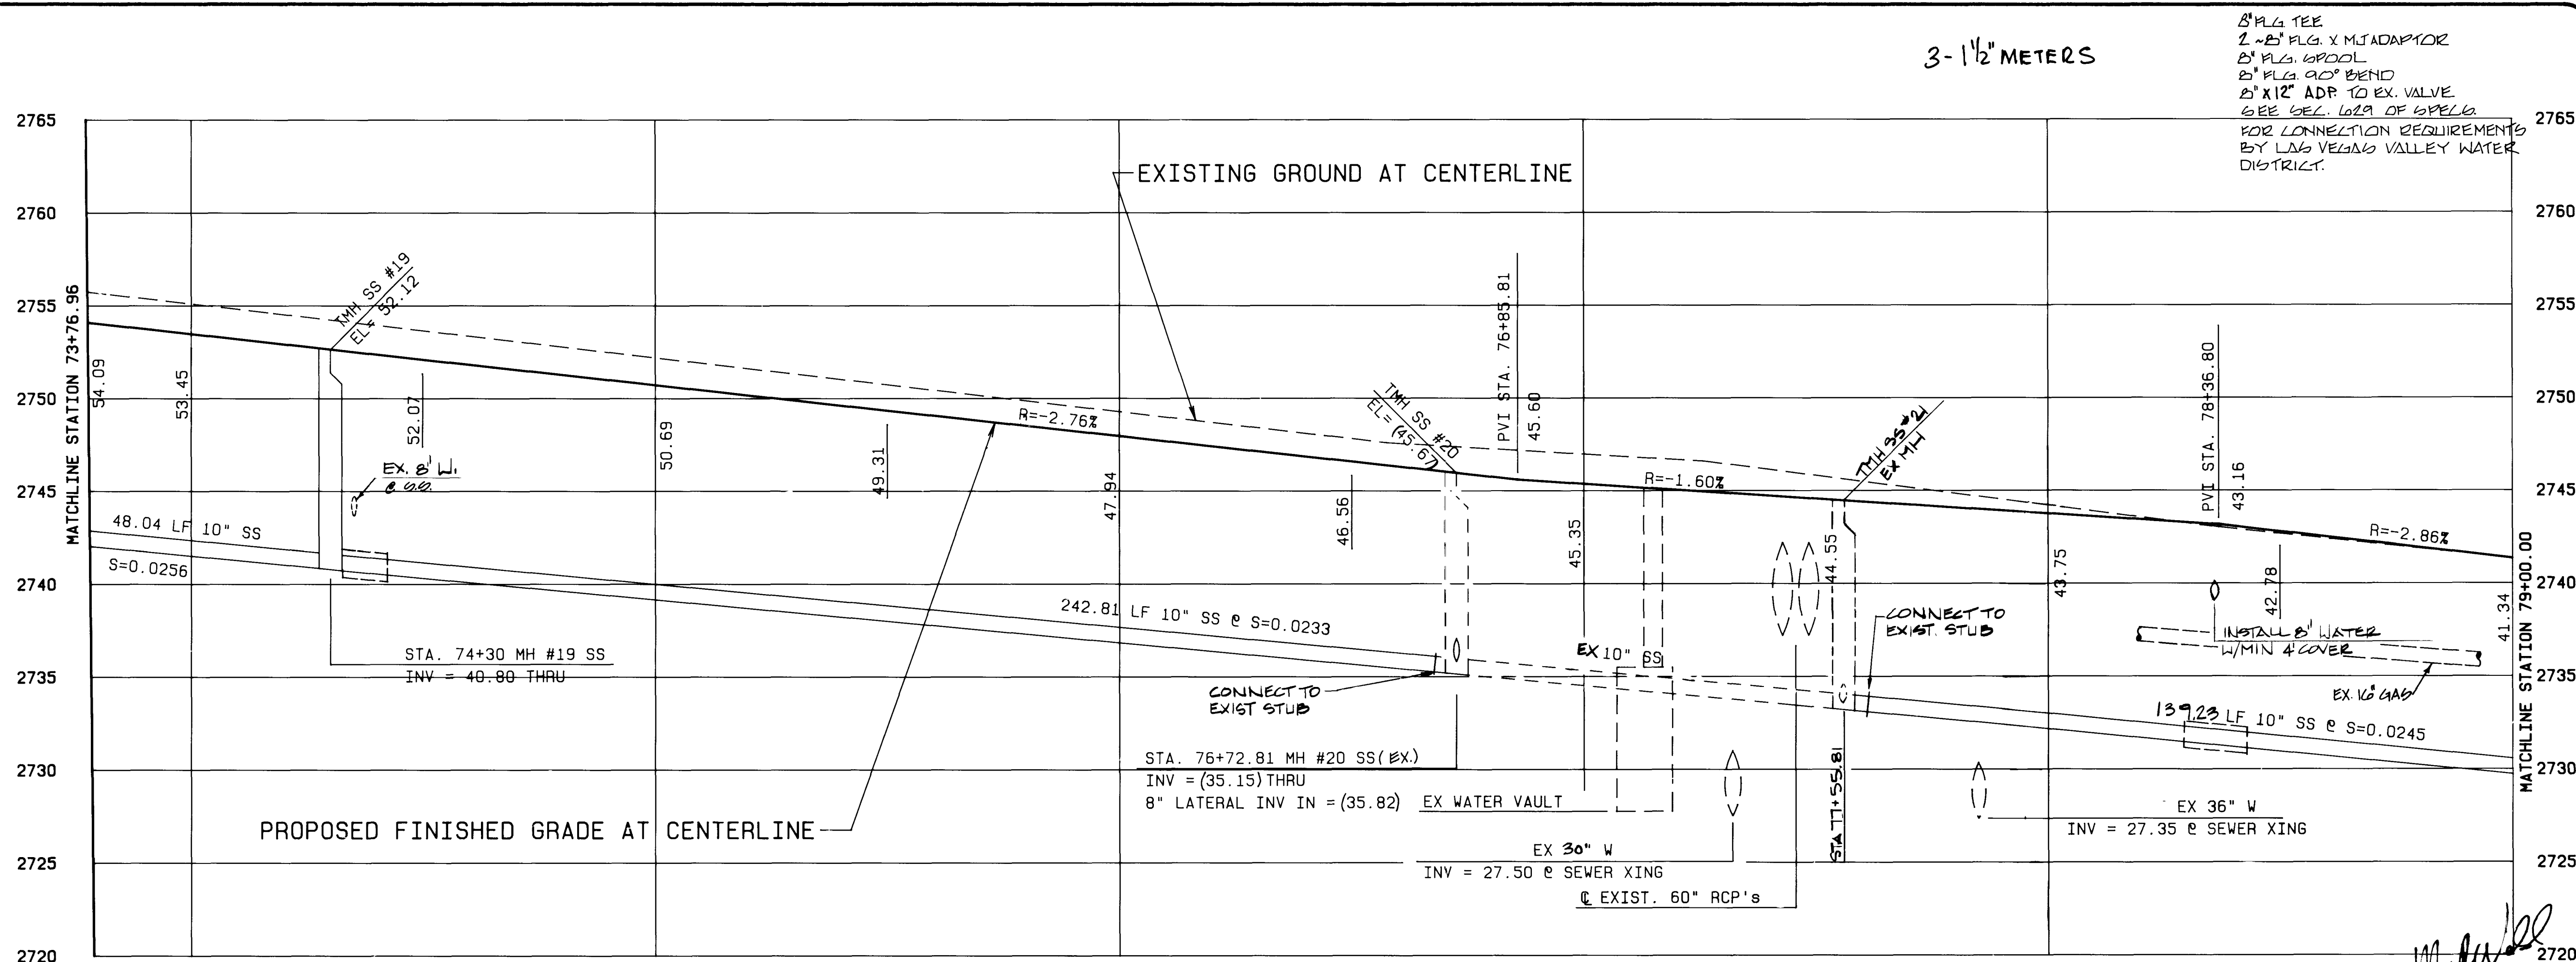


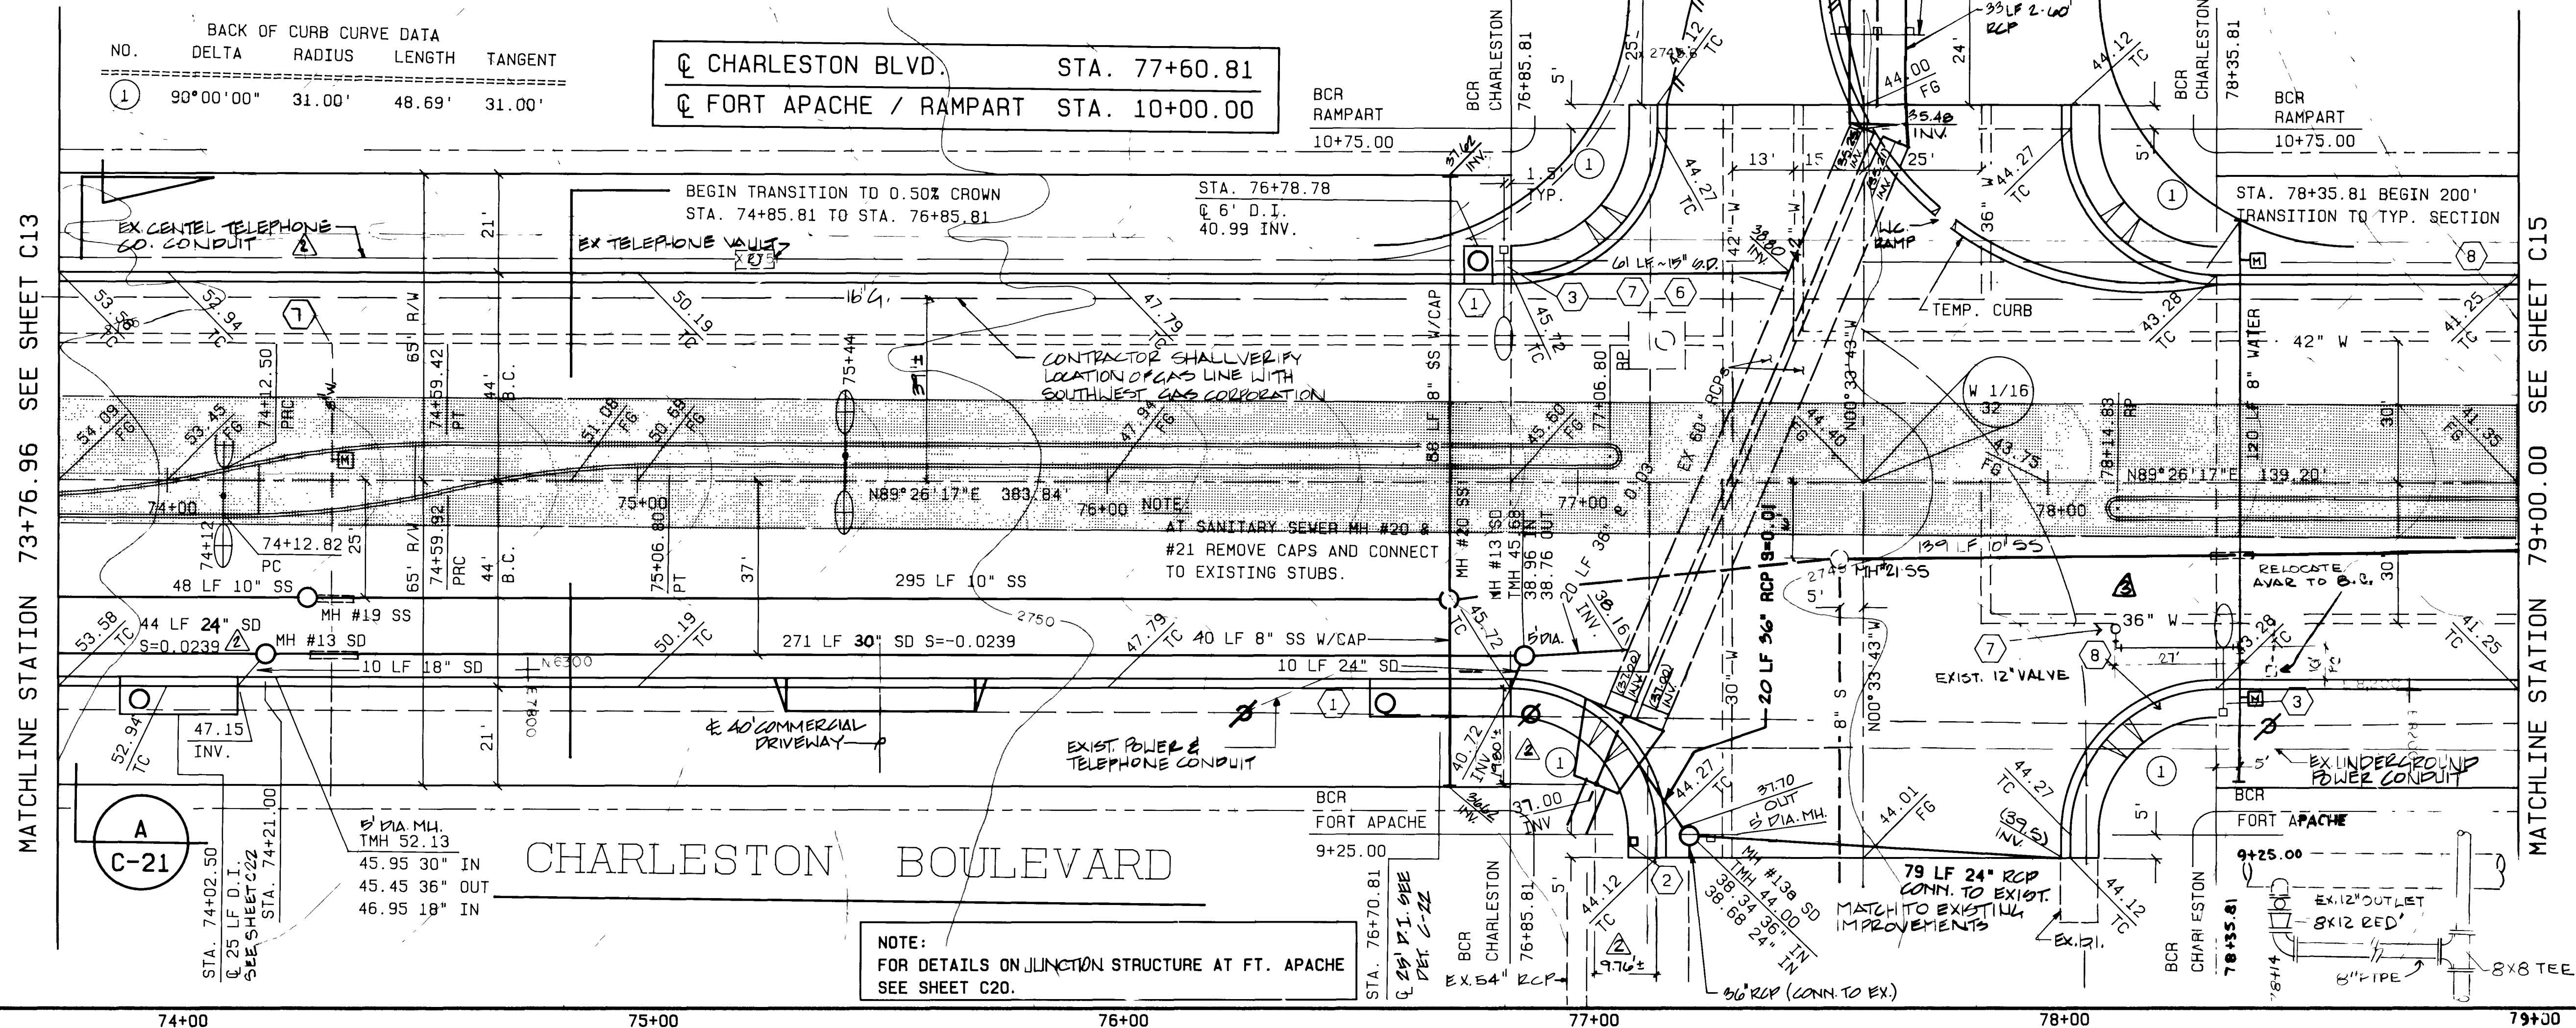

LAS VEGAS VALLEY WATER DISTRICT		REVISION	DATE	BY
NAME		DATE	BY	REVISION
DATE		BY	REVISION	DATE
DATE		BY	REVISION	DATE

CONSULTING ENGINEERS - PLANNERS
2300 PASEO DEL PRADO BUILDING A SUITE 100
LAS VEGAS, NEVADA 89102 PHONE (702) 873-7550

vtm nevada

STA. 73+76.96 TO STA. 79+00.00

WEST CHARLESTON BOULEVARD
HUALPAI WAY TO DURANGO DRIVE

PROJECT

NO. NO. 3464

BY MH / RB

DATE 09/25/89

SCALE 1" = 20' H.
1" = 5' V.

SHEET 15

C14

OF 29 SHEETS

