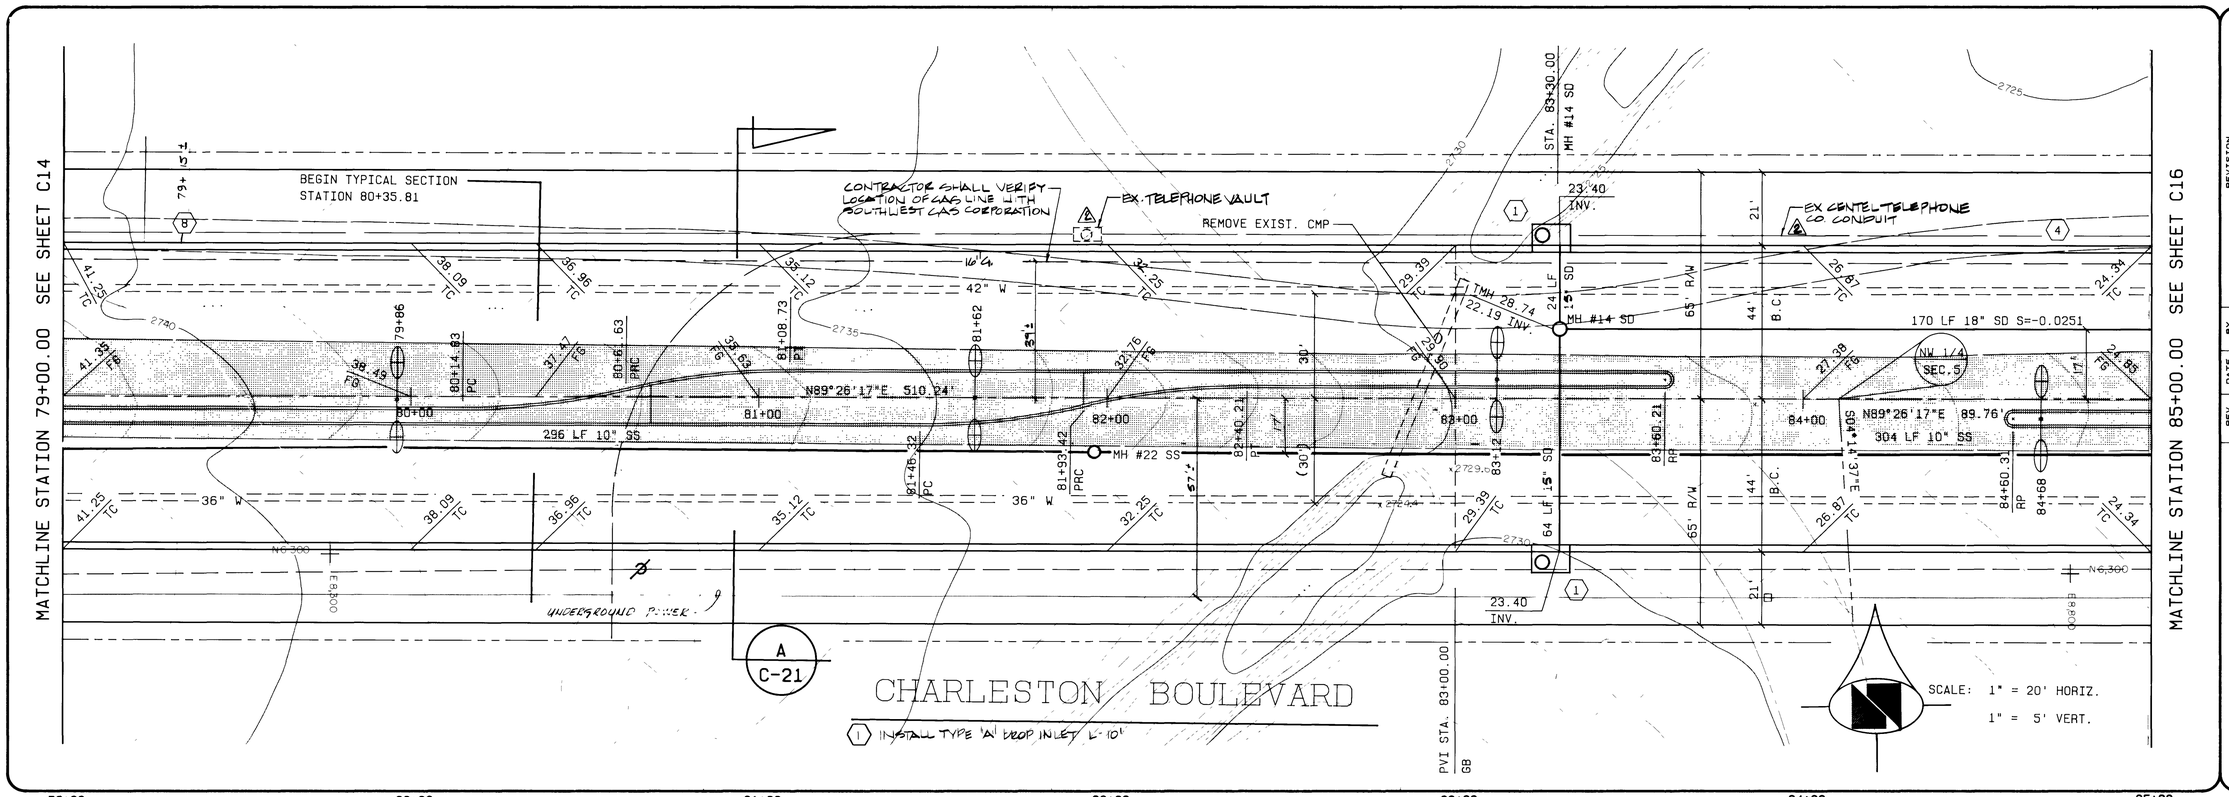

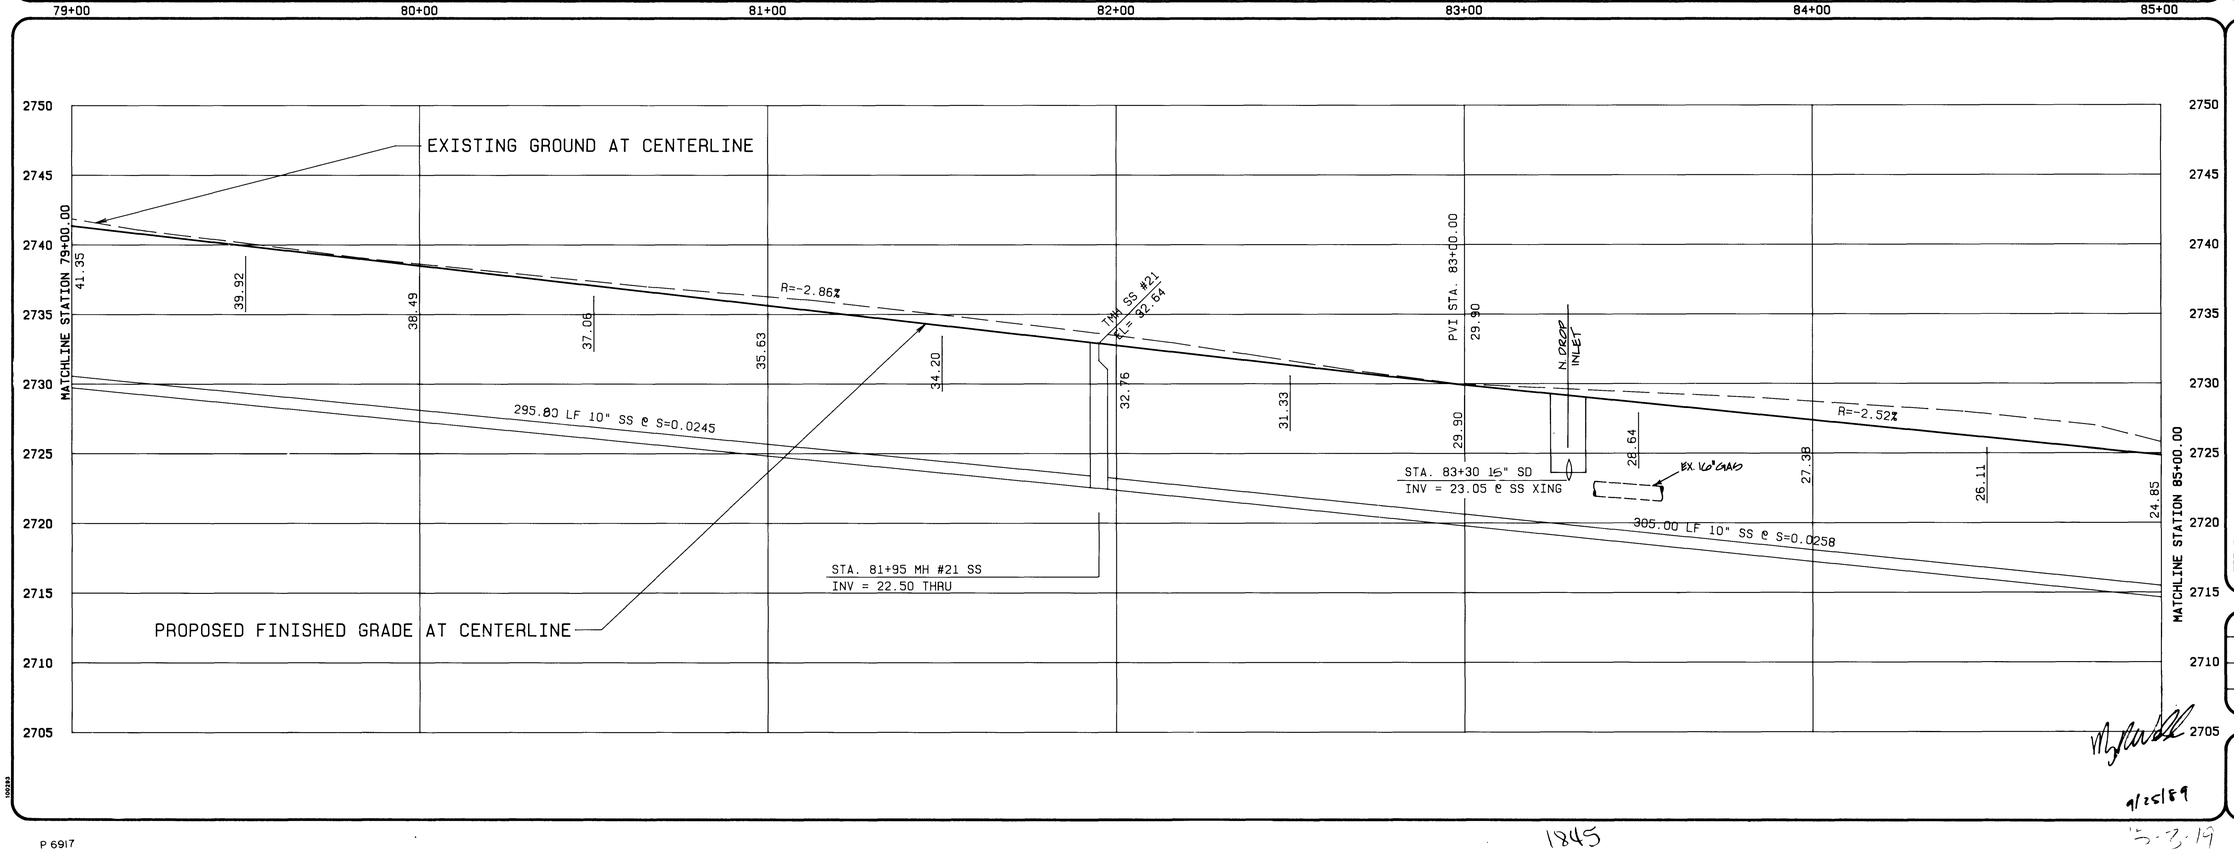

REV	DATE	BY	REVISION
2	4-6-90	RAD	ADD CENTEL CONDUIT
1	10-15-89		REV PER CLN ADD 16" GAS LINE & NOTE

LAS VEGAS VALLEY WATER DISTRICT

NAME — DATE 4/27/90

CONSULTING ENGINEERS — PLANNERS
2300 PASEO DEL PRADO BUILDING A SUITE 100
LAS VEGAS, NEVADA 89102 PHONE (702) 873-7550

vtn nevada

TITLE: STA. 79+00.00 TO STA. 85+00.00

PROJECT: WEST CHARLESTON BOULEVARD
HUALPAI WAY TO DURANGO DRIVE

WO NO.	3464
BY	MH / RB
DATE	09/25/89
SCALE	1" = 20' H. 1" = 5' V.

SHEET 16 OF 29 SHEETS

C15

9/25/89

P 6917

1845

5-3-19

107-V-1697

 

 

LAS VEGAS VALLEY WATER DISTRICT

CONSULTING ENGINEERS – PLANNERS

STA. 79+00.00 TO STA. 85+00.00

WEST CHARLESTON BOULEVARD


C15

1945