

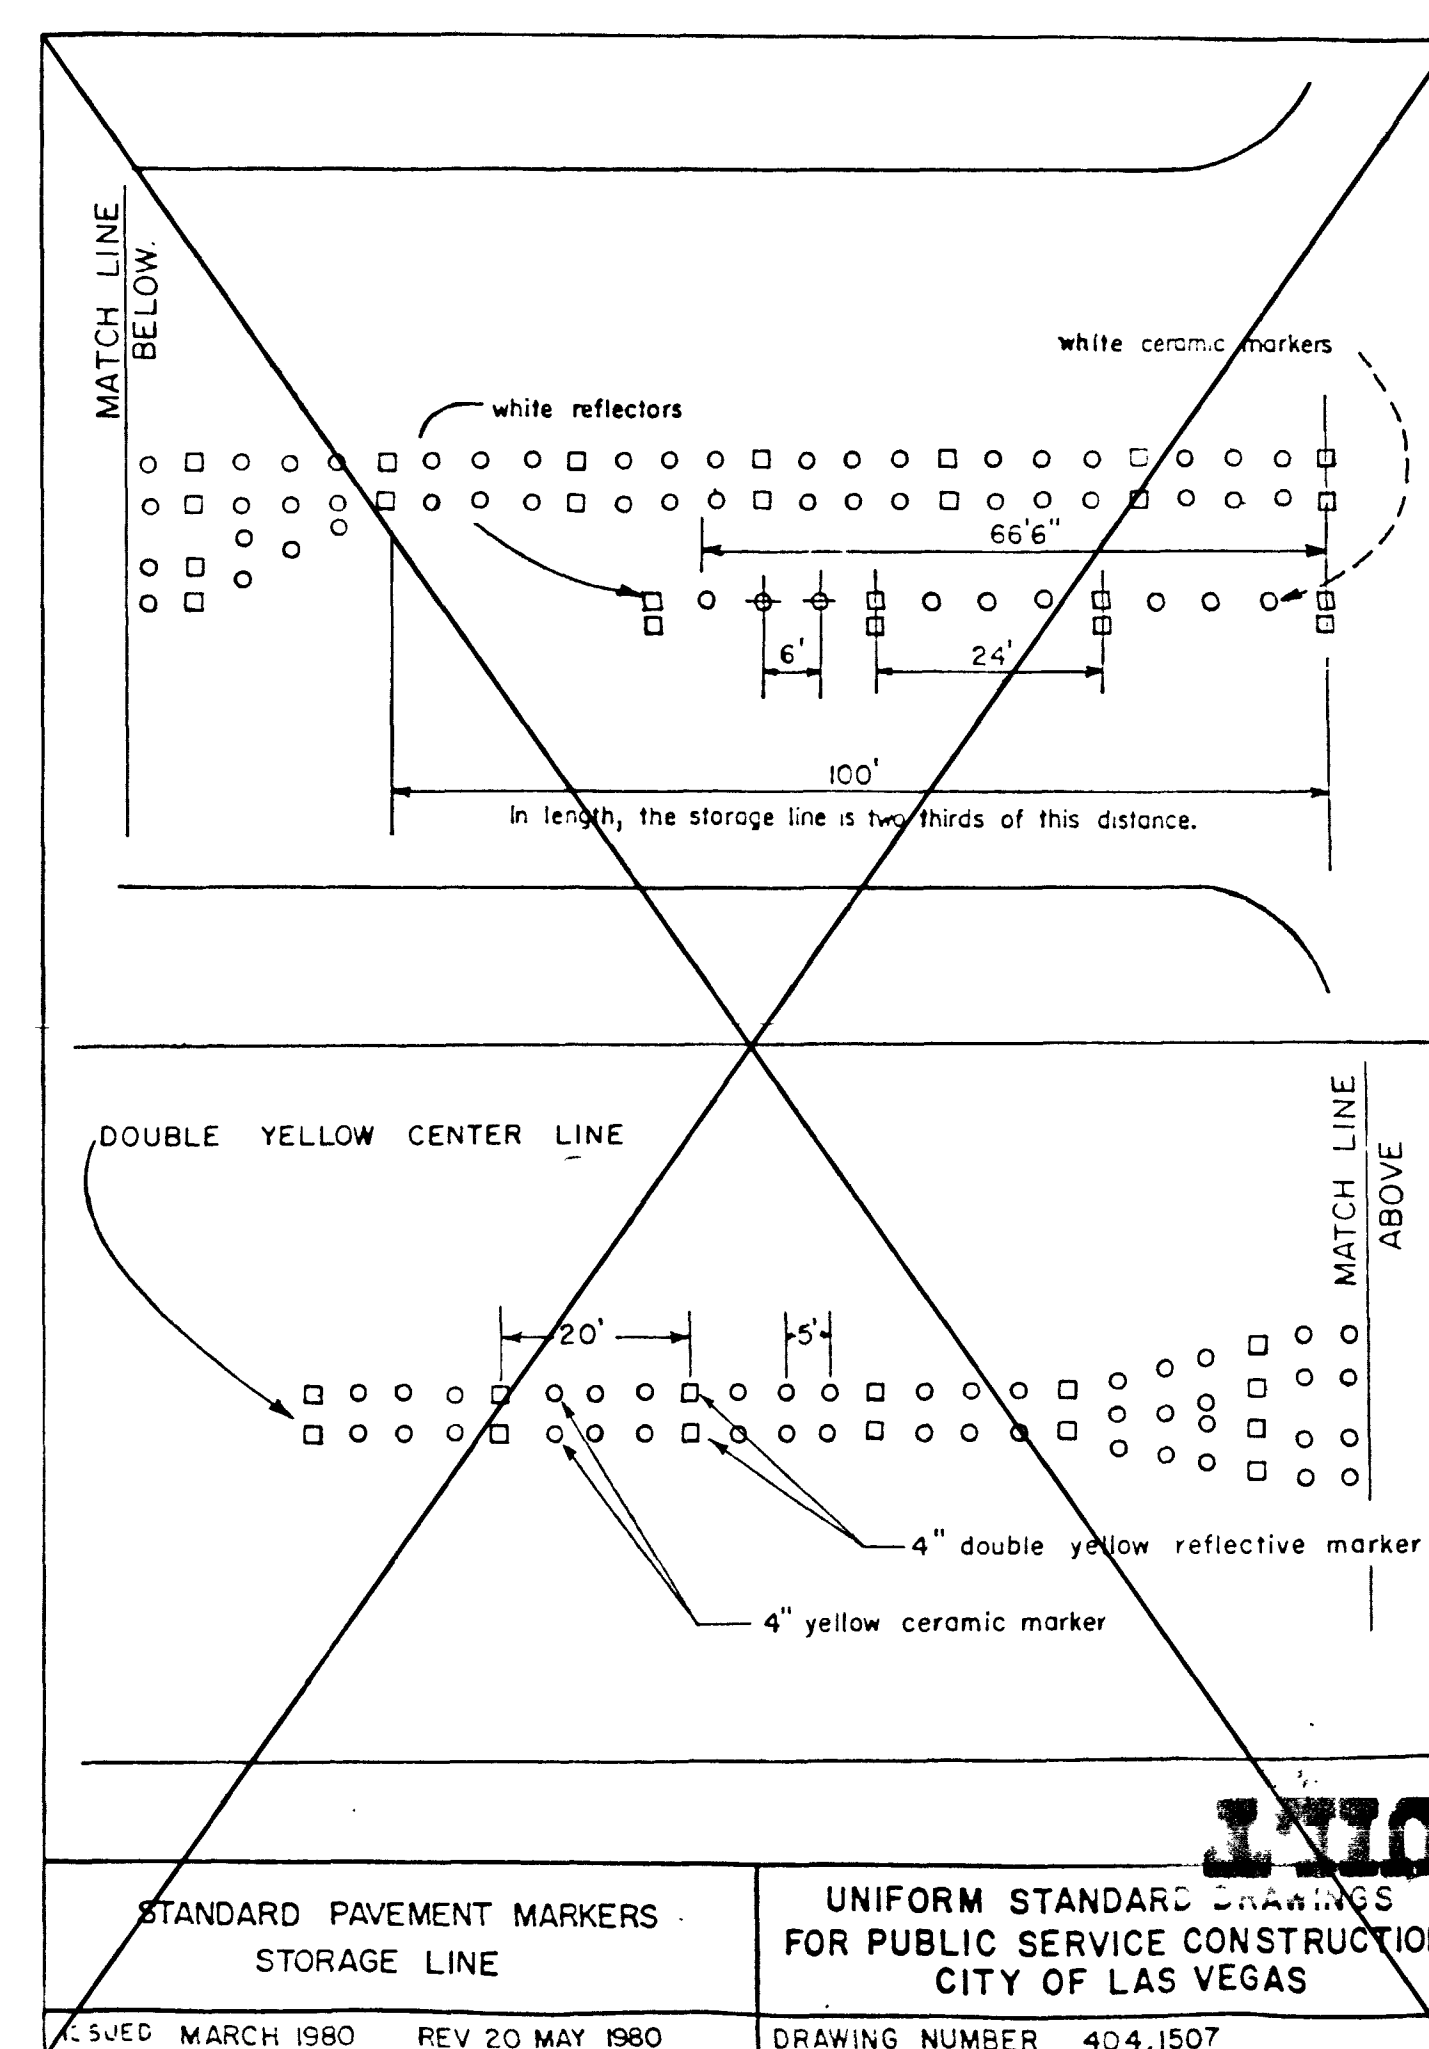
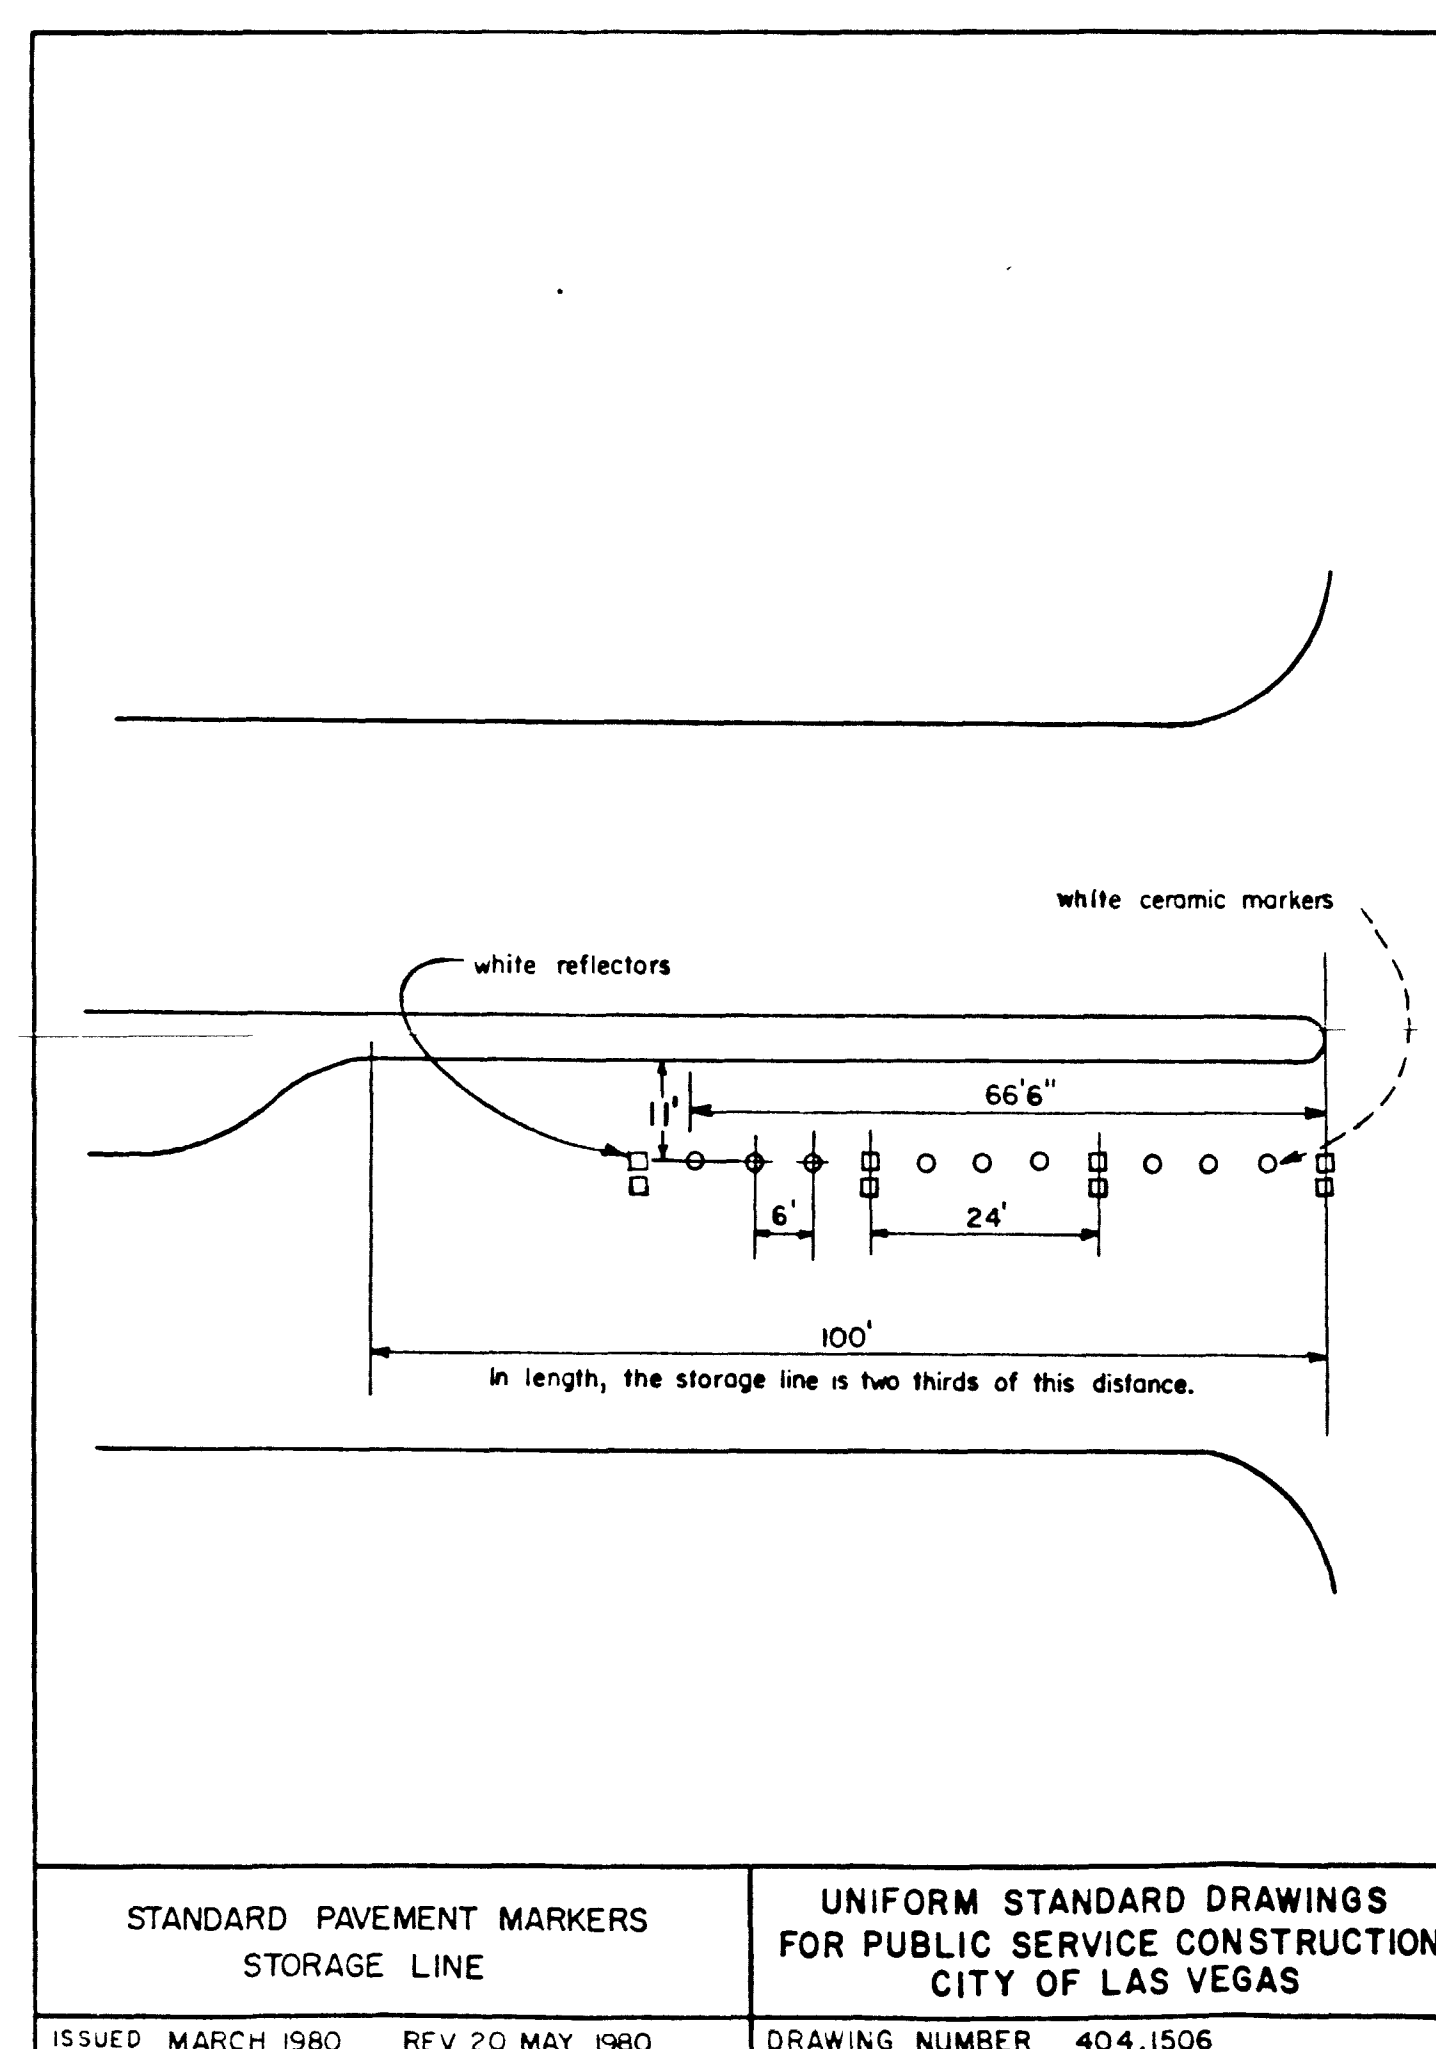
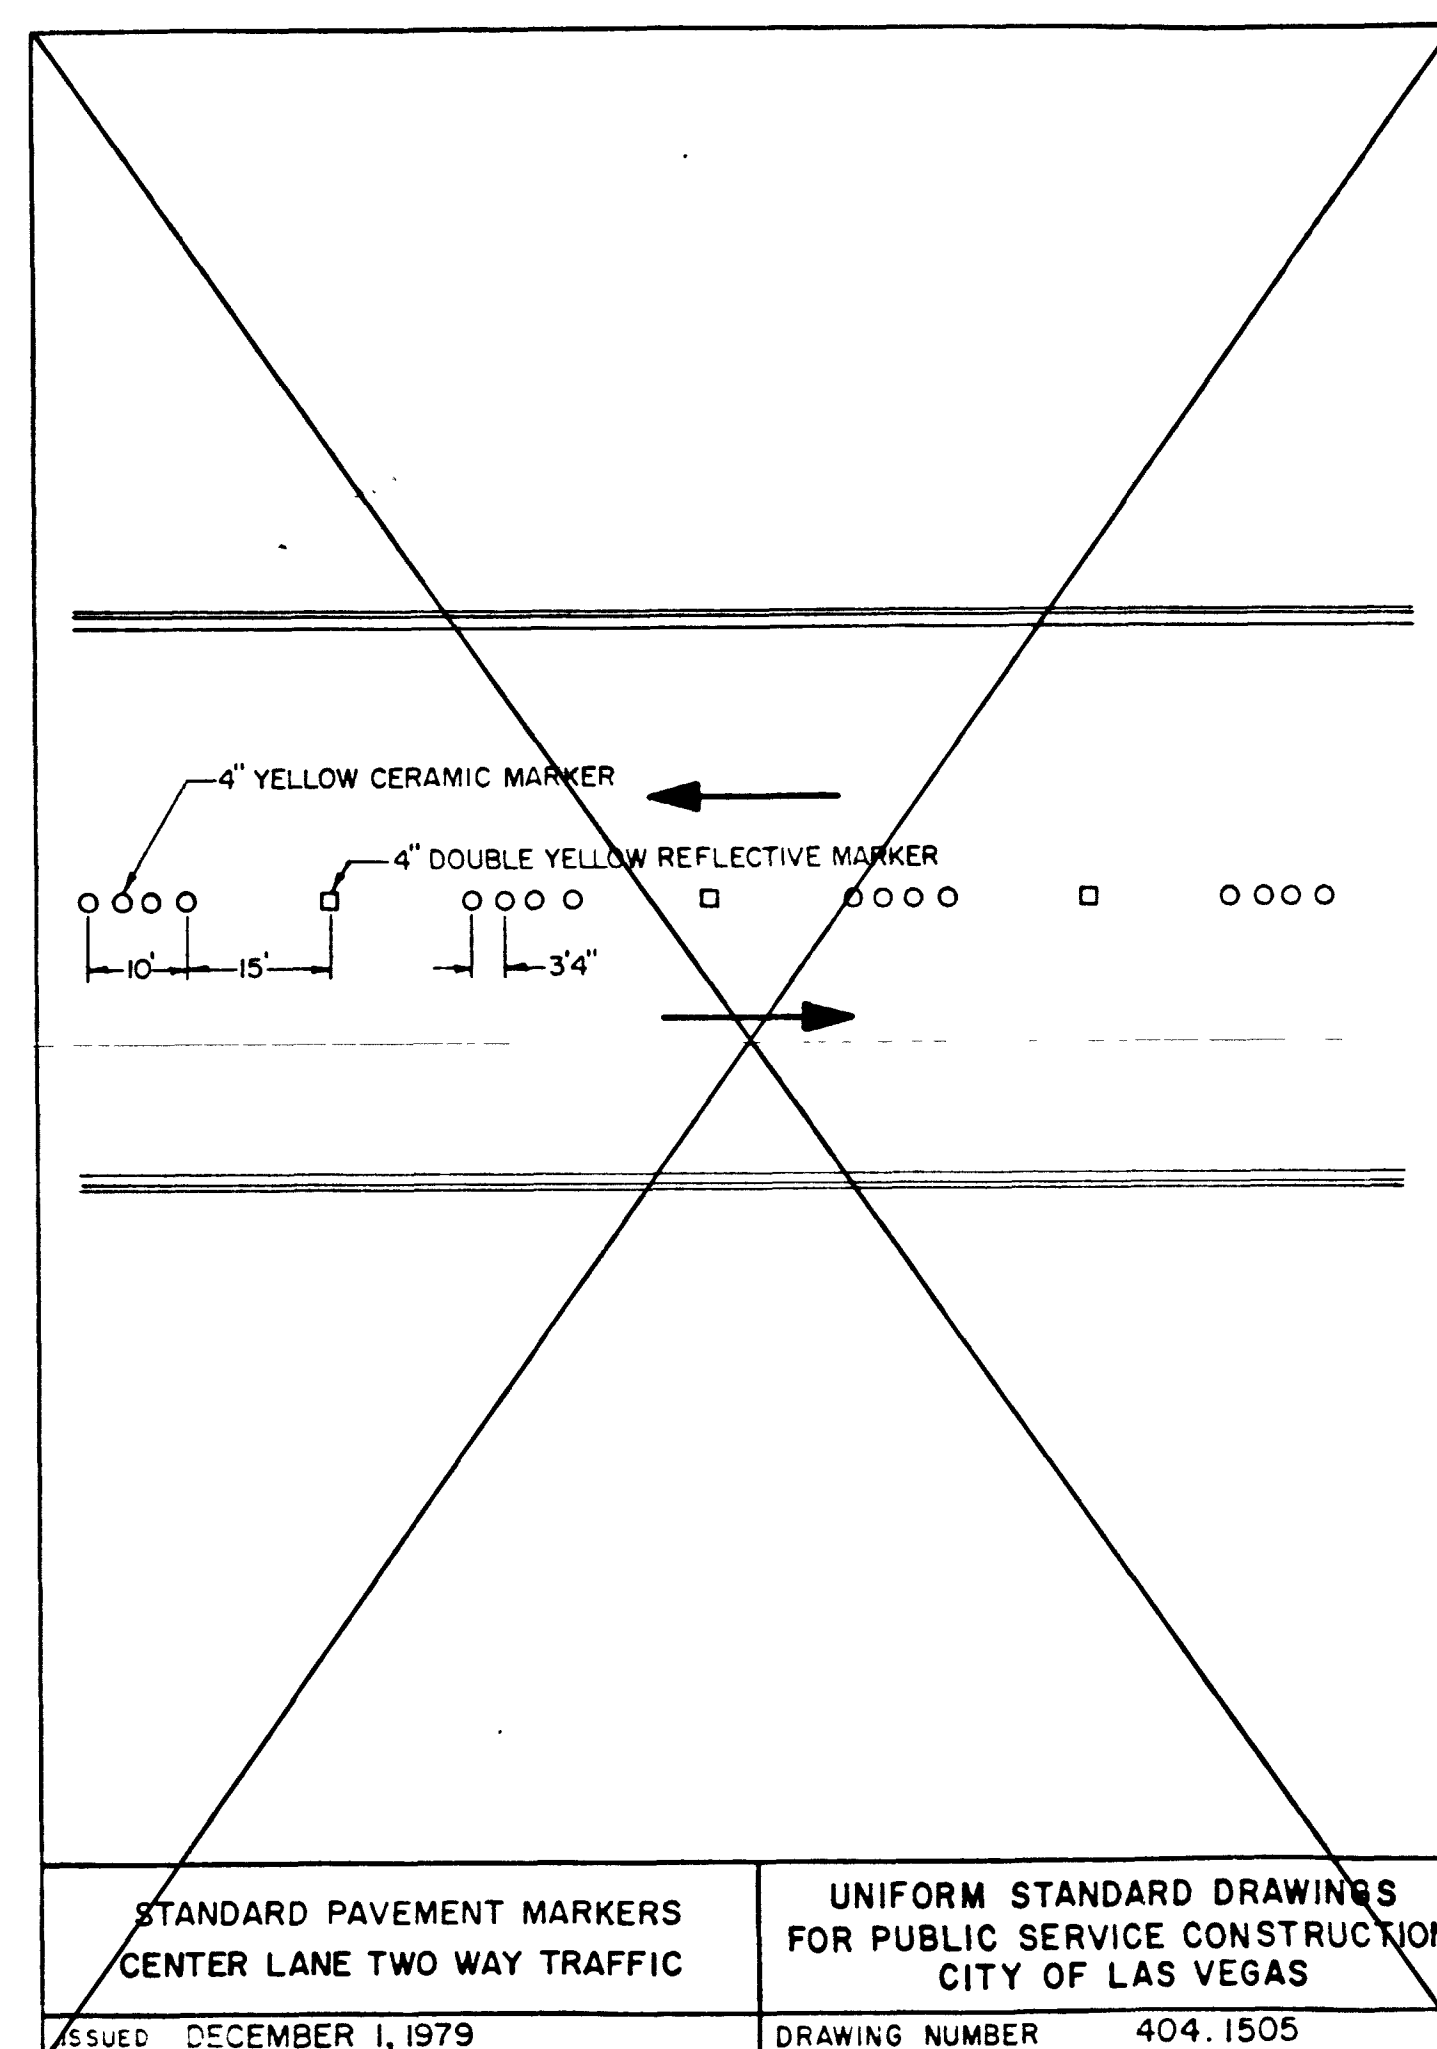
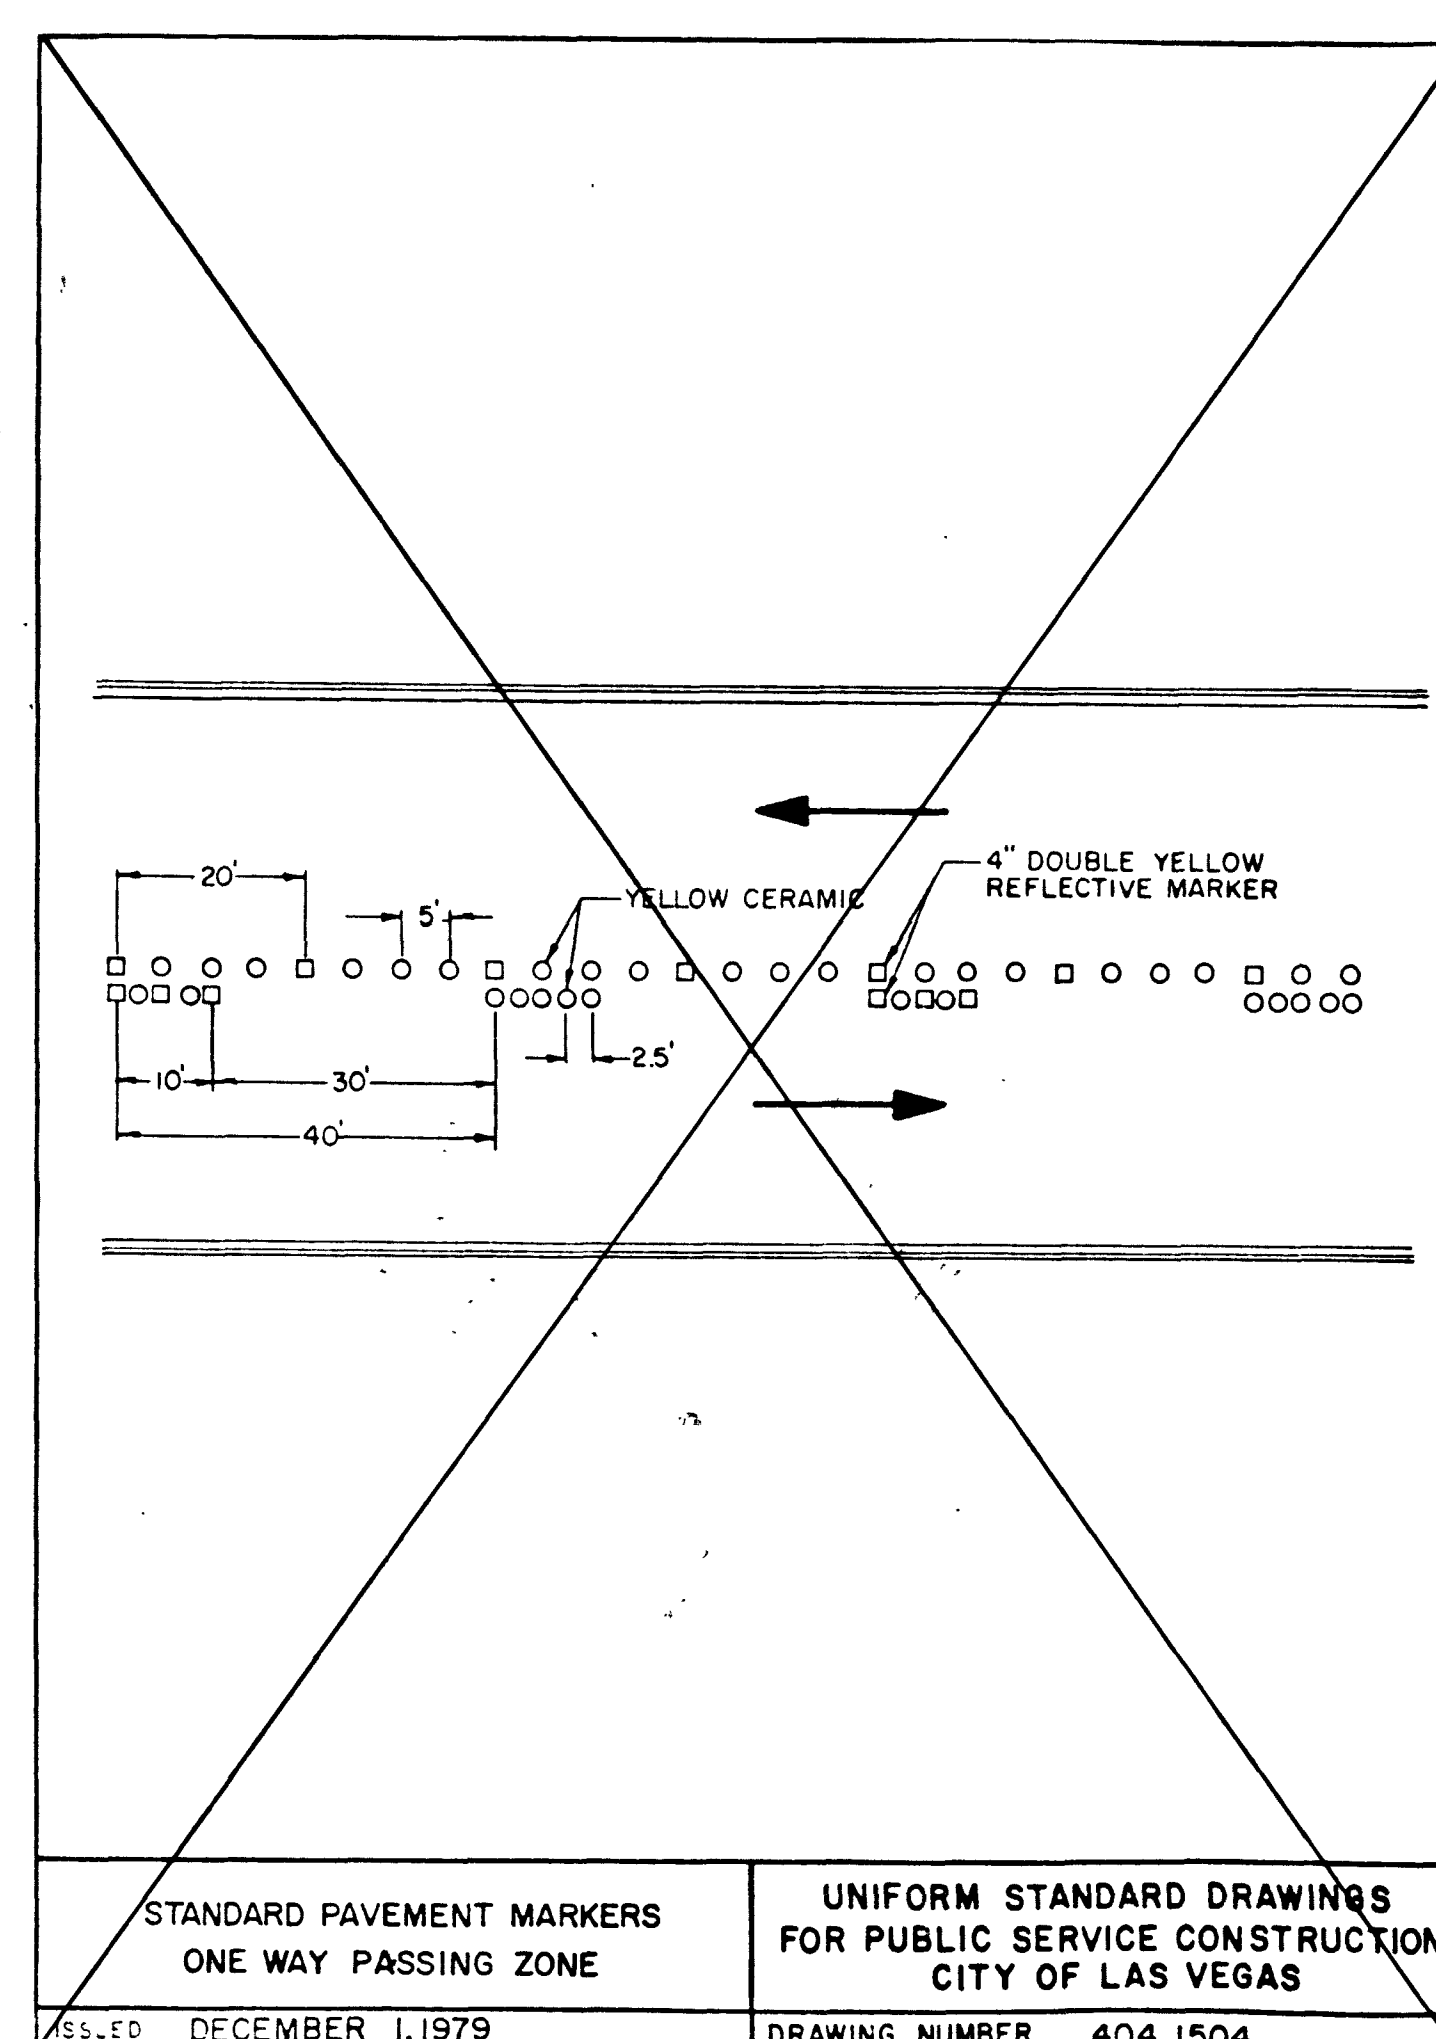
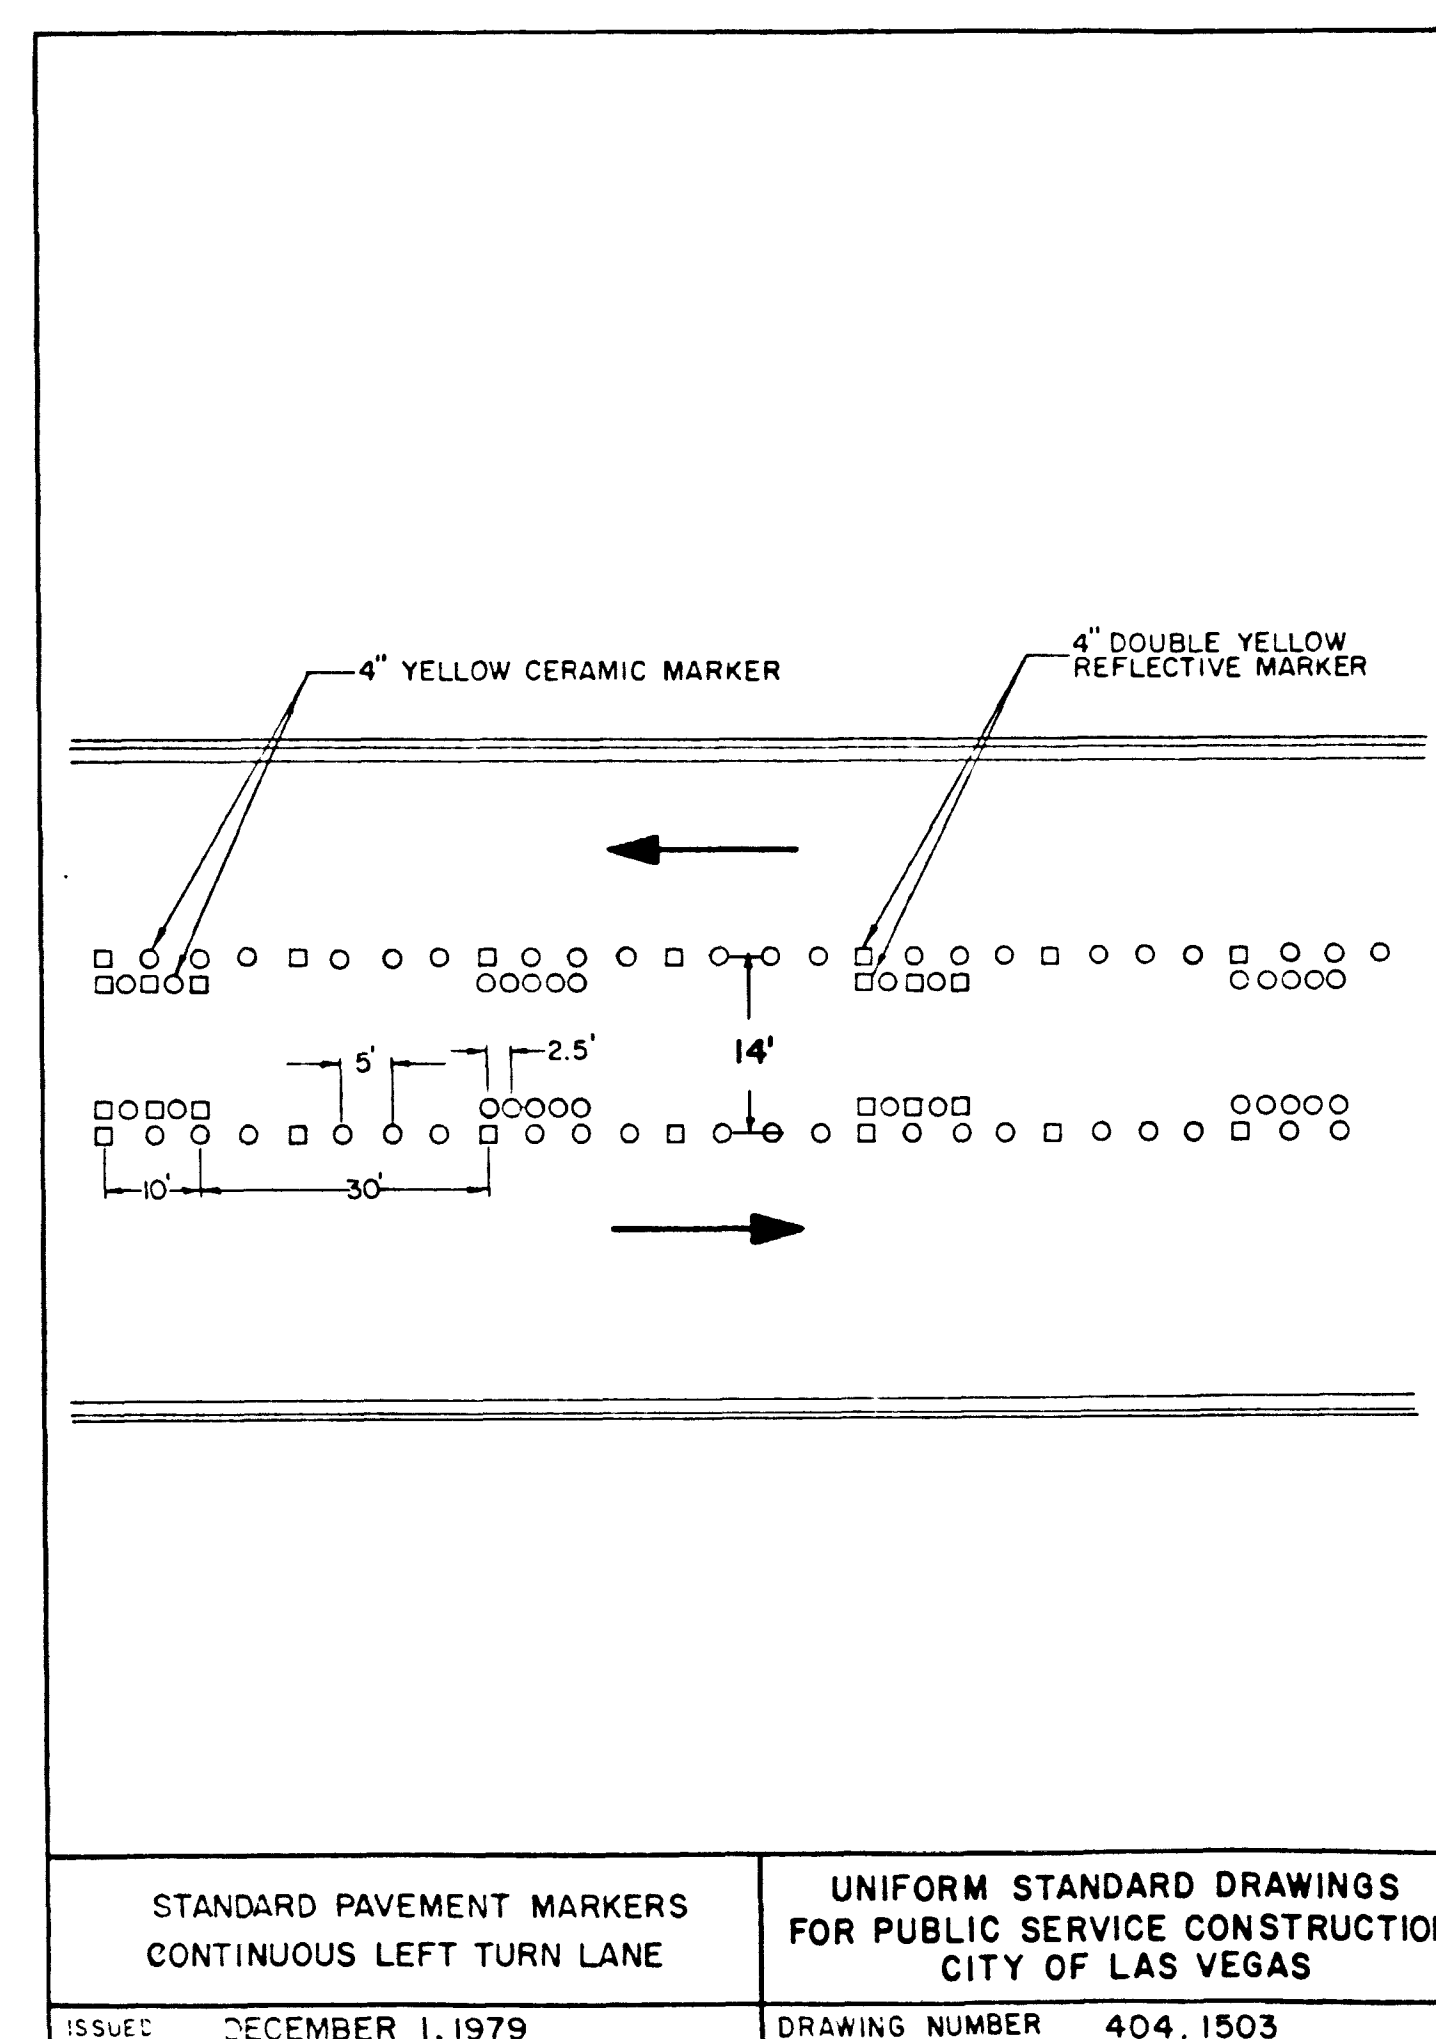
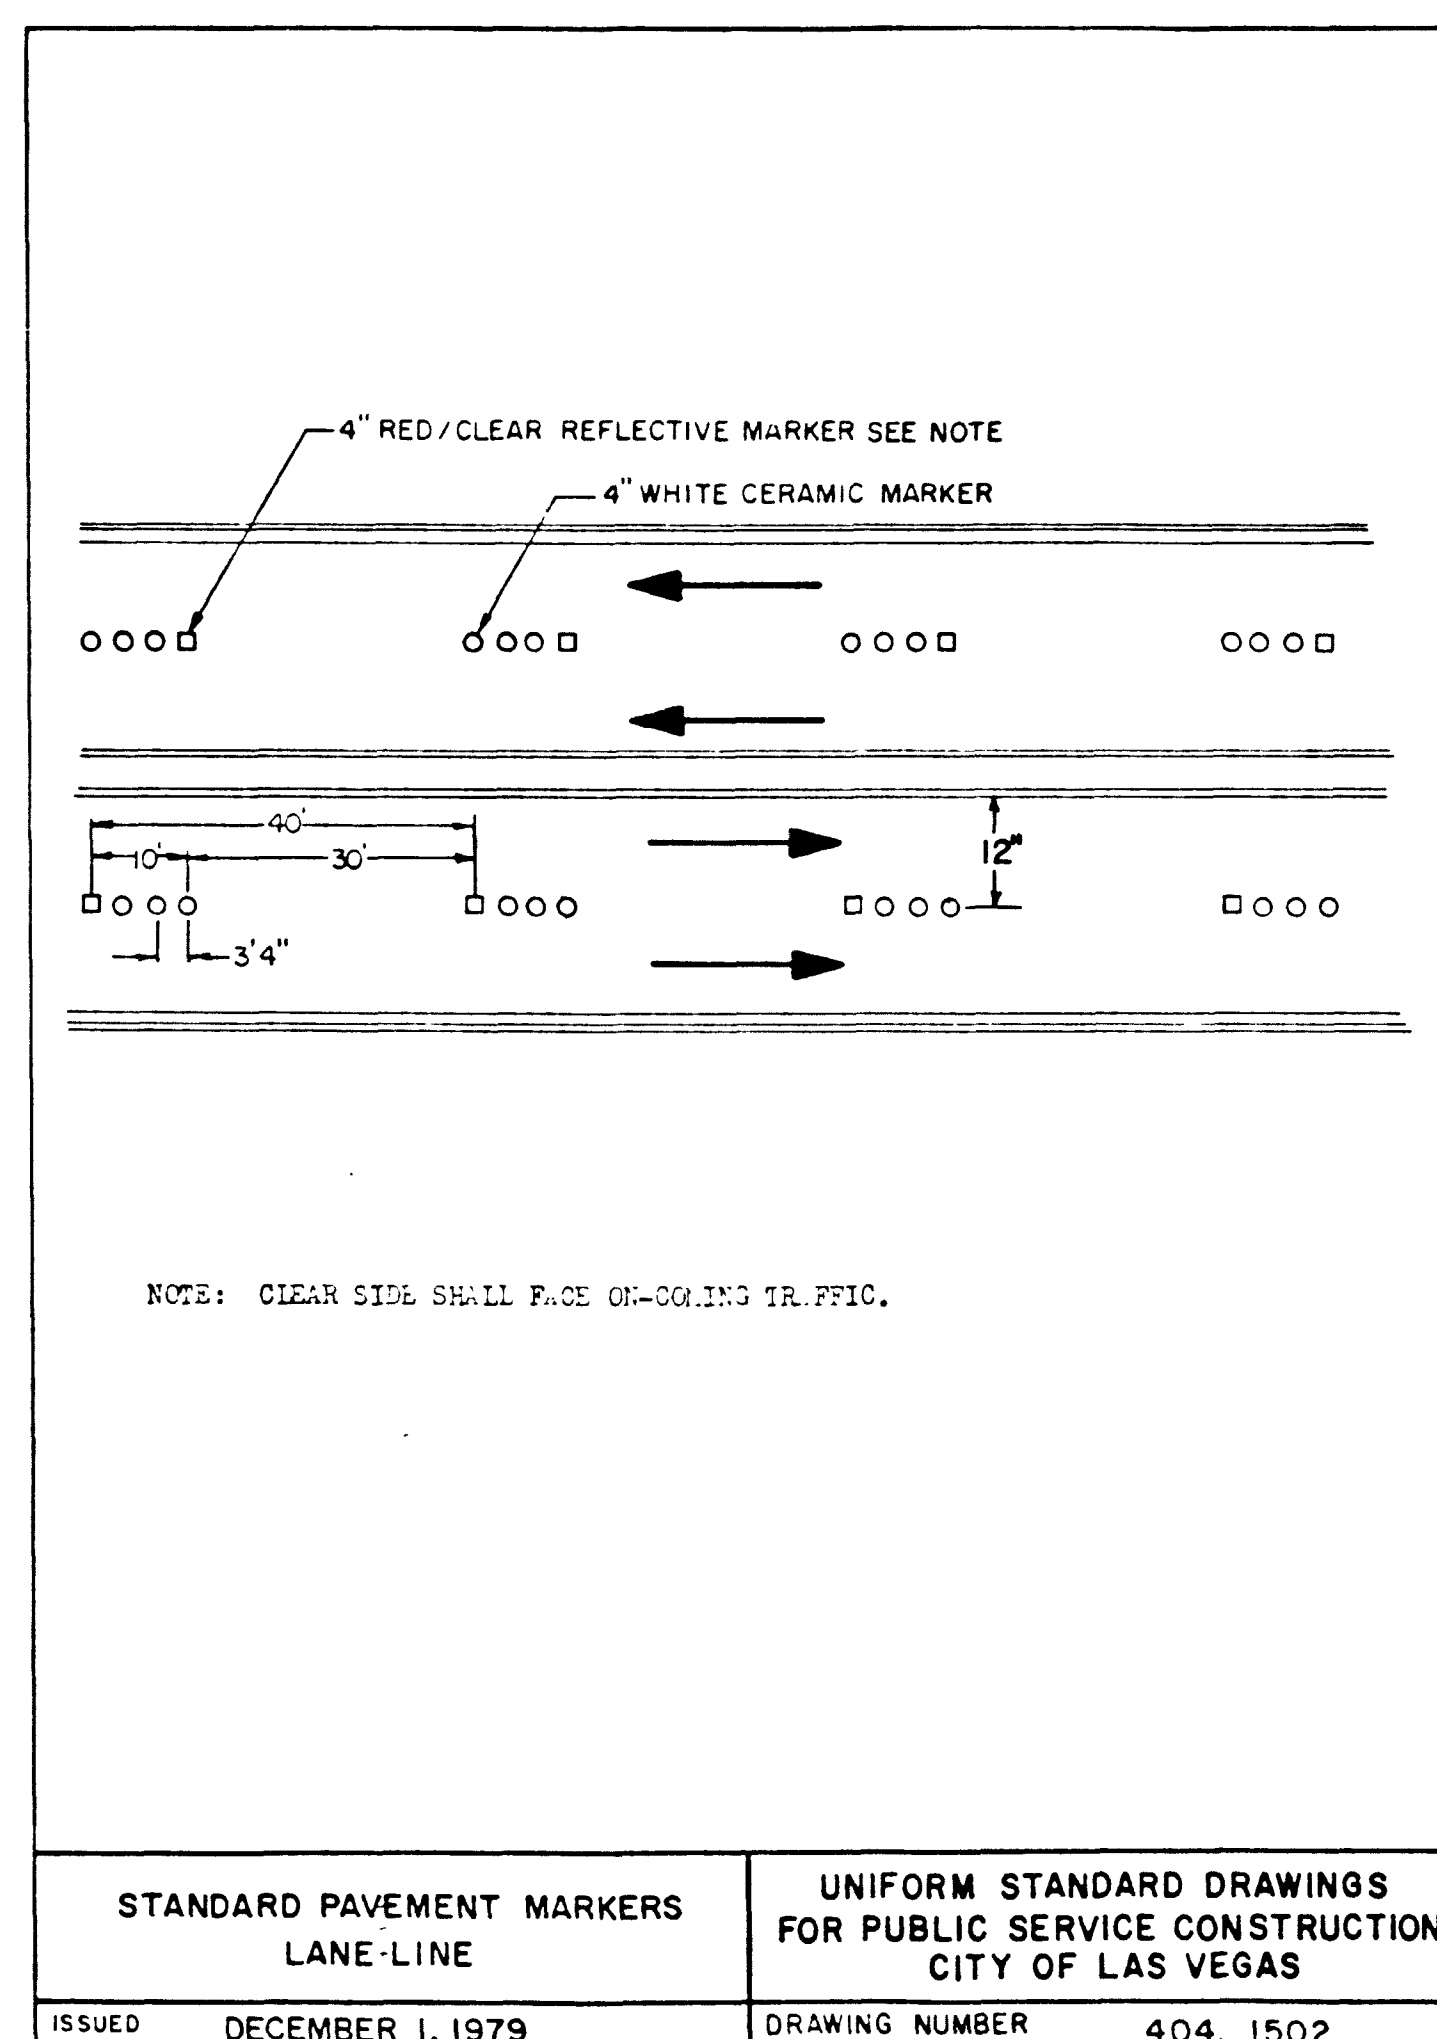
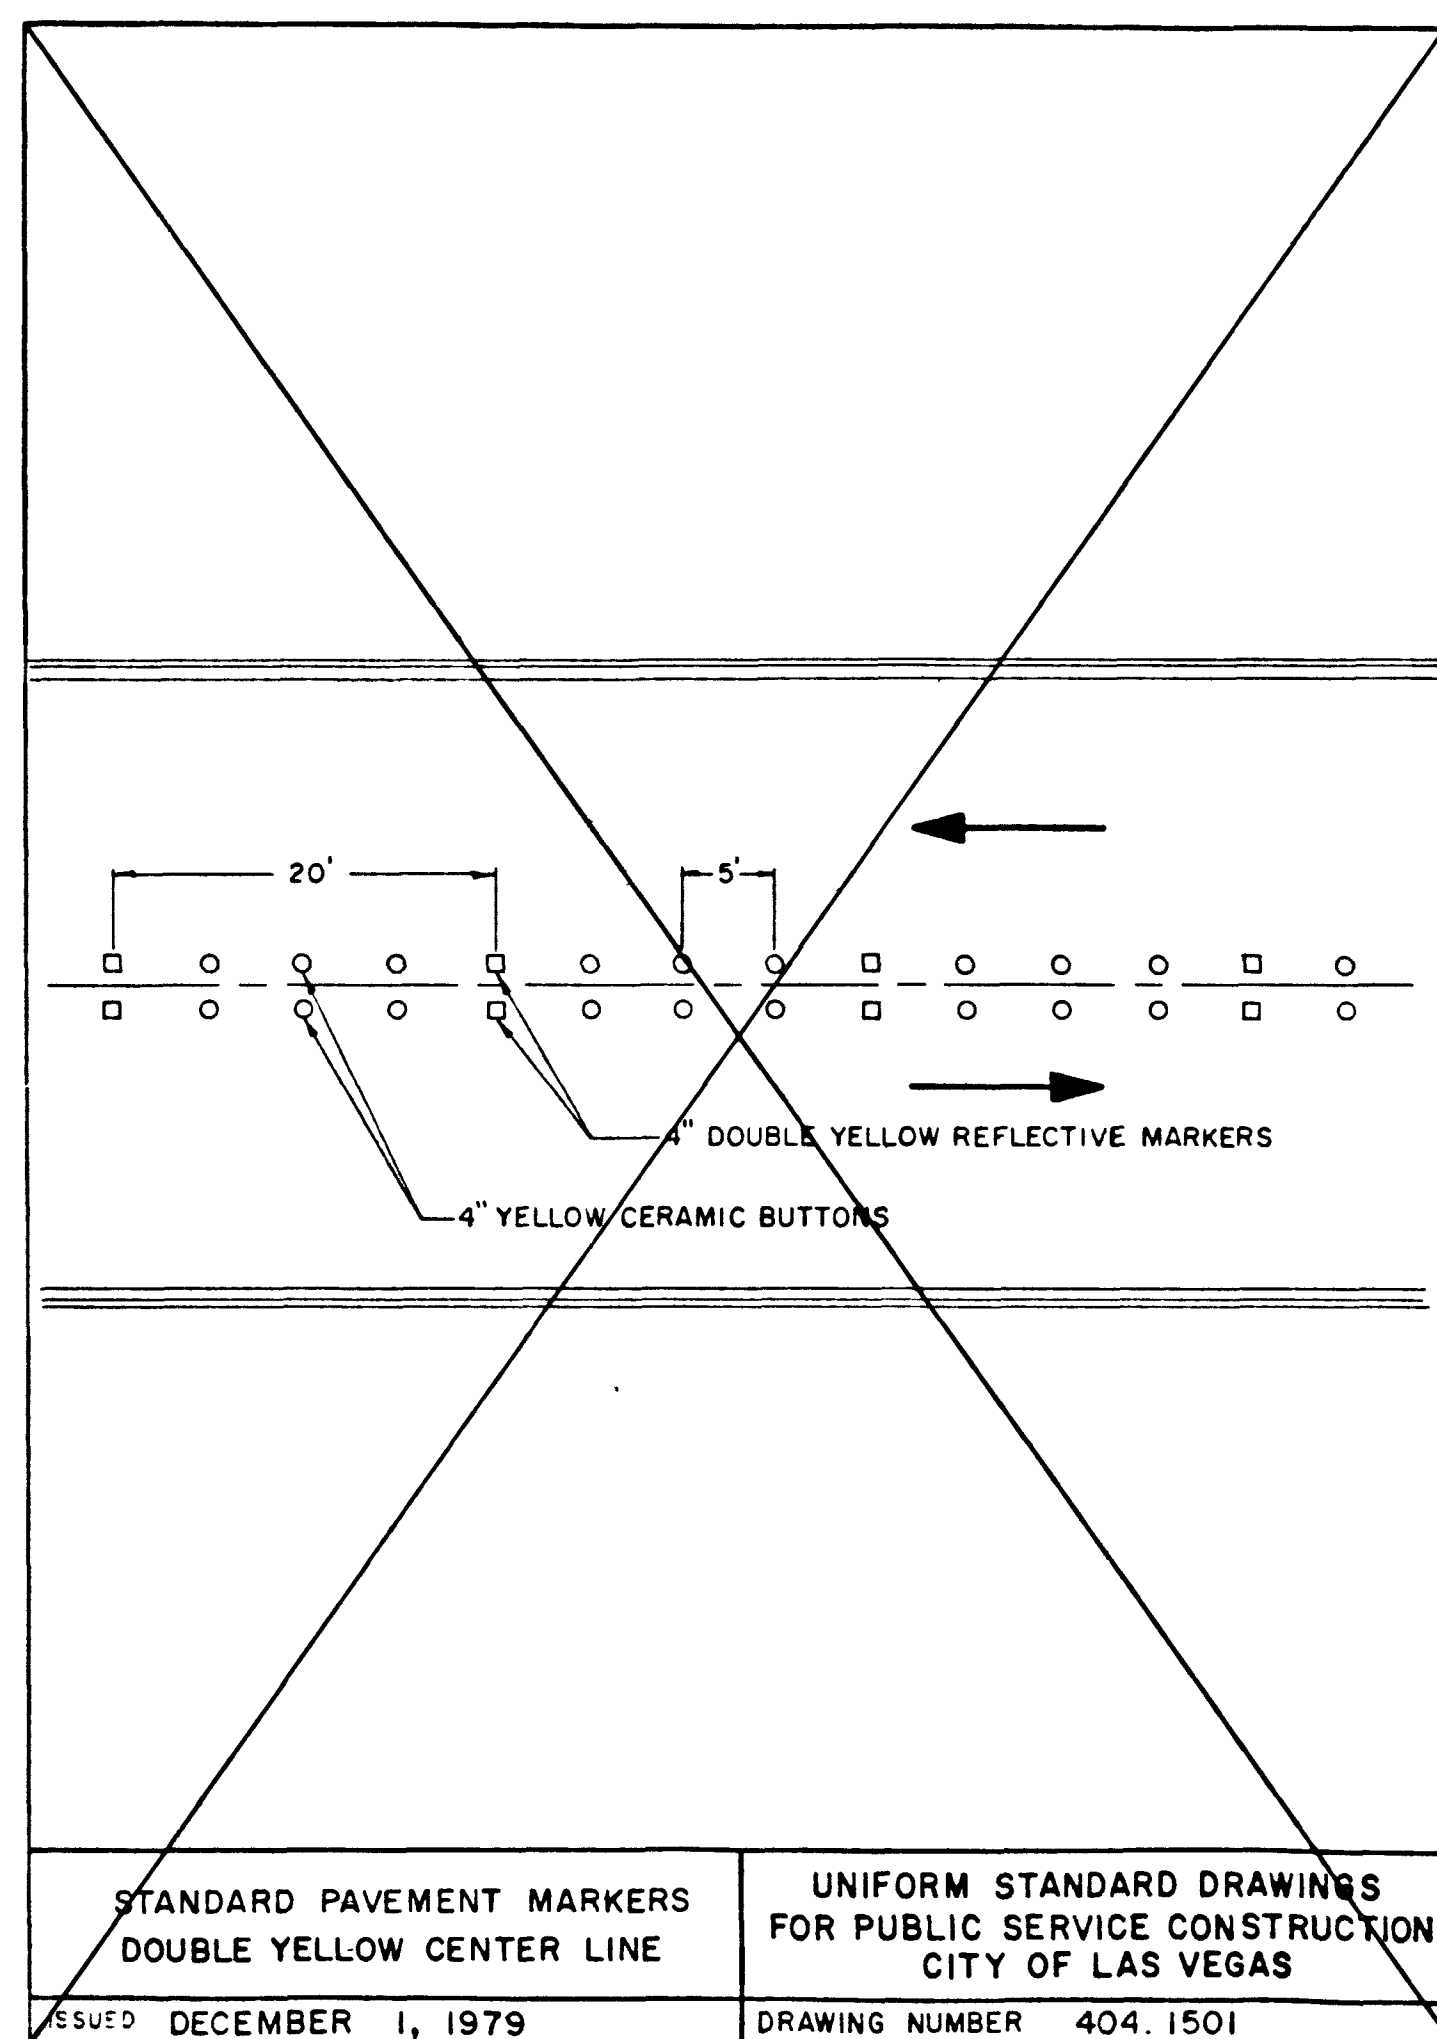
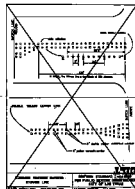
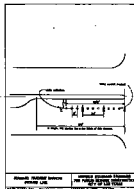
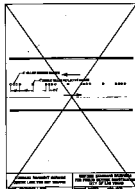
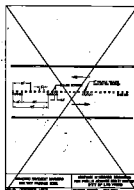
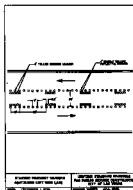


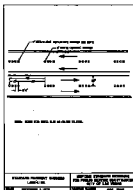

CITY OF LAS VEGAS NEVADA			
DEPARTMENT OF PUBLIC WORKS			
TRAFFIC ENGINEERING DIVISION			
TRAFFIC DETAILS			
W.O. NO.	SCALE	DATE	DRAWING NO.
DR.			107-V1648
APPROVED BY TRAFFIC ENGINEER		FILE NO.	
APPROVED BY DIRECTOR OF PUBLIC WORKS		SHEET 19 OF 37	

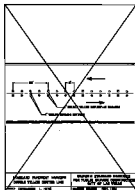

CITY OF LAS VEGAS, NEVADA
DEPARTMENT OF PUBLIC WORKS
TRAFFIC ENGINEERING DIVISION
TRAFFIC DETAILS

SECTION 1-100


