


JOB NO. 122-4/20 FILE _____ DC

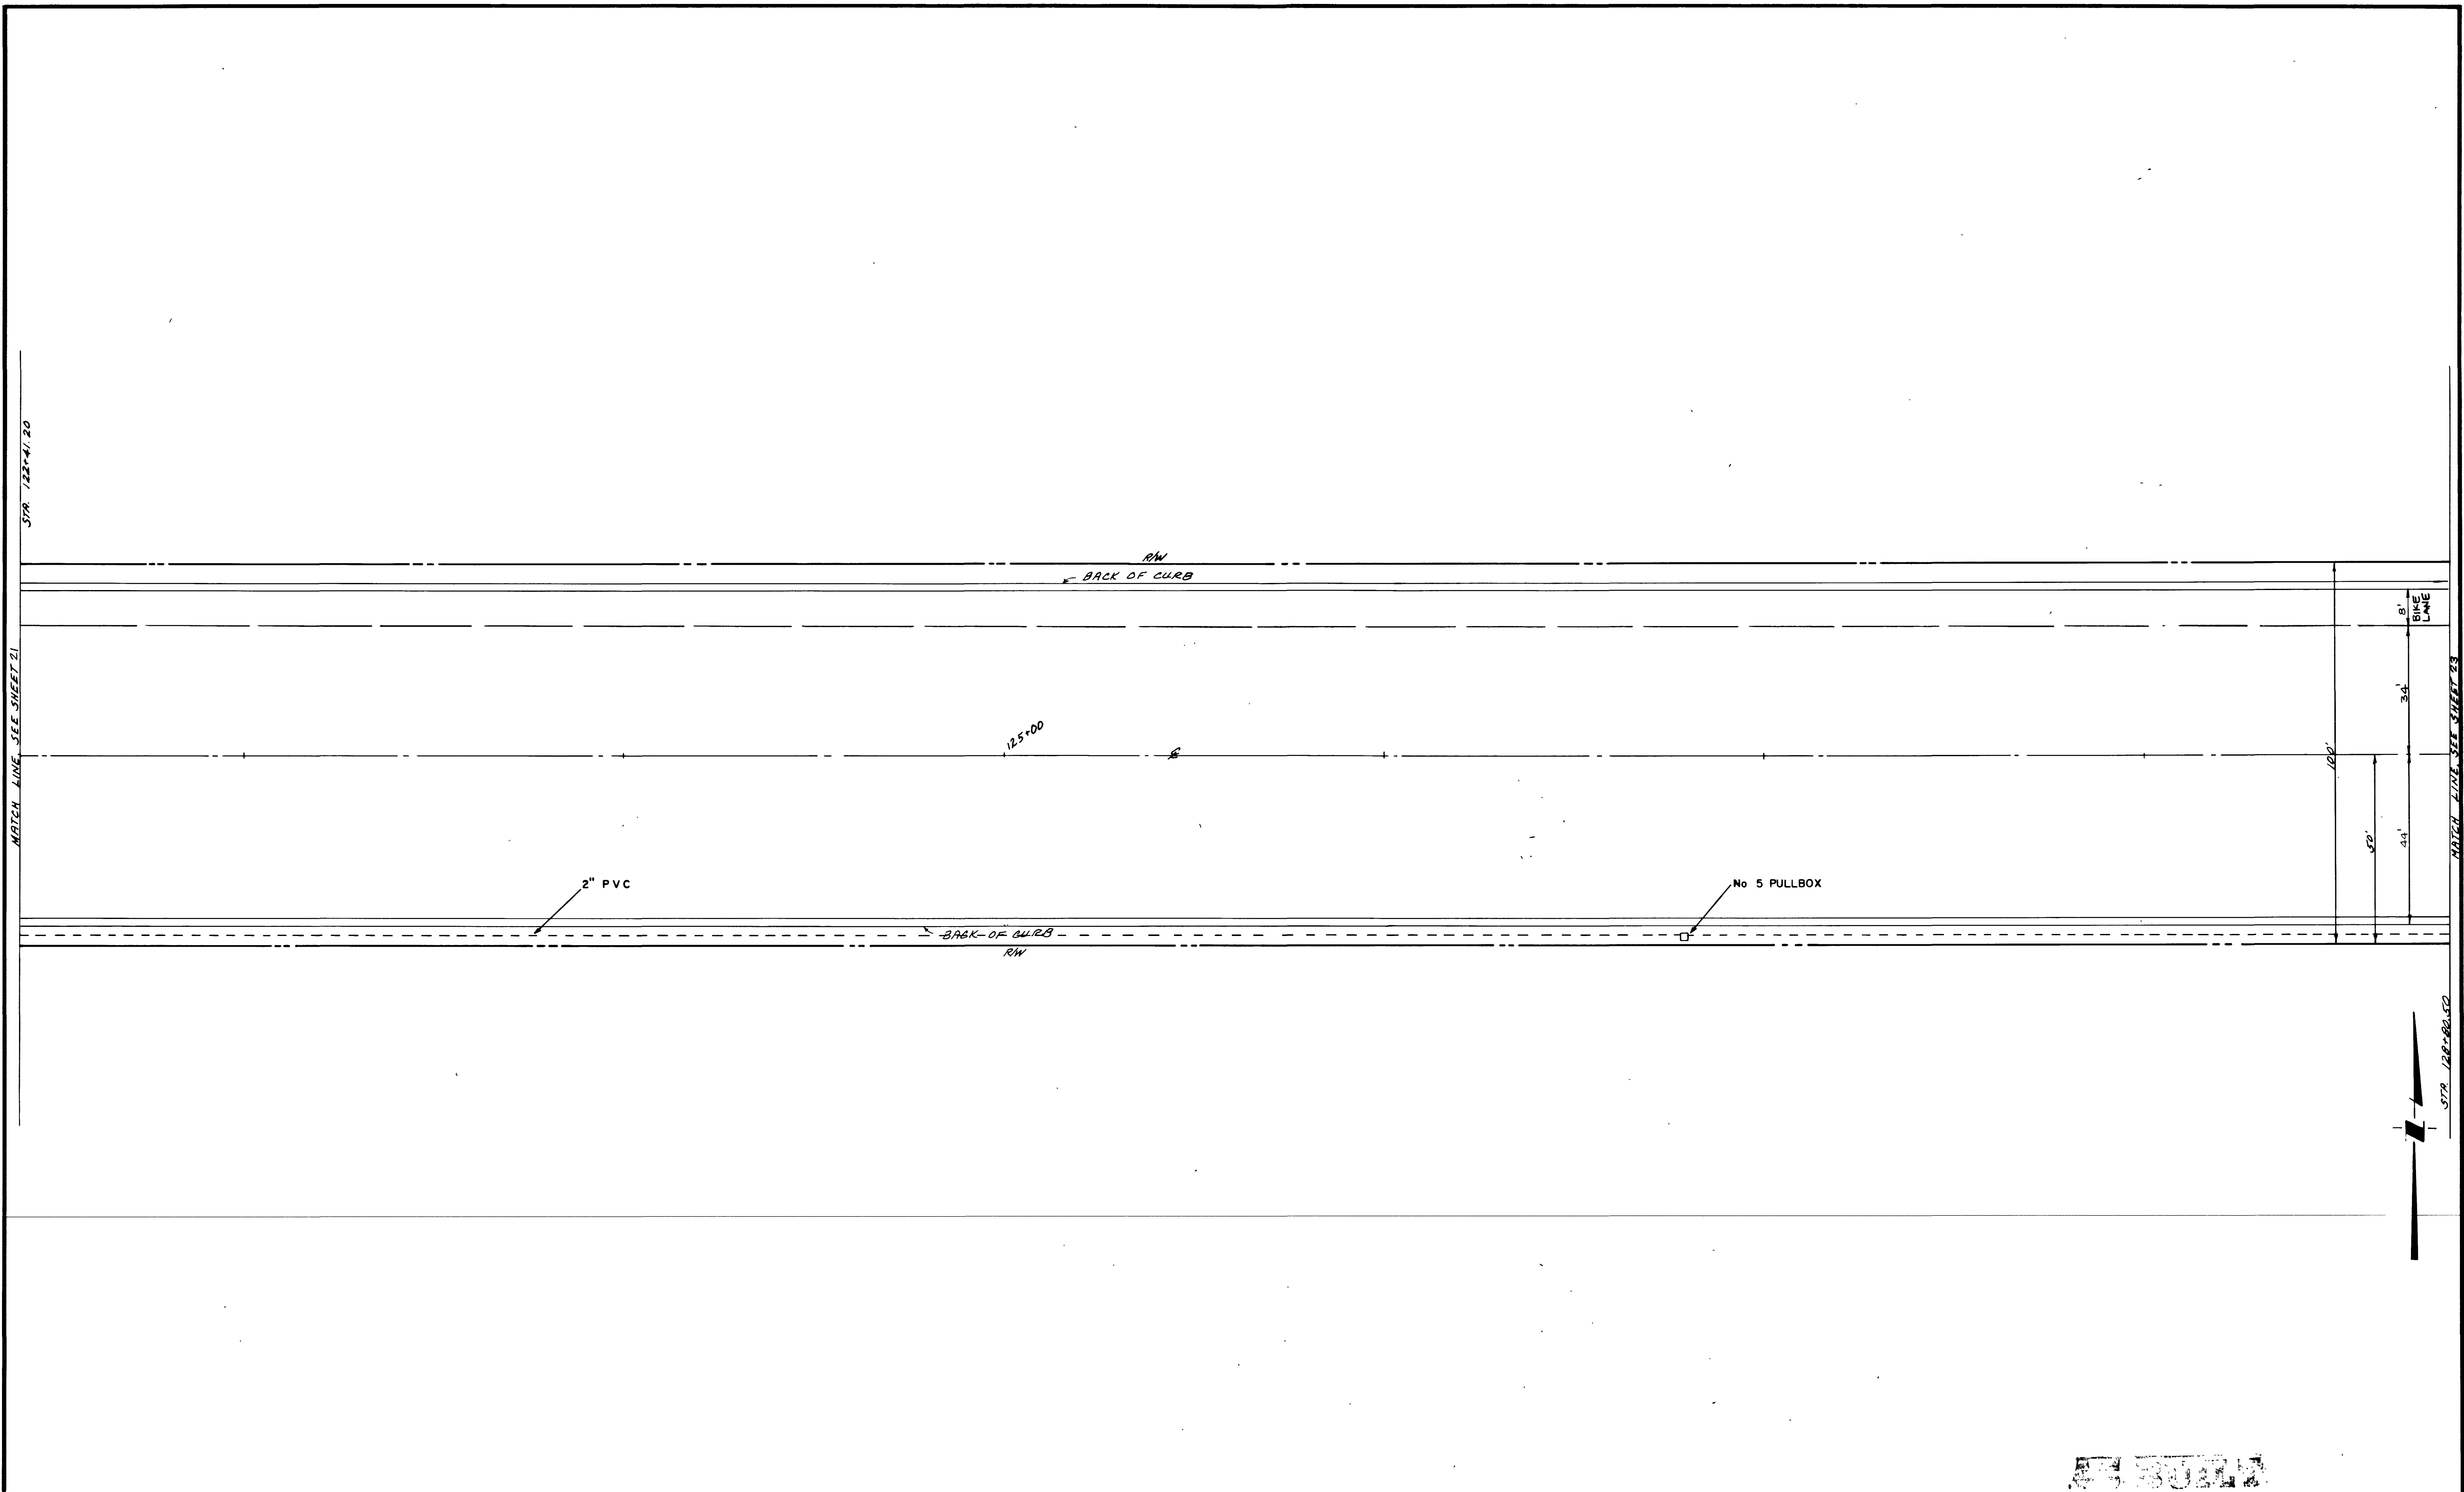

<table border="1"><thead><tr><th>REV</th><th>DATE</th><th>BY</th><th>DESCRIPTION</th></tr></thead><tbody><tr><td> </td><td> </td><td> </td><td> </td></tr><tr><td> </td><td> </td><td> </td><td> </td></tr><tr><td> </td><td> </td><td> </td><td> </td></tr></tbody></table>				REV	DATE	BY	DESCRIPTION													SCALE: 1"=20'	DESIGNED _____	SUBMITTED _____		
				REV	DATE	BY	DESCRIPTION																	
DRAWN <i>L. ROSENSTRAUCH</i>	PROJECT ENGINEER _____ R.C.E. NO. _____ DATE _____	RECOMMENDED _____																						
CHECKED _____	JAMES M. MONTGOMERY CONSULTING ENGINEERS, INC. R.C.E. NO. _____ DATE _____																							
2915 WEST CHARLESTON BLVD., LAS VEGAS, NEVADA 89102																								
					APPROVED _____ DATE _____		CITY OF LAS VEGAS		SHEET 22 OF 37 SHEETS															
					APPROVED _____ DATE _____		WEST CHARLESTON BLVD. TRAFFIC DELINEATION INTERCONNECT AND SIGNING																	

12-3-117

107-V1648