


JOB NO. 1540.00371 FILE 00

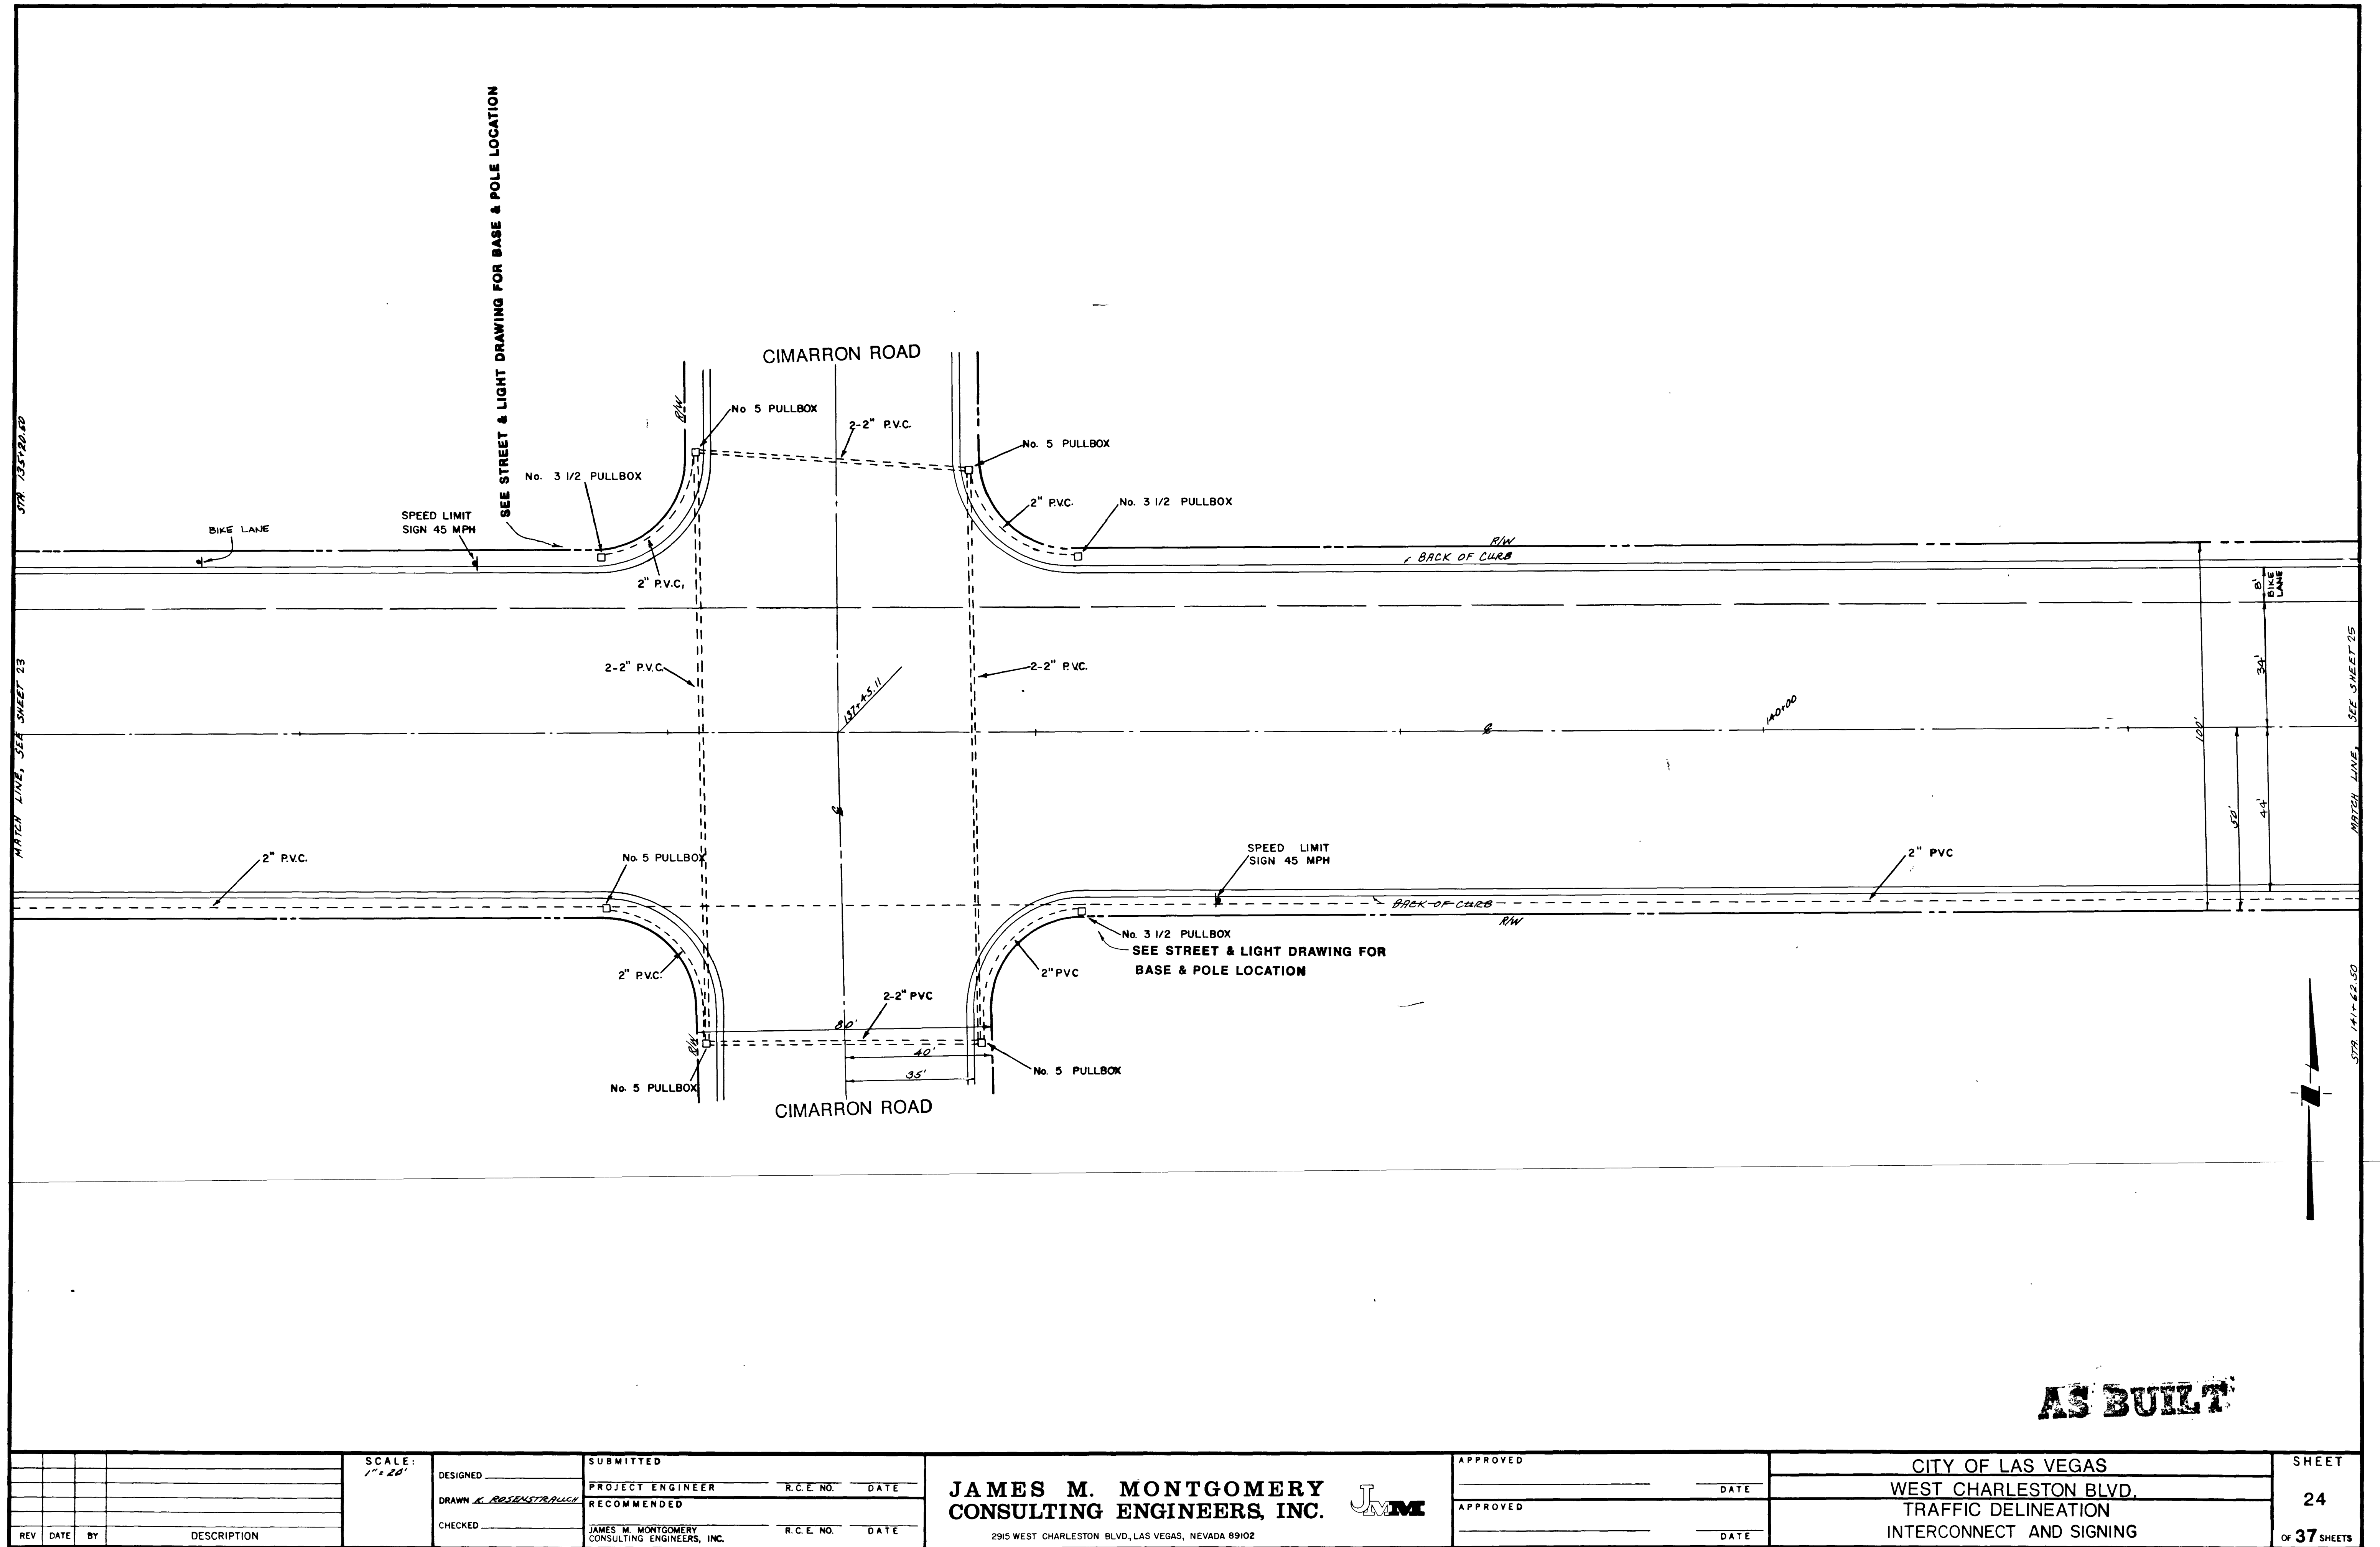

|                         |  
|-------------------------|--|--|--|---|--|--|--|---|--|--|--|----------------|--|--|--|--------------------------|--|--|--|--------------|--|
| SCALE: 1" = 20'         |  |  |  | DESIGNED _____                                                                                     |  |  |  | SUBMITTED _____                                                                                    |  |  |  | APPROVED _____ |  |  |  | CITY OF LAS VEGAS        |  |  |  | SHEET        |  |
| DRAWN K. ROSENTHAL      |  |  |  | PROJECT ENGINEER _____ R.C.E. NO. _____ DATE _____                                                 |  |  |  | RECOMMENDED _____                                                                                  |  |  |  | APPROVED _____ |  |  |  | WEST CHARLESTON BLVD.    |  |  |  | 24           |  |
| CHECKED _____           |  |  |  | JAMES M. MONTGOMERY CONSULTING ENGINEERS, INC. R.C.E. NO. _____ DATE _____                         |  |  |  | JAMES M. MONTGOMERY CONSULTING ENGINEERS, INC. R.C.E. NO. _____ DATE _____                         |  |  |  | APPROVED _____ |  |  |  | TRAFFIC DELINEATION      |  |  |  | OF 37 SHEETS |  |
| REV DATE BY DESCRIPTION |  |  |  | JAMES M. MONTGOMERY CONSULTING ENGINEERS, INC. 2915 WEST CHARLESTON BLVD., LAS VEGAS, NEVADA 89102 |  |  |  | JAMES M. MONTGOMERY CONSULTING ENGINEERS, INC. 2915 WEST CHARLESTON BLVD., LAS VEGAS, NEVADA 89102 |  |  |  | APPROVED _____ |  |  |  | INTERCONNECT AND SIGNING |  |  |  |              |  |

