



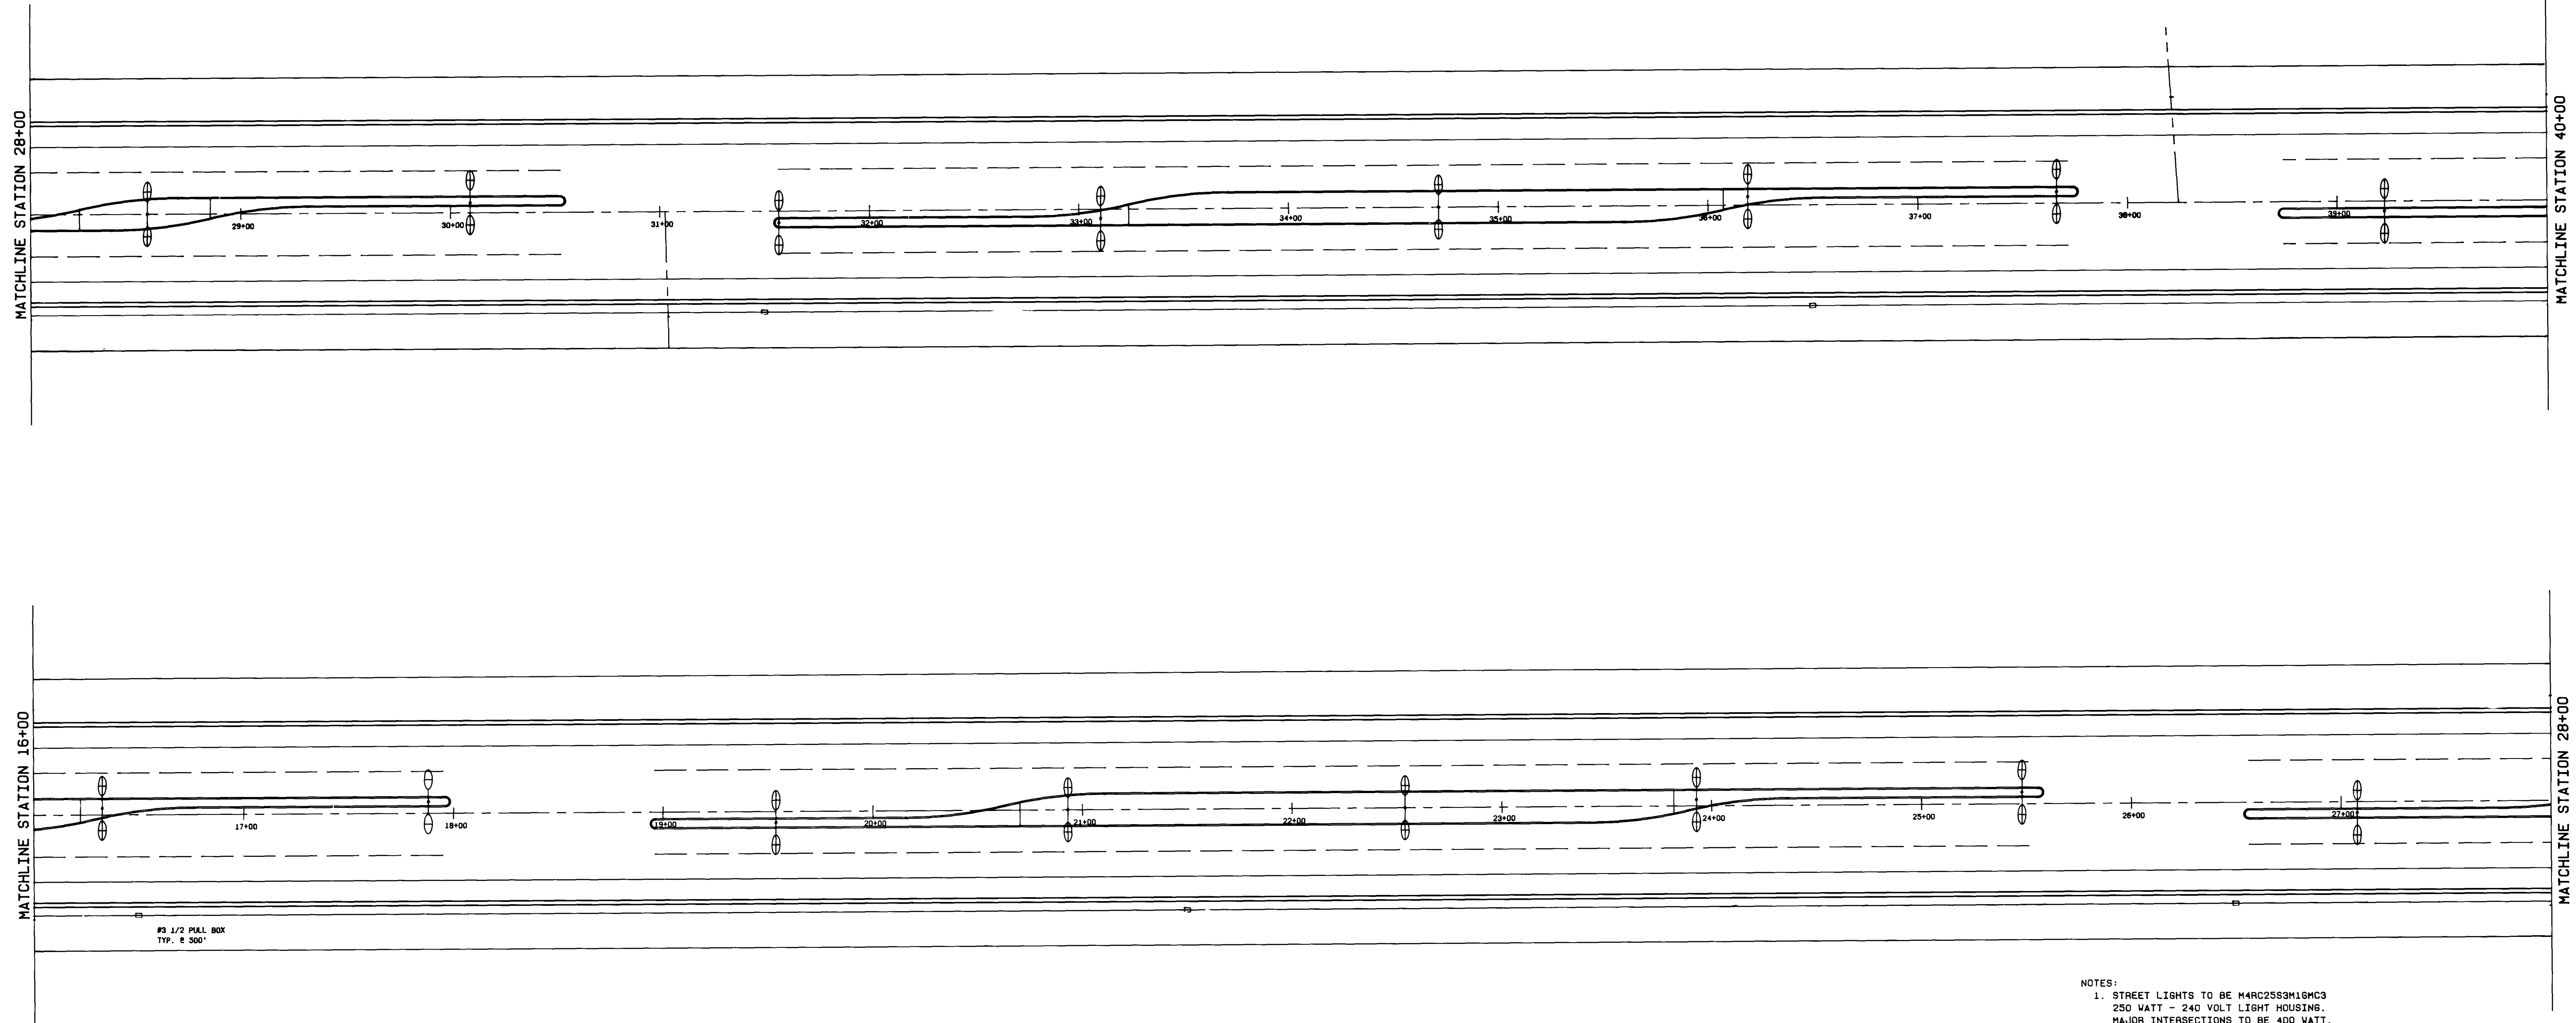

- NOTES:
1. STREET LIGHTS TO BE HARC2SSM15MCS
250 WATT - 240 VOLT LIGHT HOUSING.
MAJOR INTERSECTIONS TO BE 400 WATT.
 2. FOR STREET LIGHT LOCATION SEE SHEETS
C3 - C20 FOR STATIONING.

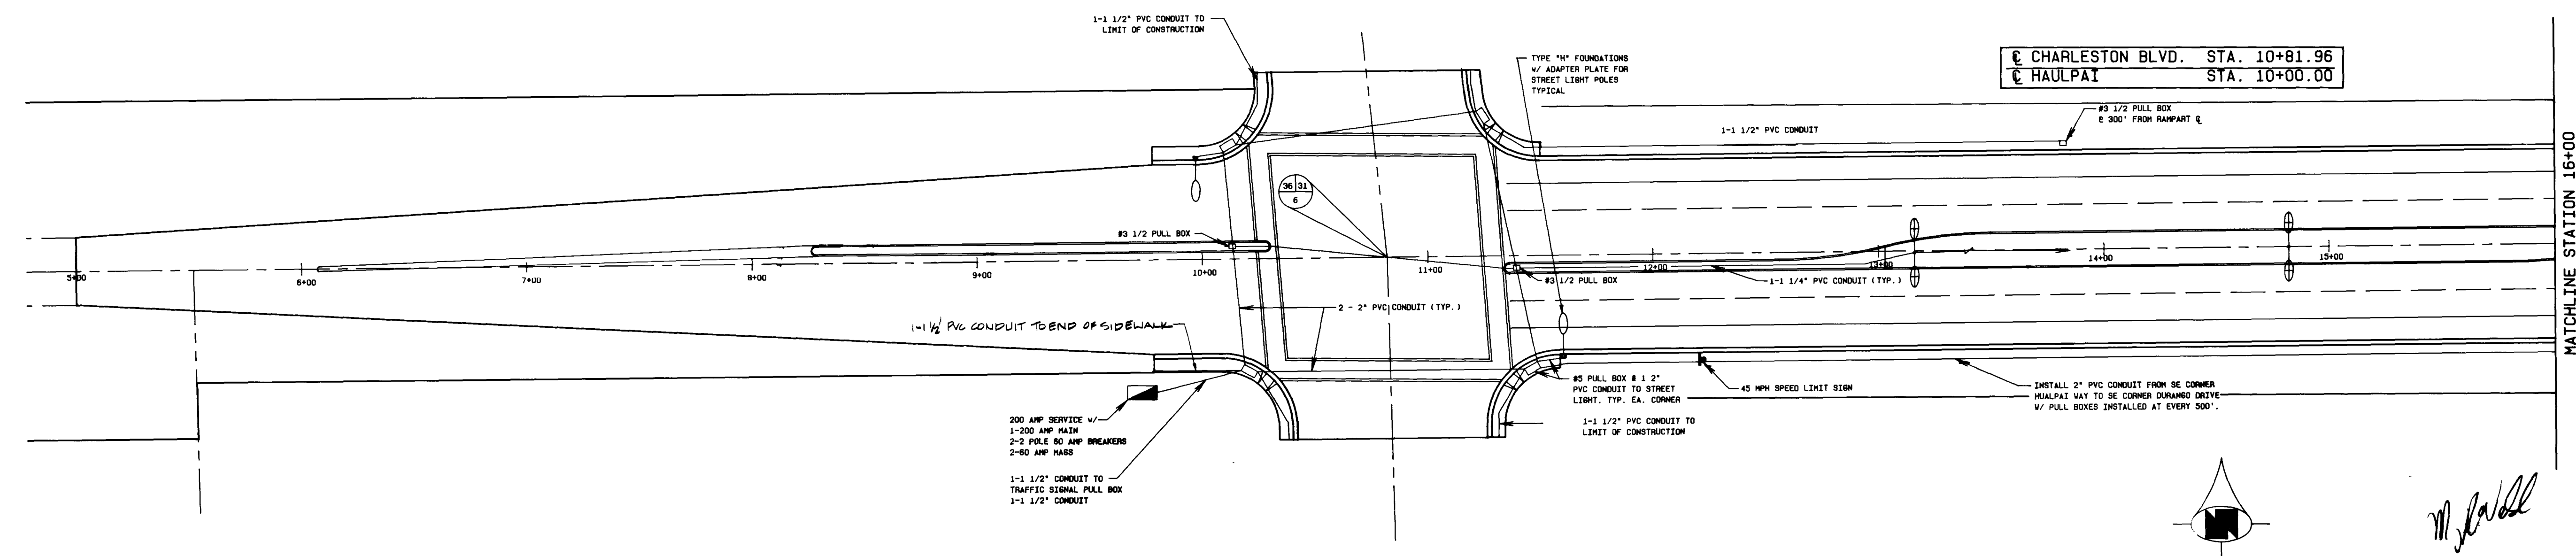

ENGINEER'S STAMP		NAME		DATE	
REVISION		REV		DATE	
BY		BY		DATE	
1		06/19/89		REV PER CIV REV B/L ADD NOTE	

CONSULTING ENGINEERS - PLANNERS
2300 PASEO DEL PRADO BUILDING A SUITE 100
LAS VEGAS, NEVADA 89102 PHONE (702) 873-7550

vtm nevada

TITLE
TRAFFIC DELINEATION PLAN

PROJECT
WEST CHARLESTON BOULEVARD
HAULPAT WAY TO DURANGO DRIVE

WO NO. 3464
BY MH/RB
DATE 06/19/89
SCALE 1" = 40' H.

SHEET 28
C26
OF 29 SHEETS

107-V-1071

15.3-31

