


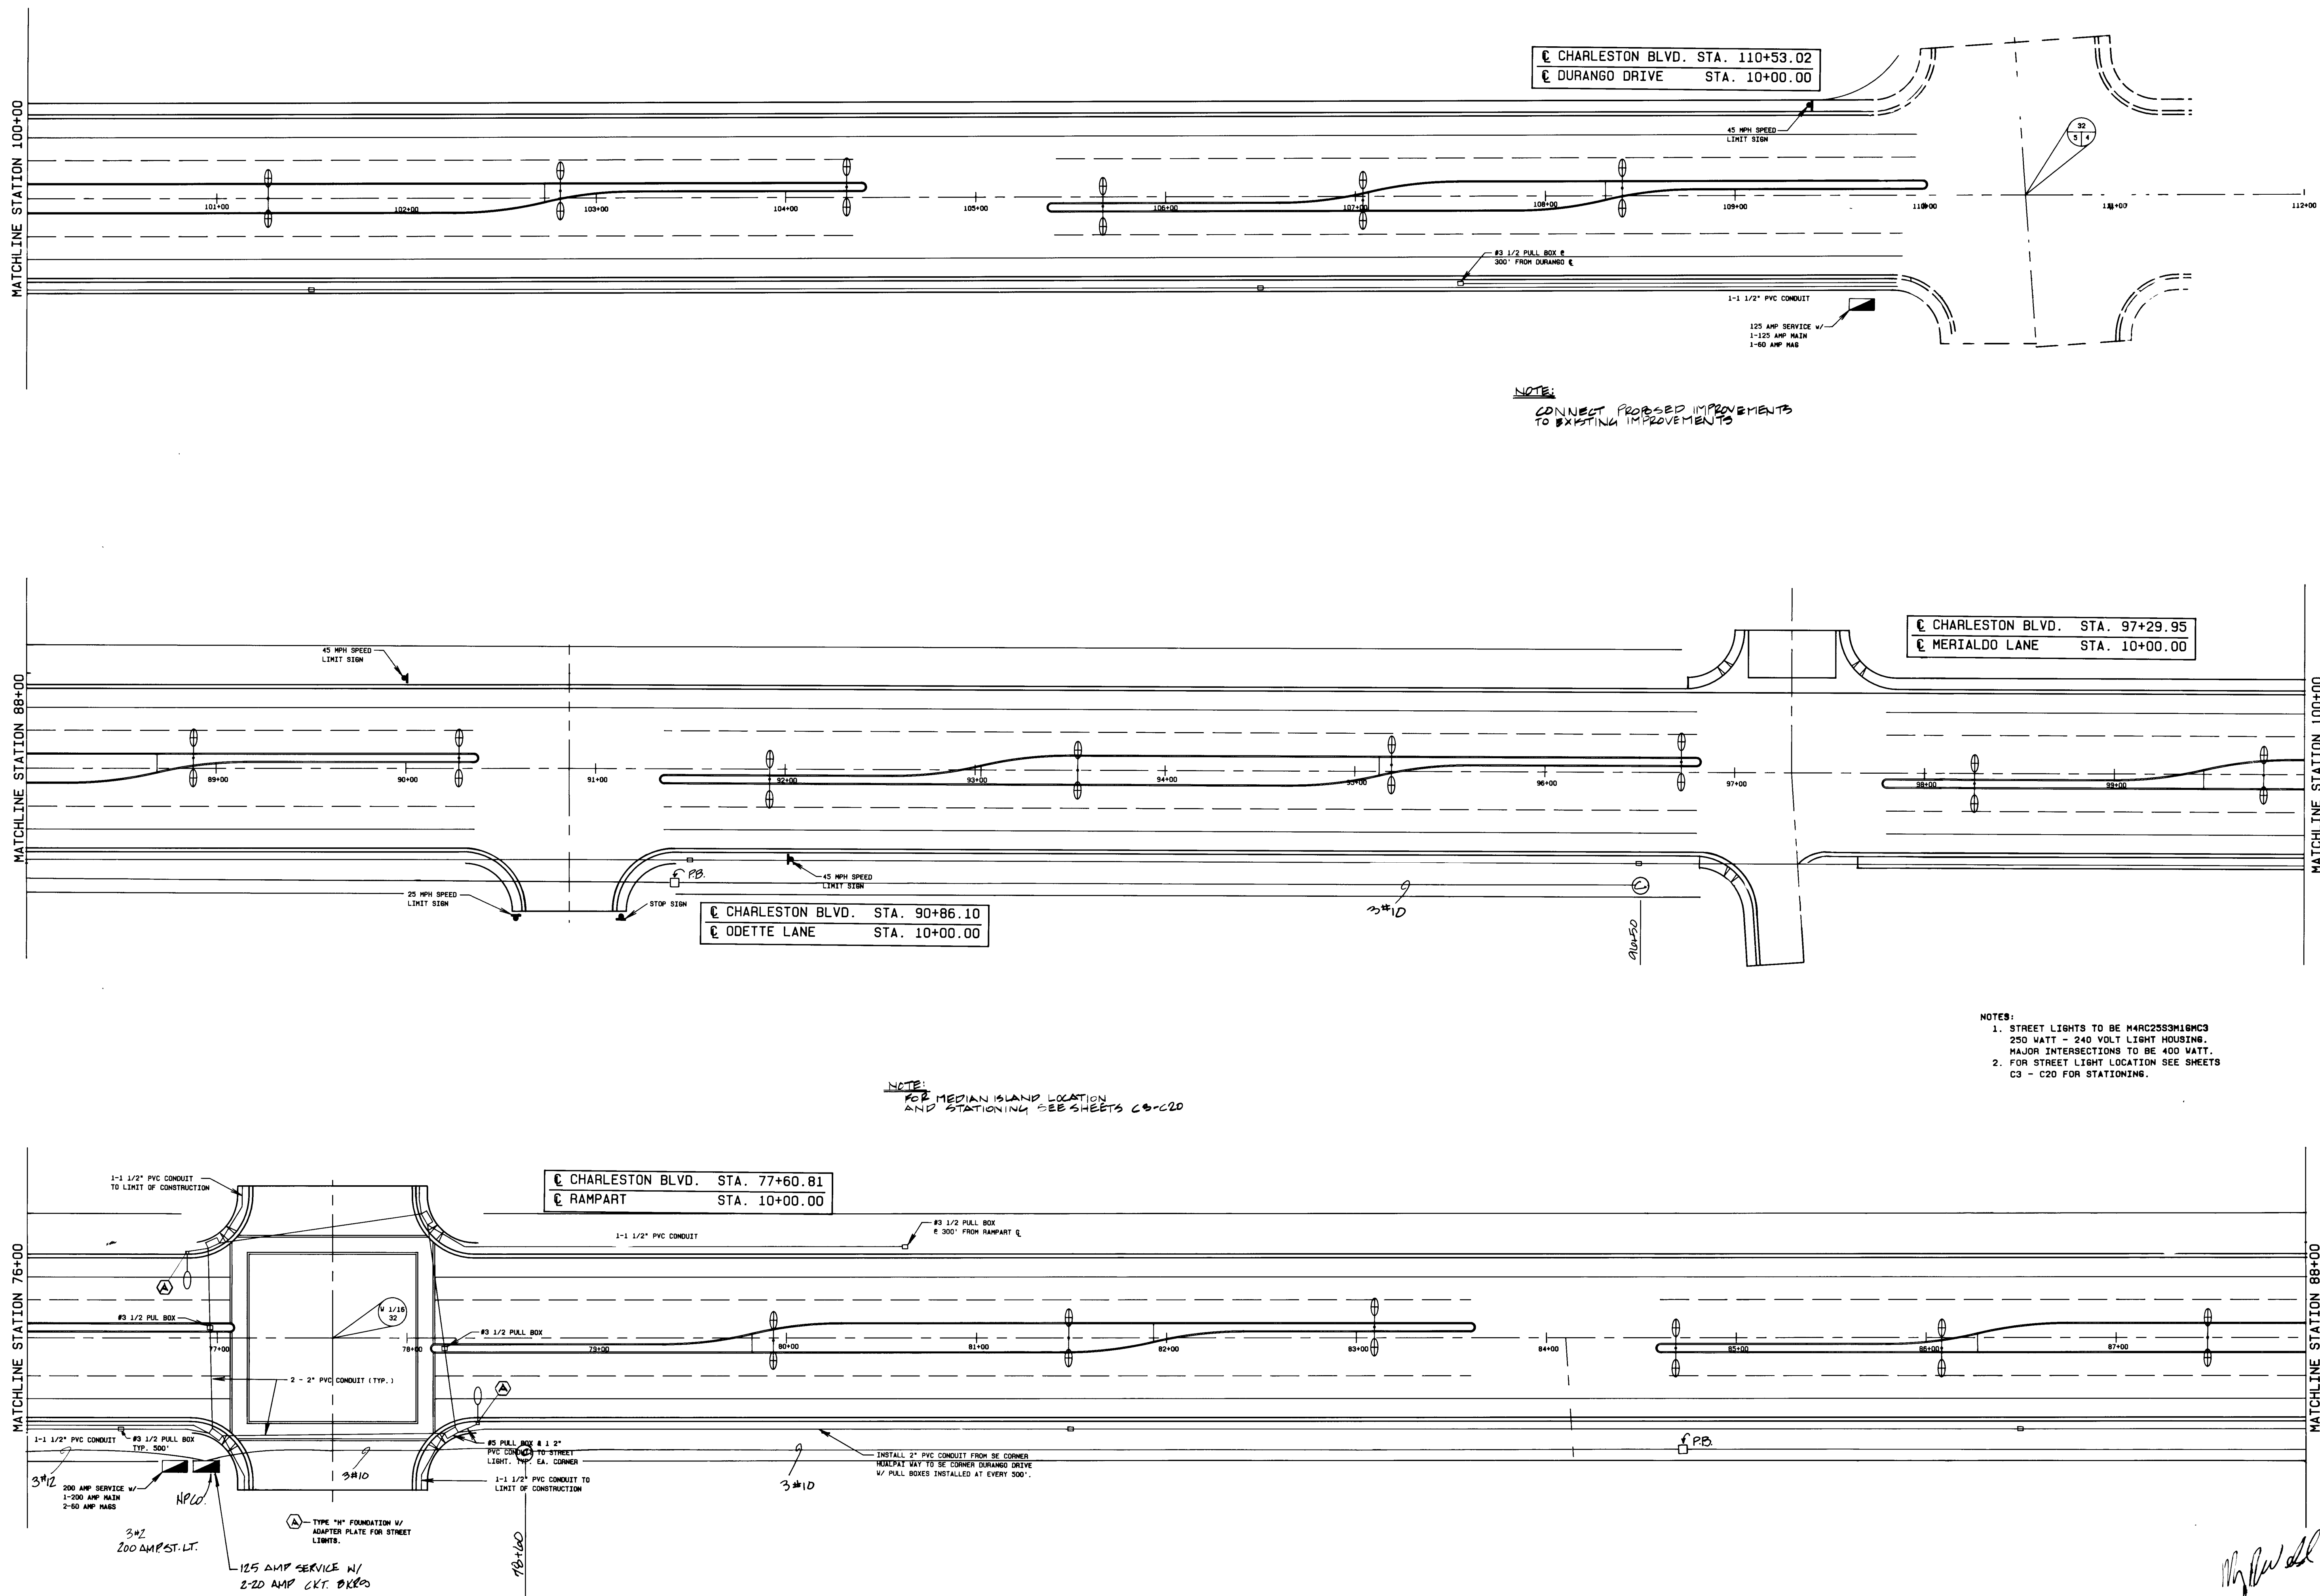

CHARLESTON BLVD. STA. 110+53.02
DURANGO DRIVE STA. 10+00.00

CHARLESTON BLVD. STA. 97+29.95
MERIALDO LANE STA. 10+00.00

CHARLESTON BLVD. STA. 90+86.10
ODETTE LANE STA. 10+00.00

CHARLESTON BLVD. STA. 77+60.81
RAMPART STA. 10+00.00

NOTE:
CONNECT PROPOSED IMPROVEMENTS
TO EXISTING IMPROVEMENTS

NOTE:
FOR MEDIAN ISLAND LOCATION
AND STATIONING SEE SHEETS C9-C20

NOTES:
1. STREET LIGHTS TO BE HARC25S3M18MC3
250 WATT - 240 VOLT LIGHT HOUSING.
MAJOR INTERSECTIONS TO BE 400 WATT.
2. FOR STREET LIGHT LOCATION SEE SHEETS
C9 - C20 FOR STATIONING.

ENGINEER'S STAMP

NAME _____ DATE _____

vtm nevada

CONSULTING ENGINEERS - PLANNERS

2300 PASEO DEL PRADO BUILDING A SUITE 100
LAS VEGAS, NEVADA 89102 PHONE (702) 873-7550

TITLE

TRAFFIC DELINEATION PLAN

PROJECT

WEST CHARLESTON BOULEVARD
HUALPAI WAY TO DURANGO DRIVE

NO. NO.

3464

BY

MH/RB

DATE

07/27 89

SCALE

1" = 40' H.

SHEET 29

C28

OF 29 SHEETS

107-V-1697

