


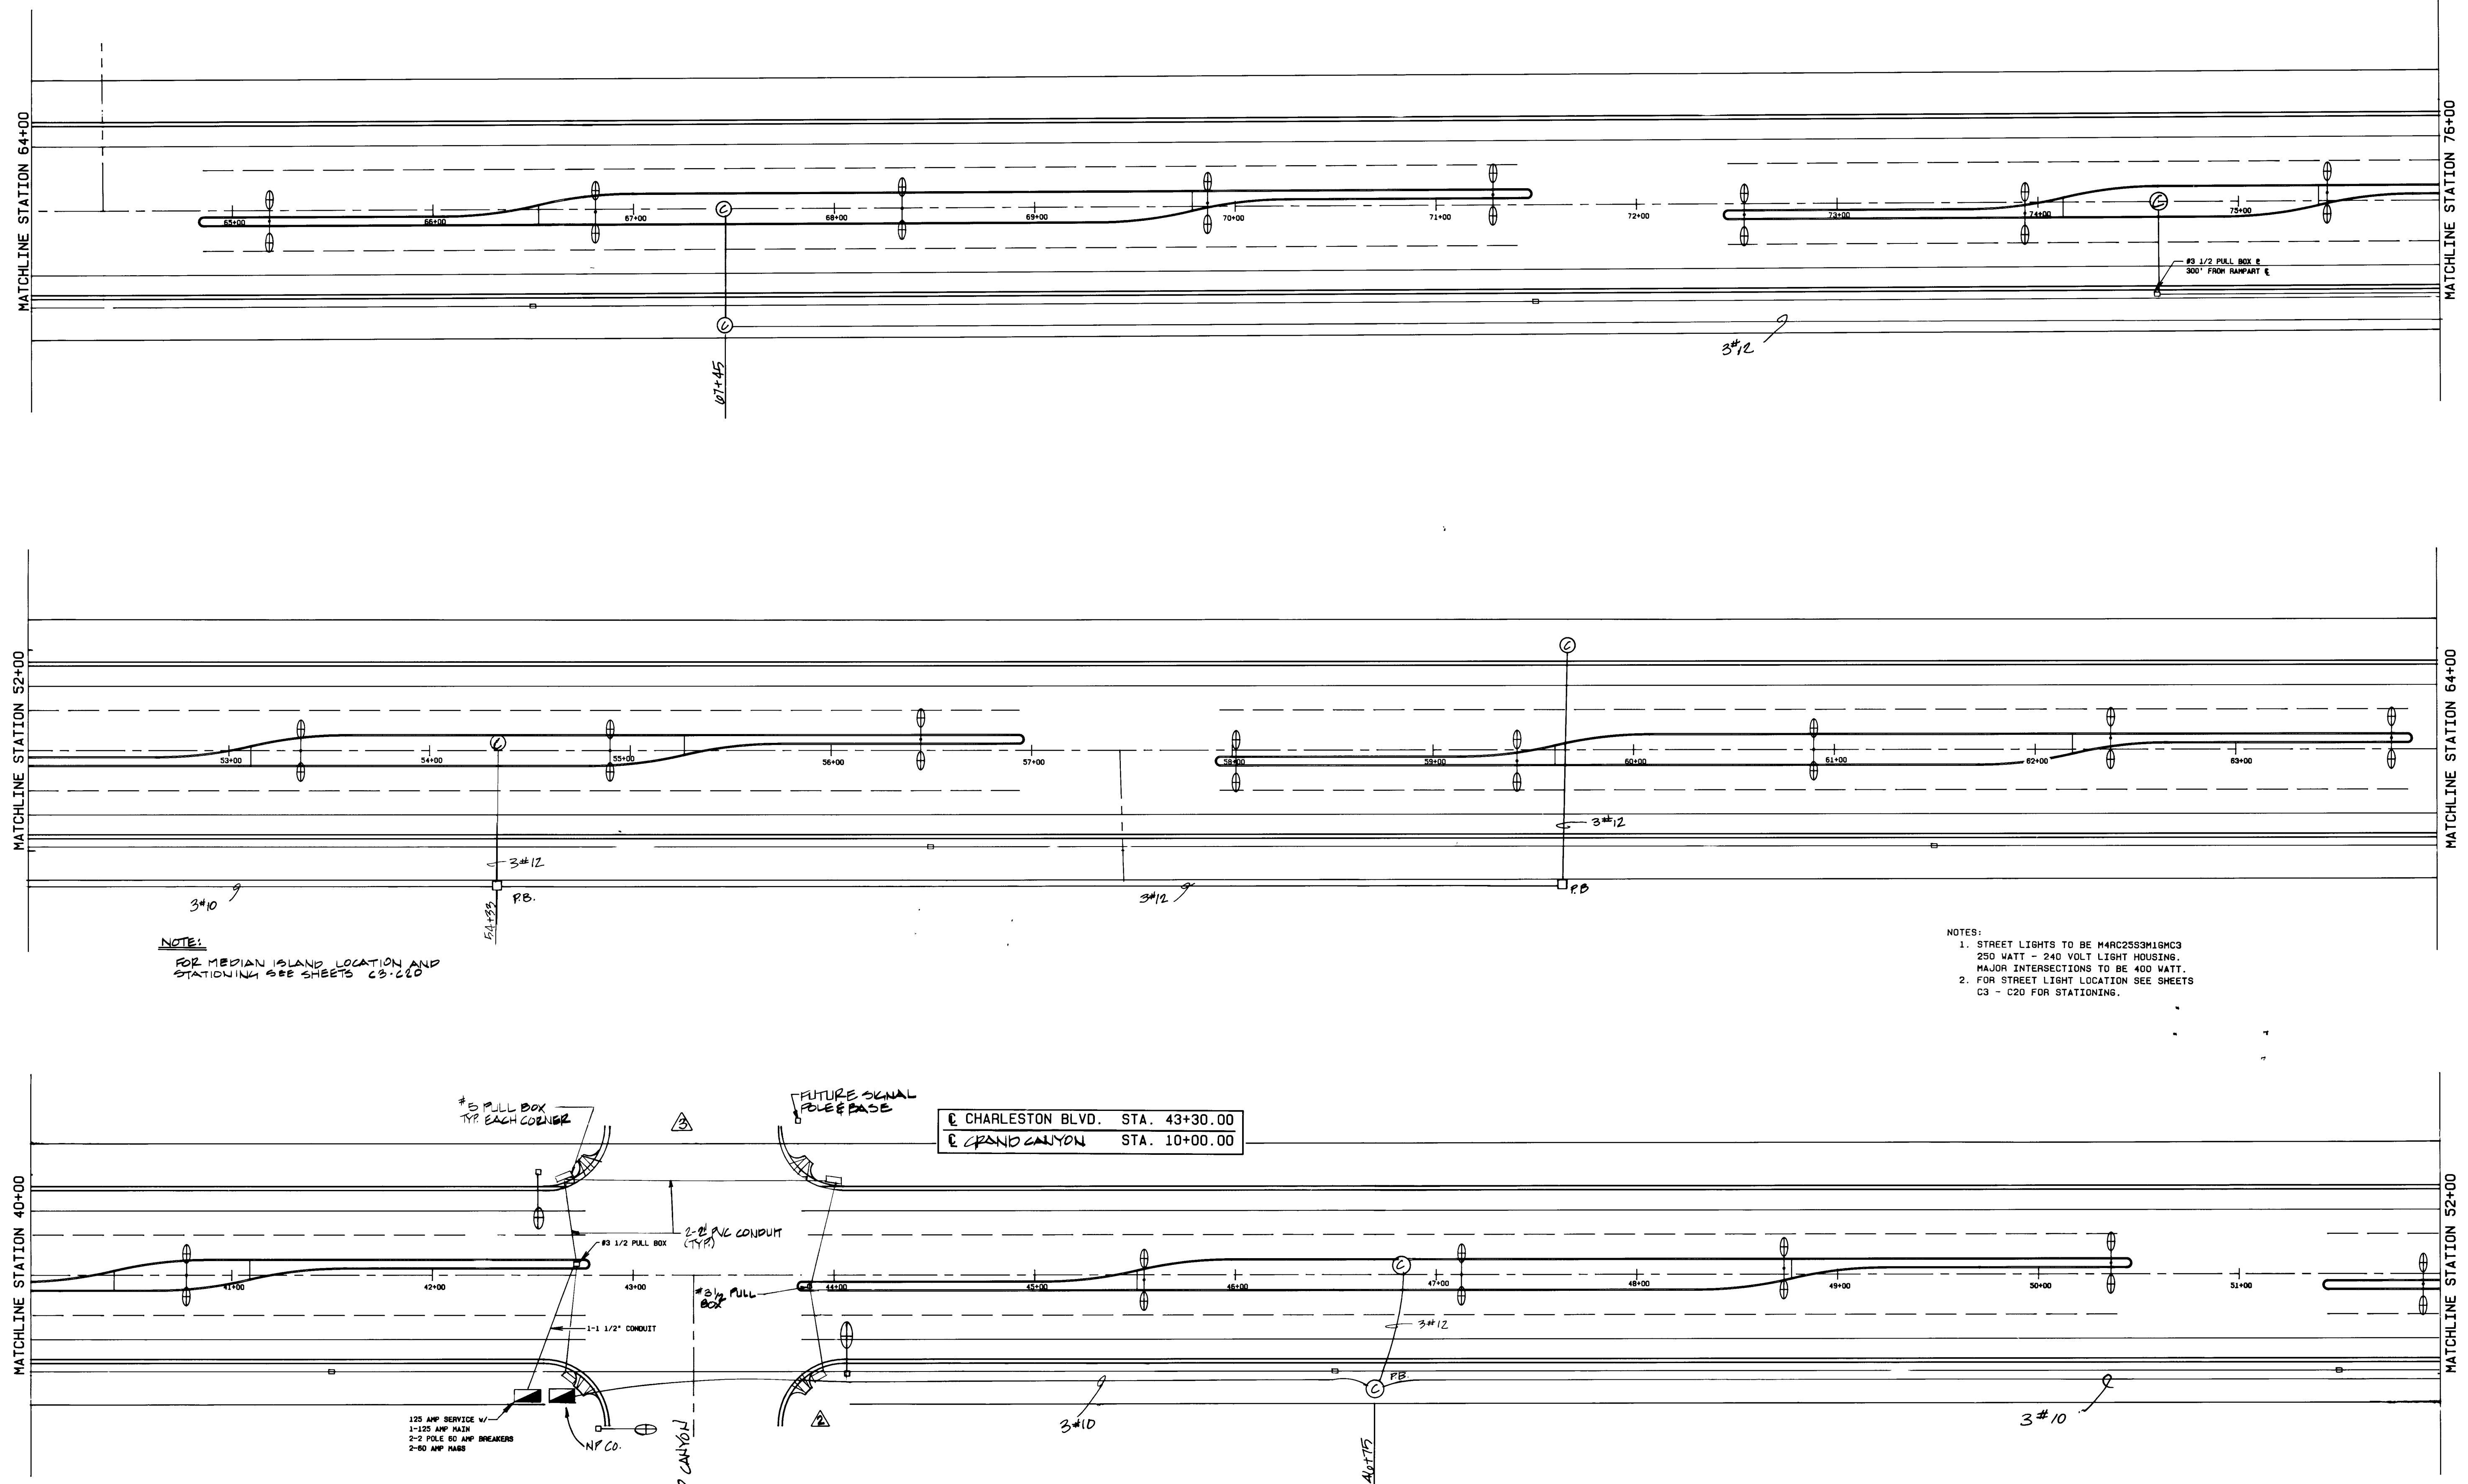

| REV | DATE     | BY  | REVISION                         |
|-----|----------|-----|----------------------------------|
| 1   | 12/19/00 | AVE | REV IRRIGATION CIRCUIT           |
| 2   | 12/3/00  | AVE | ADDED IRRIGATION CIRCUIT         |
| 3   | 4/9/00   | AVE | REV GRAND CANYON                 |
| 4   | 11/28/01 | AVE | ADD CONDUIT PULL BOXES PER STUDY |
| 5   | 10/28/04 | AVE | REV PULL BOX ADD NOTE            |

ENGINEER'S STAMP

NAME \_\_\_\_\_ DATE \_\_\_\_\_

**vtm** nevada

CONSULTING ENGINEERS - PLANNERS  
2300 PASEO DEL PRADO BUILDING A SUITE 100  
LAS VEGAS, NEVADA 89102 PHONE (702) 873-7550

TRAFFIC DELINEATION PLAN

PROJECT  
WEST CHARLESTON BOULEVARD  
HUALPAI WAY TO DURANGO DRIVE

|        |             |
|--------|-------------|
| WD NO. | 3464        |
| BY     | MH/RB       |
| DATE   | 06/19/89    |
| SCALE  | 1" = 40' H. |

SHEET 30

C27

OF 29 SHEETS

*Mythical*  
6/19/89

15, 3-32

107-V-1697

