
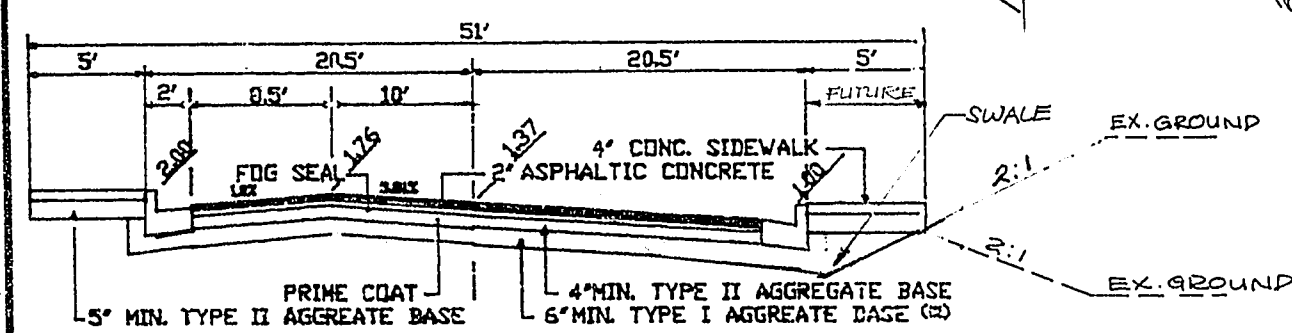


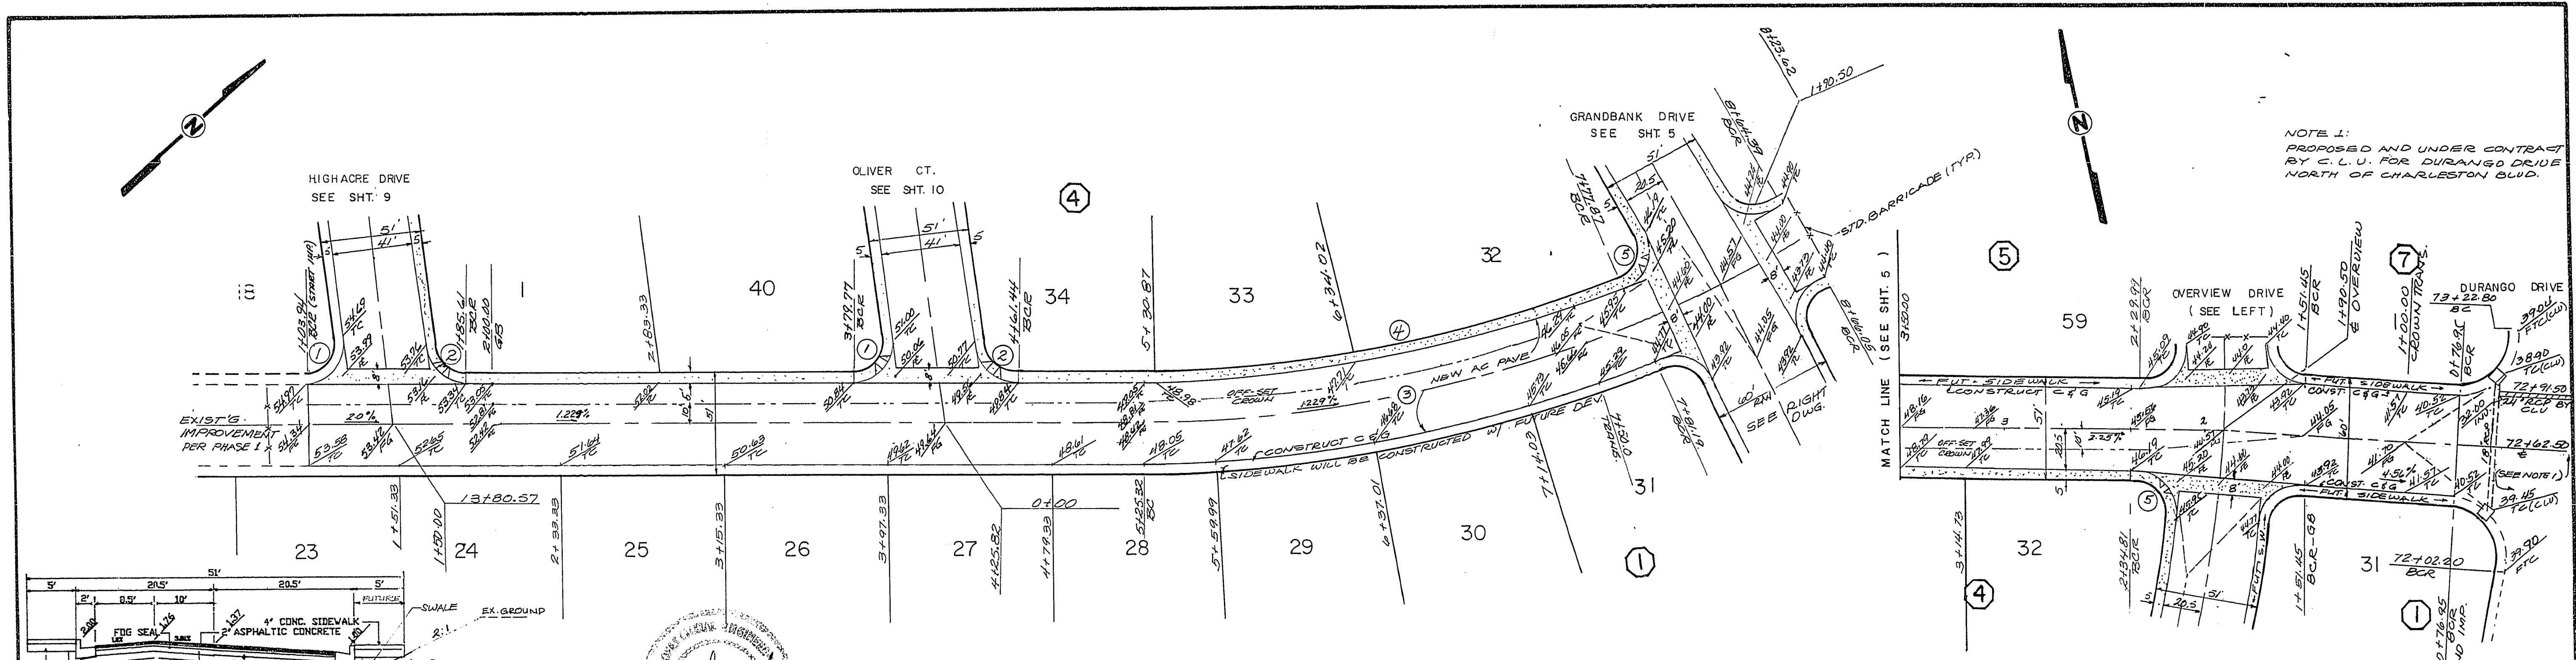


OVERVIEW DRIVE
SCALE 1" = 40'

BCR CURVE DATA

No	DELTA	R	L	T
1	97°20'41"	20.00	33.98	22.74
2	82°39'20"	20.00	28.58	17.59
(CL) 3	25°54'55"	659.50	298.30	151.74
4	21°56'27"	639.00	244.70	123.87
5	97°10'02"	20.00	33.92	22.67

GRANDBANK DRIVE
SCALE 1" = 40'

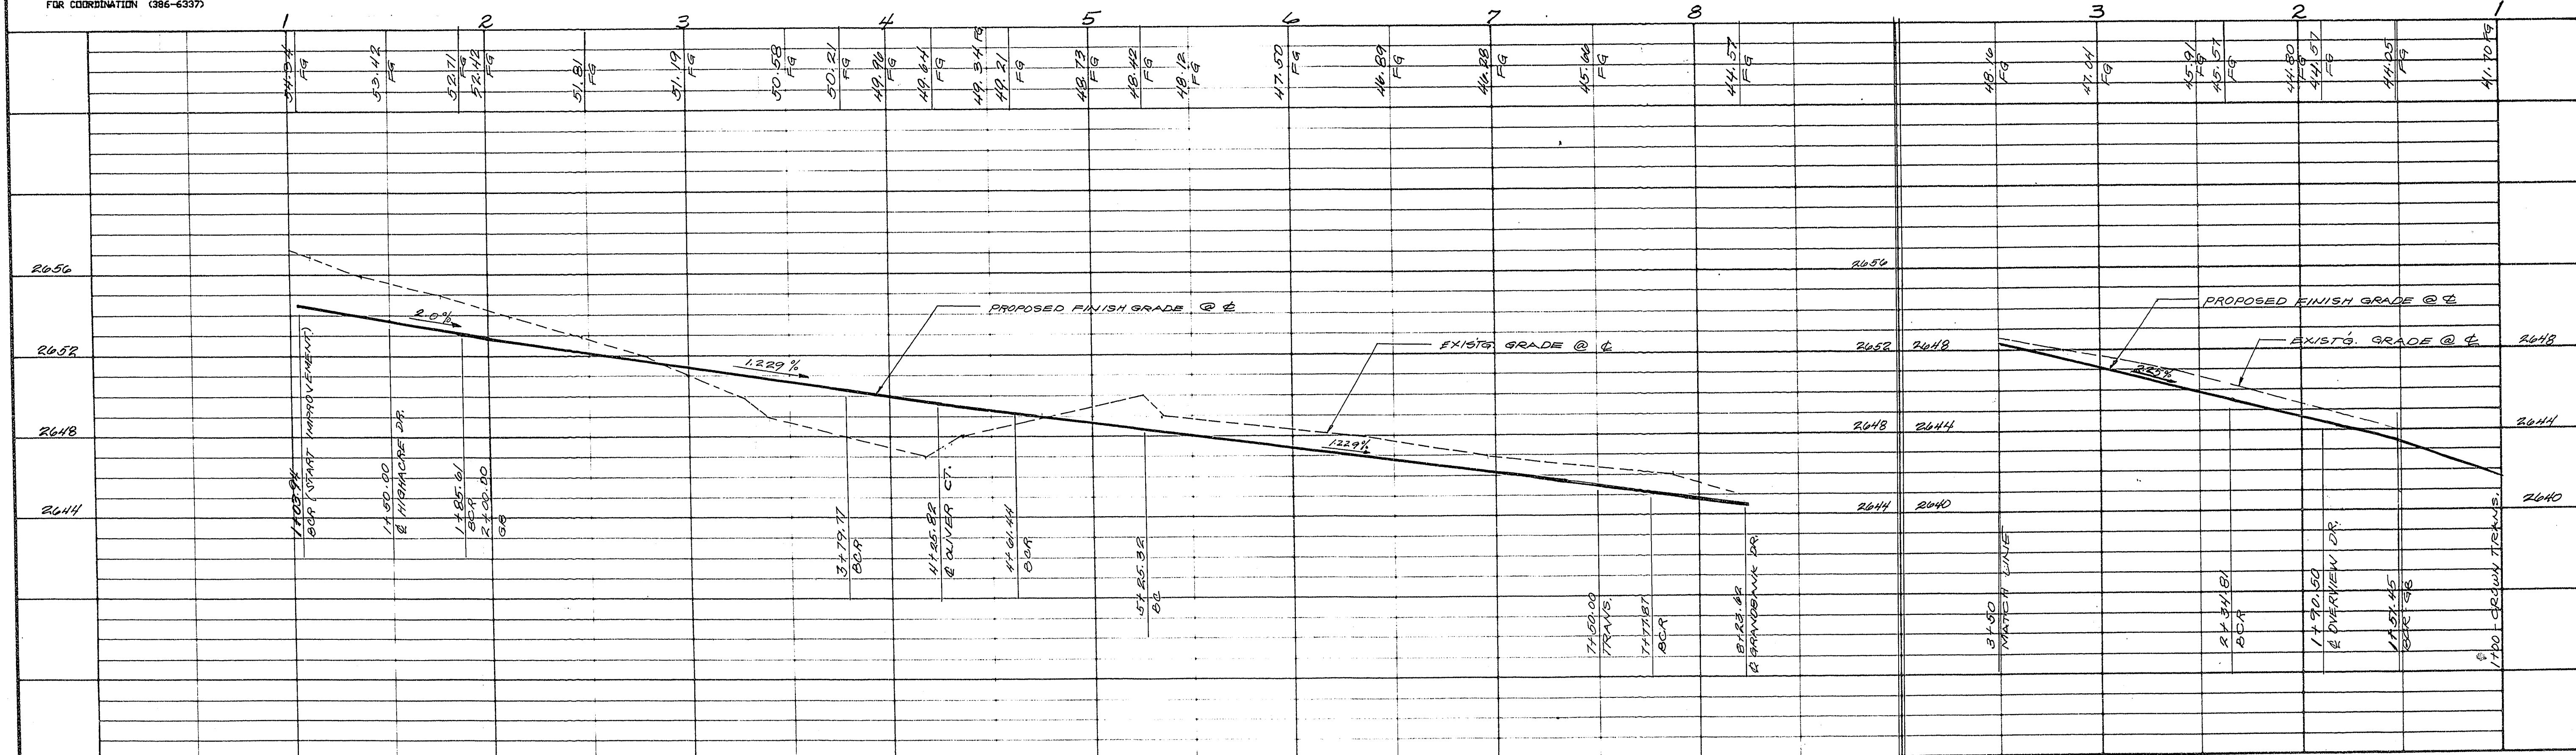

9/1/89 EXTENDED OF STREET IMPROVEMENT @ OVERVIEW AND GRANDBANK. 12/14/89 EXTENDED OF CONST. LIMITS @ GRANDBANK DR.	DESIGNED BY: COS DRAWN BY: RQA CHECKED BY:	WEST MESA ESTATES I PHASE 2 STREET PLAN OVERVIEW DRIVE / GRANDBANK DRIVE	C CONSULTANTS SURVEYORS & ENGINEERS 3200 POLARIS SUITE # 4 LAS VEGAS, NEV. 89102 (702) 251- 5490	SCALE HORZ 1" = 40' VERT 1" = 4' PROJECT NO. 0301 FIELD BOOK	DRAWING NO. SHT. 6 OF 19
---	--	---	---	--	-----------------------------