


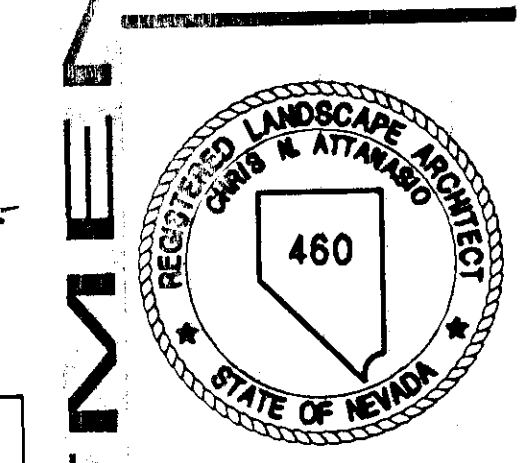


03-11-03

CONSULTANT
POGGEMEYER DESIGN GROUP INC.
 ENGINEERS PLANNERS SURVEYORS
 LANDSCAPE ARCHITECTS
 2801 NORTH TENAYA WAY
 LAS VEGAS, NEVADA 89128 (702) 255-8100

DEPARTMENT OF PUBLIC WORKS
 CITY OF LAS VEGAS WEST SERVICE YARD
 FIELD OPERATIONS CENTER AND FACILITIES
 CHEYENNE AVENUE AND BUFFALO DRIVE
 IRRIGATION PLAN



DEPARTMENT OF PUBLIC WORKS
 400 EAST STEWART AVENUE
 LAS VEGAS, NEVADA 89101
 PHONE: (702) 229-6333
 FAX: (702) 382-3232
 TDD: (702) 386-9108
 DATE SNYDER KIMSEY ARCHITECTS
 DRAWN: D. REHFELD
 SD NO: 02.15341.09
 DATE: 10-16-02
 CIV. DIV. NO: 107.V3548
 PROJECT: WEST SERVICE YARD FIELD OPERATIONS CENTER AND FACILITIES
 SHEET NO: **L 2.02**
 PROJ. NO: 99047

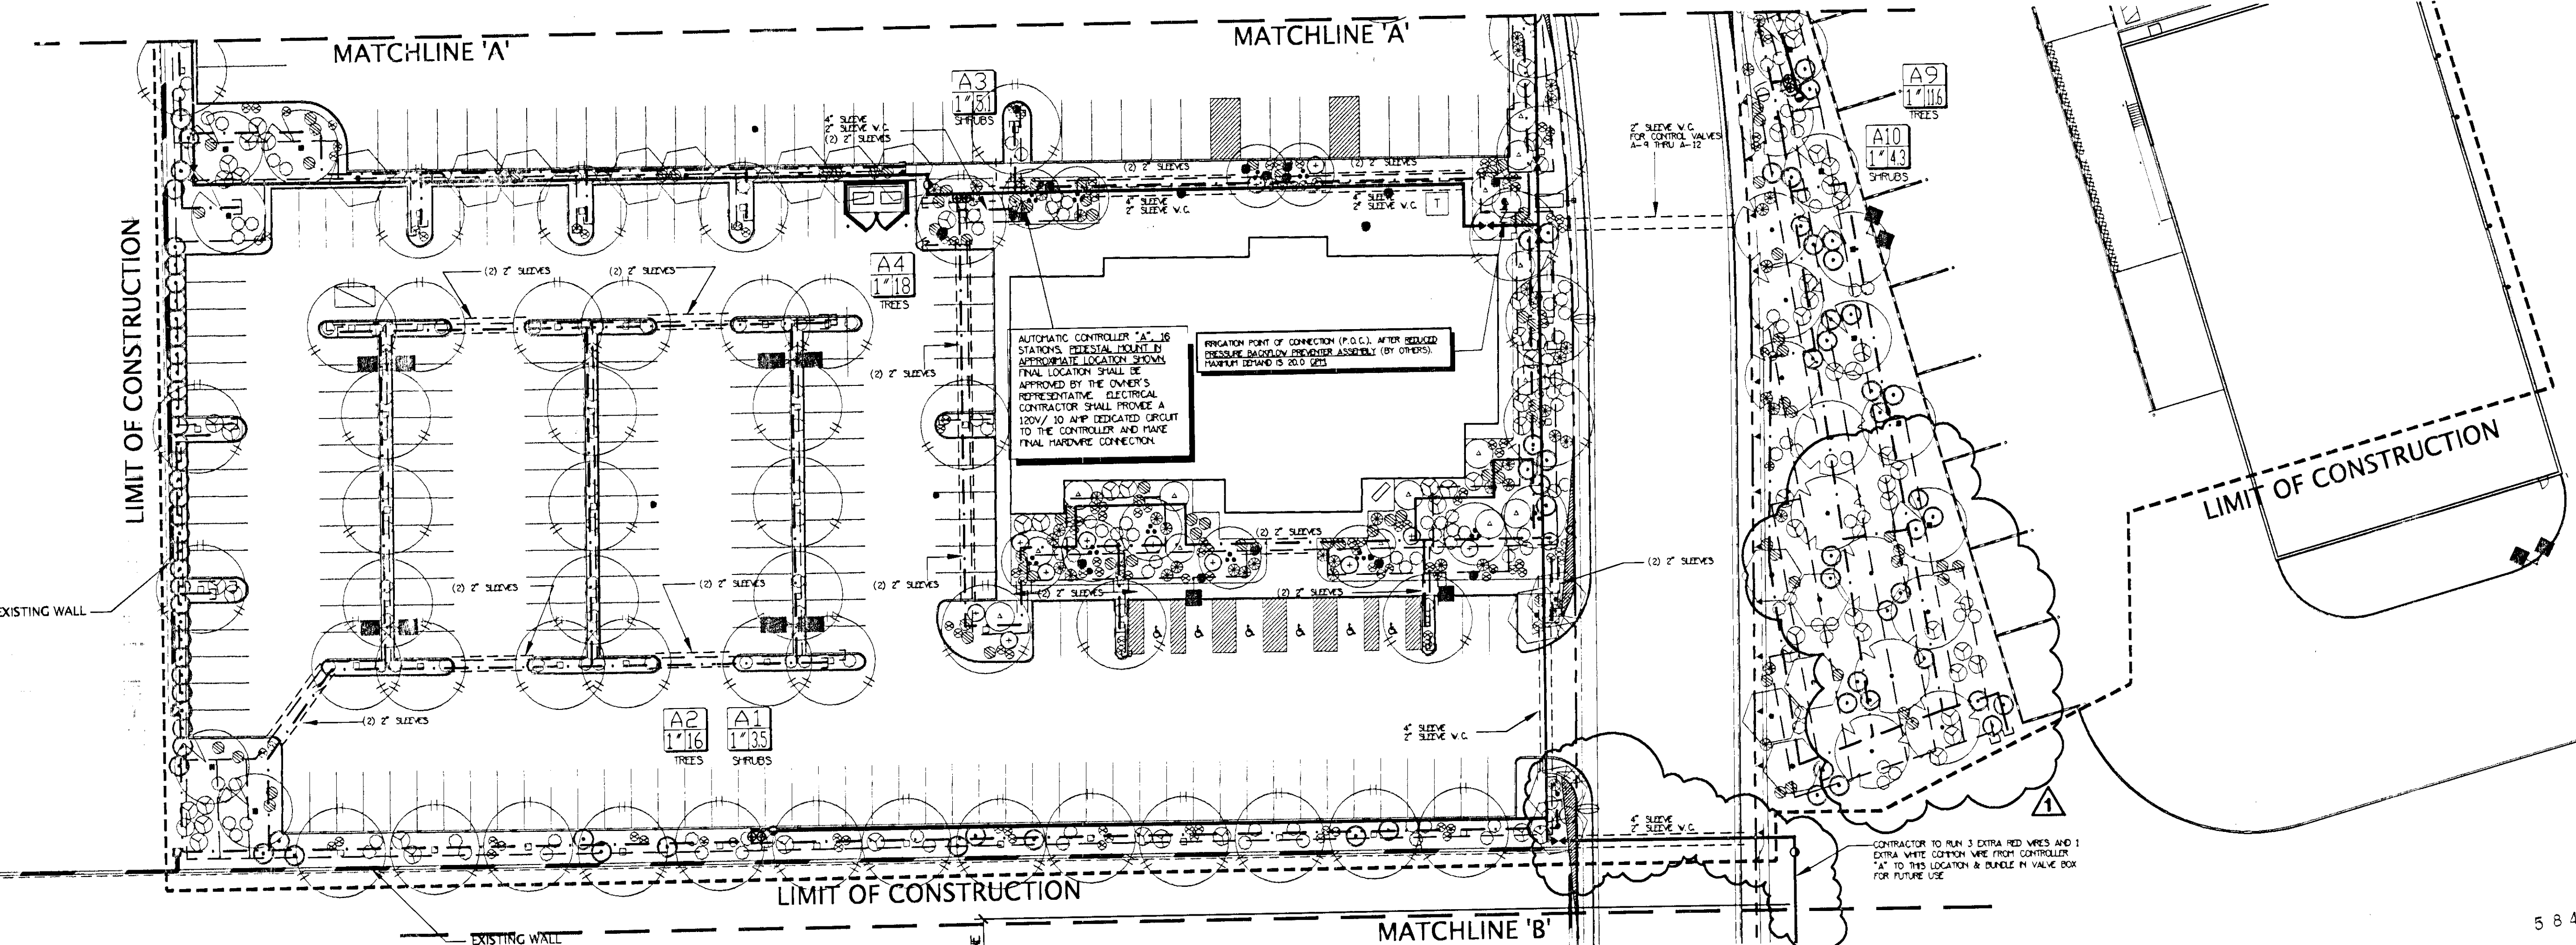




584262
 RECEIVED
 MAR 18 2003
 CITY OF LAS VEGAS PERMITS

IRRIGATION SCHEDULE						
EMITTERS						
SYMBOL	MANUFACTURER - MODEL NUMBER	PAT.	RAD.	PSI	GPM/GPH	DETAIL/SHEET
NOT SHOWN	AGRIUM LFC-20 (PRESSURE COMPENSATING EMITTER)	DRP	-	7	2.0	E/L3.01
NOT SHOWN	AGRIUM LFC-10 (PRESSURE COMPENSATING EMITTER)	DRP	-	7	1.0	E/L3.01
NOT SHOWN	AGRIUM LFC-05 (PRESSURE COMPENSATING EMITTER)	DRP	-	7	0.50	E/L3.01

PIPE AND WIRE		
SYMBOL	MANUFACTURER - MODEL NUMBER	DETAIL/SHEET
---	MANHOLE PVC SCH. 40 - 2" DA	M/L3.01
---	SHRUB DRP LINE HEADER PVC SCH. 40, 3/4" MIN. VA. PS FLEXIBLE A/R PVC TO EMITTER	M/L3.01
---	TREE DRP LINE HEADER PVC SCH. 40, 3/4" MIN. VA. PS FLEXIBLE A/R PVC TO EMITTER	M/L3.01
---	SLEEVES PVC SCH. 40, SIZE PER PLAN	M/L3.01
NOT SHOWN	CONTROL WIRE, UF DIRECT BURIAL, SOLID COPPER, 12 GA. COMMON, 14 GA. FLEET	M/L3.01

EQUIPMENT		
SYMBOL	MANUFACTURER - MODEL NUMBER	DETAIL/SHEET
△	RANERD ESP-18X - PEDESTAL MOUNT (PED-10 18)	E/L3.01
□	EXISTING REDUCED PRESSURE PRINCIPAL ASSEMBLY (RPPA)	
□	EXISTING WATER METER, SEE CML PLANS	
N	PEECO 2" B25YA BACKFLOW DEVICE	G/L3.01
+	2" NESCO T-113 GATE VALVE	N/L3.01
+	1" RANERD PED SERIES, AGRICULTURAL PRODUCTS 4E SERIES 1" WYE-FILTER	J/L3.01
+	1" SENSINGER PRESSURE REGULATOR MEDIUM FLOW @ 30 PSI	L/L3.01
+	RANERD 44RC - (QUICK COUPLER VALVE)	M/L3.01
-	DRP FLUSH VALVE	M/L3.01

△1 - CONTROLLER/STATION NUMBER
 △10 - GPH
 △100 - TYPE OF VEGETATION
 --- - VALVE SIZE

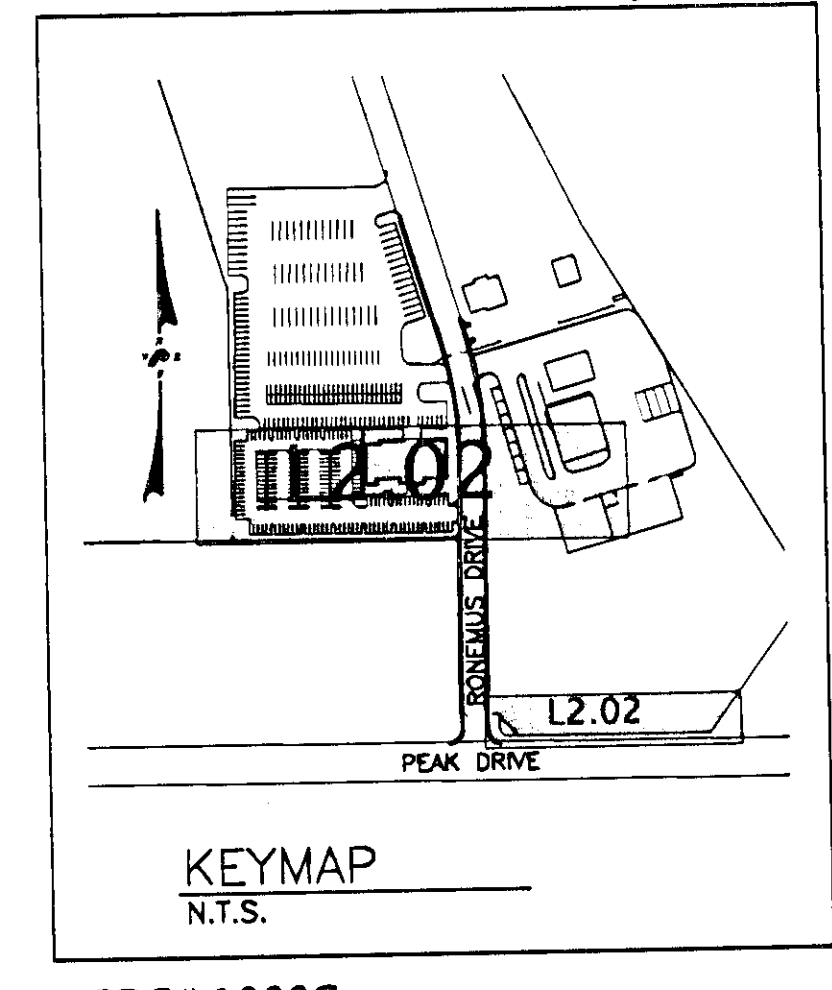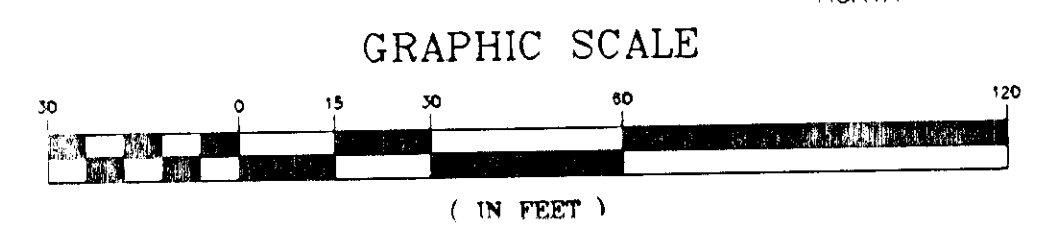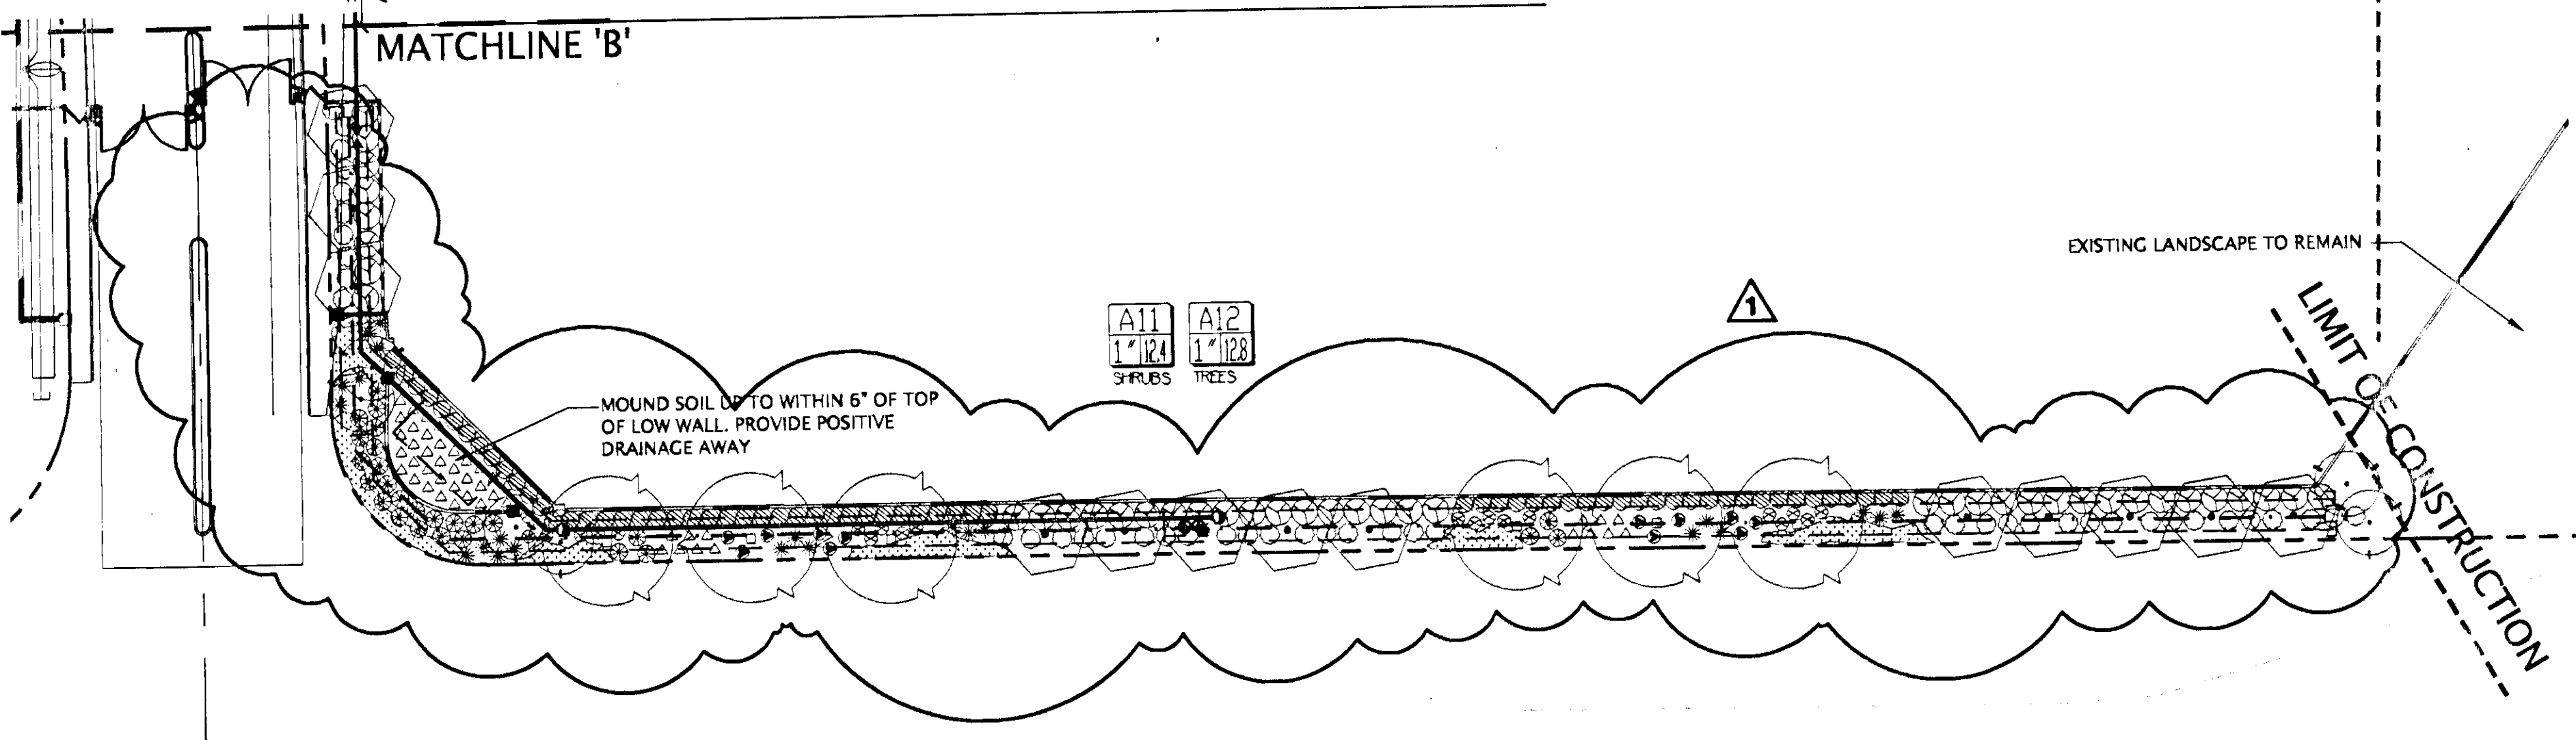

PDG#1099C