



REVISIONS
5 03.14.03


CONSULTANT

poggemeyer
design group, inc.
engineers • planners • landscape architects
2000 North Saguaro Way, Las Vegas, NV 89126 • P 702.255.6100 • F 702.255.6175

CITY OF LAS VEGAS WEST SERVICE YARD
BUFFALO DRIVE AND PEAK ROAD
LAS VEGAS, NEVADA
SECTION
FIELD MAINTENANCE BUILDING

APPROVED
STRUCTURAL
ENGINEER & Sealed Stamp
City of Las Vegas, Nevada

LTB APR 10 2003

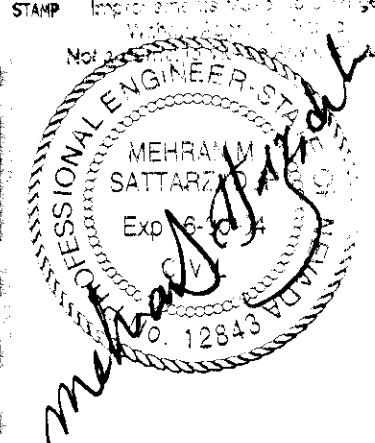


OWNER: CITY OF LAS VEGAS
DEPARTMENT OF PUBLIC WORKS
ARCHITECTURAL SERVICES

400 EAST STEWART AVENUE
LAS VEGAS, NEVADA 89101
PHONE: (702) 229-6535
FAX: (702) 382-3232
TDD: (702) 386-9108

DRAWN: SNK
TITLE: 0475204
DATE: 03.14.03
SCALE: 3/8"=1'-0"
BID NO: 02.15241.09
CLVDWG NO: 107.V3548

SHEET NO
S2.04
OF

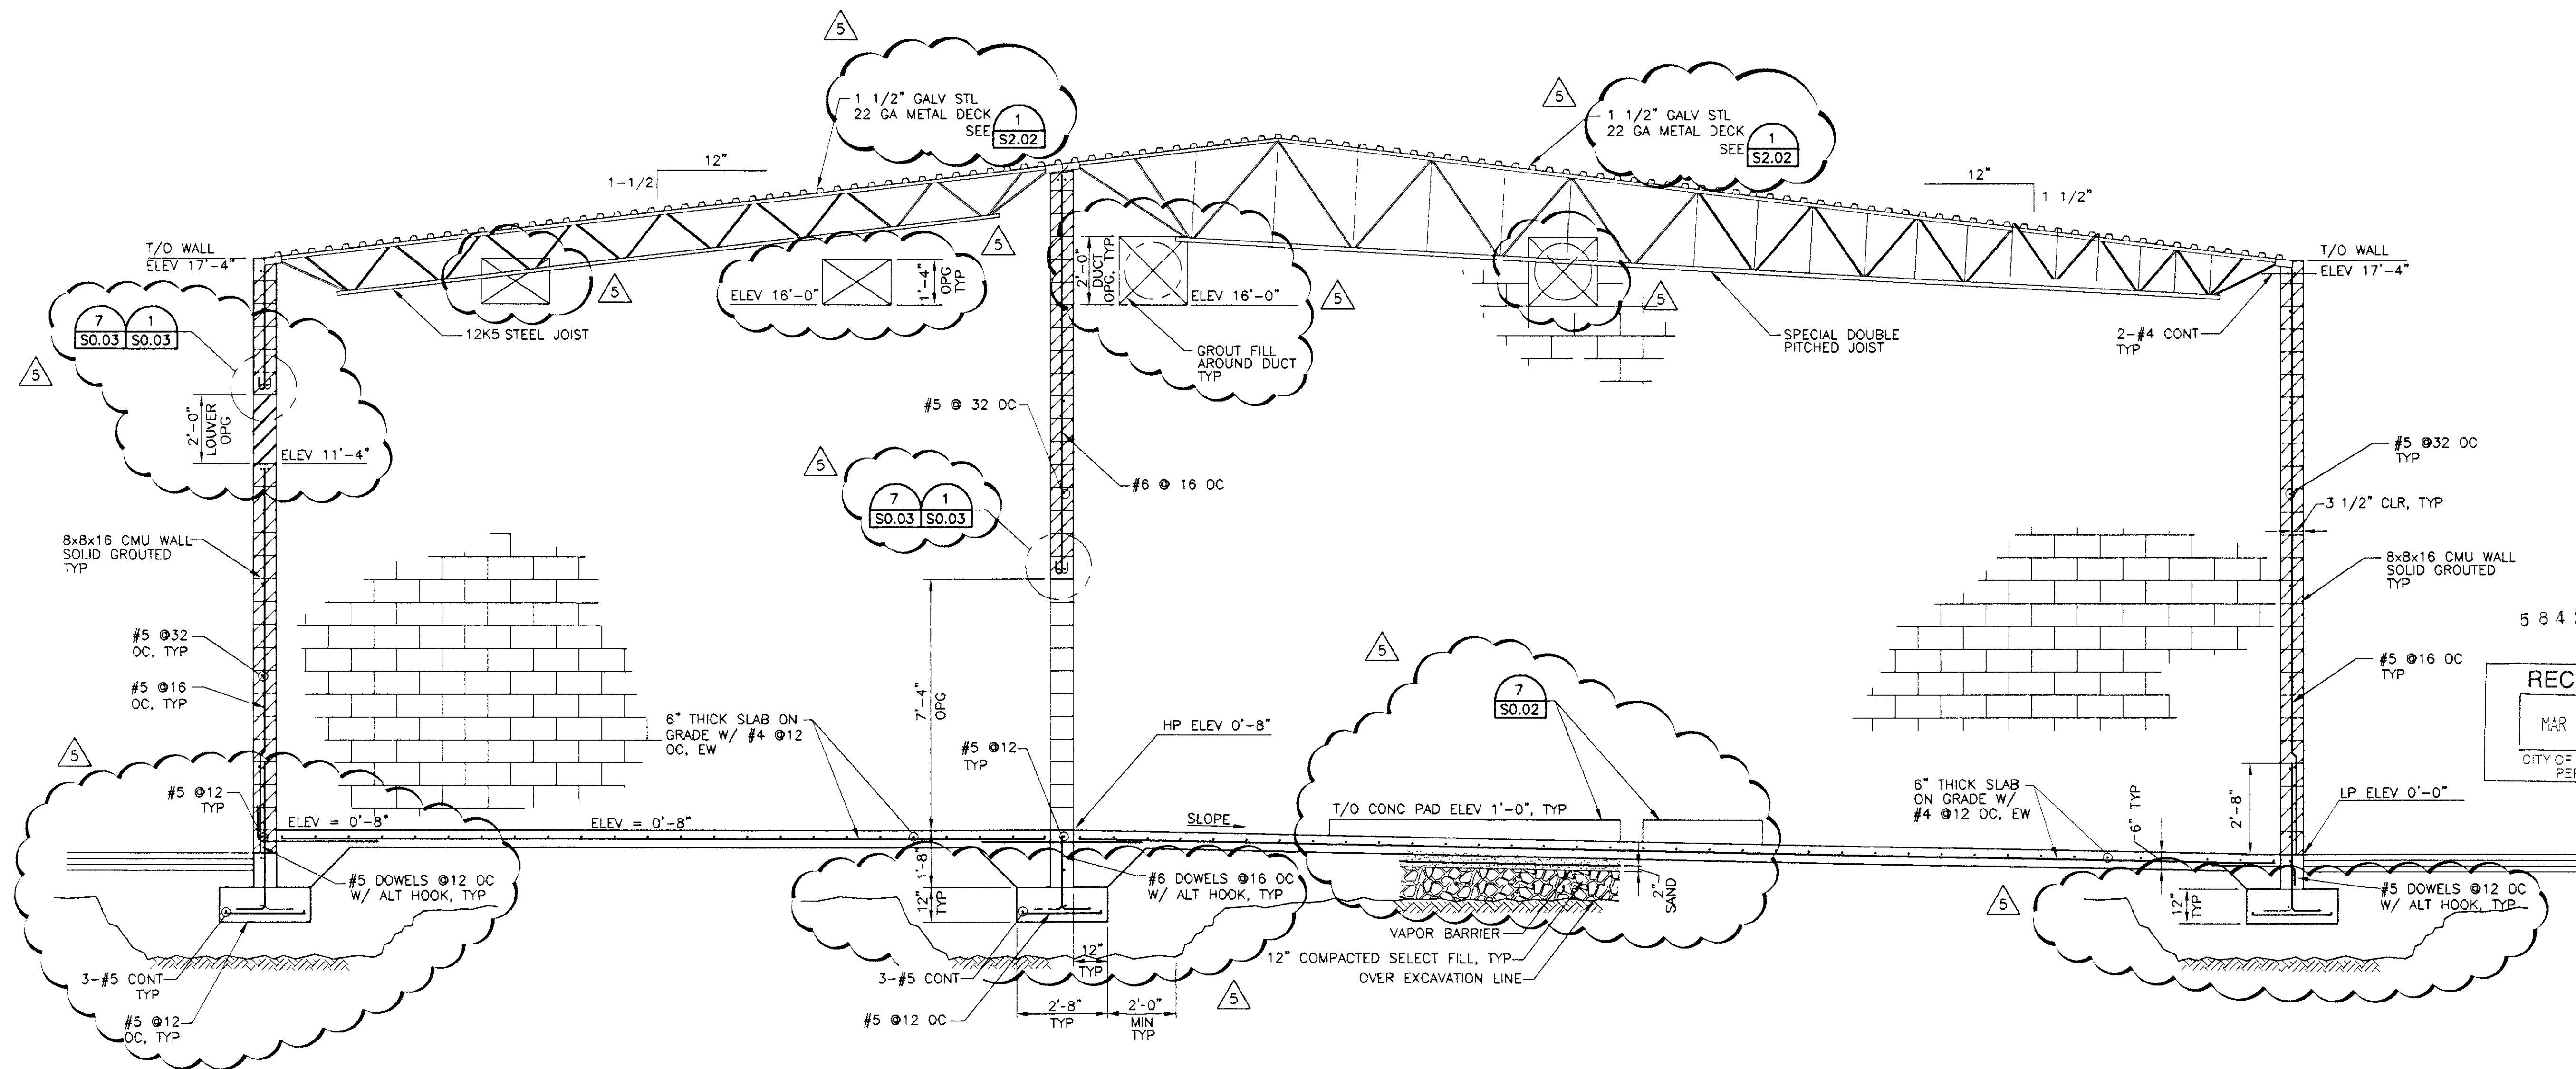

SECTION

8
S2.01
S2.02

APPROVAL IS FOR CLOUDED
AREAS OR LATEST REVISIONS
ONLY. SEE ORIGINALS
FOR OTHER REQUIREMENTS