



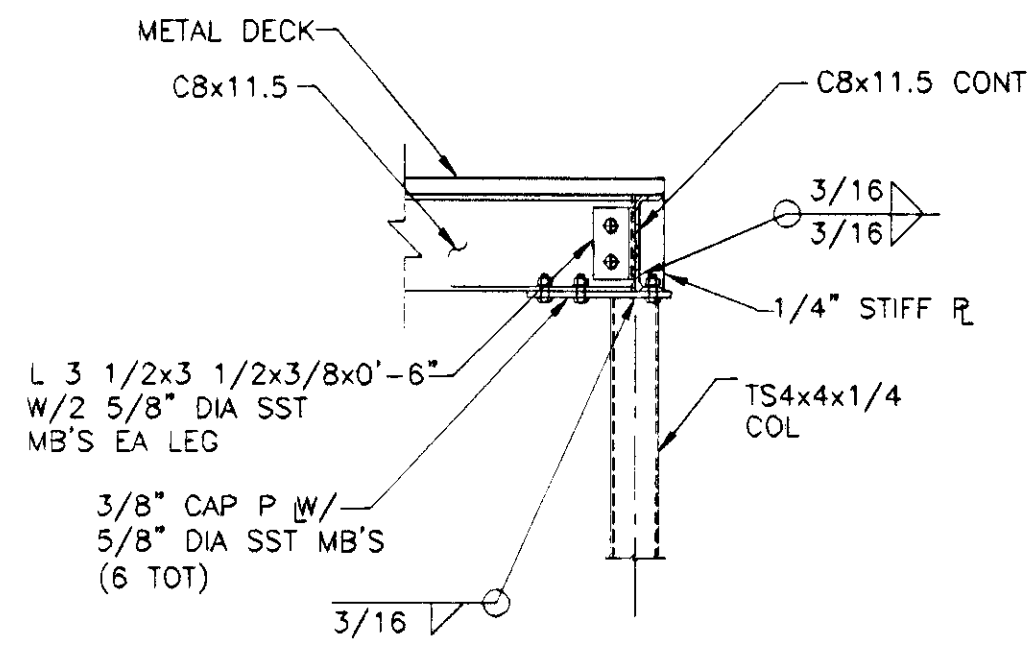


DETAIL  
3/4" = 1'-0"

1  
S2.05

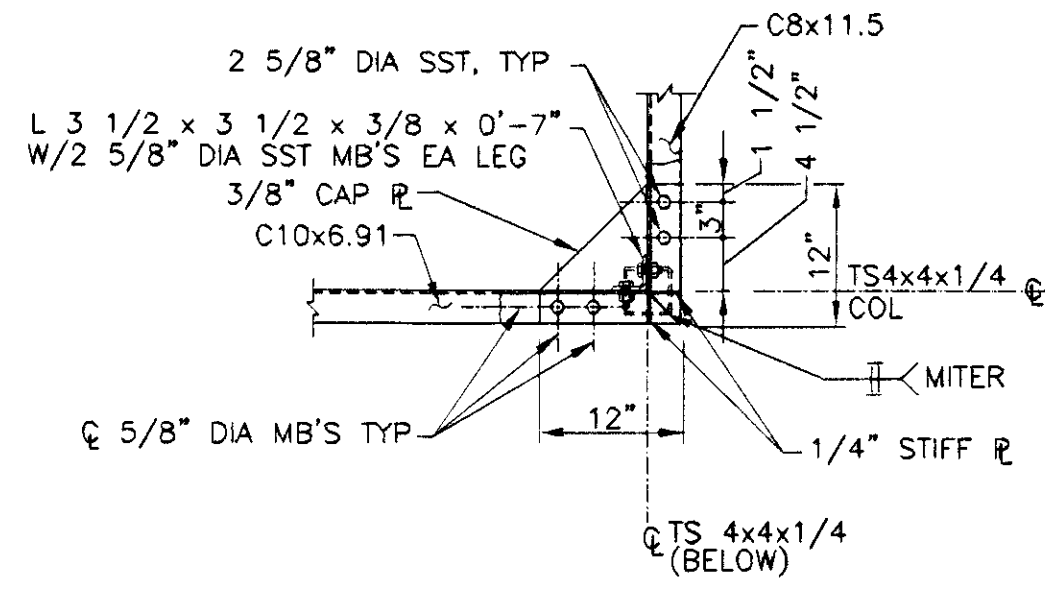


DETAIL  
3/4" = 1'-0"

2  
S2.02

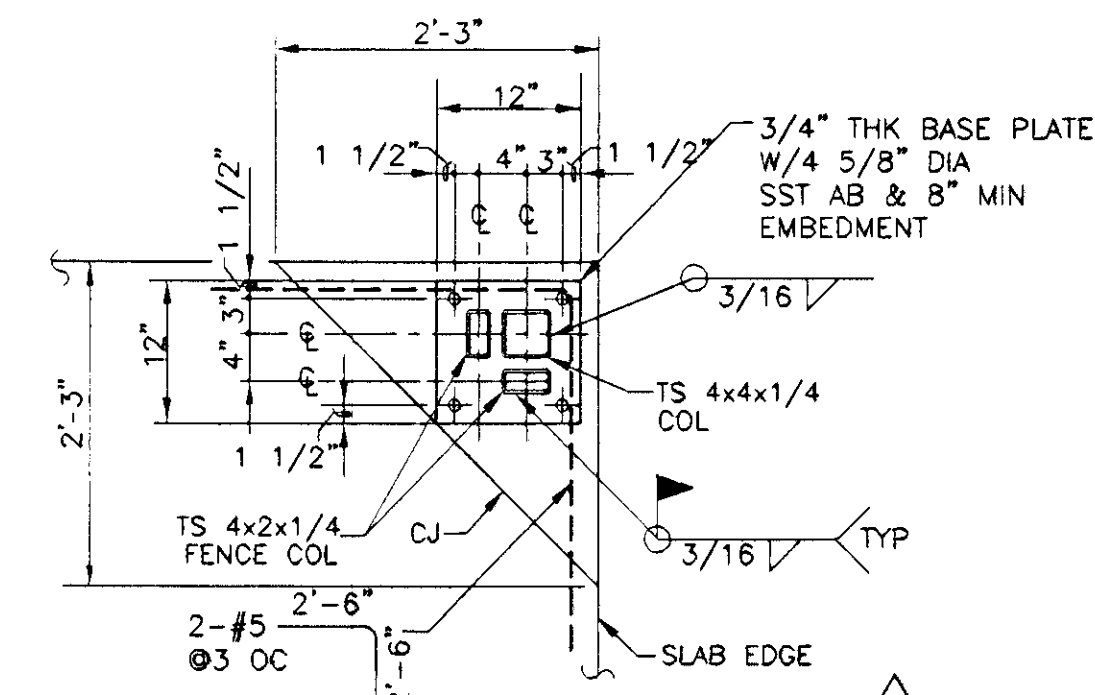


SECTION  
3/4" = 1'-0"

3  
S2.01

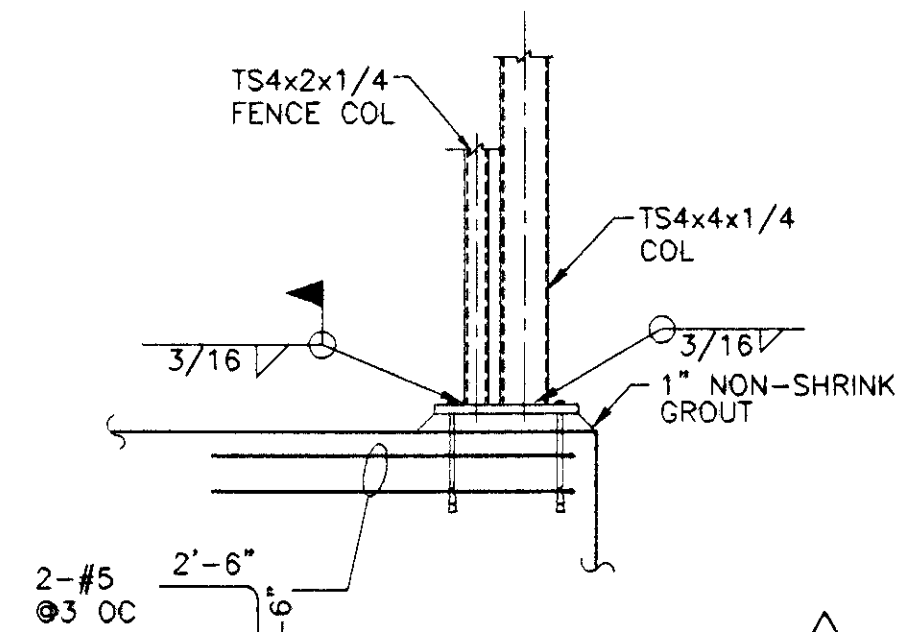


DETAIL  
3/4" = 1'-0"

4  
S2.05

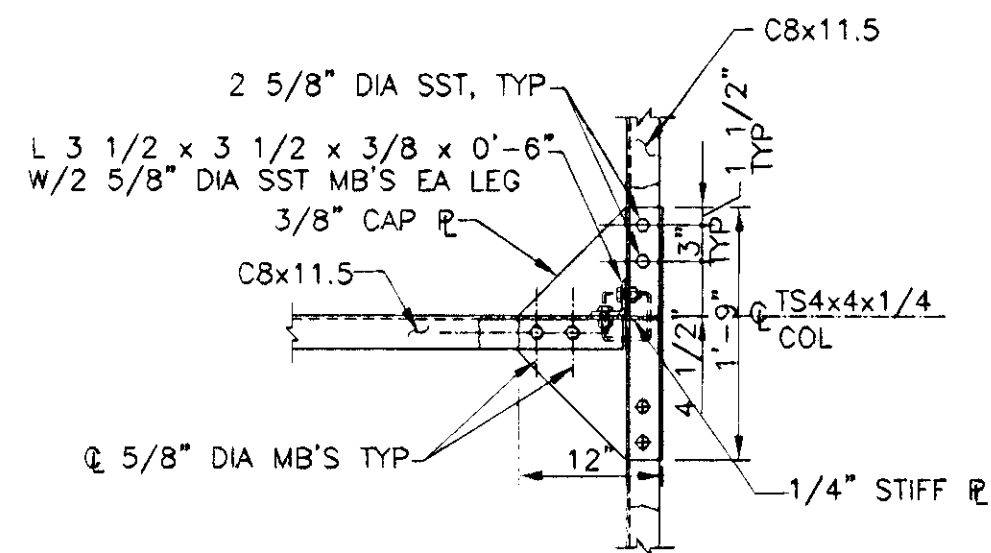


DETAIL  
3/4" = 1'-0"

5  
S2.02

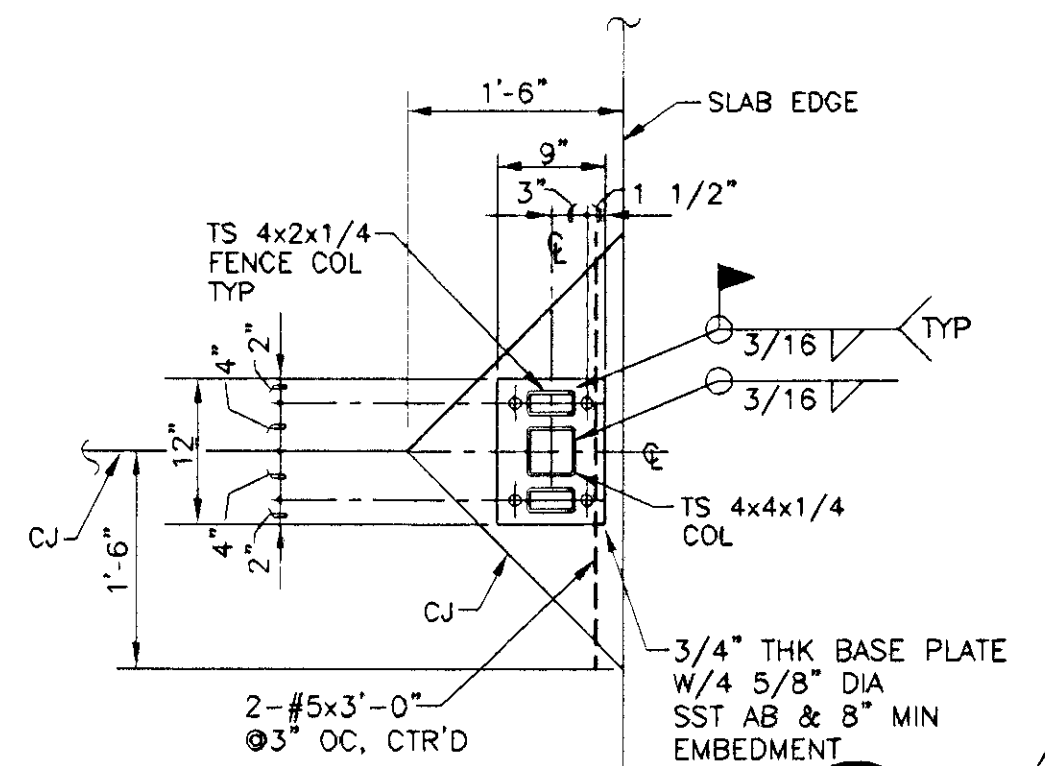

DETAIL  
3/4" = 1'-0"


6  
S2.02

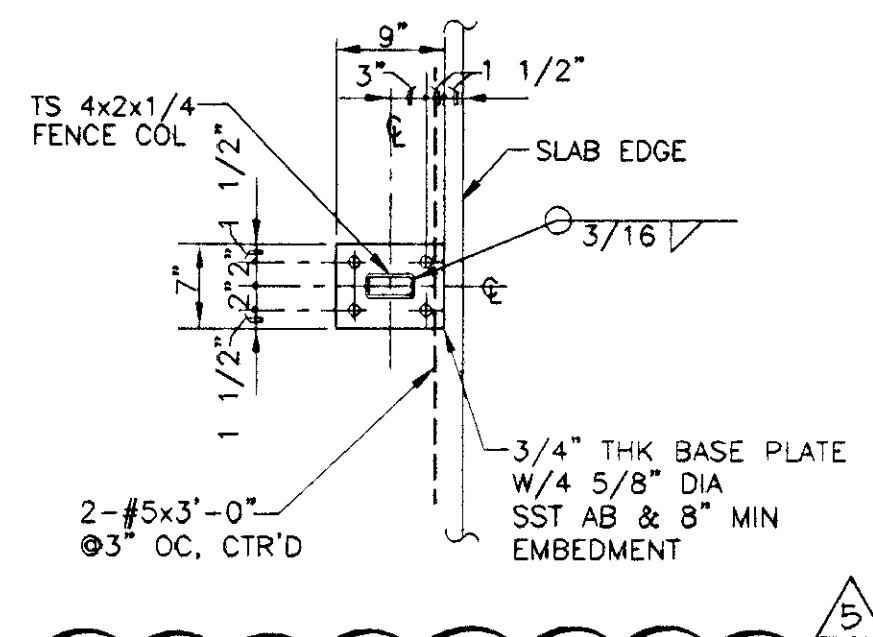

DETAIL  
3/4" = 1'-0"


7  
S2.02

5 5 4 2 5 2

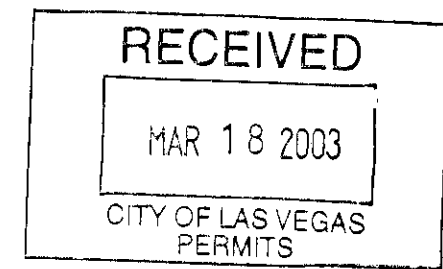

REVISIONS  
03.14.03

CONSULTANT

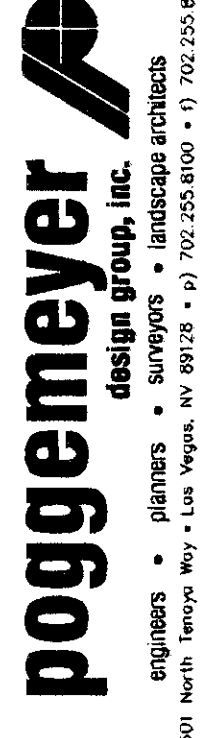


CITY OF LAS VEGAS WEST SERVICE YARD  
BUFFALO DRIVE AND PEAK ROAD  
LAS VEGAS, NEVADA  
DETAILS  
FIELD MAINTENANCE BUILDING

DESIGN APPROVED  
ARCHITECTURAL  
CITY OF LAS VEGAS  
PERMITS

LTE APR 10 2003

Does not constitute a contract. Electrical  
Plumbing, Mechanical, and Fire  
Improvements are subject to change.

5700 is a registered trademark of Autodesk

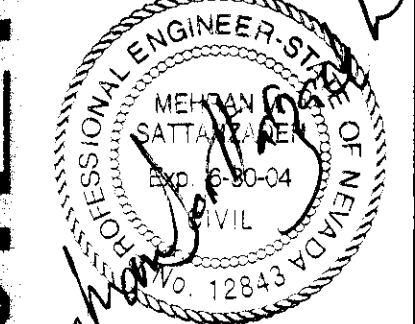

APPROVAL IS FOR CLOUDING  
AREAS OR LATEST REVISIONS  
ONLY. SEE ORIGINALS  
FOR OTHER REQUIREMENTS

OWNER: CITY OF LAS VEGAS  
DEPARTMENT OF PUBLIC WORKS  
ARCHITECTURAL SERVICES

400 EAST STEWART AVENUE  
LAS VEGAS, NEVADA 89101  
PHONE: (702) 229-6933  
FAX: (702) 382-3232  
TDD: (702) 386-9108

DRAWN: SMK  
FILE: 0475206  
DATE: 03.14.03  
SCALE: 3/4" = 1'-0"  
SHEET NO: 02.15341.09  
CLVDWG NO: 107.V2548

SHEET NO  
S2.06

OF