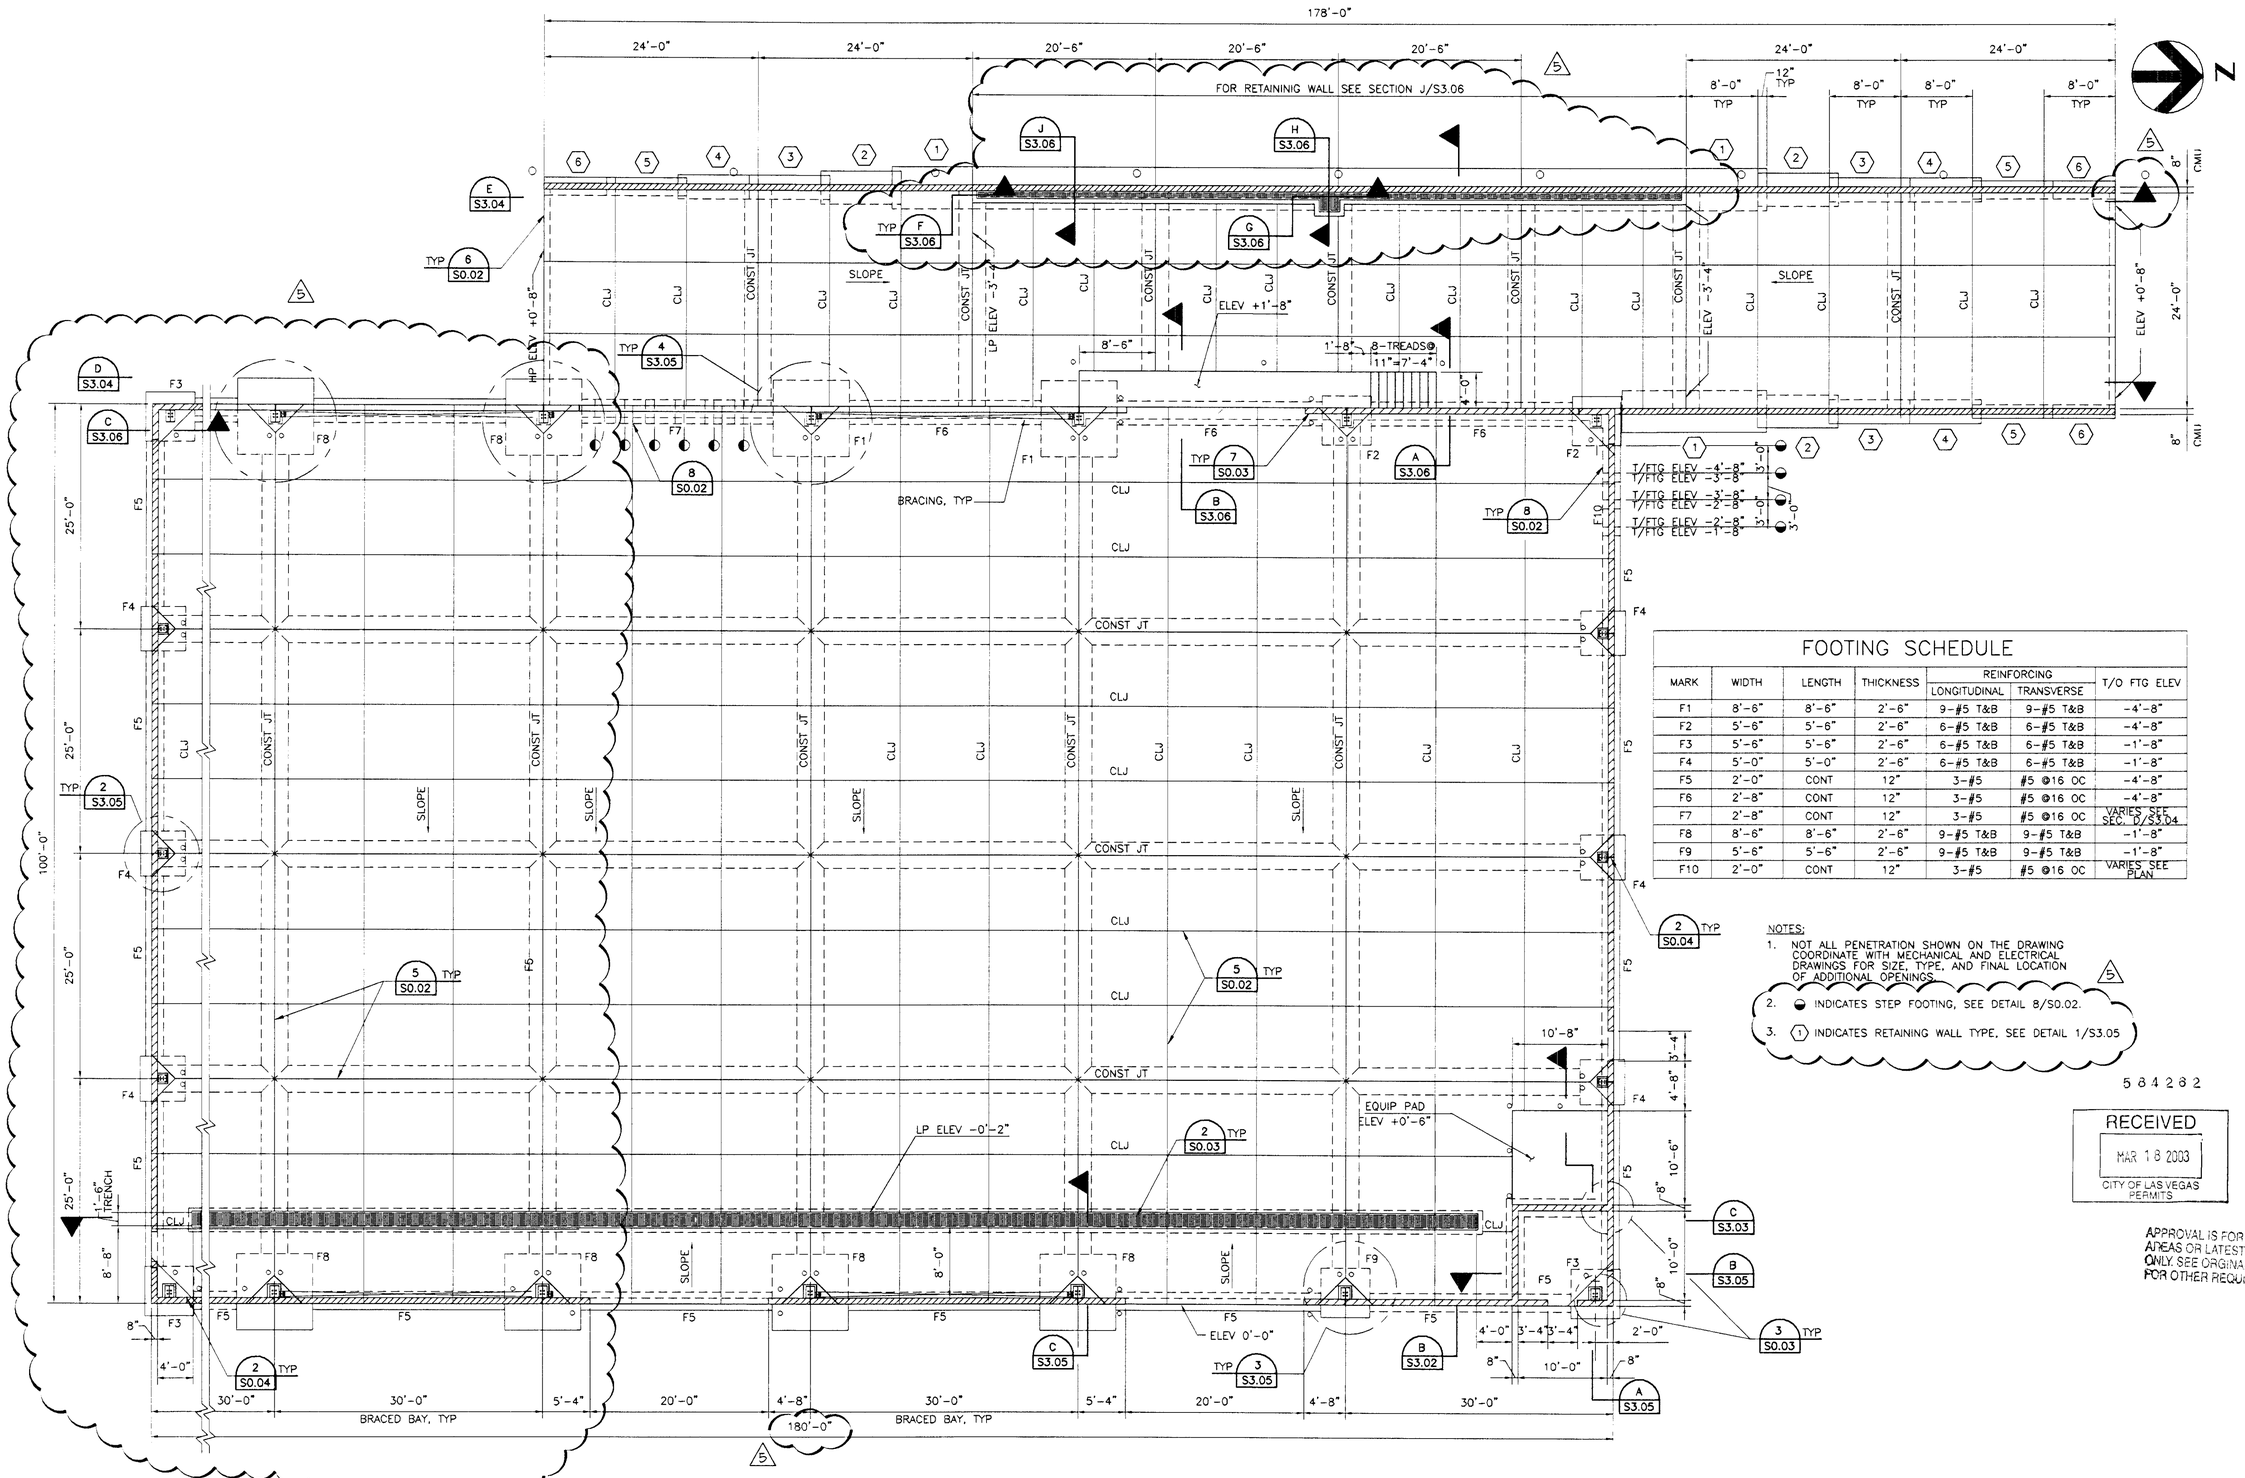


## FOOTING SCHEDULE

| MARK | WIDTH | LENGTH | THICKNESS | REINFORCING LONGITUDINAL | REINFORCING TRANSVERSE | T/O FTG ELEV |
|---|---|---|---|---|---|---|
| F1 | 8'-6" | 8'-6" | 2'-6" | 9-#5 T&B | 9-#5 T&B | -4'-8" |
| F2 | 5'-6" | 5'-6" | 2'-6" | 6-#5 T&B | 6-#5 T&B | -4'-8" |
| F3 | 5'-6" | 5'-6" | 2'-6" | 6-#5 T&B | 6-#5 T&B | -1'-8" |
| F4 | 5'-0" | 5'-0" | 2'-6" | 6-#5 T&B | 6-#5 T&B | -1'-8" |
| F5 | 2'-0" | CONT | 12" | 3-#5 | #5 @16 OC | -4'-8" |
| F6 | 2'-8" | CONT | 12" | 3-#5 | #5 @16 OC | -4'-8" |
| F7 | 2'-8" | CONT | 12" | 3-#5 | #5 @16 OC | VARIES SEE SEC. D/S3.04 |
| F8 | 8'-6" | 8'-6" | 2'-6" | 9-#5 T&B | 9-#5 T&B | -1'-8" |
| F9 | 5'-6" | 5'-6" | 2'-6" | 9-#5 T&B | 9-#5 T&B | -1'-8" |
| F10 | 2'-0" | CONT | 12" | 3-#5 | #5 @16 OC | VARIES SEE PLAN |

NOTES:

1. NOT ALL PENETRATION SHOWN ON THE DRAWING COORDINATE WITH MECHANICAL AND ELECTRICAL DRAWINGS FOR SIZE, TYPE, AND FINAL LOCATION OF ADDITIONAL OPENINGS.
2. INDICATES STEP FOOTING, SEE DETAIL 8/S0.02.
3. INDICATES RETAINING WALL TYPE, SEE DETAIL 1/S3.05

584282

RECEIVED
MAR 18 2003
CITY OF LAS VEGAS PERMITS

APPROVAL IS FOR CLO... AREAS OR LATEST REVISIO... ONLY. SEE ORIGINALS FOR OTHER REQUIREM...

FOUNDATION PLAN

CITY OF LAS VEGAS
NEVADA

REVISIONS 5 03.14.03

CONSULTANT

poggemeyer design group, inc.
engineers • planners • surveyors • landscape architects
2601 North Tenaya Way • Las Vegas, NV 89128 • p) 702.255.8100 • f) 702.255.8375

DEPARTMENT OF PUBLIC WORKS

CITY OF LAS VEGAS WEST SERVICE YARD
BUFFALO DRIVE AND PEAK ROAD
LAS VEGAS, NEVADA
FOUNDATION PLAN
MATERIAL HANDLING BUILDING

PLANS APPROVED
STRUCTURAL
Building & Safety Dept.
City of Las Vegas, Nevada
LTC APR 10 2003

STAMP

OWNER: CITY OF LAS VEGAS
DEPARTMENT OF PUBLIC WORKS
ARCHITECTURAL SERVICES
400 EAST STEWART AVENUE
LAS VEGAS, NEVADA 89101
PHONE: (702) 229-6535
FAX: (702) 382-3232
TDD: (702) 386-9108

| | |
|---|---|
| DRAWN | SMK |
| FILE | 047S301 |
| DATE | 03.14.03 |
| SCALE | 1/8"=1'-0" |
| BID NO | 02.15341.09 |
| CLV DWG NO | 107.V3548 |
| SHT NO | S3.01 |
| OF | |