



REVISIONS
5 03.14.03

CONSULTANT
poggemeyer
design group, inc.
engineers • planners • landscape architects
2000 North Nevada Ave • Las Vegas, NV 89101 • P 702.253.8175

CITY OF LAS VEGAS WEST SERVICE YARD
BUFFALO DRIVE AND PEAK ROAD
LAS VEGAS, NEVADA
SECTION
MATERIAL HANDLING BUILDING

APPROVED
STRUCTURAL
Engineering & Survey Dept.
City of Las Vegas, Nevada

DATE APR 10 2003

Does Not Apply to Structural, Electrical, Plumbing, Mechanical or Civil Site


STAMP
Not a Professional Engineer Stamp
MEHRAN M. SATTARI
EX. 683-04
NO. 12843
Professional Engineer

APPROVAL IS FOR CLOUDED AREAS OR LATEST REVISIONS ONLY SEE ORIGINALS FOR OTHER REQUIREMENTS

OWNER: CITY OF LAS VEGAS
DEPARTMENT OF PUBLIC WORKS
ARCHITECTURAL SERVICES

400 EAST STEWART AVENUE
LAS VEGAS, NEVADA 89101
PHONE: (702) 228-8938
FAX: (702) 382-3232
TDD: (702) 386-9108

DRAWN	SMK
TITLE	0475302
DATE	03.14.03
SCALE	3/16"=1'-0"
REV NO	02.15341.09
CLV DWG NO	107.V3548
SHEET NO	S3.02
OF	

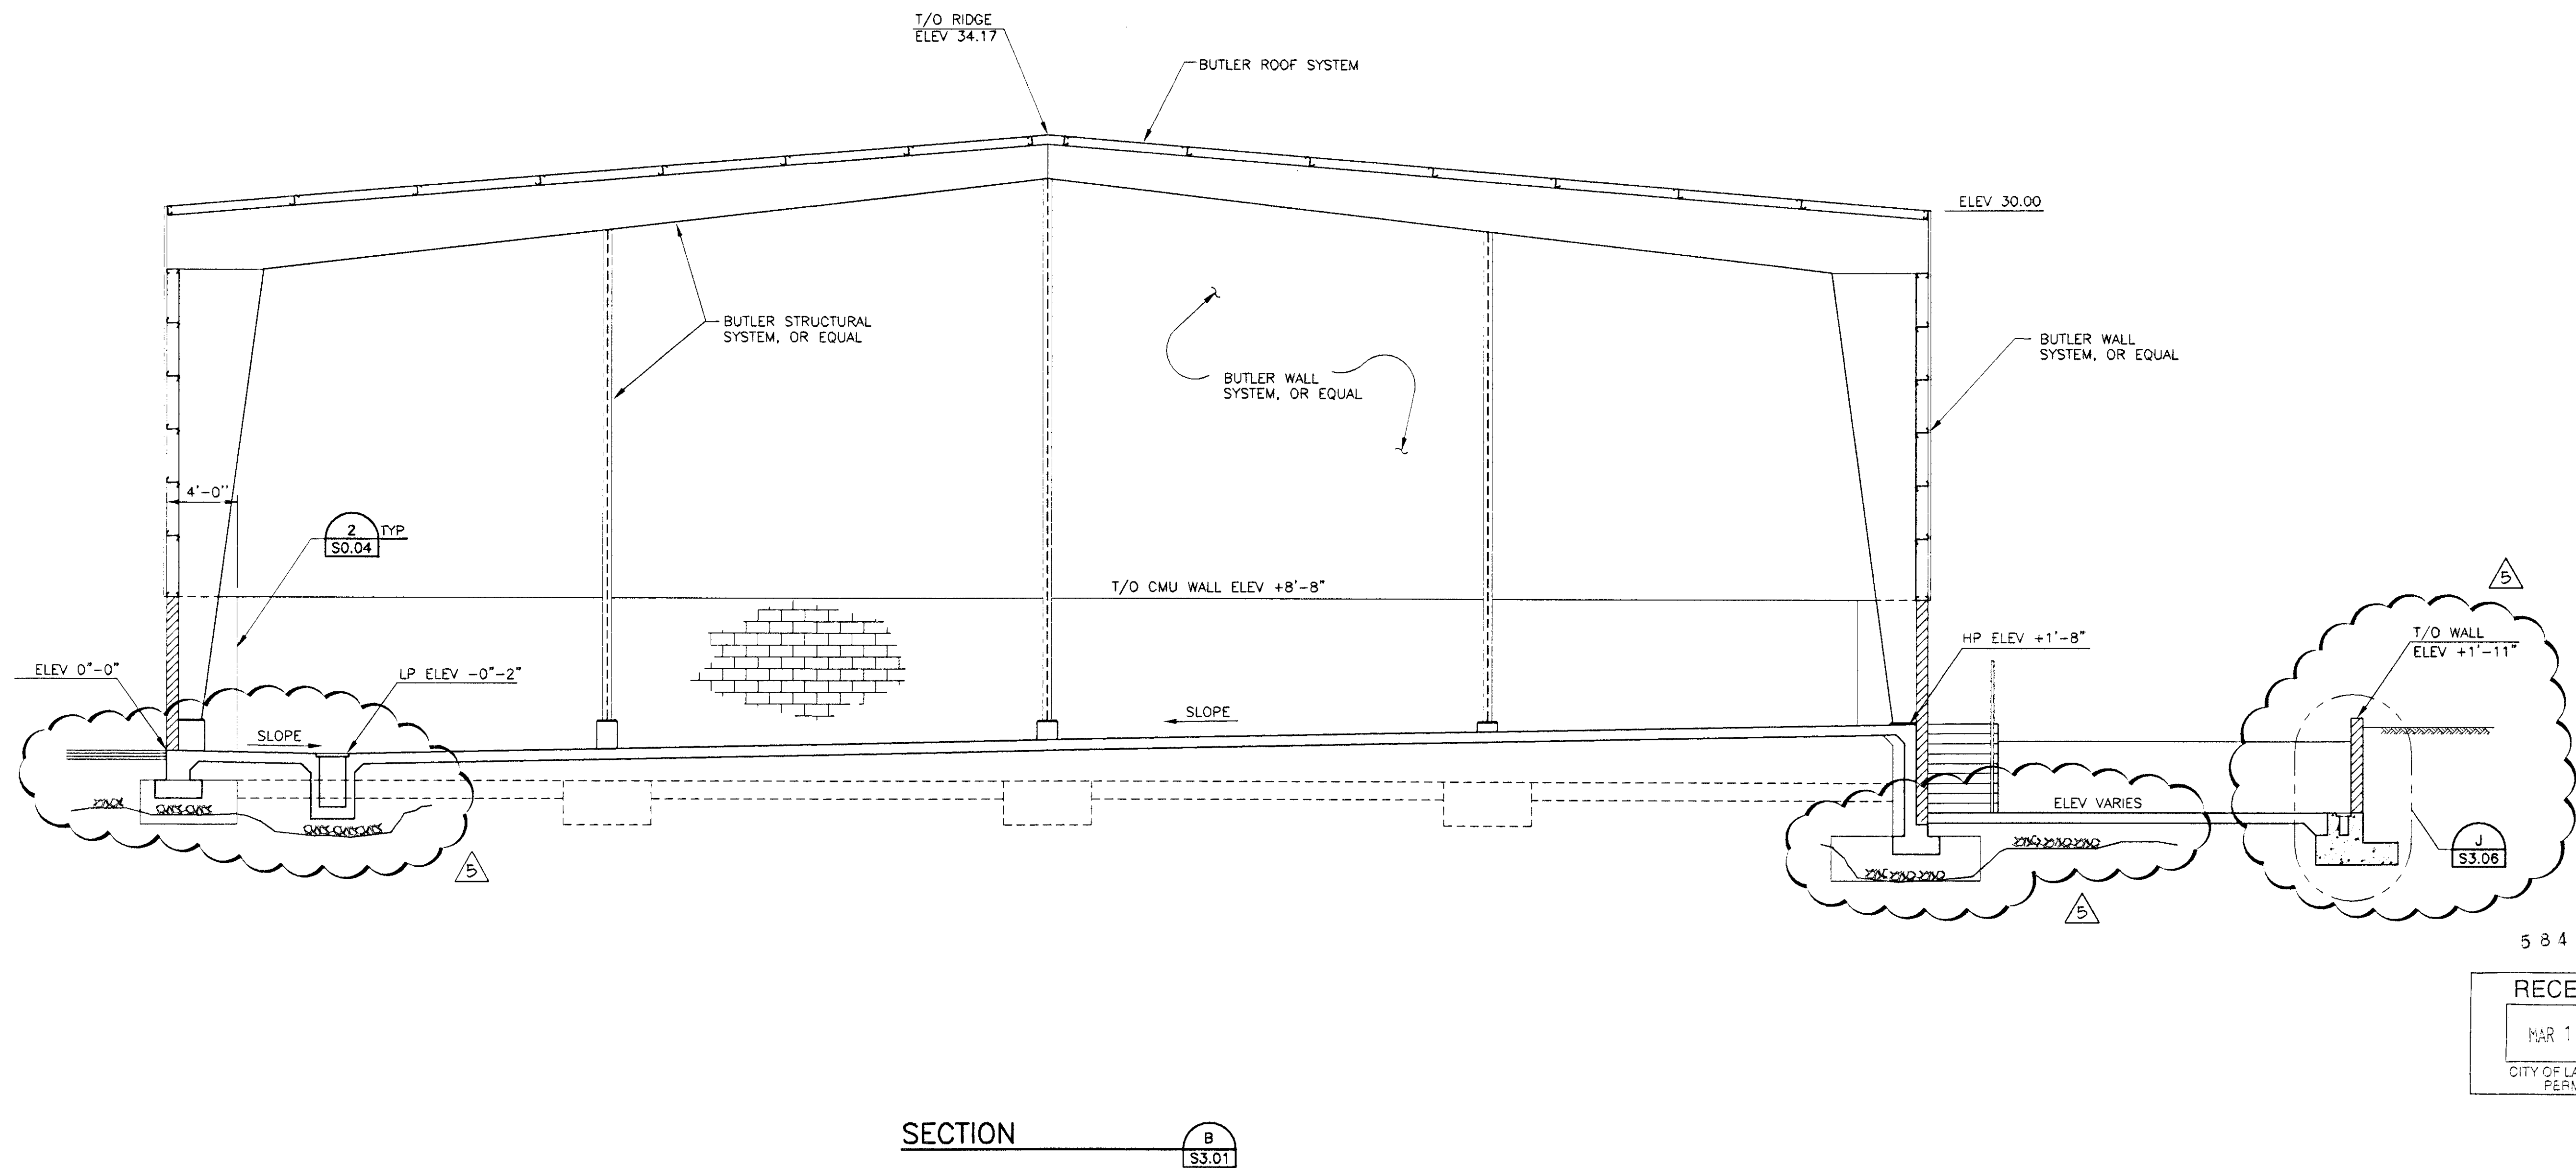

5 8 4 2 6 2

RECEIVED
MAR 18 2003
CITY OF LAS VEGAS
PERMITS

SECTION
B
S3.01

