



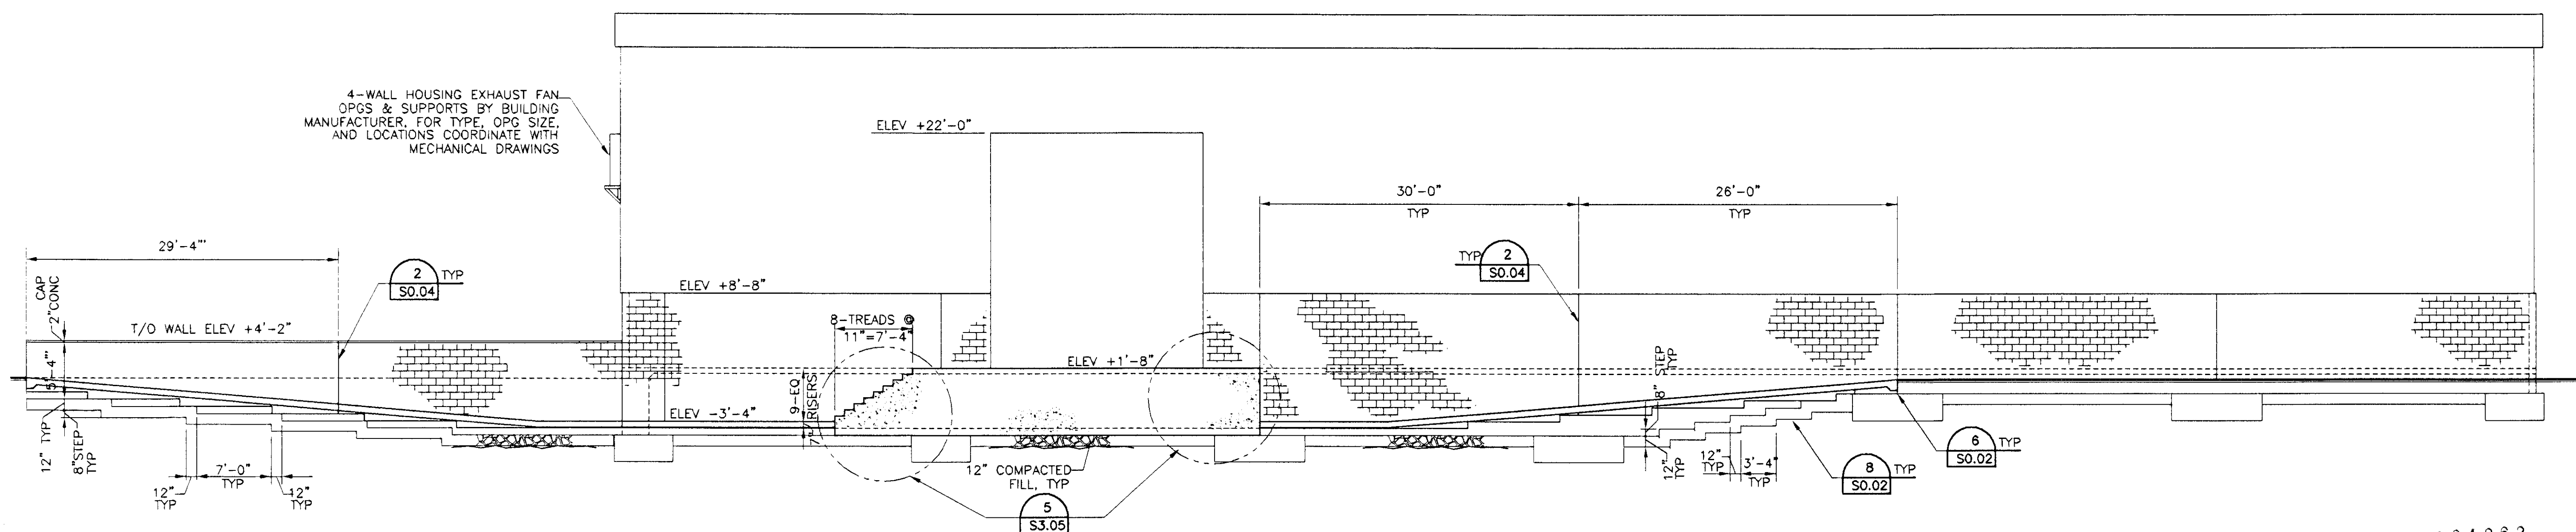

SECTION D S3.01

5 8 4 2 8 2
RECEIVED
MAR 18 2003
CITY OF LAS VEGAS
PERMITS

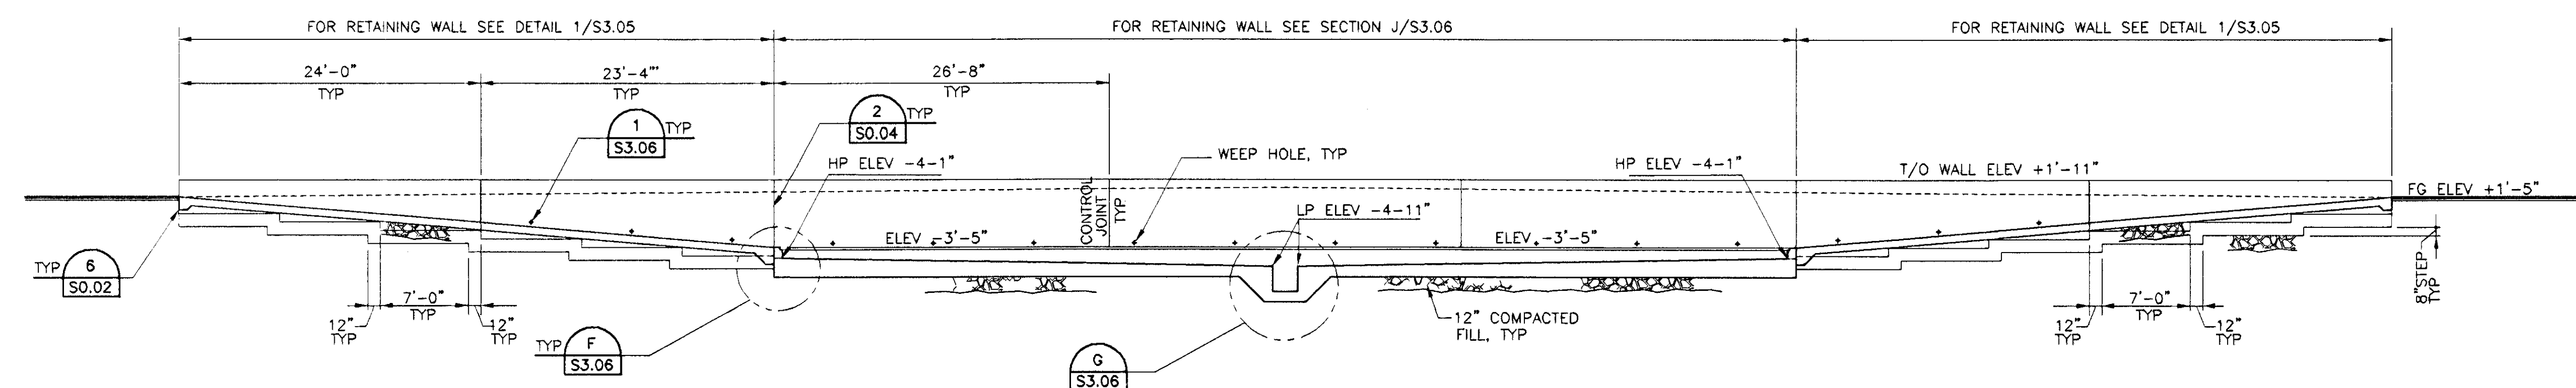

SECTION E S3.01

APPROVAL IS FOR CIRCLED
AREAS OR LATEST REVISION
ONLY SEE ORIGINALS
FOR OTHER REQUIREMENTS



REVISIONS
5 03.14.03

CONSULTANT
poggemeyer
design group, inc.
engineers • planners • surveyors • landscape architects
2000 North Sahara Way, Las Vegas, NV 89128 • P: 702.255.6100 • F: 702.255.6175

DEPARTMENT OF PUBLIC WORKS

CITY OF LAS VEGAS WEST SERVICE YARD
BUFFALO DRIVE AND PEAK ROAD
LAS VEGAS, NEVADA
SECTION
MATERIAL HANDLING BUILDING

APPROVED
STRUCTURAL
CITY OF LAS VEGAS
APR 10 2003

PROFESSIONAL ENGINEER
SEAL OF NEVADA
No. 2543
J. J. J. J.

OWNER: CITY OF LAS VEGAS
DEPARTMENT OF PUBLIC WORKS
ARCHITECTURAL SERVICES

400 EAST STEWART AVENUE
LAS VEGAS, NEVADA 89101
PHONE: (702) 229-6535
FAX: (702) 386-3232
TDD: (702) 386-9108

DRAWN SMK
TITLE 047S304
DATE 03.14.03
SCALE 1/8"=1'-0"
BID NO 02.15341.09
CIV. DWG. NO 107.V3548
SHEET NO S3.04
OF