

 
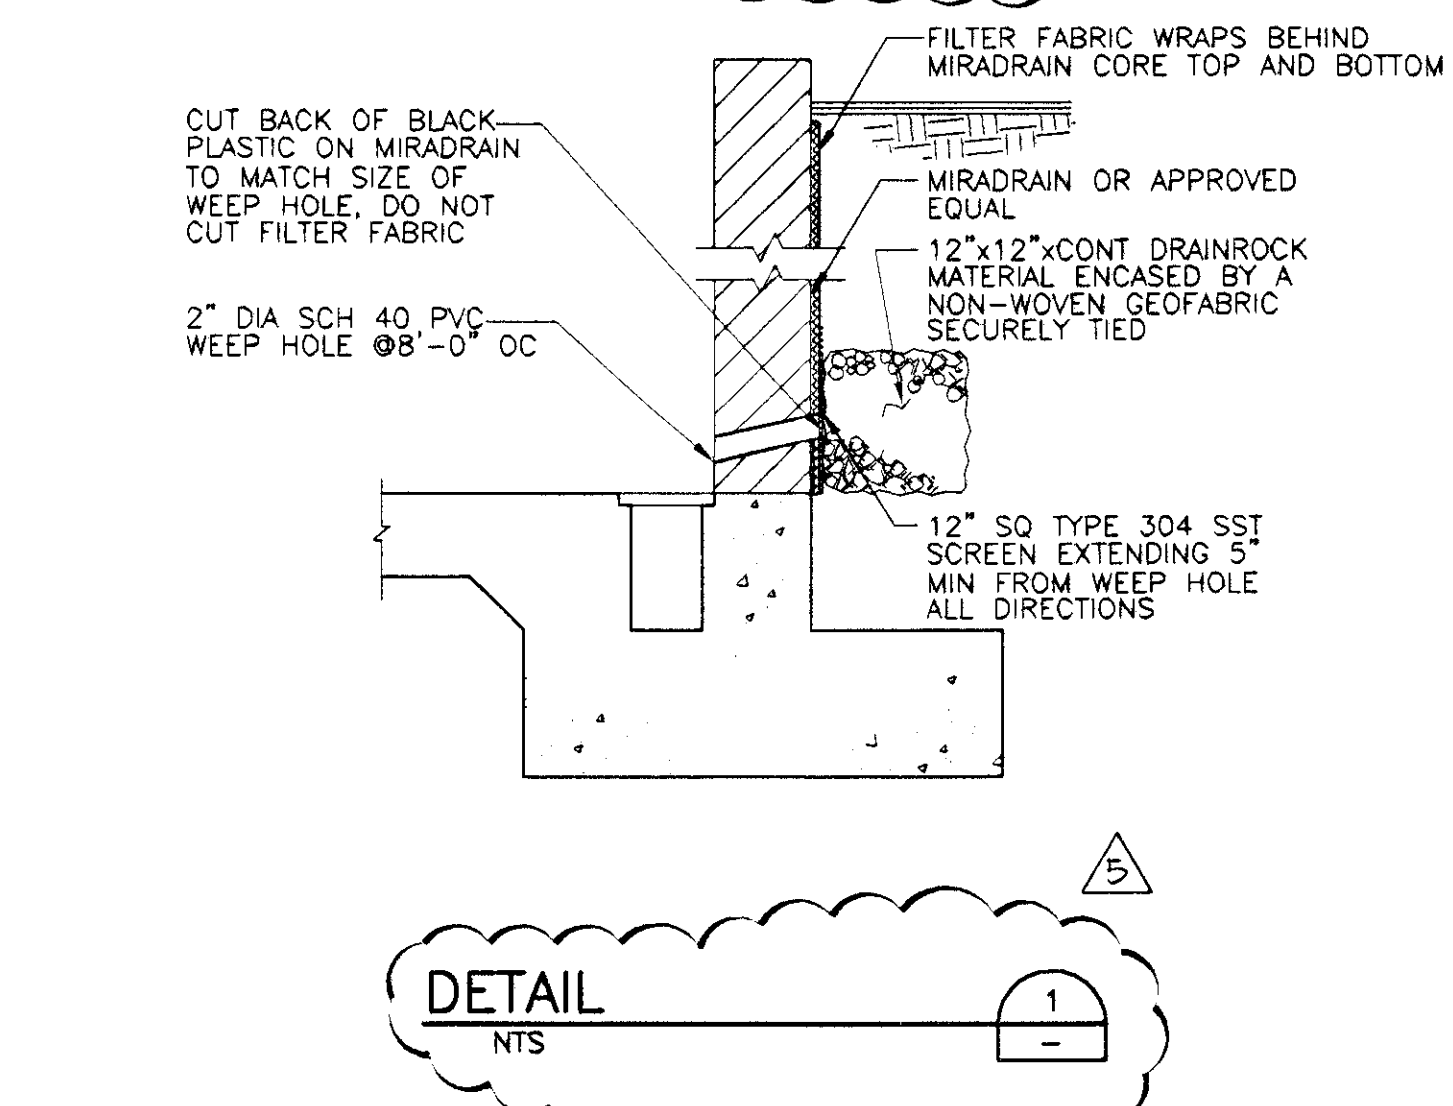
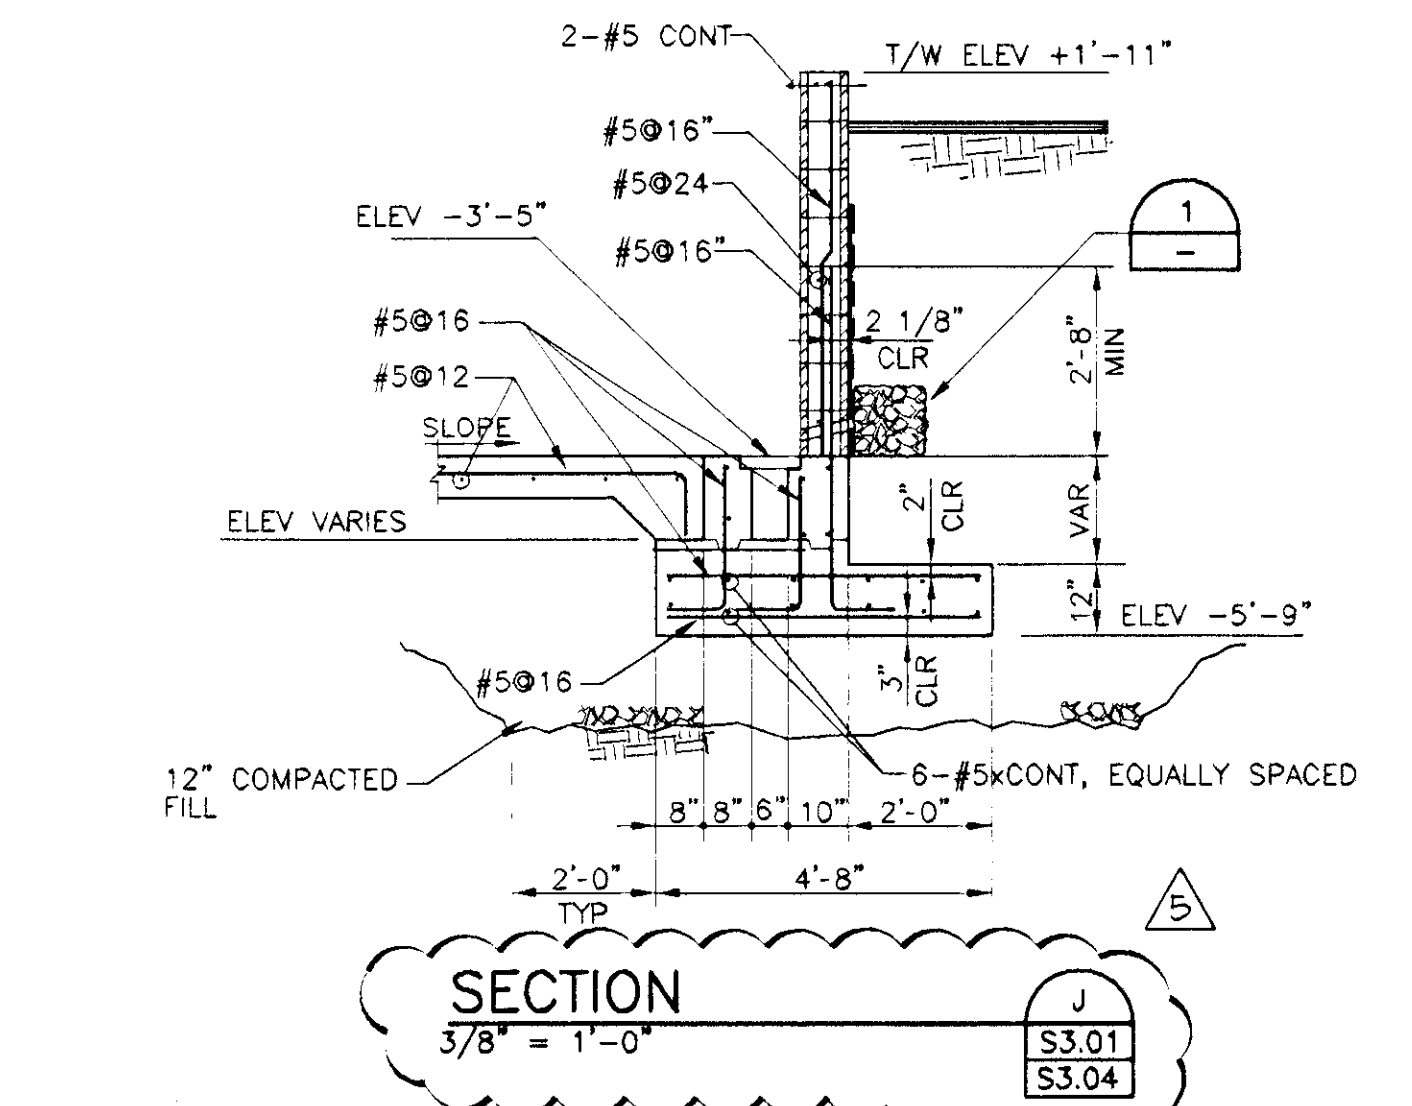
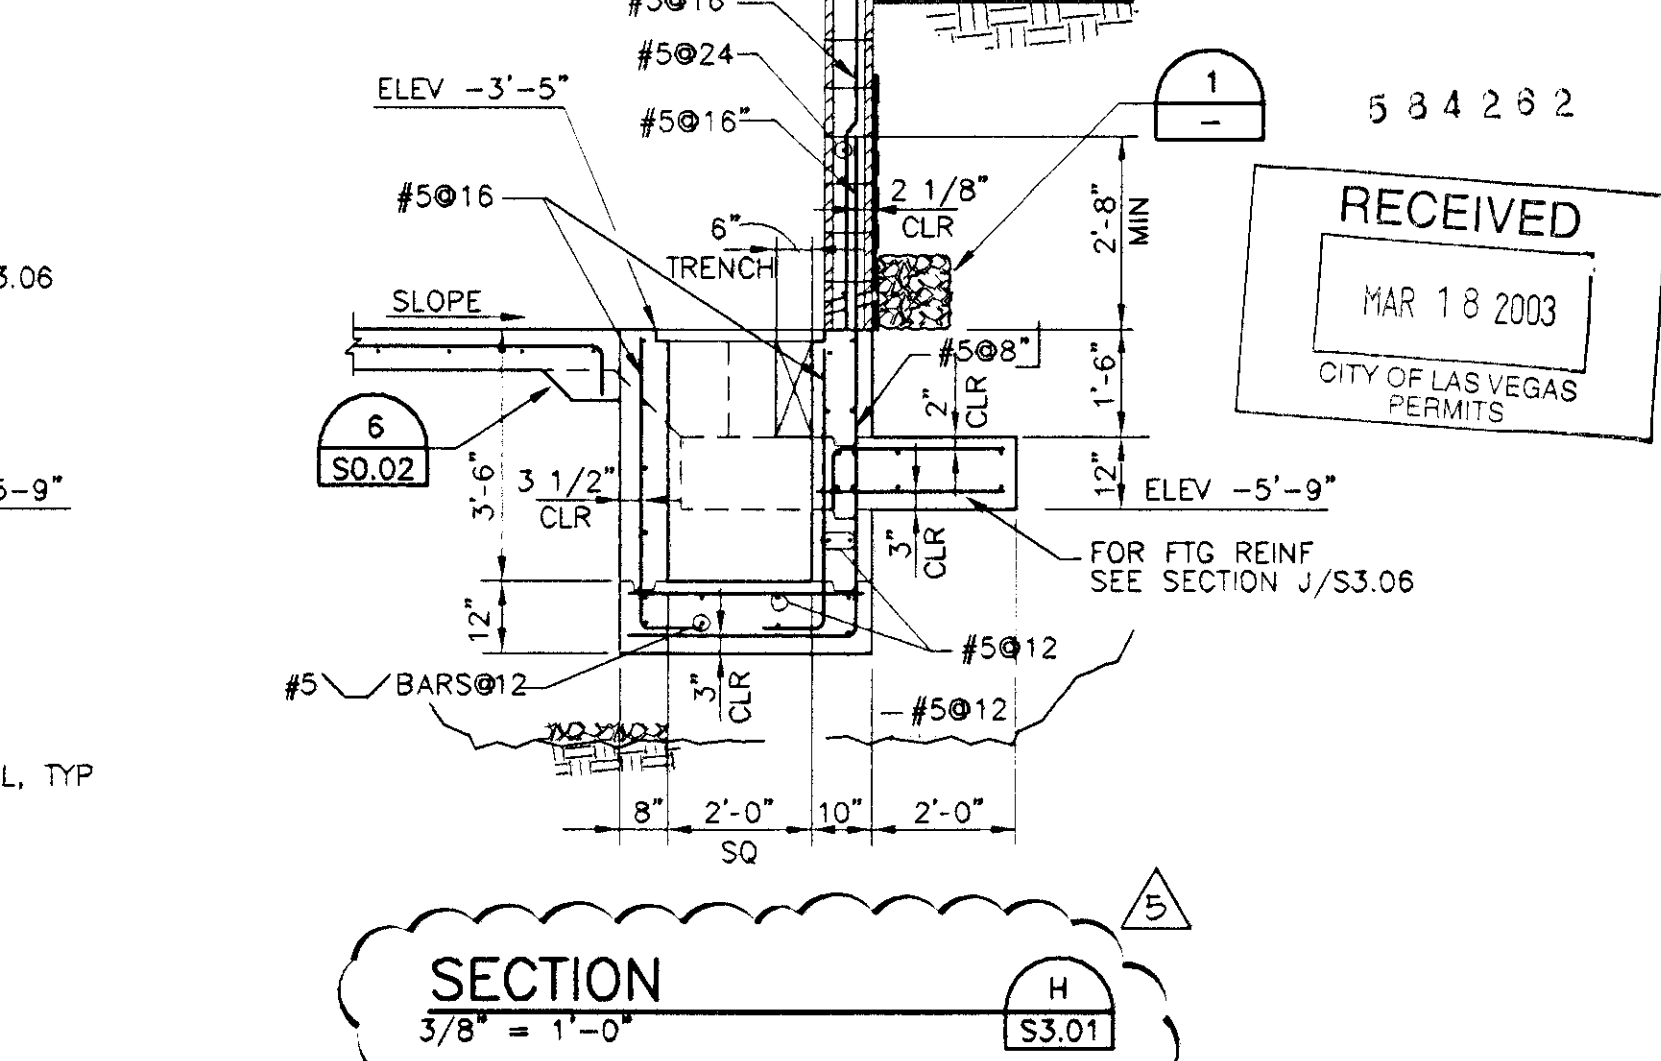
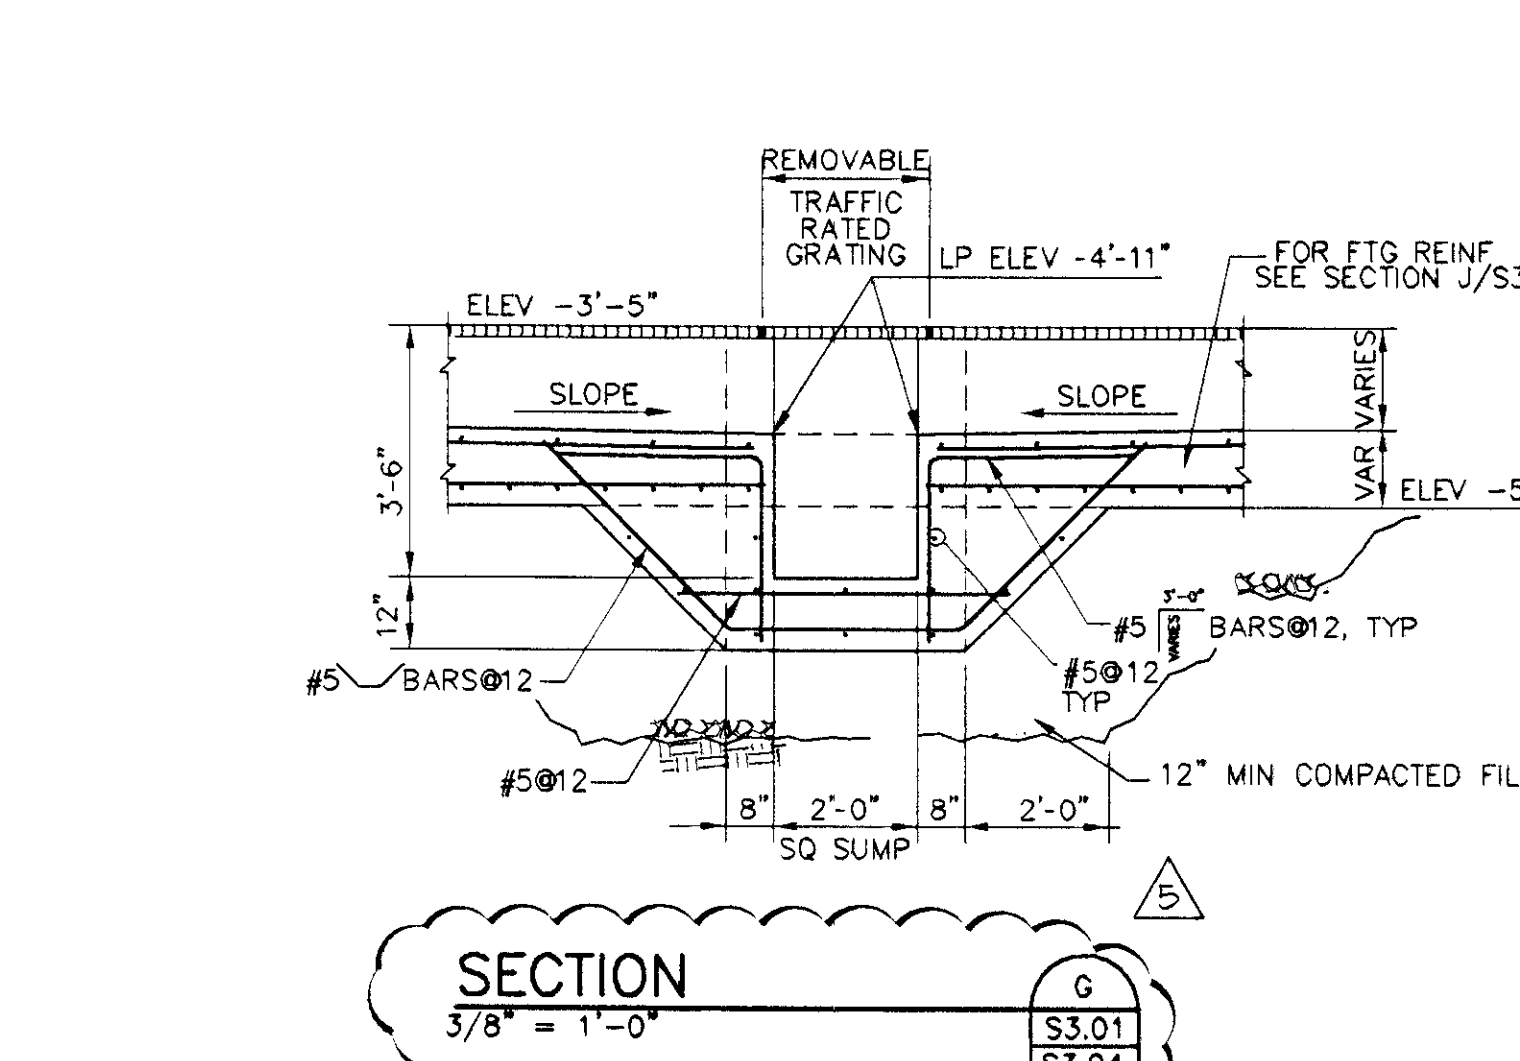
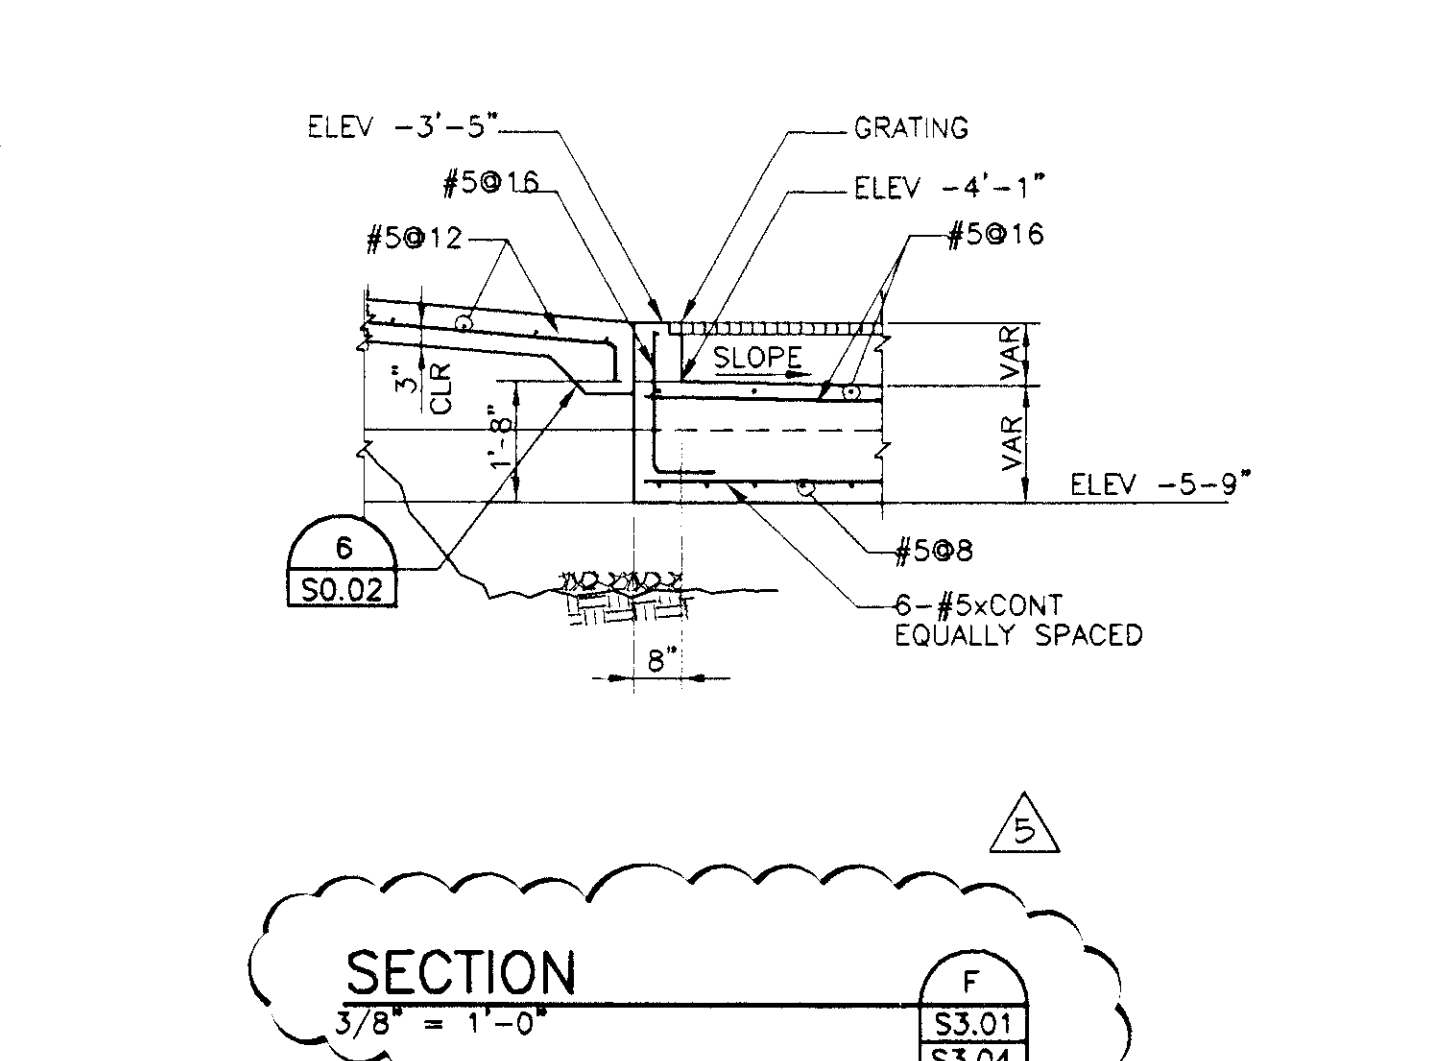
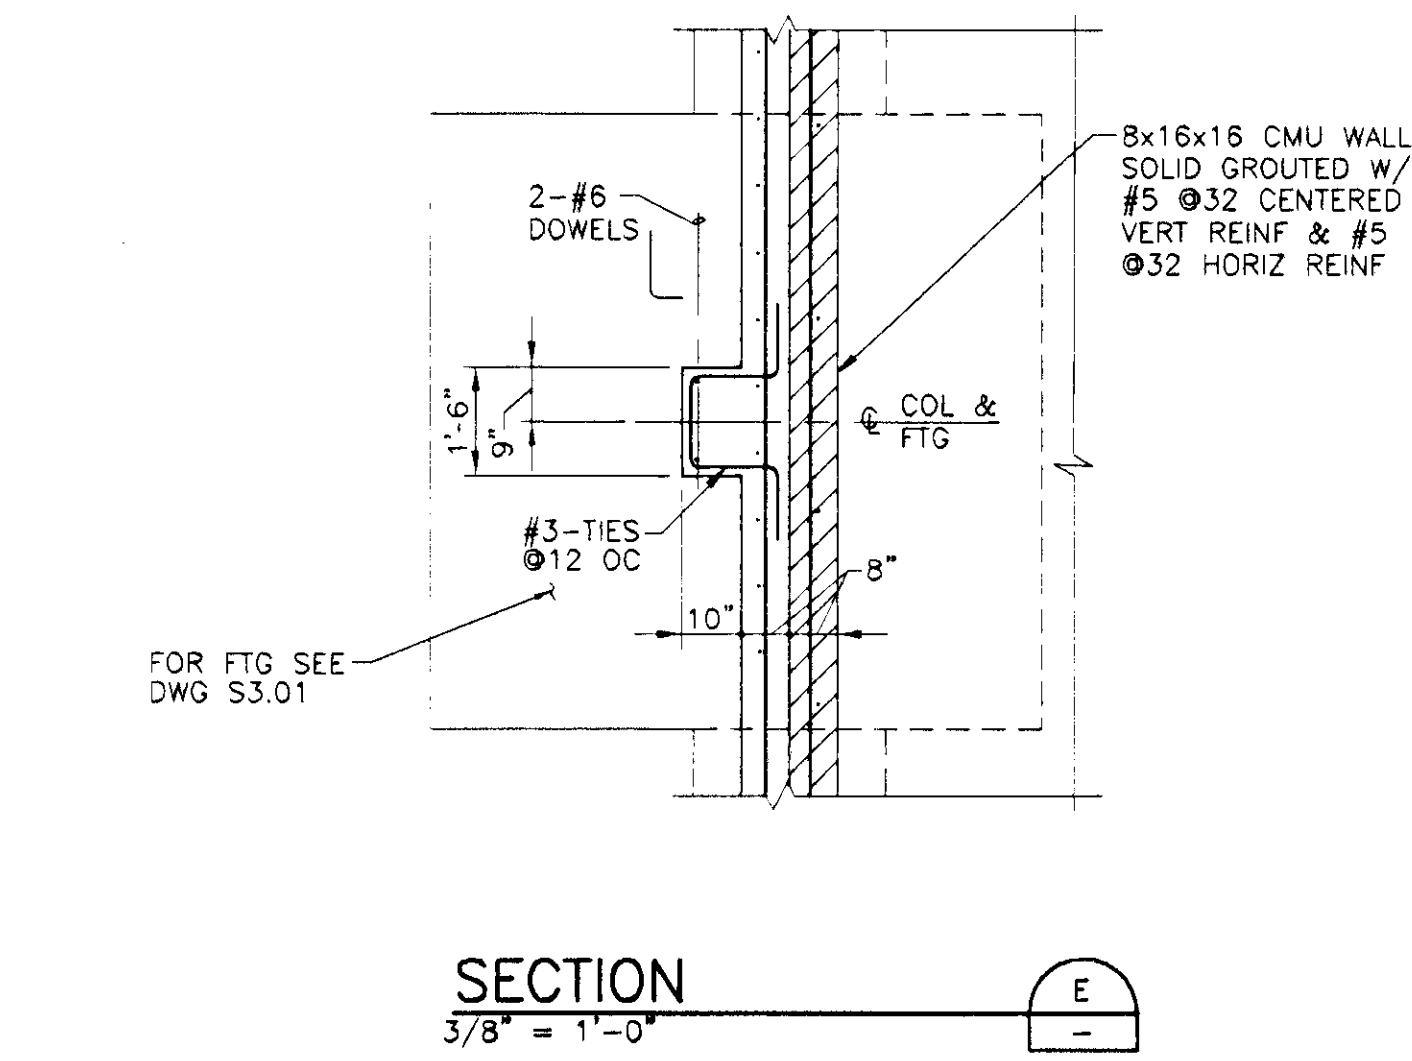
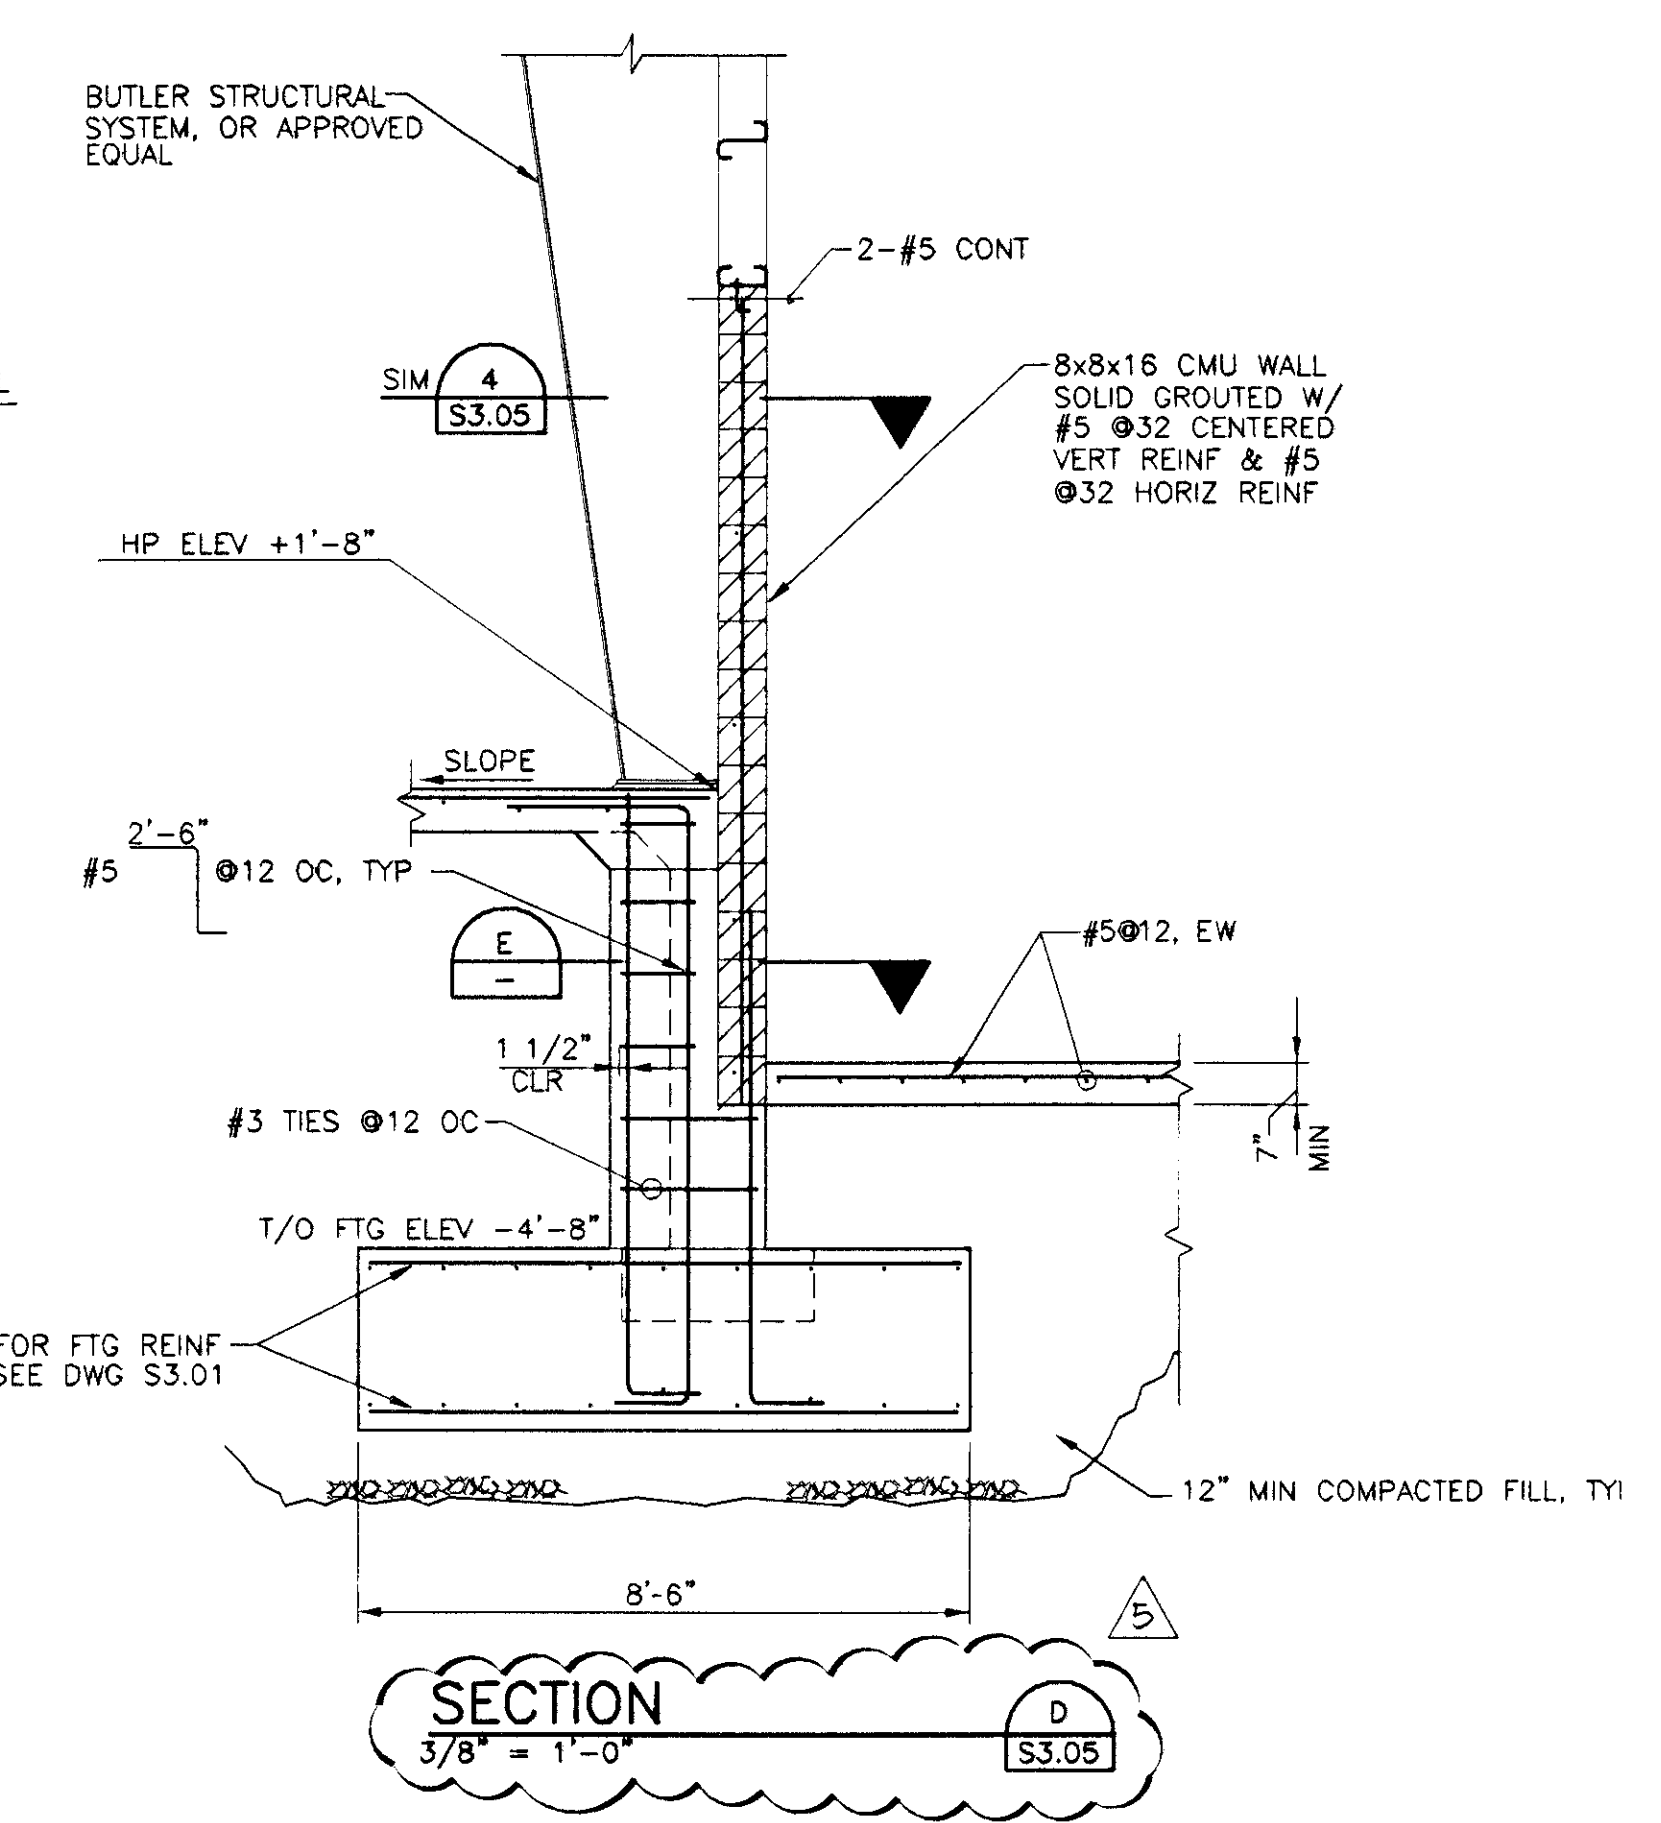
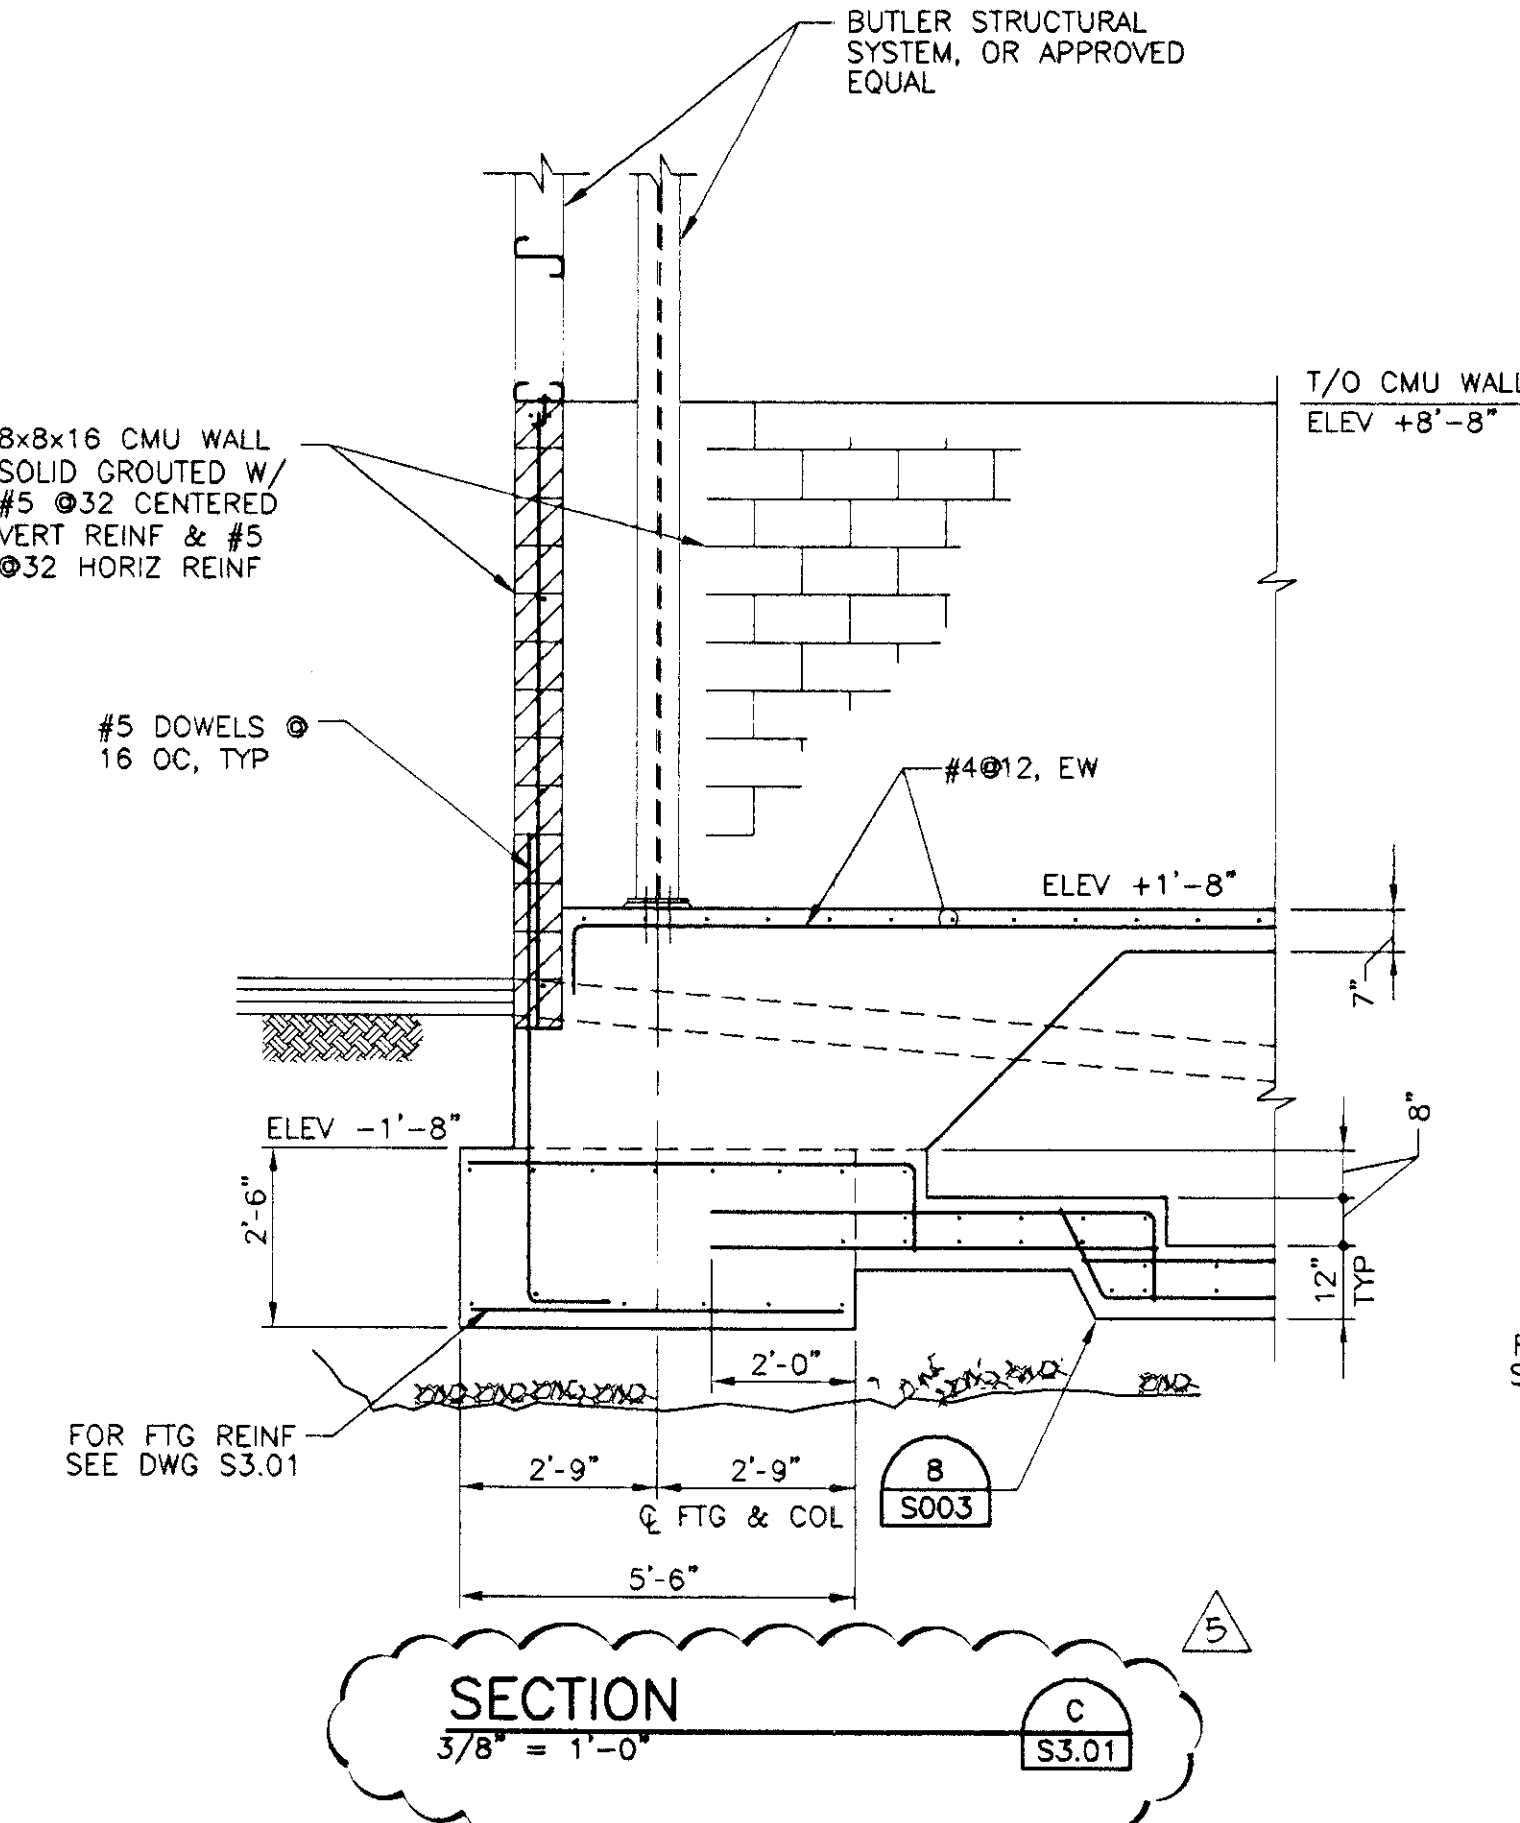
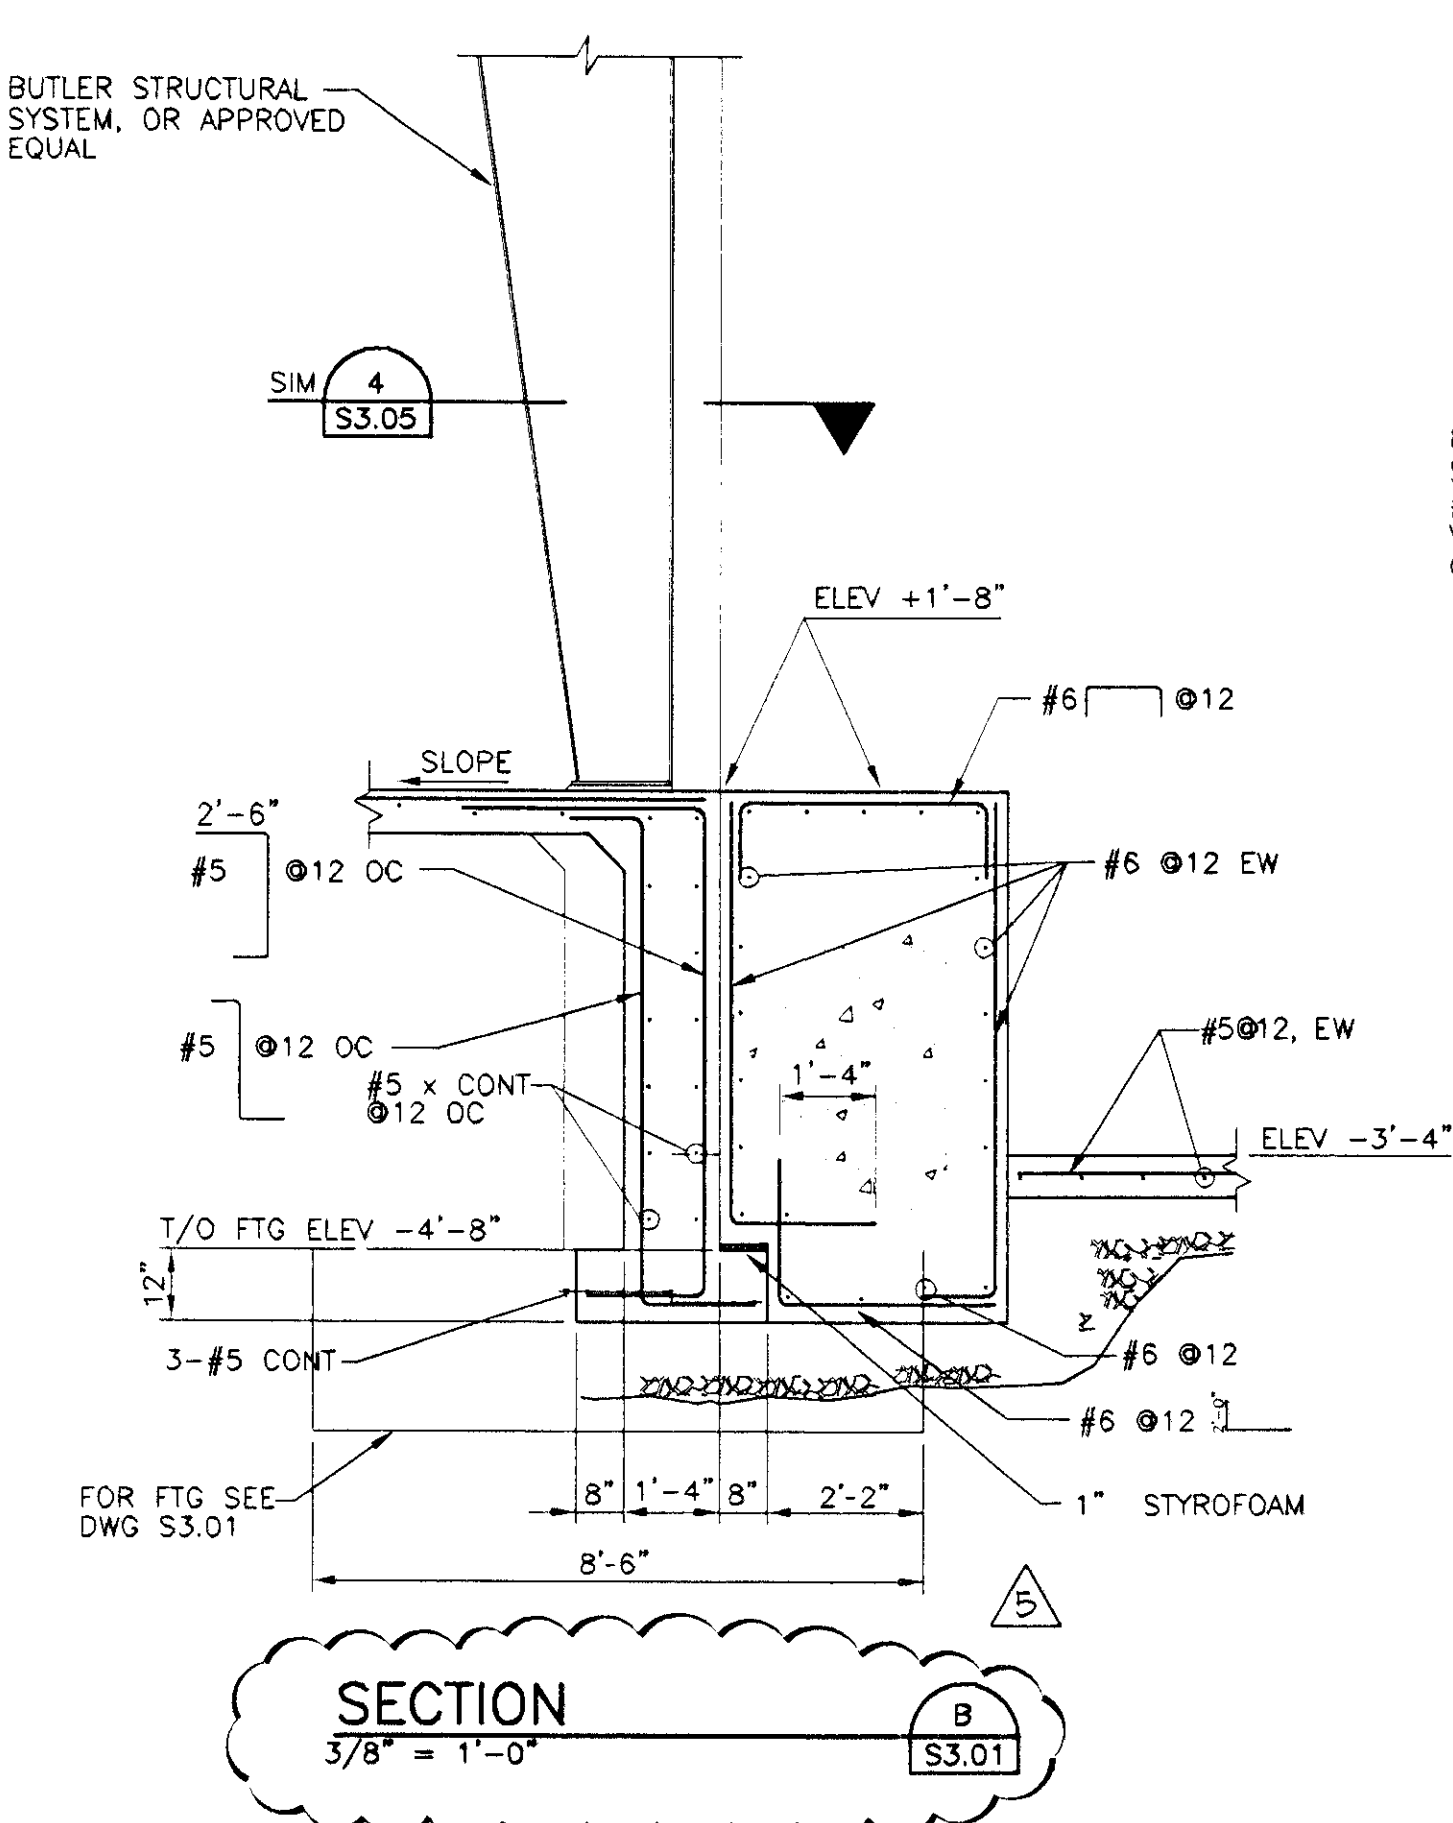


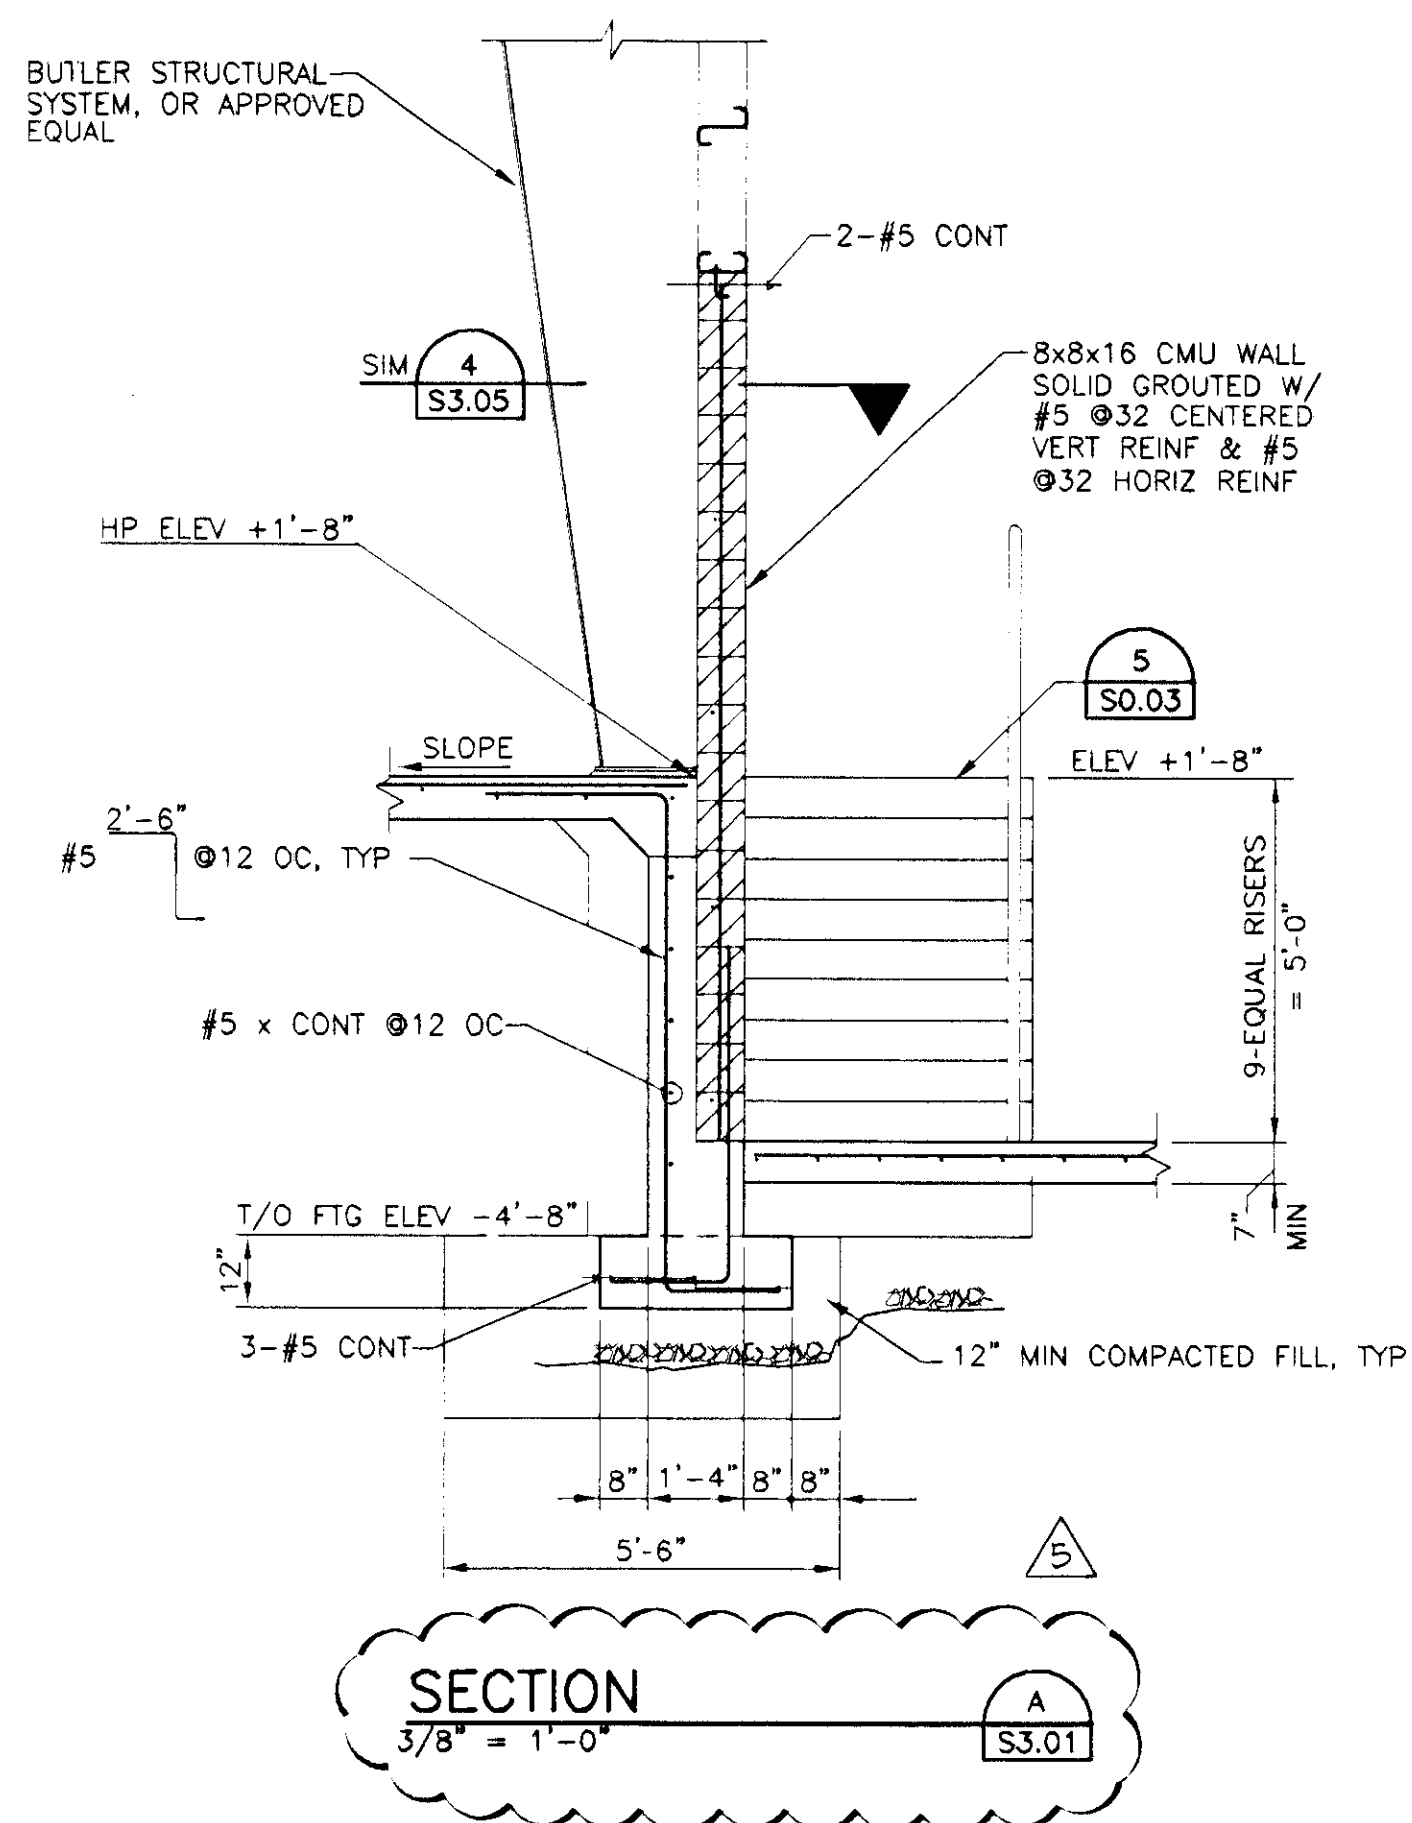

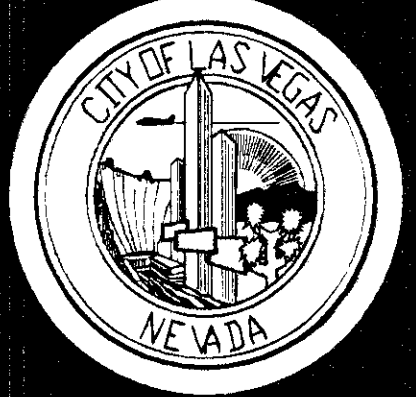

REVISIONS  
5 03.14.03

CONSULTANT  
**poggemeyer**  
design group, inc.  
engineers • planners • landscape architects  
2000 North Virginia Ave., Las Vegas, NV 89101 • P: 702.259.8175

**CITY OF LAS VEGAS WEST SERVICE YARD**  
**BUFFALO DRIVE AND PEAK ROAD**  
**LAS VEGAS, NEVADA**  
**SECTIONS**  
**MATERIAL HANDLING BUILDING**

APPROVED  
STRUCTURAL  
CITY ENGINEER & Survey Dept  
CITY OF LAS VEGAS, NEVADA

APR 10 2003

RECEIVED  
MAR 18 2003  
CITY OF LAS VEGAS  
PERMITS

APPROVAL IS FOR CLOUDY  
AREAS OR LATEST REVISION  
ONLY SEE ORIGINALS  
FOR OTHER REQUIREMENTS

OWNER: CITY OF LAS VEGAS  
DEPARTMENT OF PUBLIC WORKS  
ARCHITECTURAL SERVICES

400 EAST STEWART AVENUE  
LAS VEGAS, NEVADA 89101  
PHONE: (702) 229-6535  
FAX: (702) 385-9232  
TDD: (702) 386-9108

DRAWN: SMK  
FILE: 0475306  
DATE: 03.14.03  
SCALE: 3/8"=1'-0"  
REV NO: 02.15341.09  
CLV DWG NO: 107 V3548

SHEET NO: S3.06  
OF