




REVISIONS
5 03.14.03

CONSULTANT
poggemeyer
design group, llc.
engineers • planners • designers • landscape architects
2001 North Nevada Way • Las Vegas, NV 89101 • P 702.255.8000 • F 702.255.8075

CITY OF LAS VEGAS WEST SERVICE YARD
BUFFALO DRIVE AND PEAK ROAD
LAS VEGAS, NEVADA
SECTIONS
WASH BAYS

APPROVED
STRUCTURAL
ENGINEER
CITY OF LAS VEGAS
PERMITS

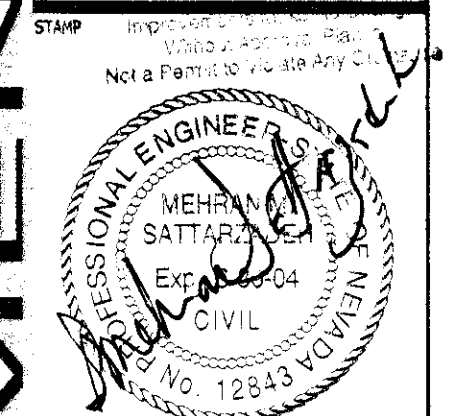


OWNER: CITY OF LAS VEGAS
DEPARTMENT OF PUBLIC WORKS
ARCHITECTURAL SERVICES

400 EAST STEWART AVENUE
LAS VEGAS, NEVADA 89101
PHONE: (702) 229-6535
FAX: (702) 382-3232
TDD: (702) 382-5108

DRAWN: SMK,MSZ
FILE: 0475402
DATE: 03.14.03
SCALE: 1/4"=1'-0"
SHEET NO: 02.15341.09
CLV DWG NO: 107.V3548


SHEET NO: S4.02
OF

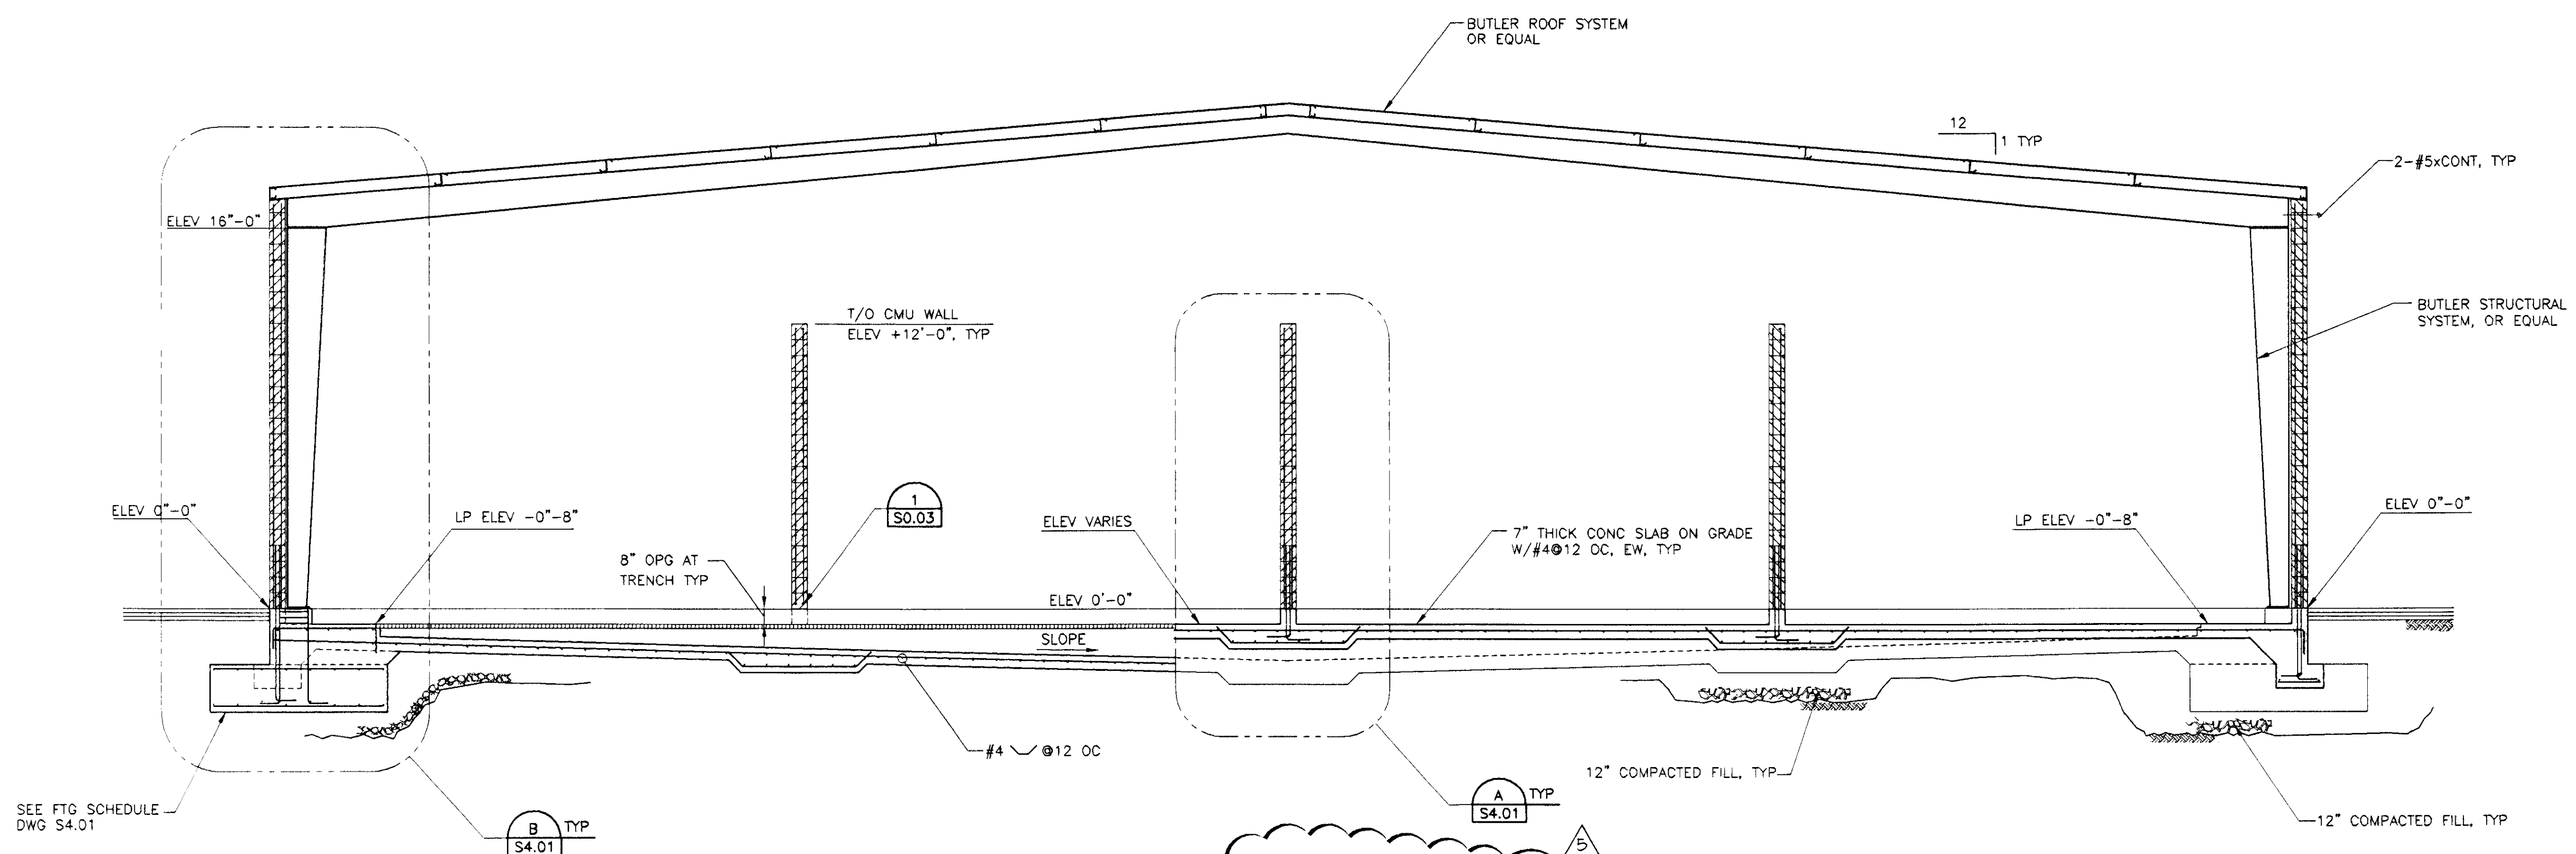

SECTION A-A

5 8 4 2 8 2

RECEIVED
MAR 18 2003
CITY OF LAS VEGAS
PERMITS

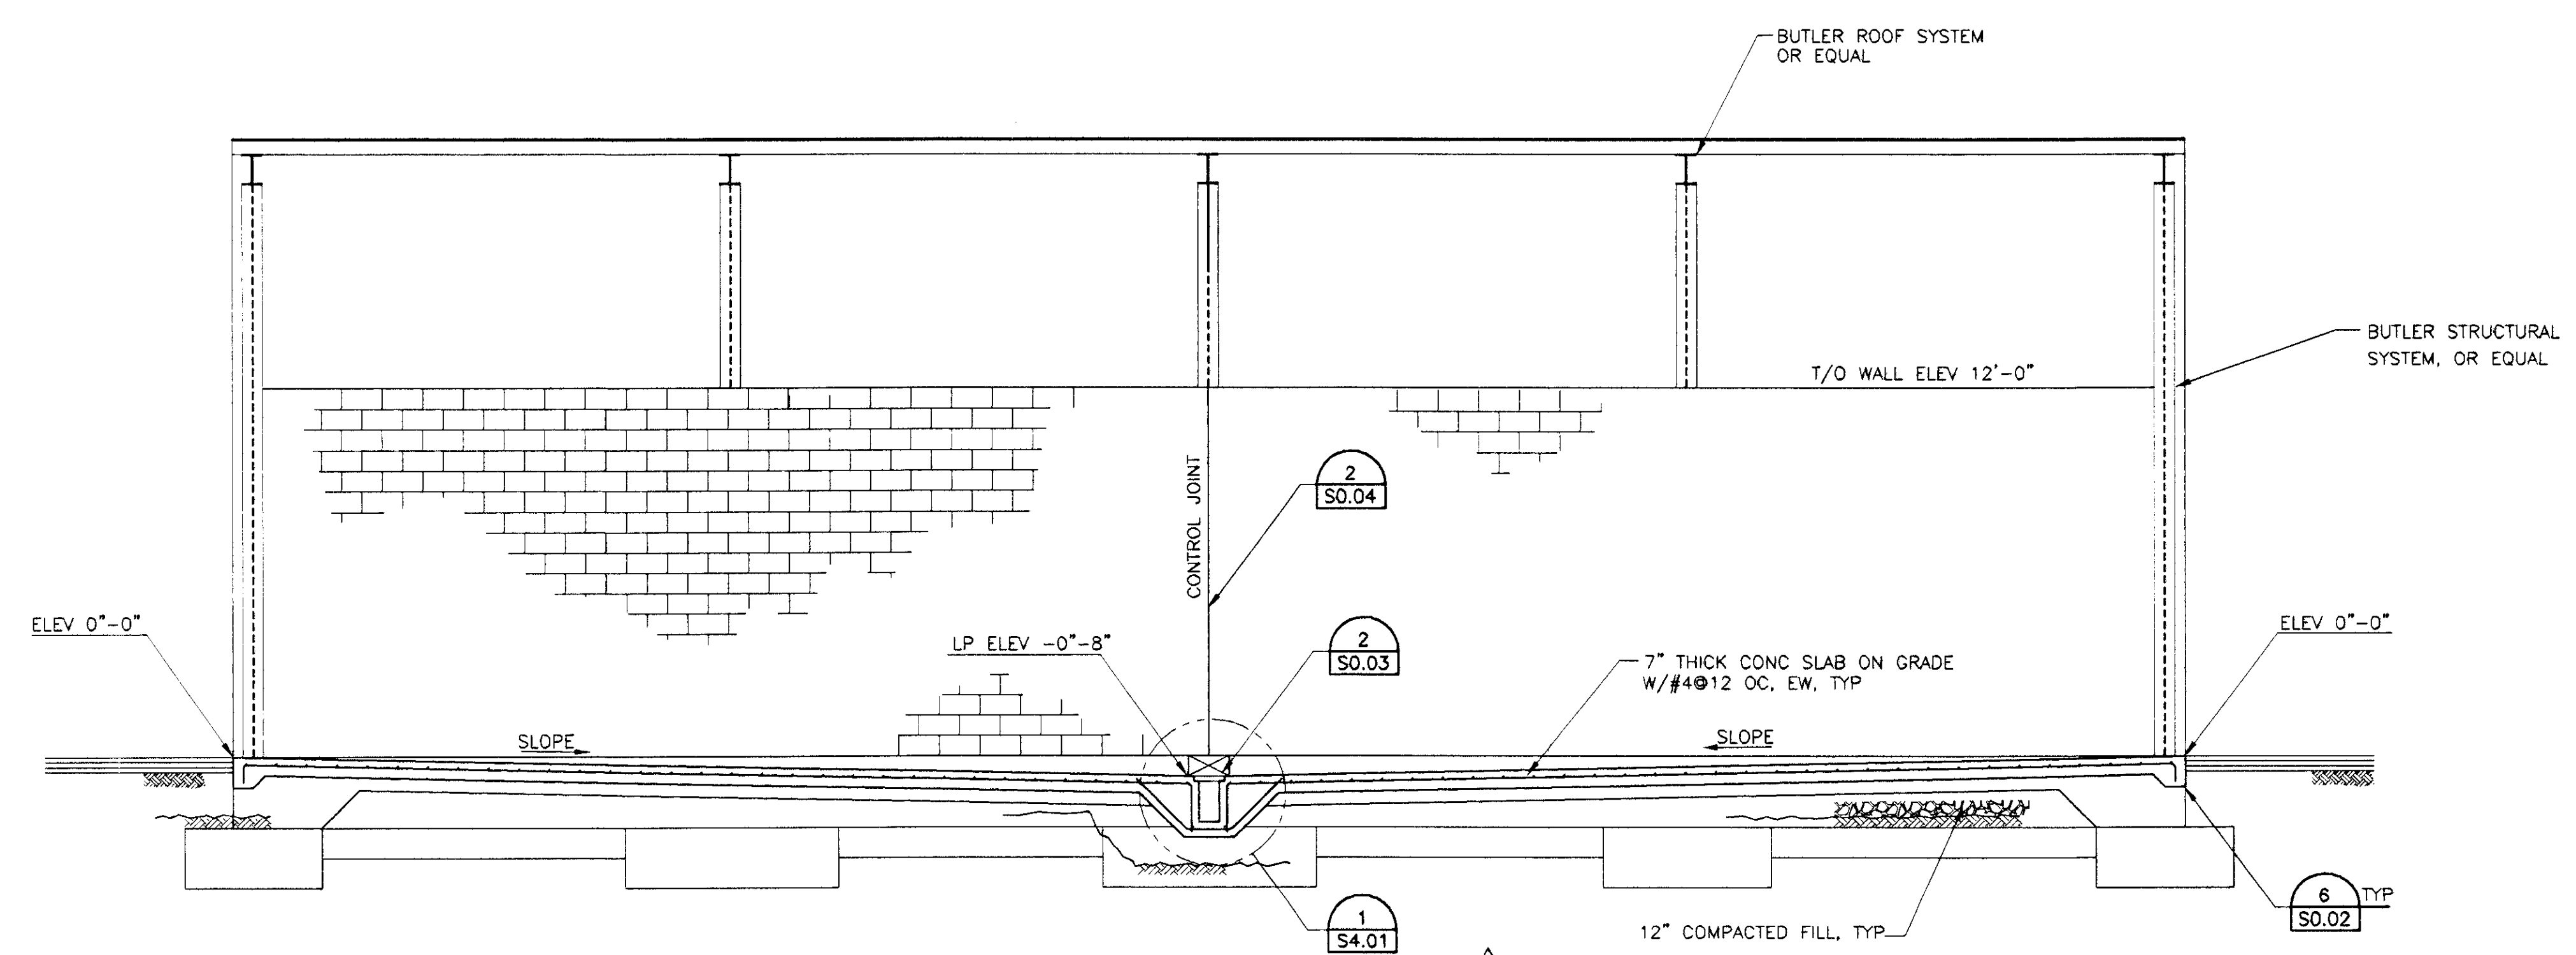

SECTION B-B

APPROVAL IS FOR CLOUDED
AREAS OR LATEST REVISIONS
ONLY. SEE ORIGINALS
FOR OTHER REQUIREMENTS