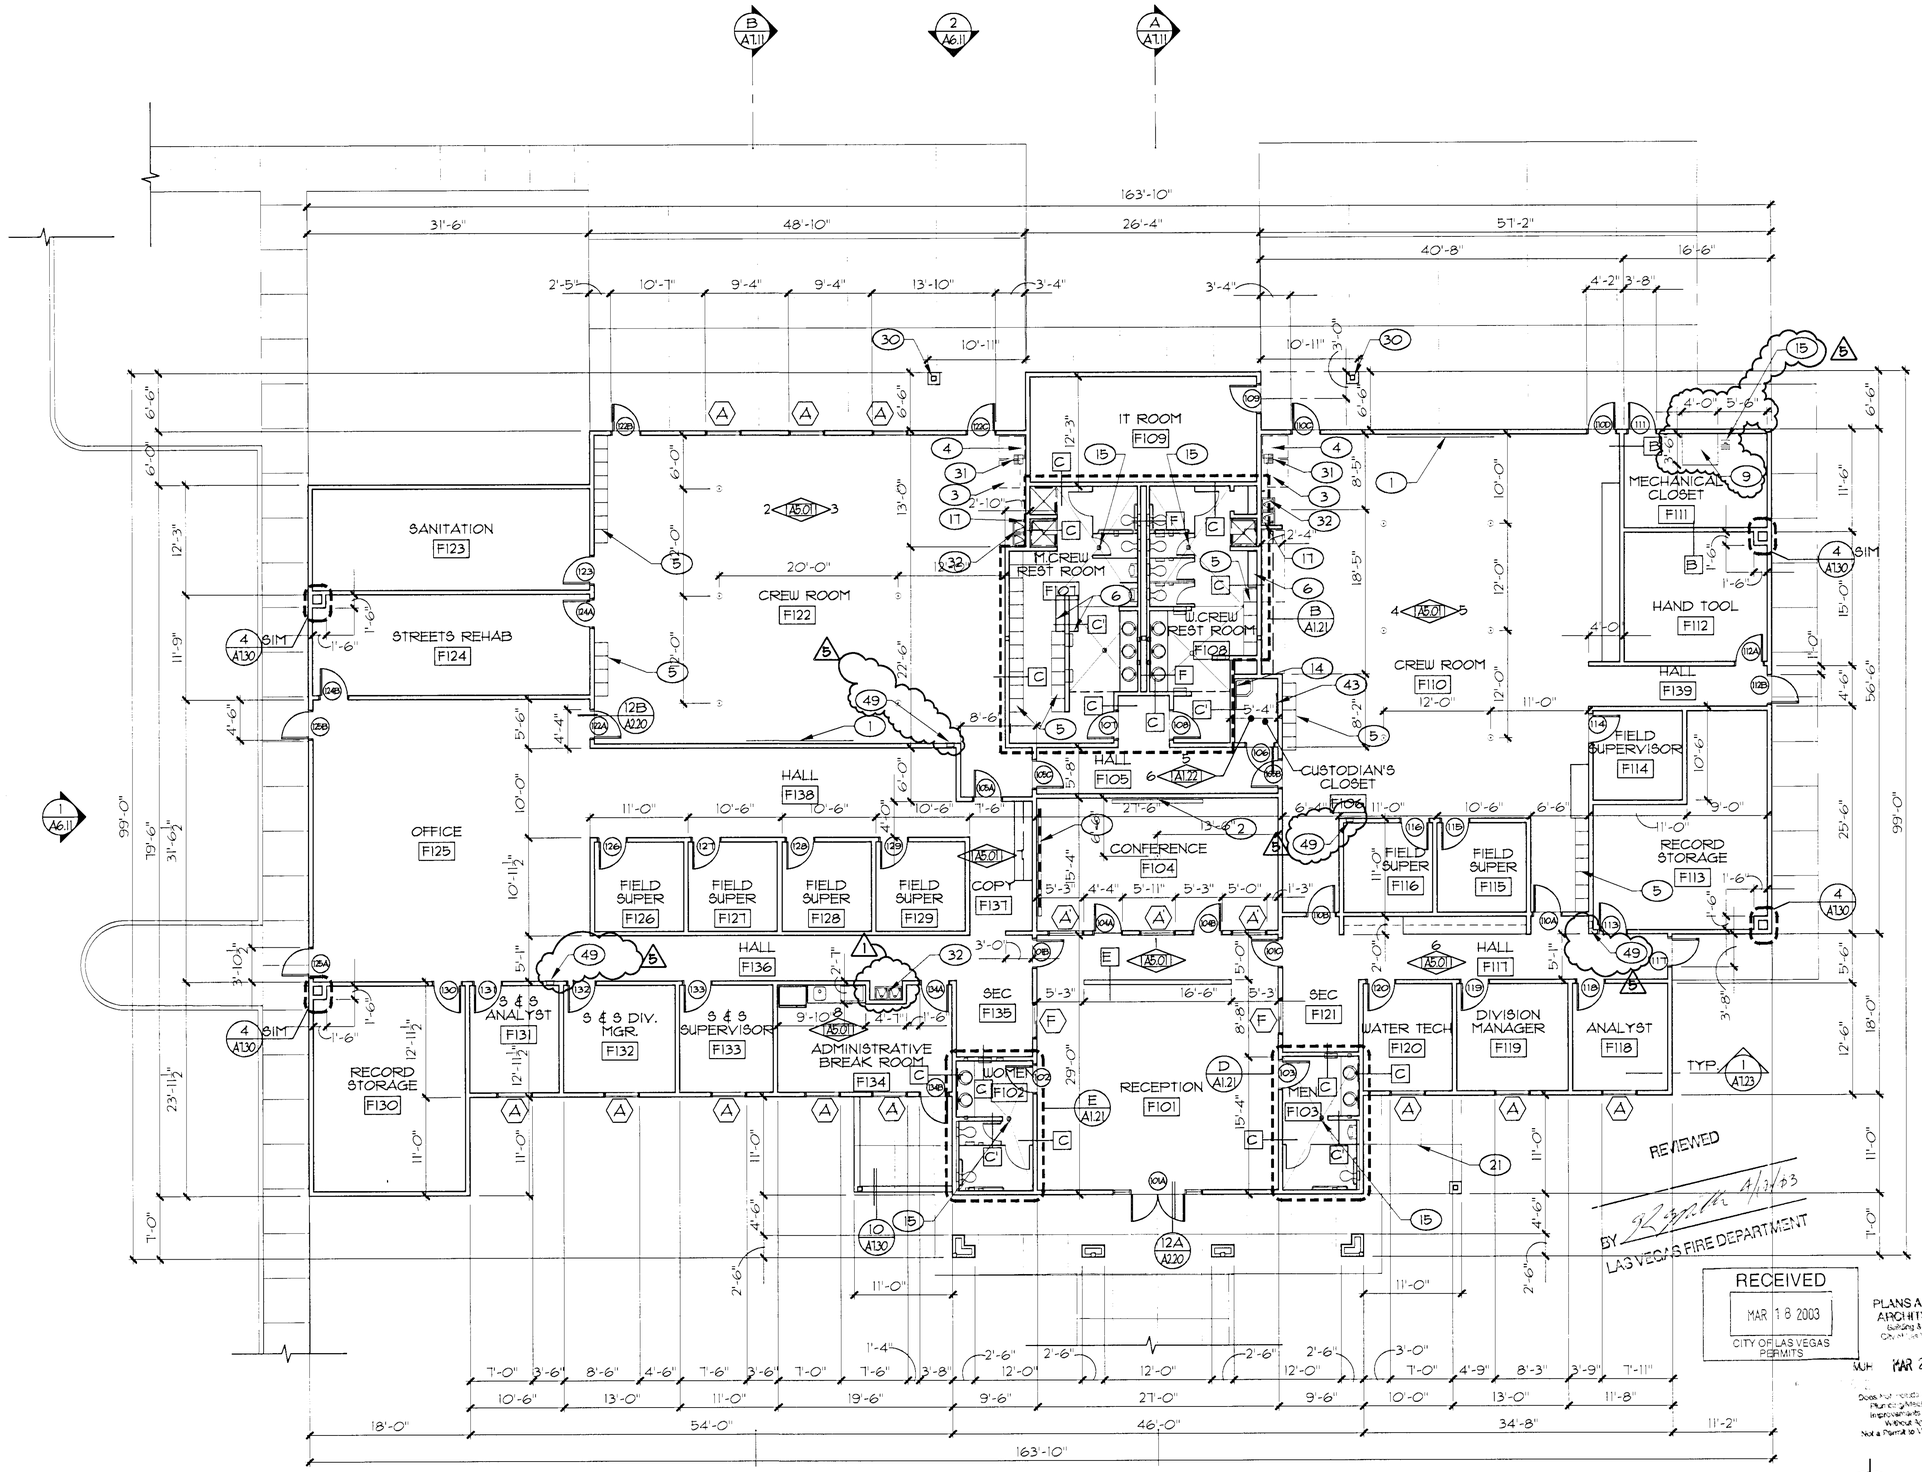

FLOOR PLAN

SCALE: 1/8" = 1'-0"

APPROVAL IS FOR CLOUDED AREAS OR LATEST REVISIONS ONLY. SEE ORIGINALS FOR OTHER REQUIREMENTS.

APPROVED
FIELD OPS BLDG
BY
CONSTRUCTION MANAGER
CITY OF LAS VEGAS
4/11/03

KEYNOTES

SHEETS A1.11 - A1.15

1. 4' x 12' DUSTLESS WRITING SURFACE
2. WALL-MOUNTED PROJECT. SCREEN @ 9'-0" AFF
3. VENDING MACHINE (NIC)
4. ICE MACHINE (NIC)
5. LOCKERS
6. LOCKER BENCH, N.I.C.
7. CMU RETAINING WALL
8. CONCRETE LOADING DOCK
9. CONCRETE EQUIPMENT PAD
10. TRENCH DRAIN, SEE PLUMBING DRAWINGS
11. CONCRETE SLAB
12. PERFORATED STEEL PLATE, SEE DETAIL 7 / A5.03
13. EYEWASH
14. WALL-MOUNTED MOP RACK
15. FLOOR DRAIN, SEE PLUMB. DWGS.
16. WALL-MOUNTED SINK
17. HOSE BIB
18. CMU WALL
19. PERFORATED METAL GATE SEE A/A5.03
20. EXHAUST FAN, MOUNTED IN WALL PANEL ABOVE, SEE MECH. DWGS.
21. LOCATE OWNER-FURNISHED MEMORIAL BENCH
22. CONSTRUCTION JOINT, SEE STRUCTURAL DRAWINGS
23. BOLLARD, TYP
24. METAL ROOF
25. STEEL FRAMING, SEE STRUCTURAL DRAWINGS
26. 1-1/2" DIA. STEEL PIPE RAILING, PTD. (SEE A2.01 FOR COLOR), SEE ELEV.
27. 8" O.D. STEEL PIPE BOLLARD, PAINTED
28. OPENING AT FLOOR LEVEL FOR TRENCH DRAIN, SEE STRUCTURAL
29. CONCRETE FOOTING, SEE STRUCT. DWGS.
30. TUBE STEEL COLUMN, PTD. SEE STRUCT. DWGS.
31. FLOOR SINK, SEE PLUMB. DWGS.
32. DRINKING FOUNTAIN, SEE PLUMB. DWGS.
33. PREFABRICATED WALL PANELS
34. REMOVE EXIST. SIDEWALK AND LANDSCAPING
35. WOVEN-WIRE PARTITIONS
36. REMOVE EXIST. STUCCO FINISH & METAL LATH TO EXPOSE EXIST. SHEATHING
37. REMOVE EXIST. STUCCO FR/ COLUMNS, TYP. OF 4 COLUMNS TO REMAIN
38. REMOVE EXIST. CONC. TILE FROM ROOF AREA SHOWN ABOVE
39. REMOVE EXIST. STOREFRONT (NON-LOAD BEARING)
40. REMOVE EXIST. WINDOW
41. REMOVE AND RELOCATE EXIST. SITE LAMP. SEE ELEC. DWGS.
42. REMOVE EXIST. ARCHES & STUCCO SOFFIT FR/ ABOVE
43. ROOF ACCESS LADDER
49. RECESSED FIRE EXT. CAB.
50. FIRE EXT. ON BRACKET

GENERAL NOTES

1. FOR A1.11, FIELD OPERATIONS BUILDING, ALL INTERIOR PARTITIONS TO BE TYPE 'A', U.N.O.
2. FOR A1.11, FIELD OPERATIONS BUILDING, FF ELEV. +0'-0" IS EQUAL TO FF ELEV 78.5 ON CIVIL DRAWINGS
3. FOR A1.12, MATERIALS HAND. BUILDING, FF ELEV. +0'-0" IS EQUAL TO FF ELEV 70.52 ON CIVIL DRAWINGS
4. FOR A1.13, FIELD MAINT. BUILDING, FF ELEV. +0'-0" IS EQUAL TO FF ELEV 71.58 ON CIVIL DRAWINGS
5. ALL FURNISHINGS N.I.C. U.N.O.
6. SEE A2.30 FOR WALL TYPES

CITY OF LAS VEGAS

REVISIONS
1 08.30.02
5 03.14.03

CONSULTANT
TATE SNYDER KIMSEY ARCHITECTS
7139 Valley Woods Court, Henderson, Nevada 89014 ph: (702) 436-3000 fax: (702) 436-1009
www.tatesnyderkimsey.com
COPYRIGHT © 2002 TATE SNYDER KIMSEY ARCHITECTS
THE PROJECT DRAWINGS AND SPECIFICATIONS AS INSTRUMENTS OF SERVICE ARE THE PROPERTY OF THE ARCHITECT AND SHALL NOT BE REPRODUCED IN WHOLE OR IN PART WITHOUT WRITTEN CONSENT OF THE ARCHITECT. THE PROJECT DRAWINGS AND SPECIFICATIONS AS INSTRUMENTS OF SERVICE, MAY BE USED BY THE OWNER AND OTHERS WORKING ON THE PROJECT FOR INFORMATION AND REFERENCE IN CONNECTION WITH THE OWNER'S USE AND OCCUPANCY OF THE PROJECT. THE PROJECT DRAWINGS AND SPECIFICATIONS MAY NOT BE USED BY THE OWNER OR OTHERS FOR EXTENSIONS OF THE PROJECT OR ON ANY OTHER PROJECT WITHOUT WRITTEN AGREEMENT BY THE ARCHITECT.

DEPARTMENT OF PUBLIC WORKS

CITY OF LAS VEGAS WEST SERVICE YARD
BUFFALO DRIVE AND PEAK ROAD
LAS VEGAS, NEVADA
FLOOR PLAN
FIELD OPERATIONS BUILDING

STAMP
STEPHEN C. RAMEY
REGISTERED
NO. 4440
ARCHITECT
STATE OF NEVADA
4/11/03

OWNER: CITY OF LAS VEGAS
DEPARTMENT OF PUBLIC WORKS
ARCHITECTURAL SERVICES

400 EAST STEWART AVENUE
LAS VEGAS, NEVADA 89101
PHONE: (702) 229-6535
FAX: (702) 382-3232
TDD: (702) 386-9108

DRAWN	JFE
FILE	047a111
DATE	03.14.03
SCALE	1/8" = 1'-0"
BID NO	02.15341.09
CIV DWG NO	107-V3548
SHT NO	A1.11

DRAWINGS AND SPECIFICATIONS REVIEWED BY THE OWNER MAY BE UTILIZED ONLY FOR OCCUPYING THE PROJECT FOR WHICH THEY WERE PREPARED AND NOT FOR THE CONSTRUCTION OF ANY OTHER PROJECT. A.A.C. 62.20